


All dimensions to be checked on site; Figured dimensions to be read in preference to scaled.

Brock Carmichael accepts no responsibility for and does not permit any unauthorised amendments to or reproduction of the drawing. This drawing and associated copyright remains the property of Brock Carmichael unless otherwise agreed.

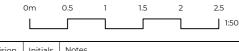

Date	Revision	Initials	Notes
19.04.24	S1 P3	JDW	PRELIMINARY PLANNING ISSUE

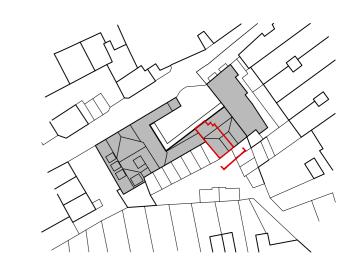

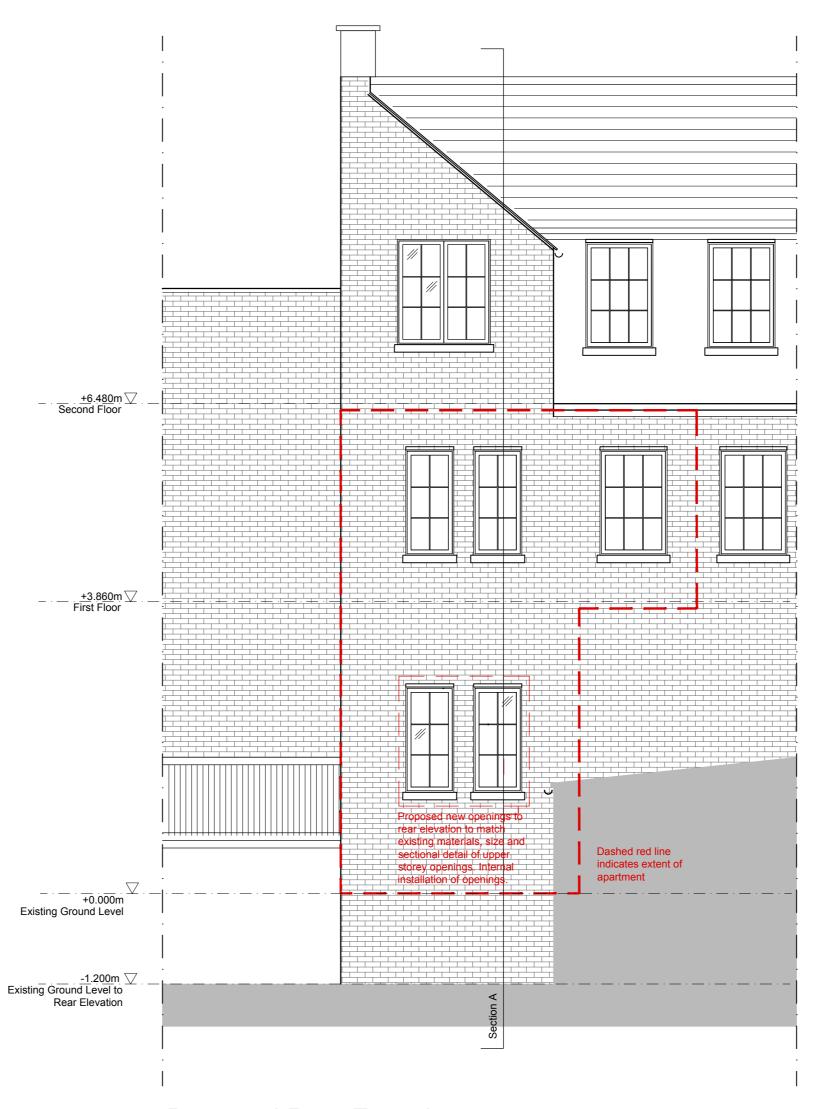

Proposed Rear Elevation 1:50@A2

Existing Rear Elevation 1:50@A2

Not Surveyed

Dashed red line indicates extent of

Not Surveyed

_____+6.480m \sqrt{

+3.860m
First Floor

Existing Ground Level

Existing Ground Level to
Rear Elevation



PLANNING

Natasha Orchant

BCA Project Ref

23 033 2 Salmon Mews

CB

Checked By

CB

CB

Drawing Title

Existing and Proposed Rear Elevation

Drawing Reference

23 033 - BCA-XX-XX-DR-A-05002 S1 P3 1:50