


Proposed Plan

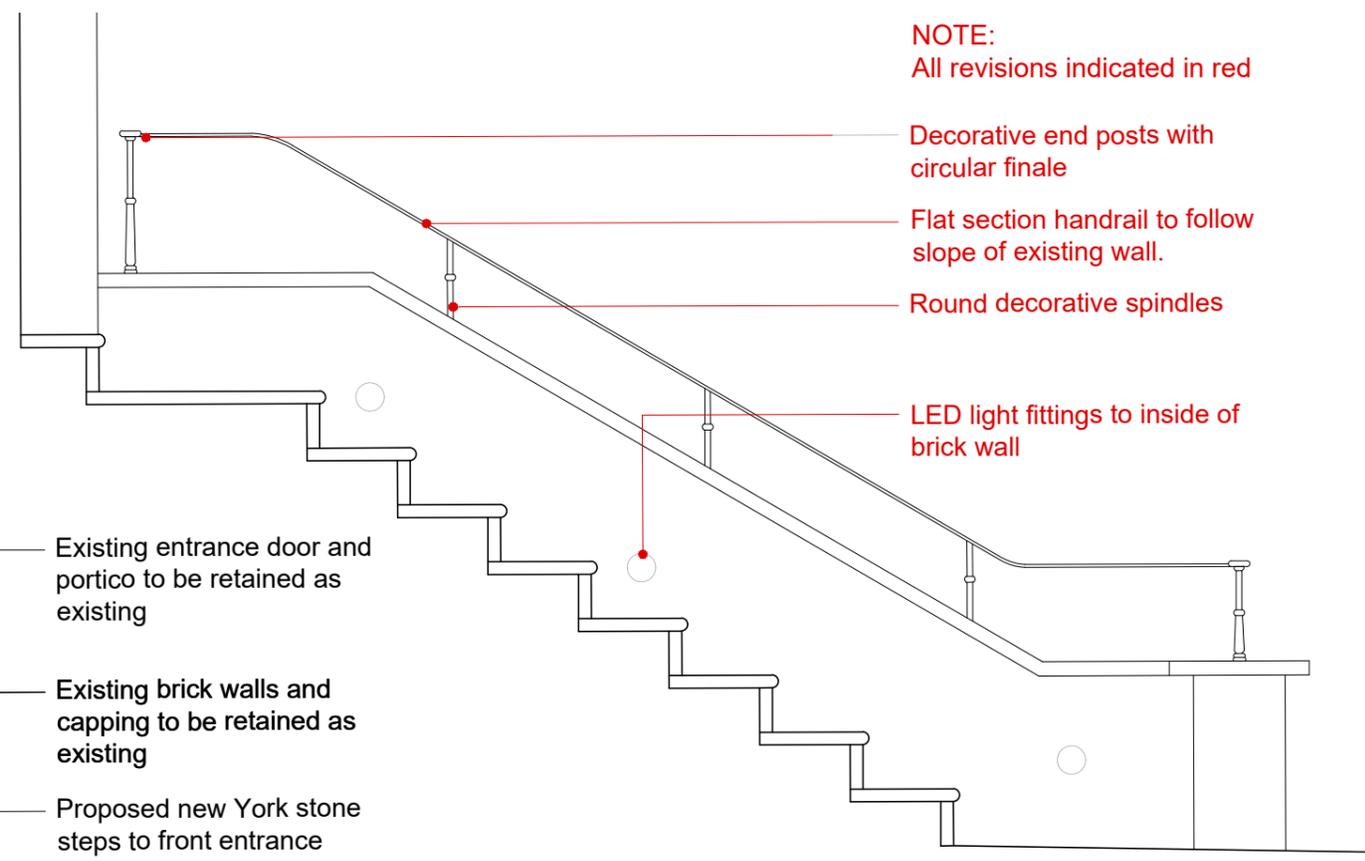


Proposed Section

- NOTE:**  
All revisions indicated in red
- Decorative end posts with circular finiale
  - Flat section handrail to follow slope of existing wall.
  - Round decorative spindles
  - LED light fittings to inside of brick wall

- Existing entrance door and portico to be retained as existing
- Existing brick walls and capping to be retained as existing
- Proposed new York stone steps to front entrance steps and landing
- Existing landscaping and stone paving to front garden to be retained as existing
- Proposed iron balustrade fixed to capping stone. Black gloss finish to all new ironwork

Rev No.	Rev Date	Description	Drawn By
A	23.04.2025	Non-Material Amendment	NT

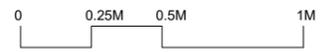

Enn Studio Ltd,  
1 Arlesford Road, London.  
www.ennstudio.co  
hello@ennstudio.co

NOTES:  
- Drawings are for planning purposes only.  
- Drawings are not for construction or tender.  
- All dimensions to be checked on site by the contractor.  
- Any drawing errors and discrepancies to be reported to the Architect.  
- All dimensions in millimeters unless stated otherwise.  
- If in doubt contact Project Manager.

job title  
Steele's Road Front Entrance Steps

drawing title  
Proposed Front Entrance Plan

status	PLANNING	drawn by	NT
scale	1:25 @ A3	date	23.04.25

job no	drawing no	Revision
A114	PL-01-101-A	A