


EXISTING GROUND FLOOR PLAN

SCALE 1:50

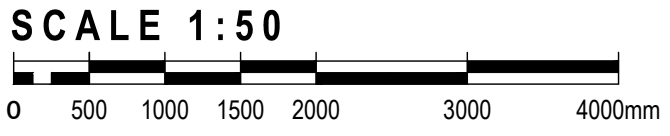

HAMPSTEAD

GENERAL NOTES

1. THIS DRAWING MUST NOT BE SCALED.
2. FOLLOWING COMMENCEMENT OF WORK ON SITE, ISSUED DRAWINGS AND DETAILS MAY BE SUBJECT TO CHANGE DUE TO SITE CONDITIONS OR CONTRACTOR DESIGN MODIFICATIONS.
3. ALL WORKS MUST BE CARRIED OUT TO THE SATISFACTION OF LOCAL AND STATUTORY AUTHORITIES, IN ACCORDANCE WITH CURRENT BUILDING REGULATIONS AND CODES OF PRACTICE.
4. ALL DIMENSIONS ARE TO BE VERIFIED WITH THE CONTRACTOR ON SITE PRIOR TO MANUFACTURE OR INSTALLATION.
5. QUADRANT DESIGN MUST BE INFORMED OF ANY AMENDMENTS TO THE DESIGN ON SITE.

MORE INFO



SCAN THIS CODE TO ACCESS:
QD WEBSITE

29.11.24	AS BUILT	JF	
WORK STAGE	AS BUILT		
CLIENT	THE WHITE COMPANY LONDON		
PROJECT	HAMPSTEAD		
SHEET TITLE	EXISTING GROUND FLOOR PLAN		
SCALE	AS SHOWN AT A1		JF
SHEET NO.	J002205_A1_00	REVISION:	R



QUADRANT DESIGN
23 KINGS ROAD,
READING,
RG1 3AR
73-74 BERWICK STREET,
LONDON,
W1F 8TE
(+44) 0118 9591 581
hello@quadrantdesign.co.uk
www.quadrantdesign.co.uk

INTERIORS | ARCHITECTURE | BRANDING