



NOTES
1) SECTIONS SEE DRAWING NUMBER
21064/E05 AND E06 AND C07 TO C11

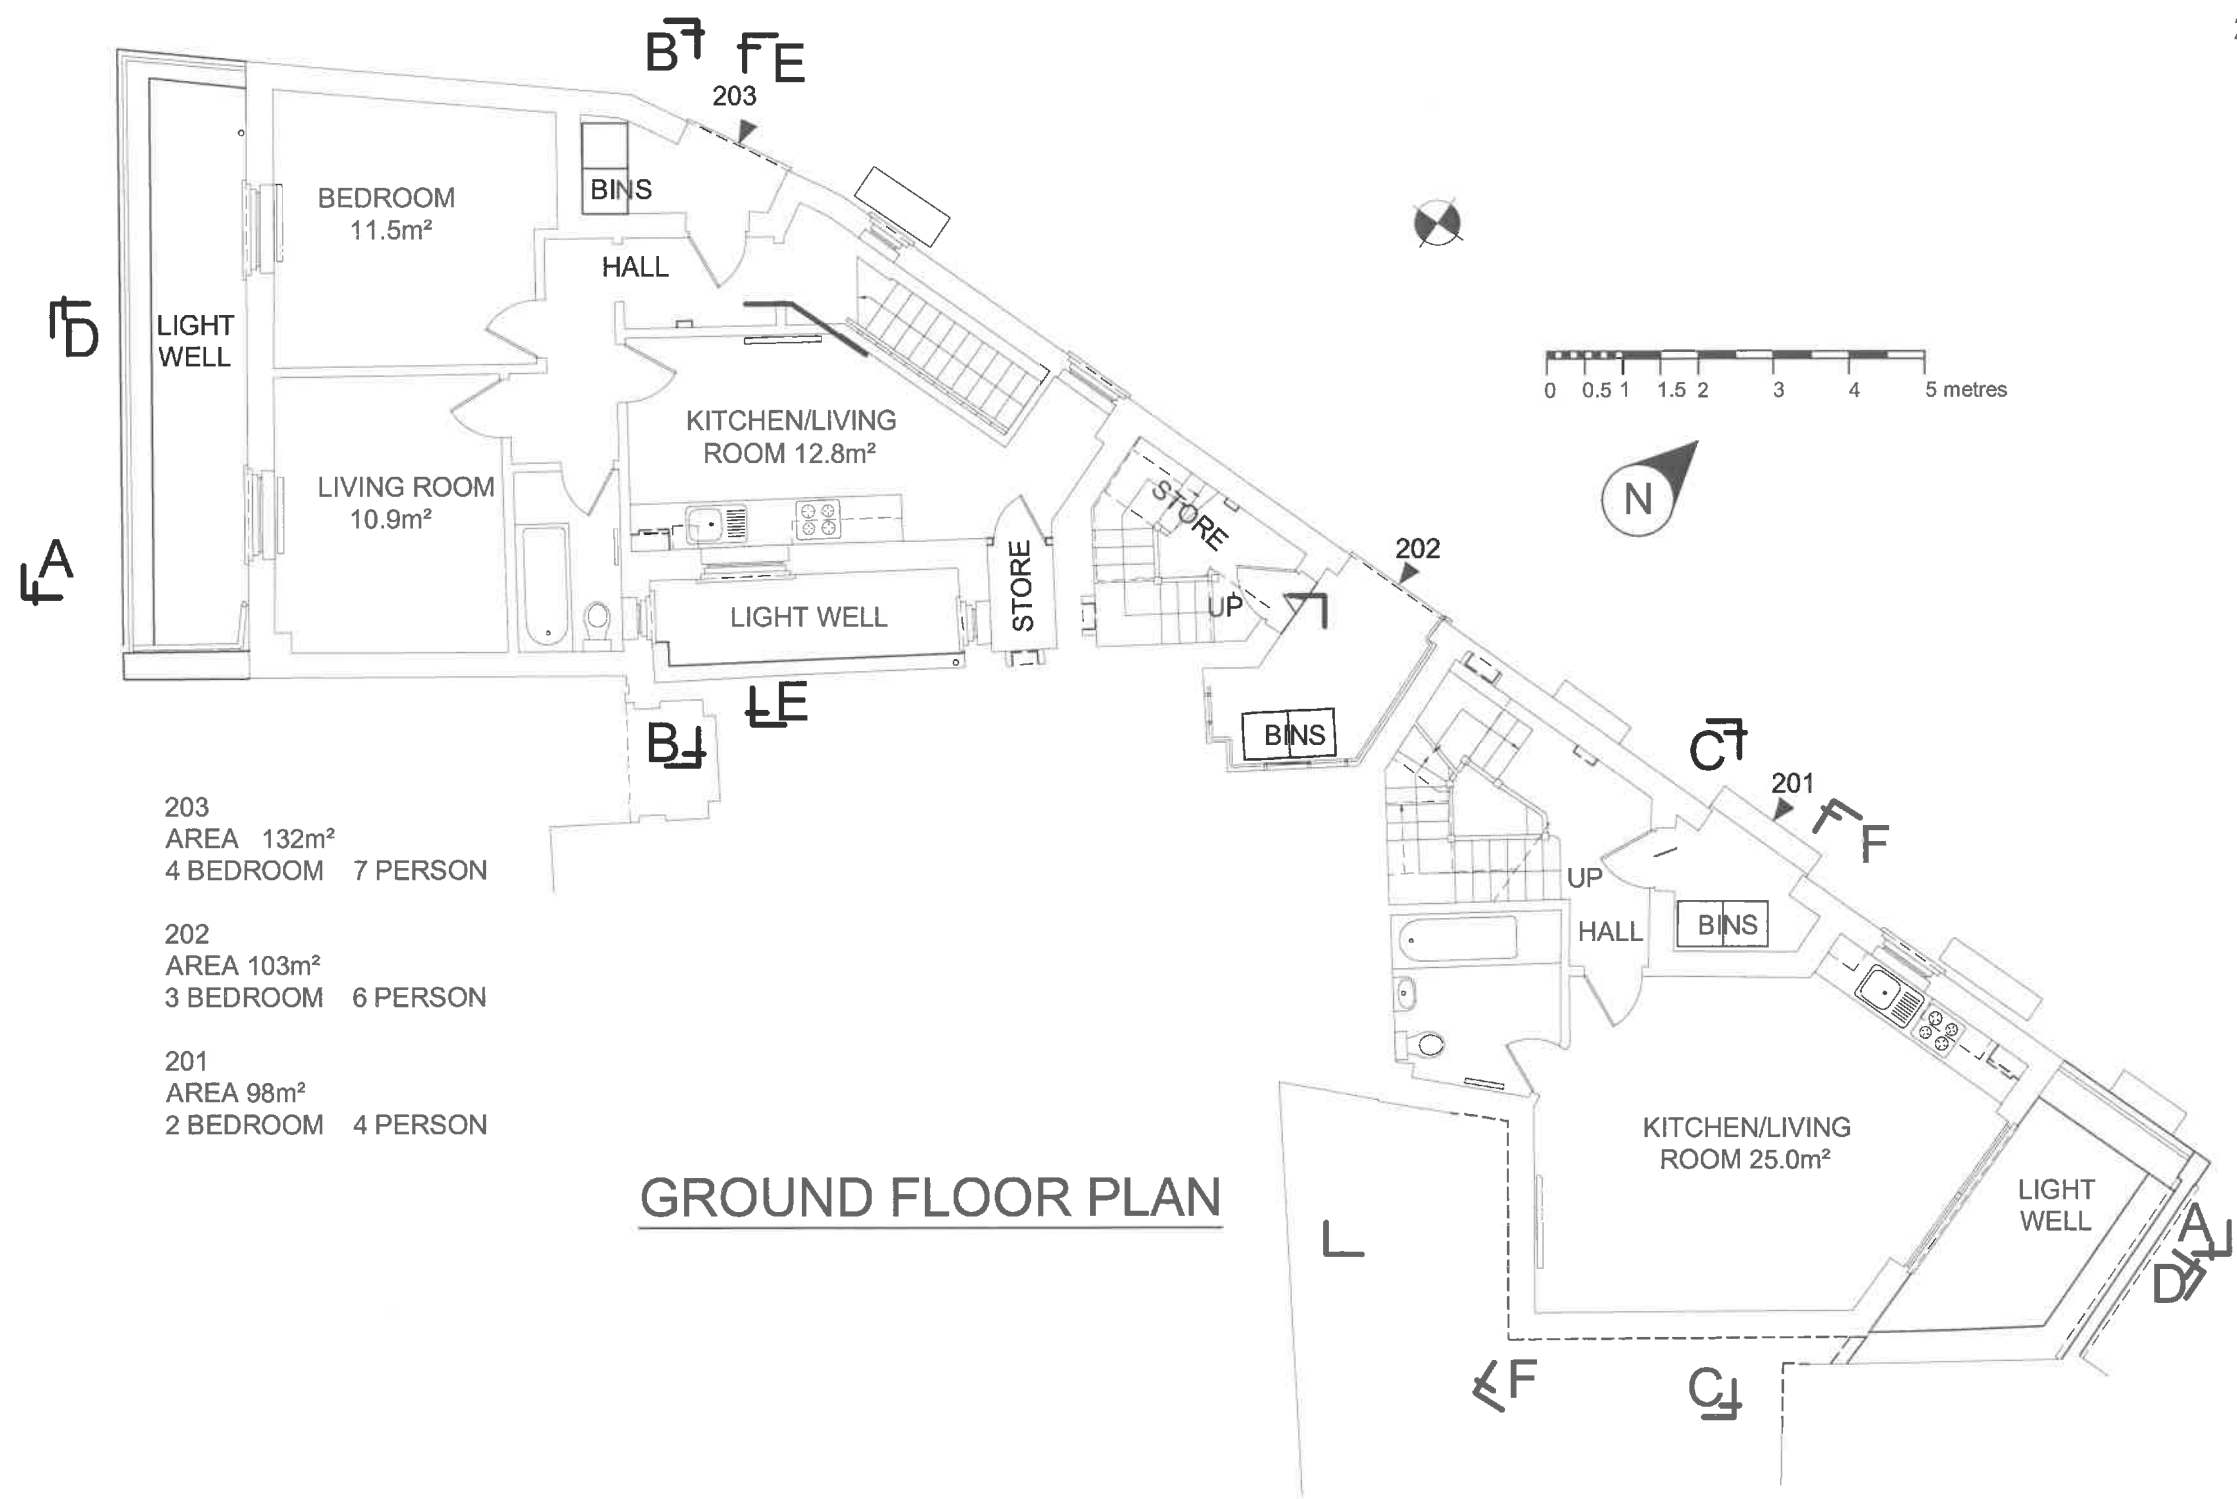

PROPOSED		
F	SECTION MARKS REVISED	MAR 25
E	SECTION LINES ADDED	MAR 25
D	SECTION LINES ADDED	DEC 24
C	TITLE REVISED	NOV 24
B	TITLE REVISED	NOV 24
A	NOTES ADDED	JULY 24

Suffix	Revision	Date										
KLF STRUCTURAL DESIGN LIMITED Consulting Engineers SBC House Wallington SM6 7AH 020 8619 0359 KLF_Structural_Design@yahoo.com												(C)
Job 201 TO 203 PRINCE OF WALES ROAD (FORMERLY 62A HAVERSTOCK HILL) LONDON NW3												
Title PROPOSED GROUND FLOOR PLAN												
Drawn TM		Date JUN 24		Checked		Date		Scale 1:100 @ A3				
Sheet Size A3				Sheet No. 21064/B02								
Revision				A	B	C	D	E	F			

NOTES
1) LOCATION OF SECTIONS SEE DRAWING
NUMBER 21064/B02

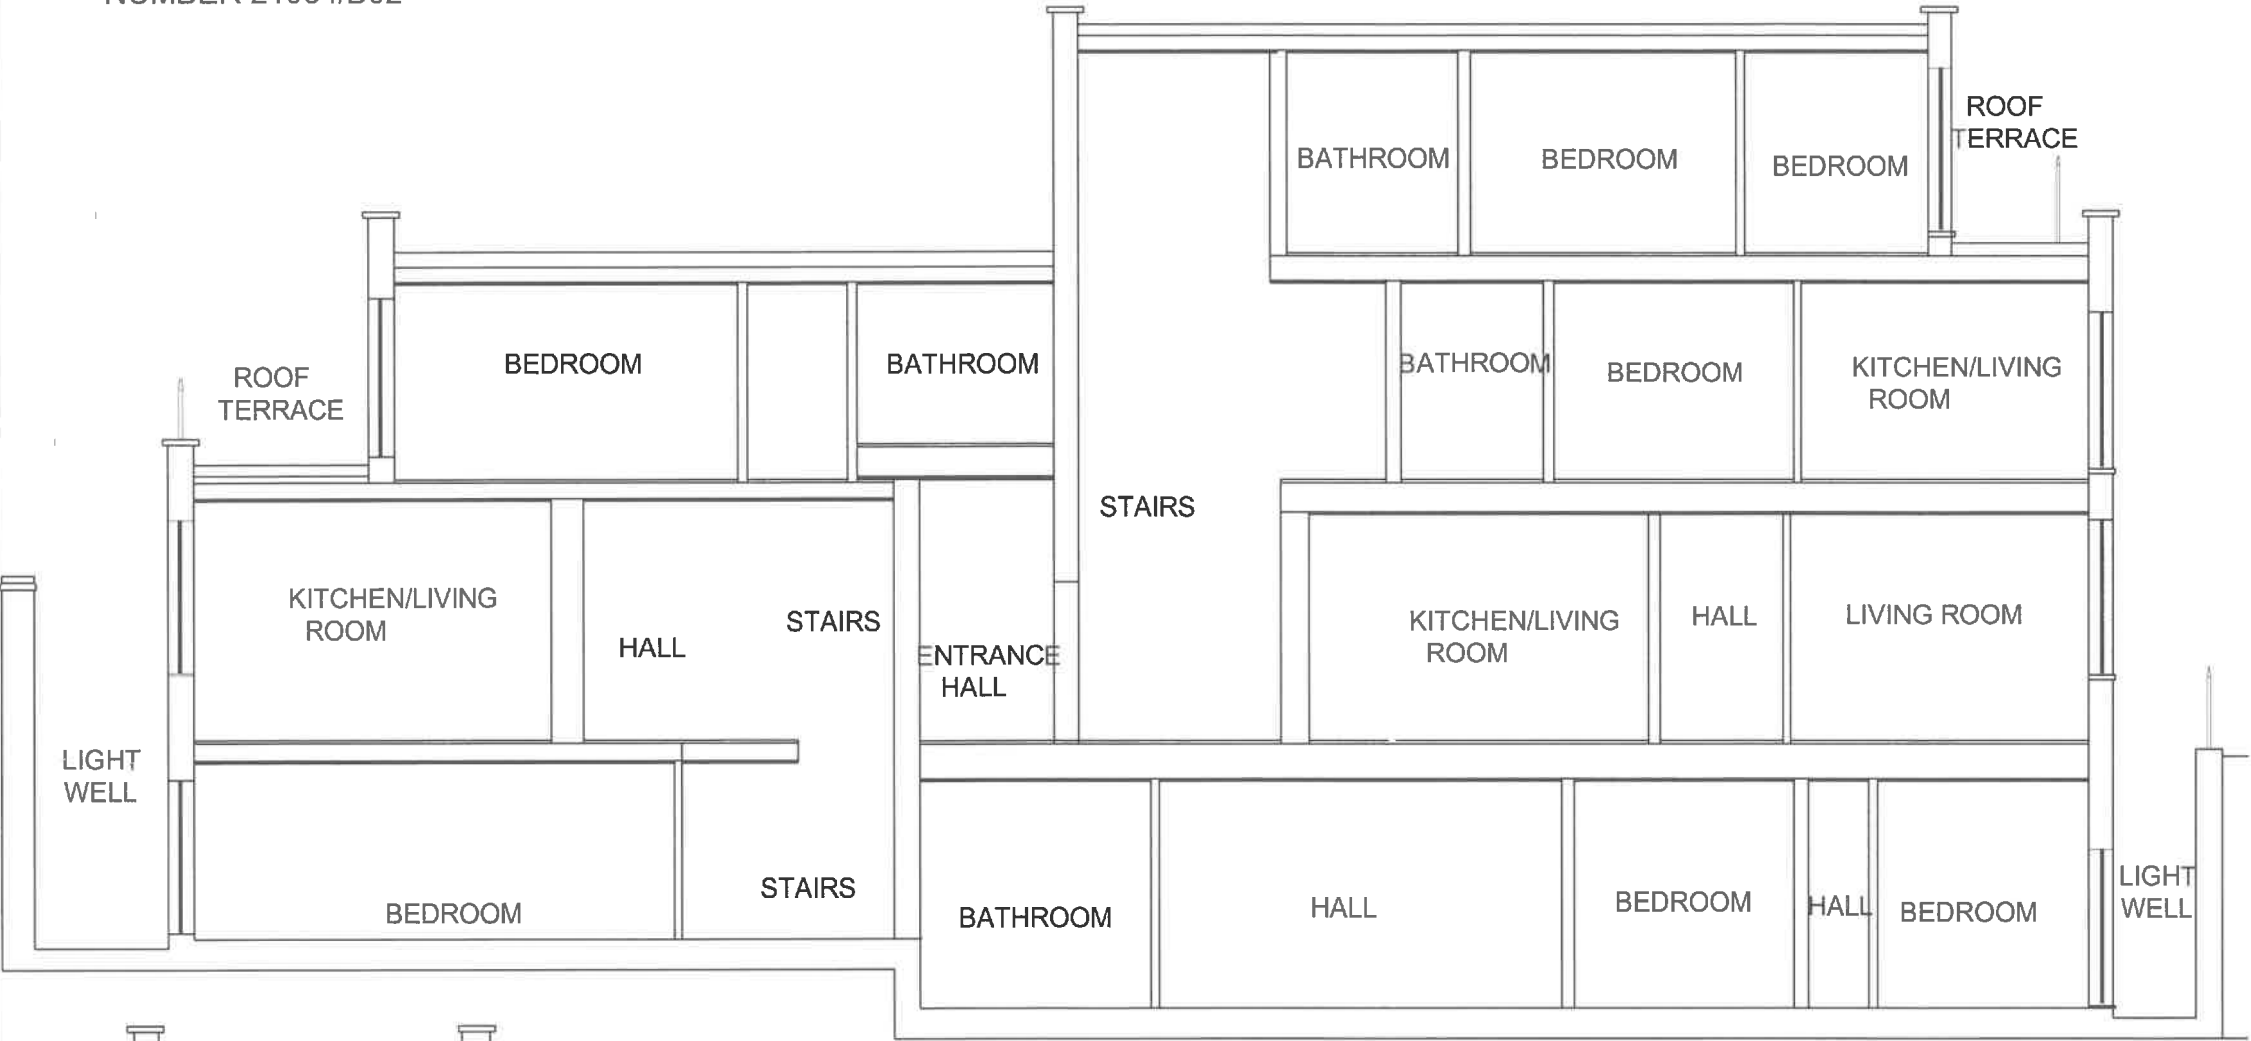

SECTION D - D


SECTION E - E


PROPOSED



SECTION F - F

B		SECTION REFERENCE REVISED		MAR 25
A		SCALE BAR ADDED		MAR 25
Suffix		Revision		Date
KLF STRUCTURAL DESIGN LIMITED Consulting Engineers SBC House Wallington SM6 7AH 020 8619 0359 KLF_Structural_Design@yahoo.com				
				©
Job 201 TO 203 PRINCE OF WALES ROAD (FORMERLY 62A HAVERSTOCK HILL) LONDON NW3				
Title SECTIONS				
Drawn TM	Date DEC 24	Checked	Date	Scale 1:100 @ A3
Sheet Size A3		Sheet No. 21064/E05		
Revision		A	B	

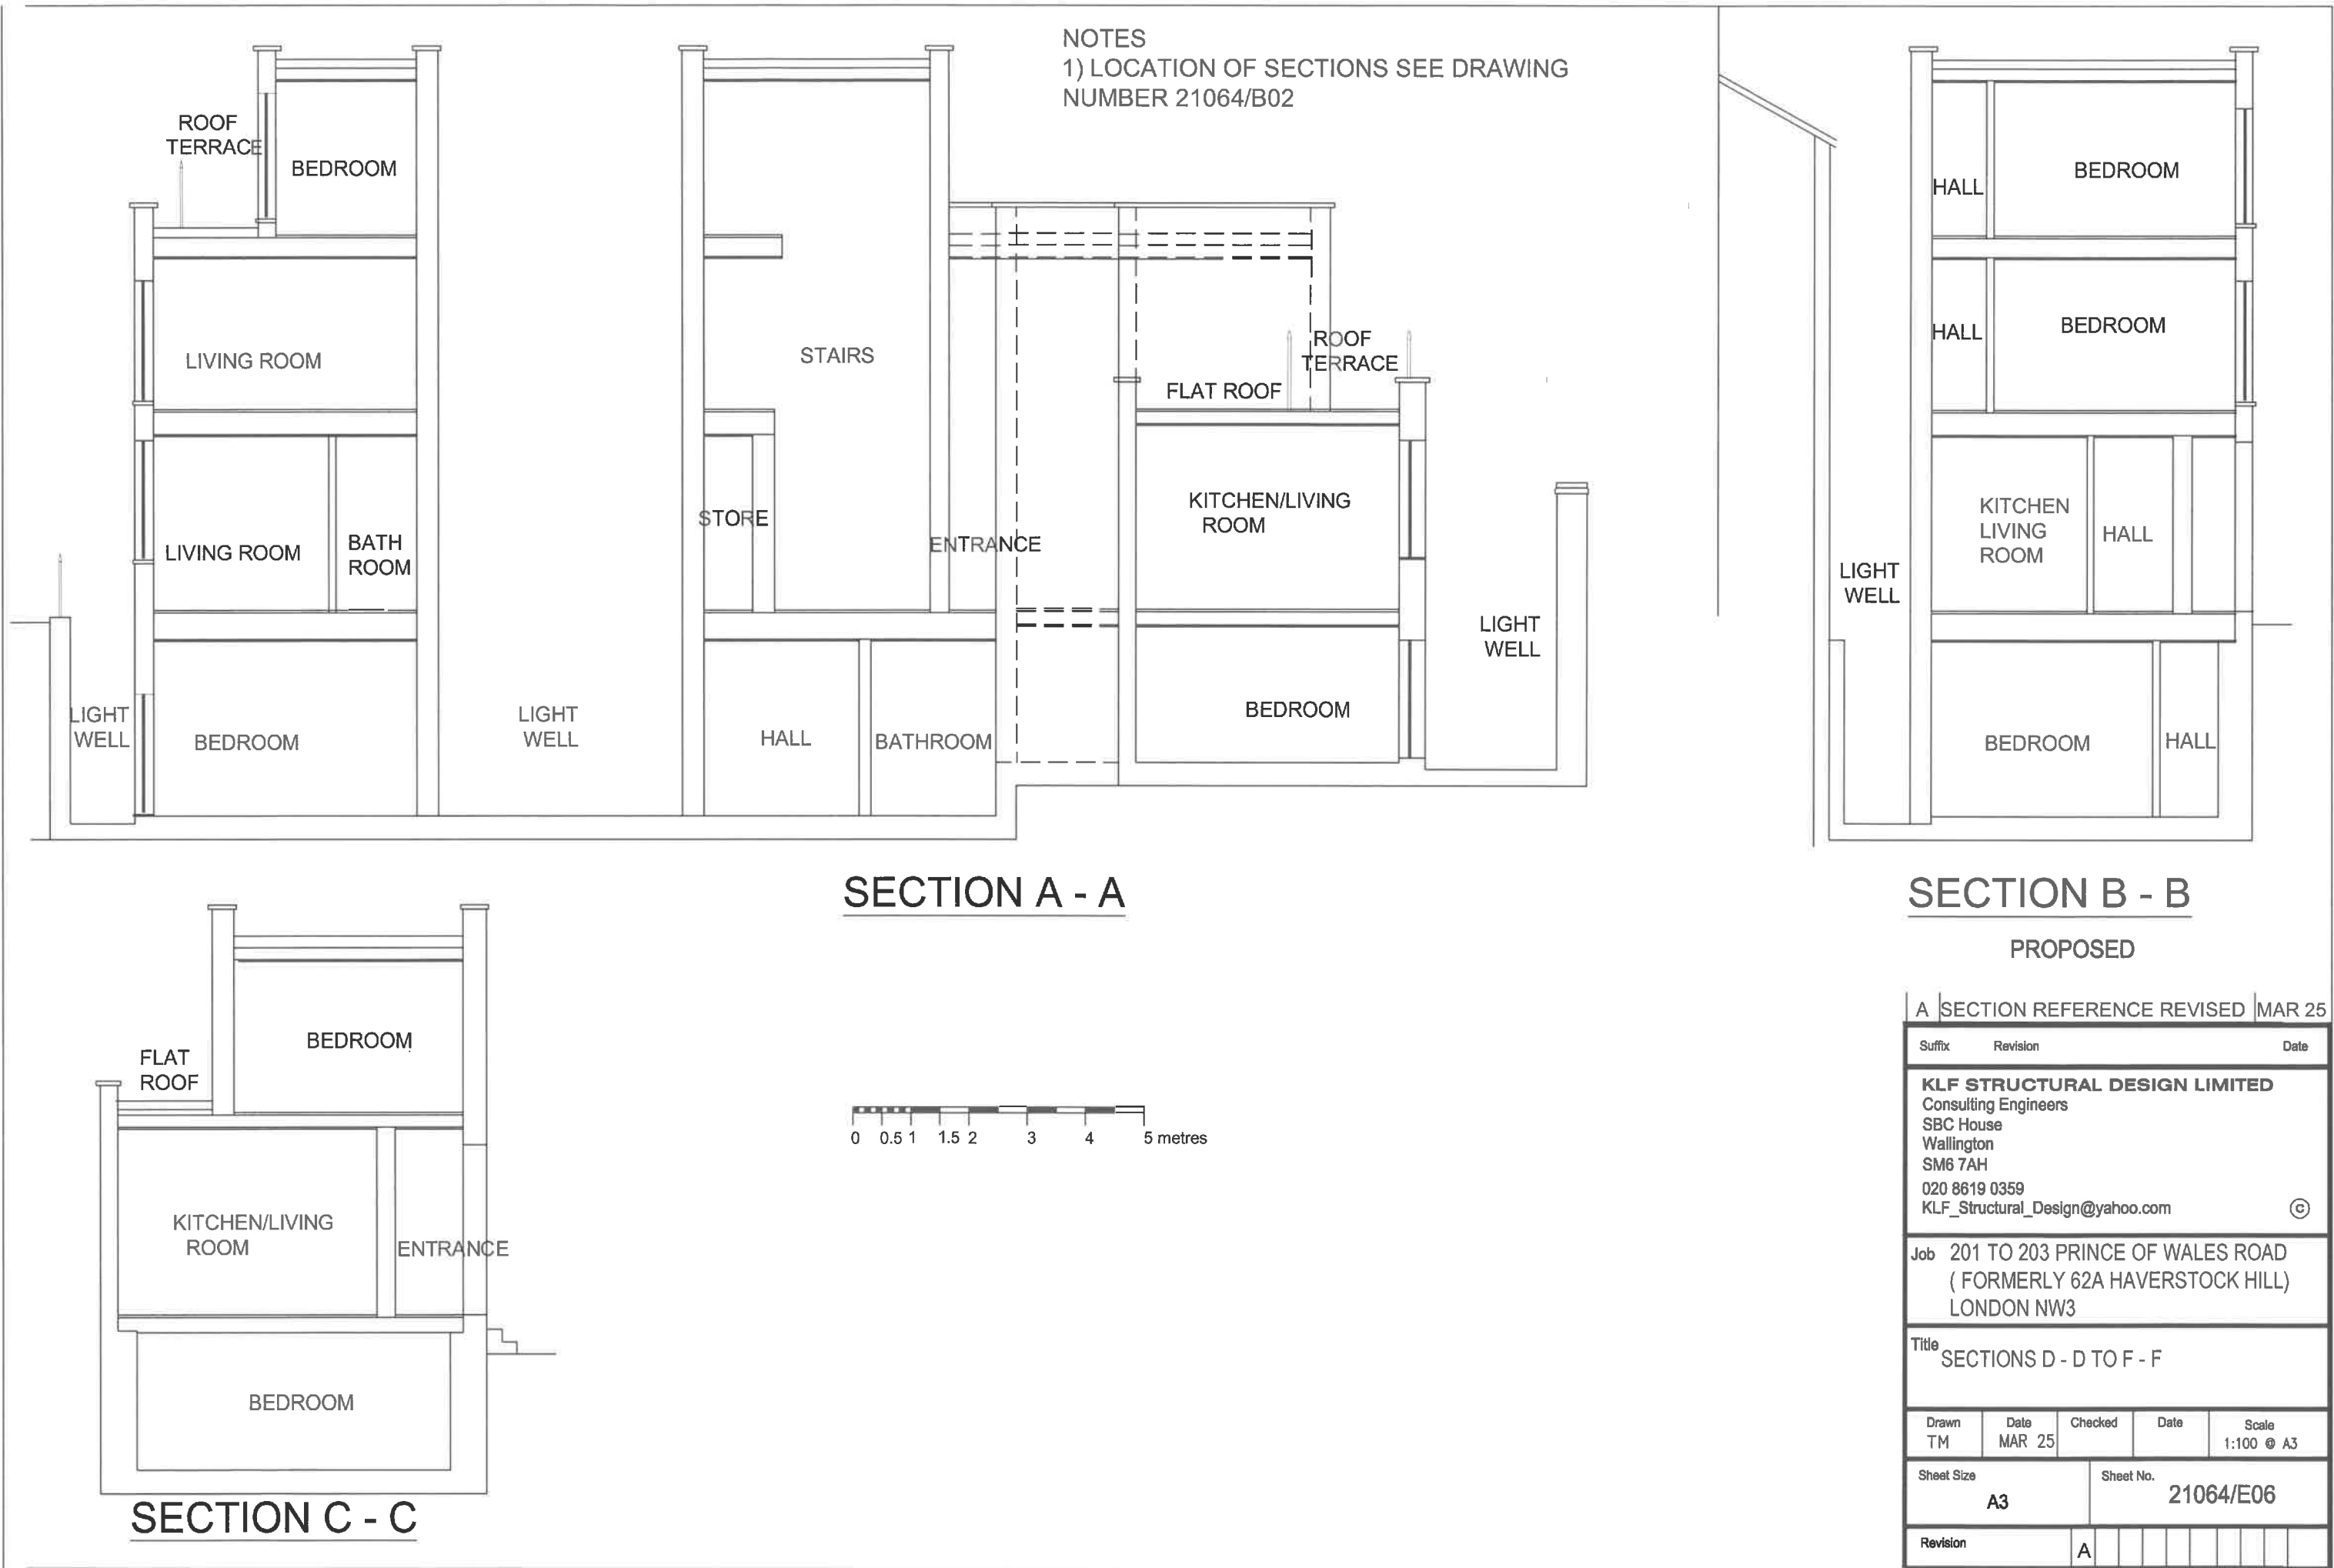

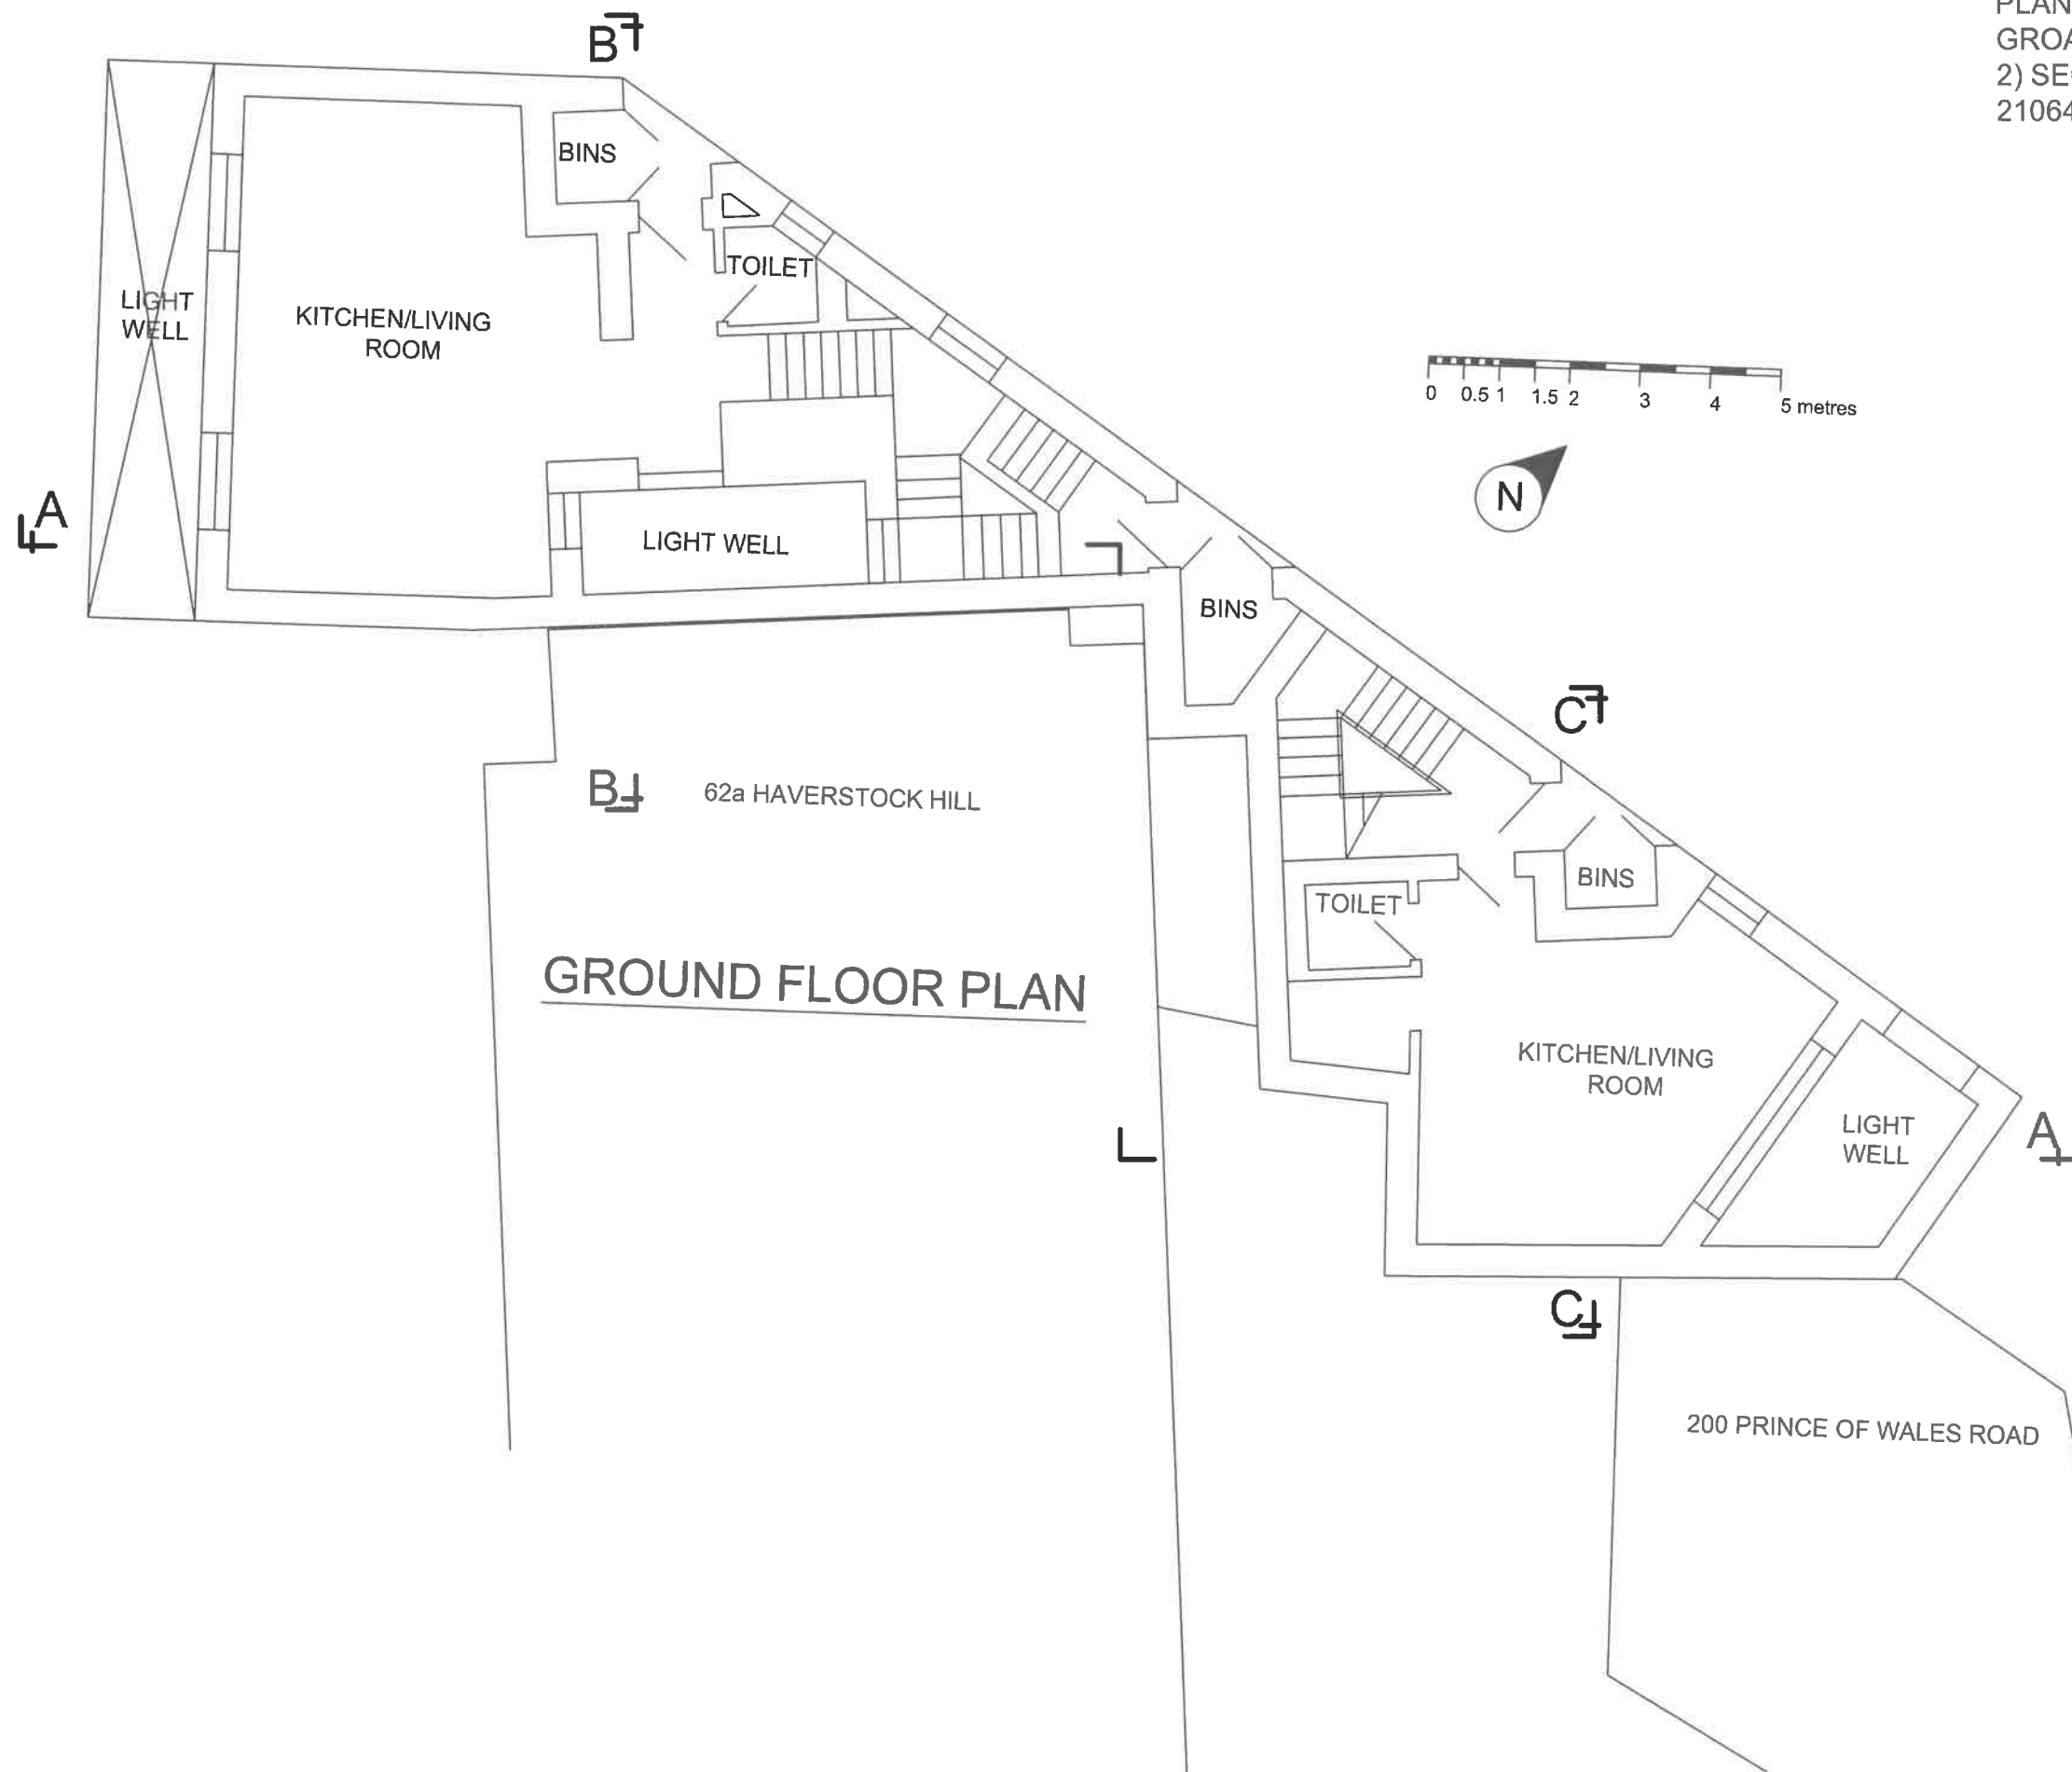

NOTES
1) THIS DRAWING IS BASED ON THE APPROVED
PLANNING DRAWING PRODUCED BY CARMODY
GROARKE DRAWING NUMBER 126_P_22_01 P9
2) SECTIONS SEE DRAWING NUMBERS
21064/A05 AND C07 TO C11


GROUND FLOOR PLAN

ORIGINAL PLANNING PLAN

C	NOTES REVISED	MAR 25
B	SECTION MARKS ADDED	JAN 25
A	TITLE REVISED	NOV 24

Suffix		Revision		Date											
KLF STRUCTURAL DESIGN LIMITED Consulting Engineers SBC House Wallington SM6 7AH 020 8619 0359 KLF_Structural_Design@yahoo.com						(C)									
Job 201 TO 203 PRINCE OF WALES ROAD (FORMERLY 62A HAVERSTOCK HILL) LONDON NW3															
Title ORIGINAL PLANNING DRAWING GROUND FLOOR PLAN															
Drawn TM		Date OCT 24		Checked		Date		Scale 1:100 @ A3							
Sheet Size A3				Sheet No. 21064/A02											
Revision				A		B		C							

NOTES
1) LOCATION OF SECTIONS SEE DRAWING
NUMBER 21064/B02 AND A02

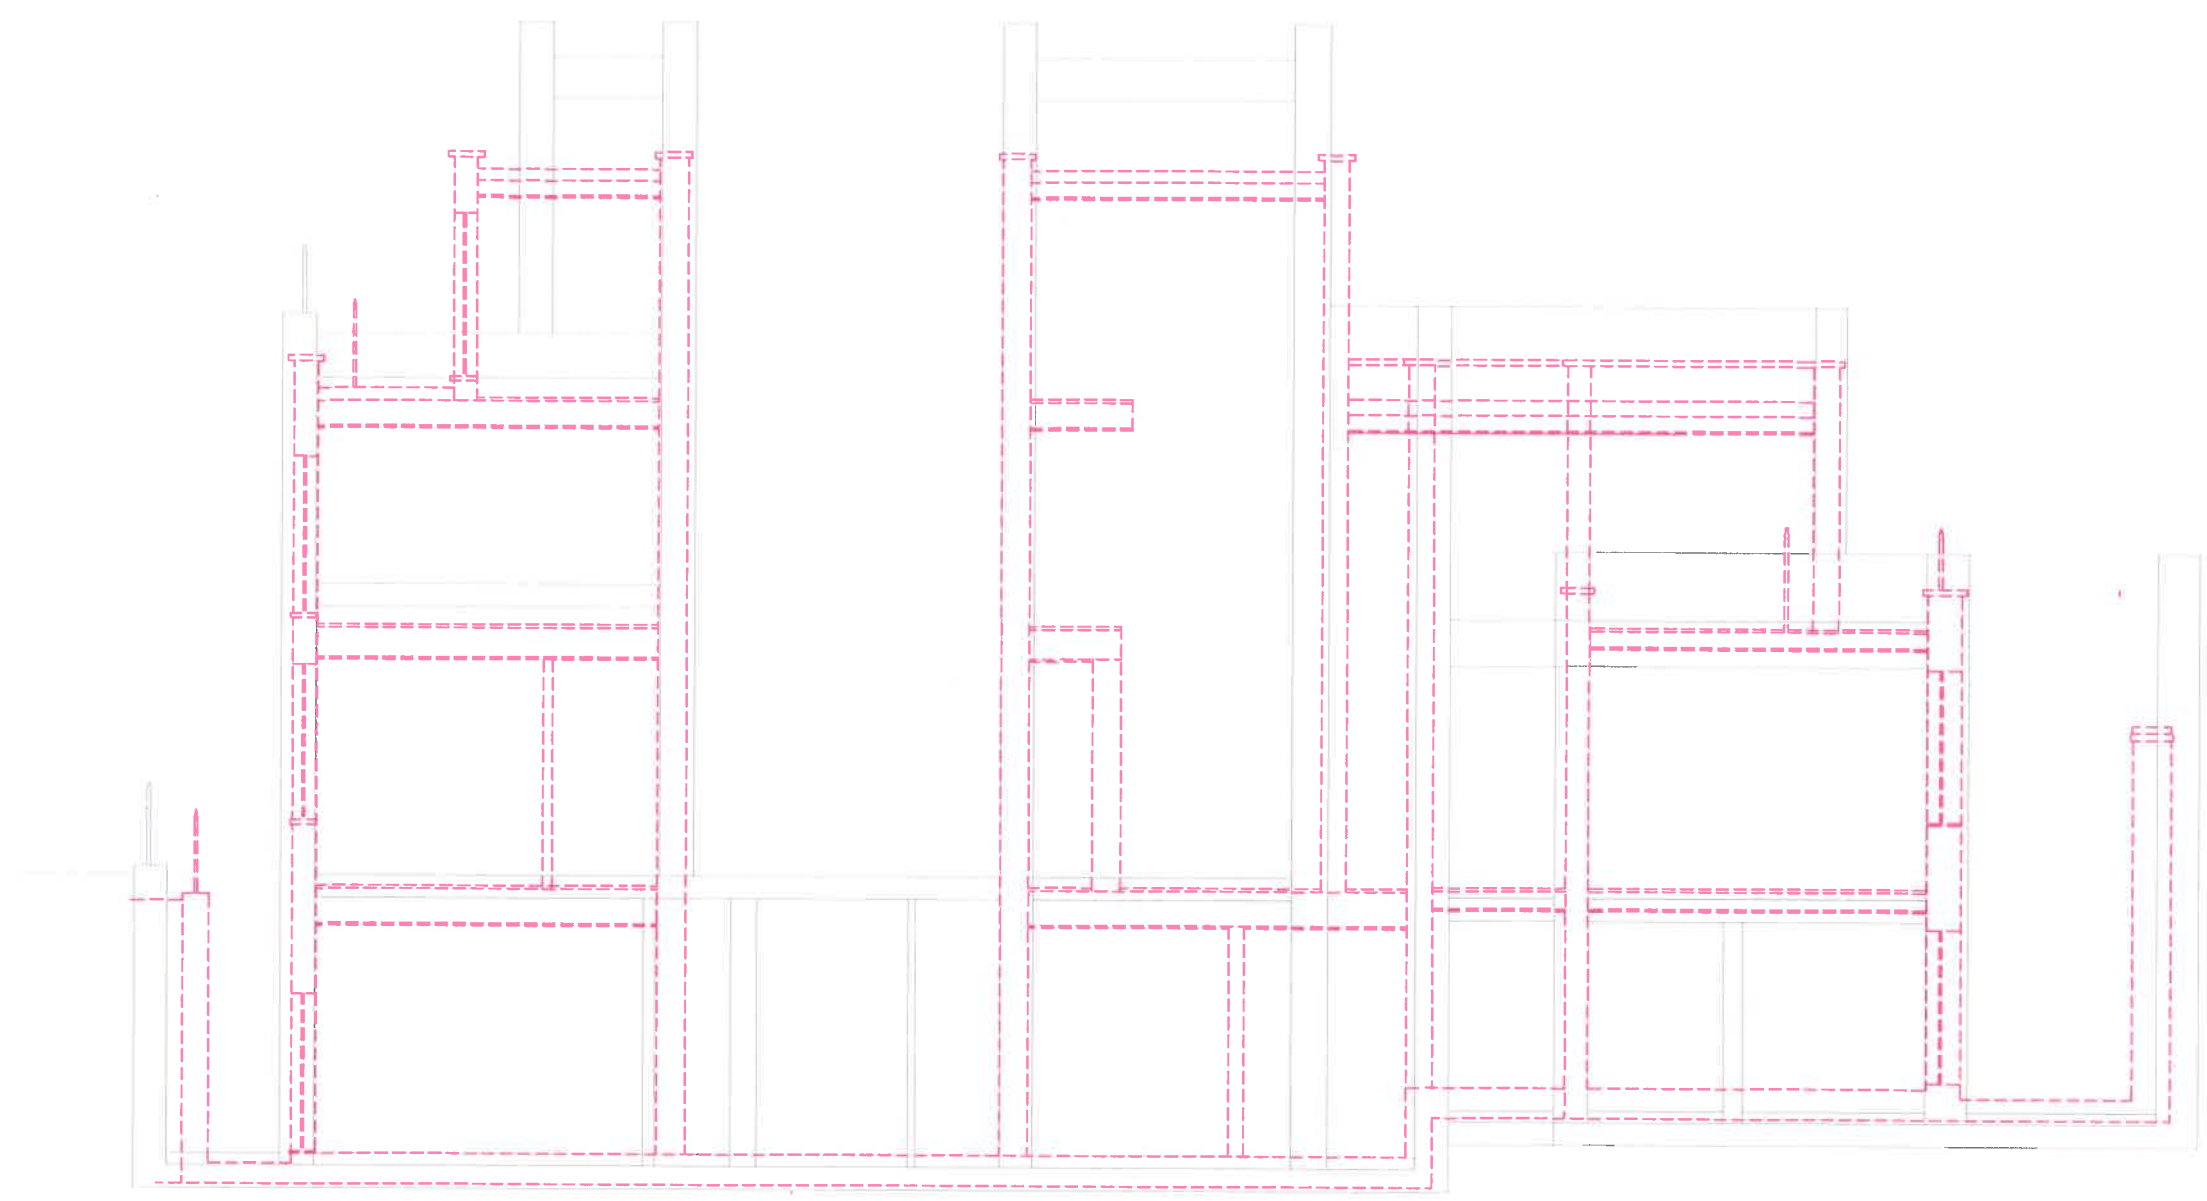


SECTION A - A




ORIGINAL PLANNING/PROPOSED

Suffix	Revision	Date
KLF STRUCTURAL DESIGN LIMITED Consulting Engineers SBC House Wallington SM6 7AH 020 8619 0359 KLF_Structural_Design@yahoo.com		
Job 201 TO 203 PRINCE OF WALES ROAD (FORMERLY 62A HAVERSTOCK HILL) LONDON NW3		
Title ORIGINAL PLANNING/AS BUILT OVERLAY SECTION A - A		
Drawn TM	Date MAR 25	Checked Date Scale 1:100 @ A3
Sheet Size A3		Sheet No. 21064/C07
Revision		

NOTES
1) LOCATION OF SECTIONS SEE DRAWING
NUMBER 21064/B02 AND A02

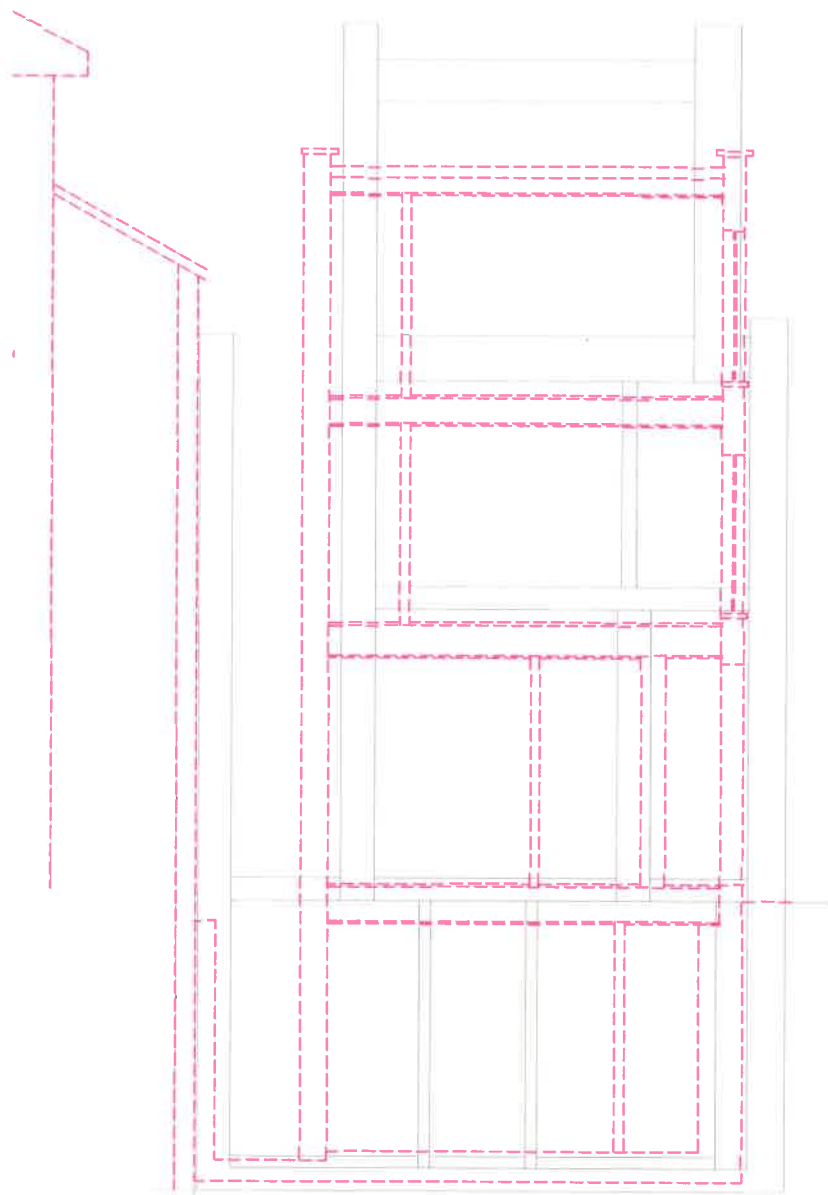

SECTION B - B

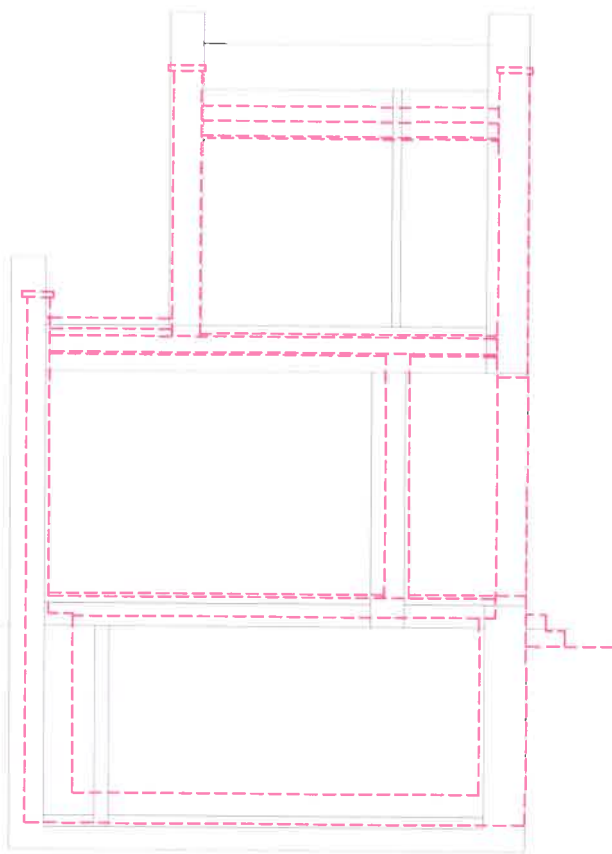


SECTION C - C



ORIGINAL PLANNING/PROPOSED

Suffix	Revision	Date
KLF STRUCTURAL DESIGN LIMITED Consulting Engineers SBC House Wallington SM6 7AH 020 8619 0359 KLF_Structural_Design@yahoo.com		
©		
Job 201 TO 203 PRINCE OF WALES ROAD (FORMERLY 62A HAVERSTOCK HILL) LONDON NW3		
Title ORIGINAL PLANNING/AS BUILT OVERLAY SECTIONS B - B AND C - C		
Drawn TM	Date MAR 25	Checked Date Scale 1:100 @ A3
Sheet Size A3		Sheet No. 21064/C08
Revision		

NOTES
1) LOCATION OF SECTION SEE DRAWING
NUMBER 21064/A02

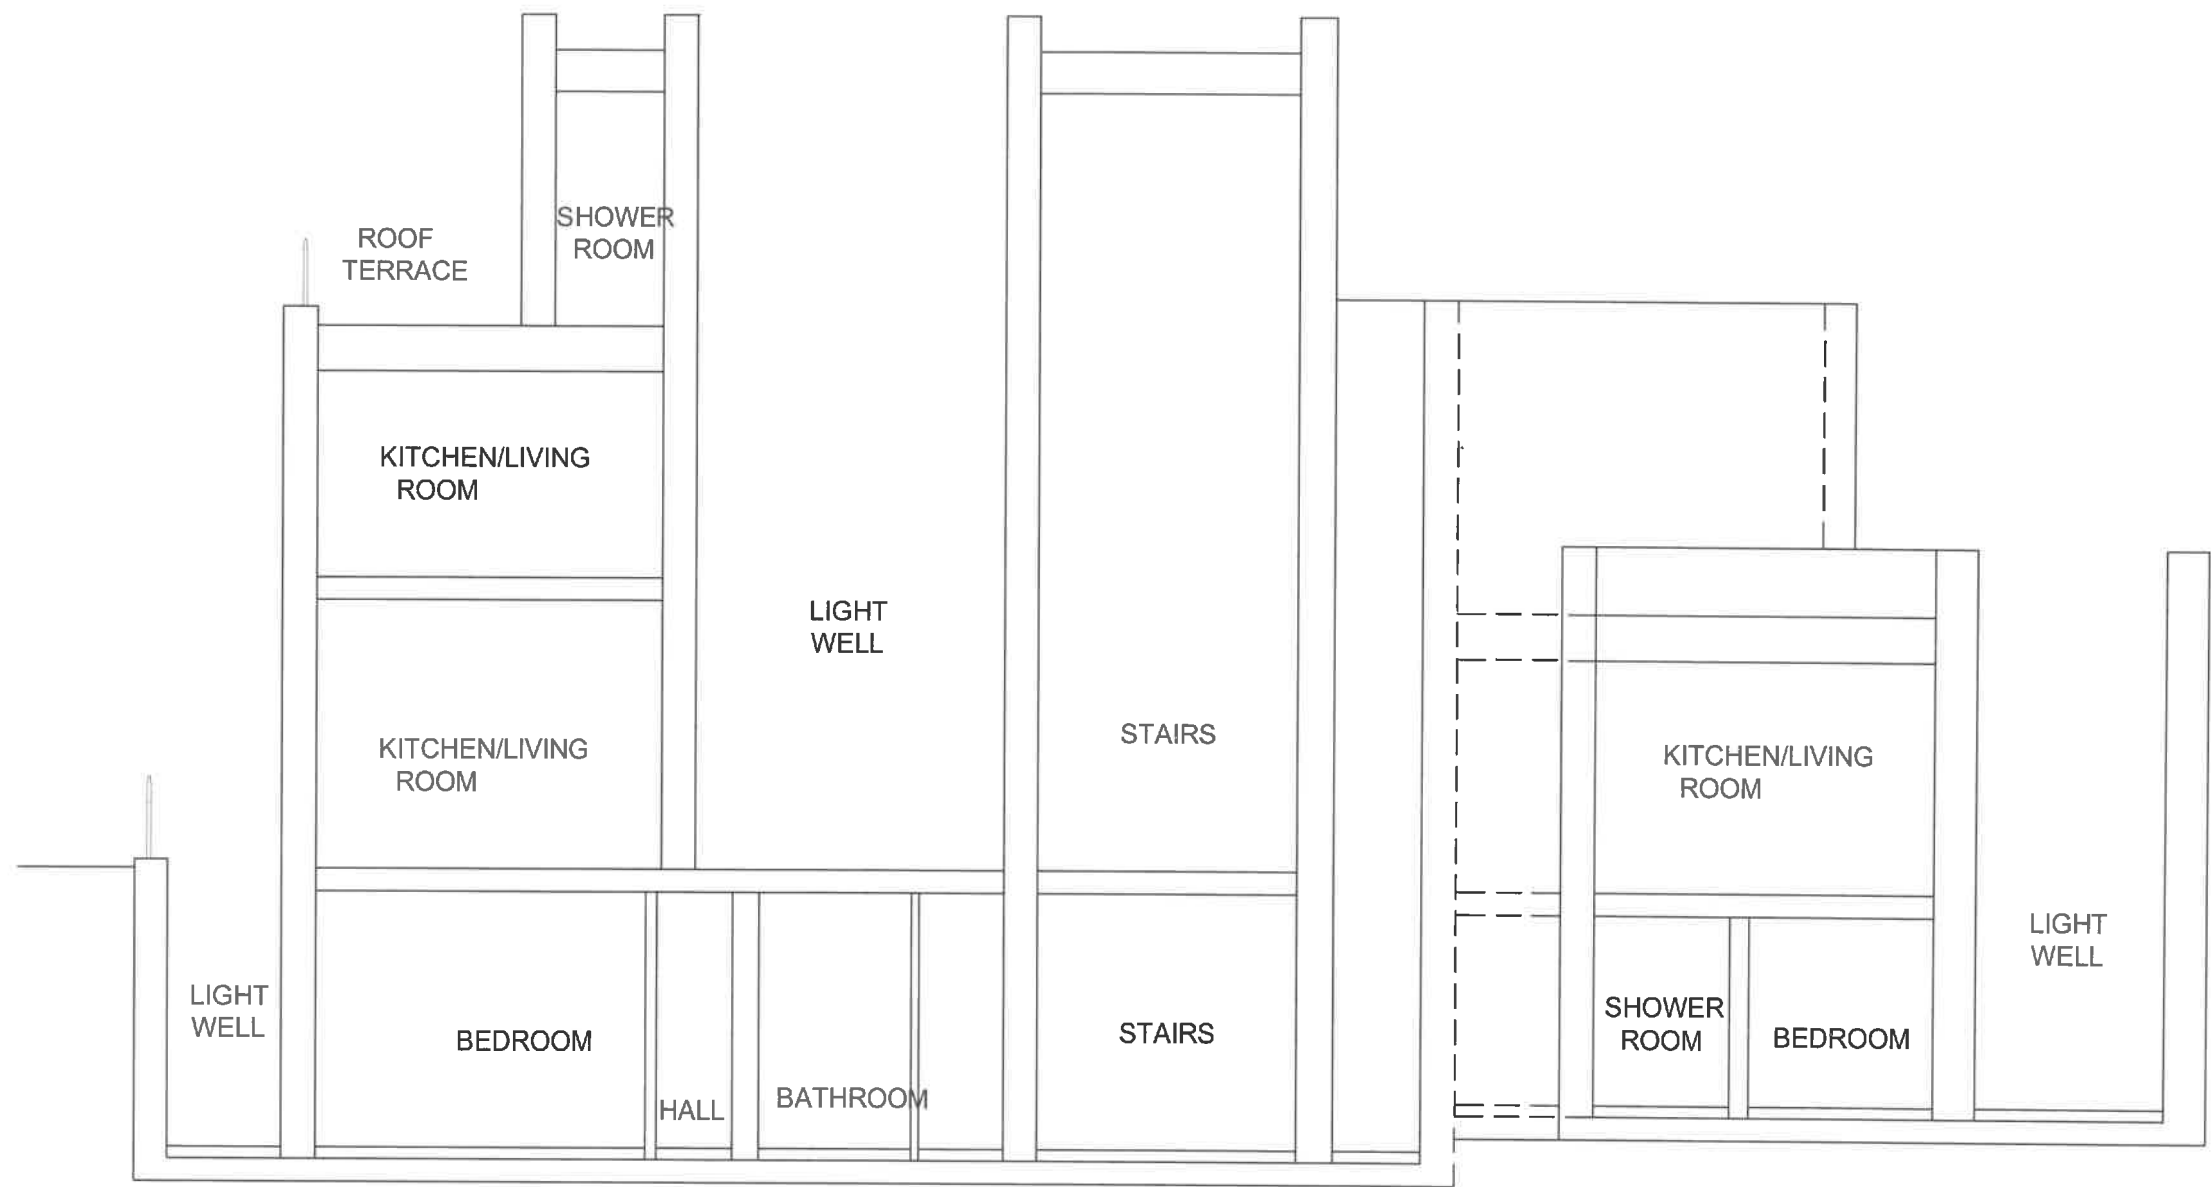


SECTION A - A (ORIGINAL PLANNING)



ORIGINAL PLANNING/PROPOSED

Suffix	Revision	Date
KLF STRUCTURAL DESIGN LIMITED Consulting Engineers SBC House Wallington SM6 7AH 020 8619 0359 KLF_Structural_Design@yahoo.com		
Job 201 TO 203 PRINCE OF WALES ROAD (FORMERLY 62A HAVERSTOCK HILL) LONDON NW3		
Title ORIGINAL PLANNING SECTION A - A		
Drawn TM	Date MAR 25	Checked Date Scale 1:100 @ A3
Sheet Size A3		Sheet No. 21064/C09
Revision		

NOTES
1) LOCATION OF SECTIONS SEE DRAWING
NUMBER 21064/B02

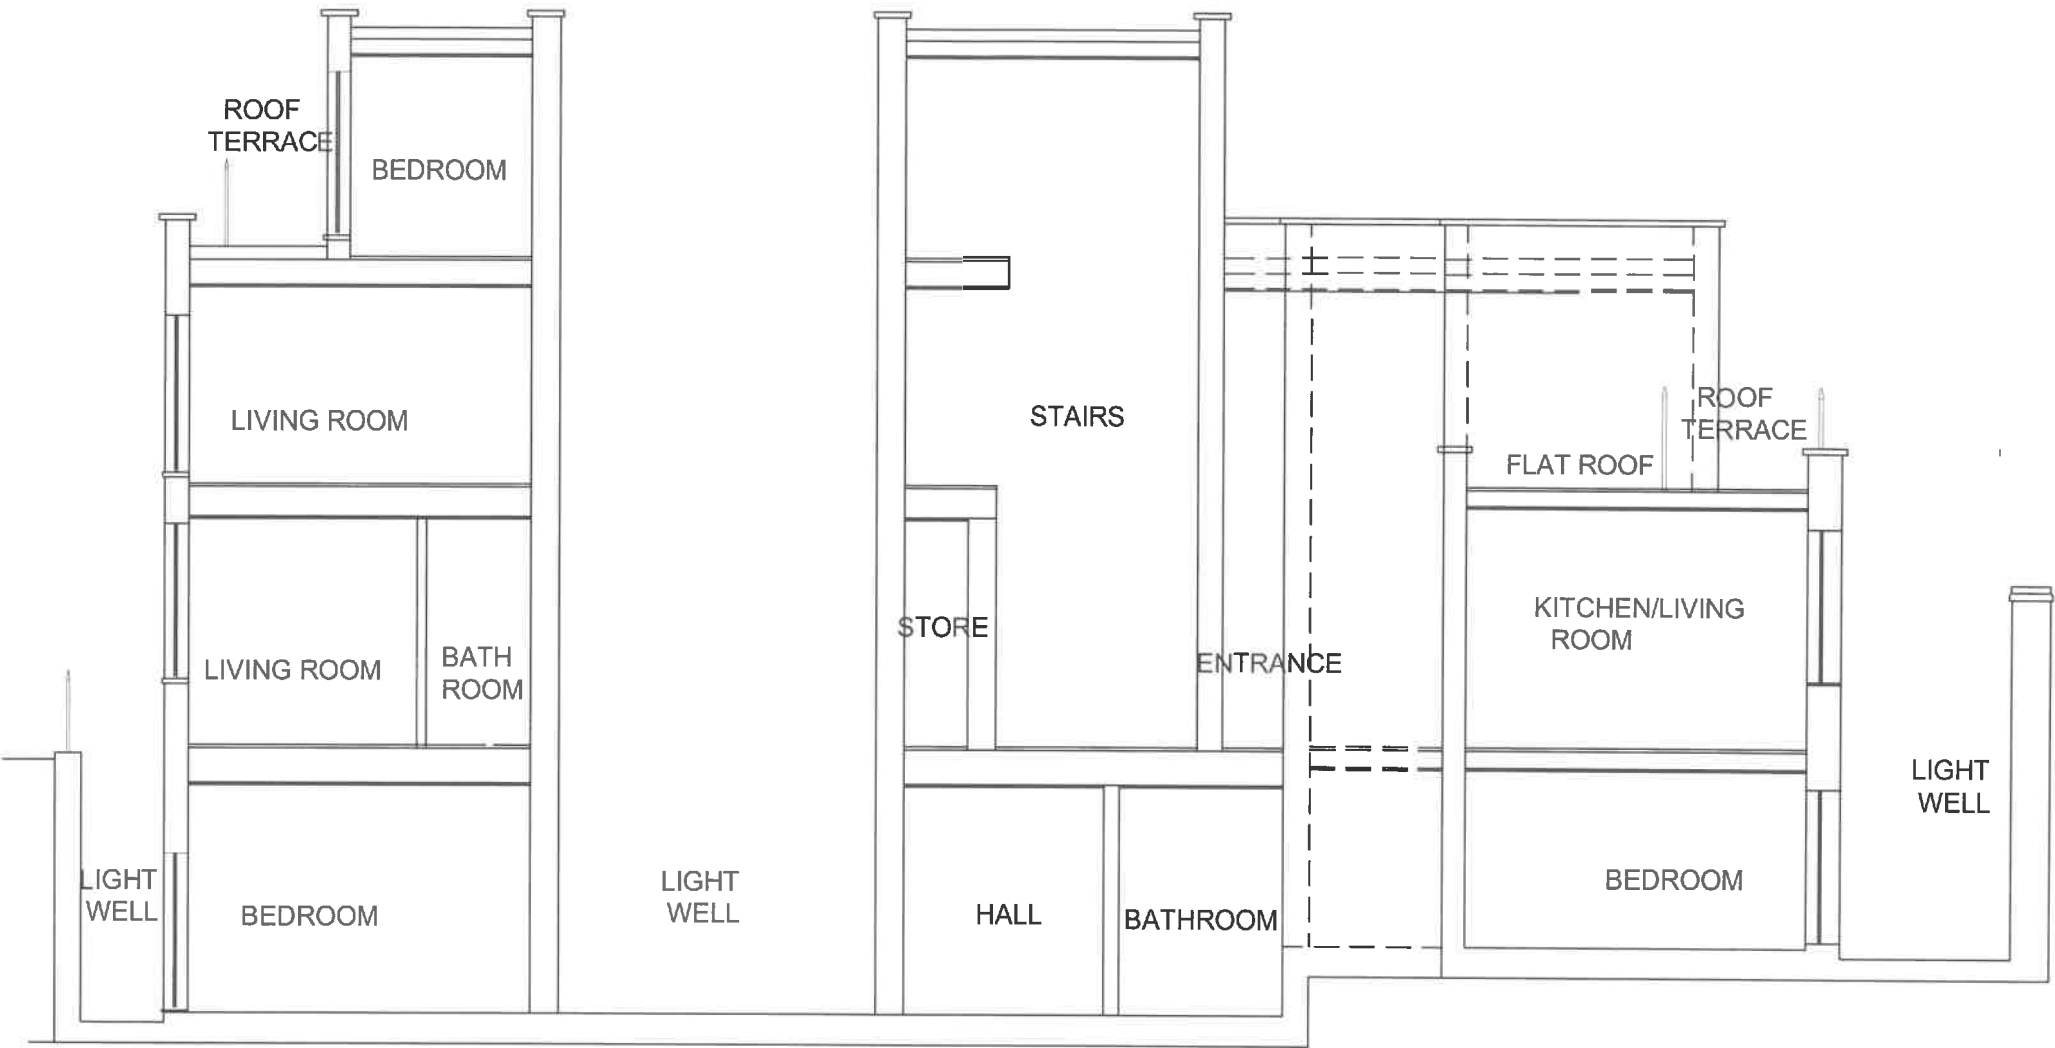


SECTION A - A (PROPOSED/AS BUILT)




PROPOSED

Suffix		Revision		Date	
KLF STRUCTURAL DESIGN LIMITED Consulting Engineers SBC House Wallington SM6 7AH 020 8619 0359 KLF_Structural_Design@yahoo.com					
					©
Job 201 TO 203 PRINCE OF WALES ROAD (FORMERLY 62A HAVERSTOCK HILL) LONDON NW3					
Title PROPOSED/AS BUILT SECTION A - A					
Drawn TM		Date MAR 25		Checked Date Scale 1:100 @ A3	
Sheet Size A3			Sheet No. 21064/C10		
Revision					


NOTES
1) LOCATION OF SECTIONS SEE DRAWING
NUMBER 21064/B02 AND A02

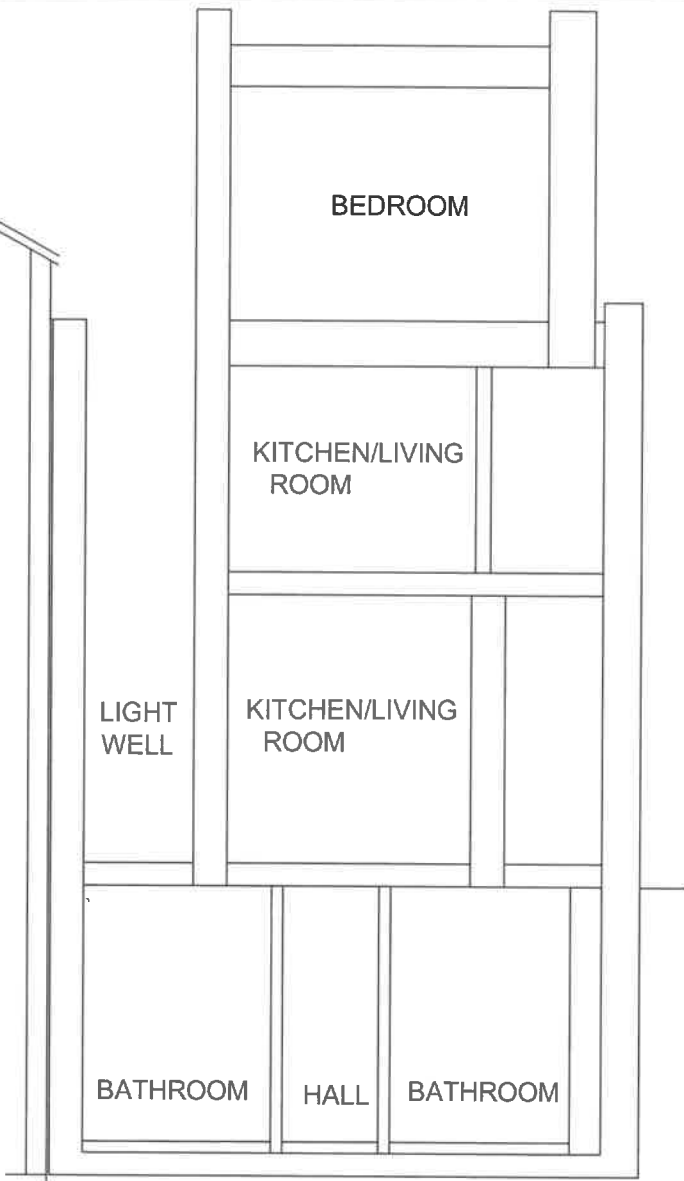

SECTION B - B
(ORIGINAL PLANNING)

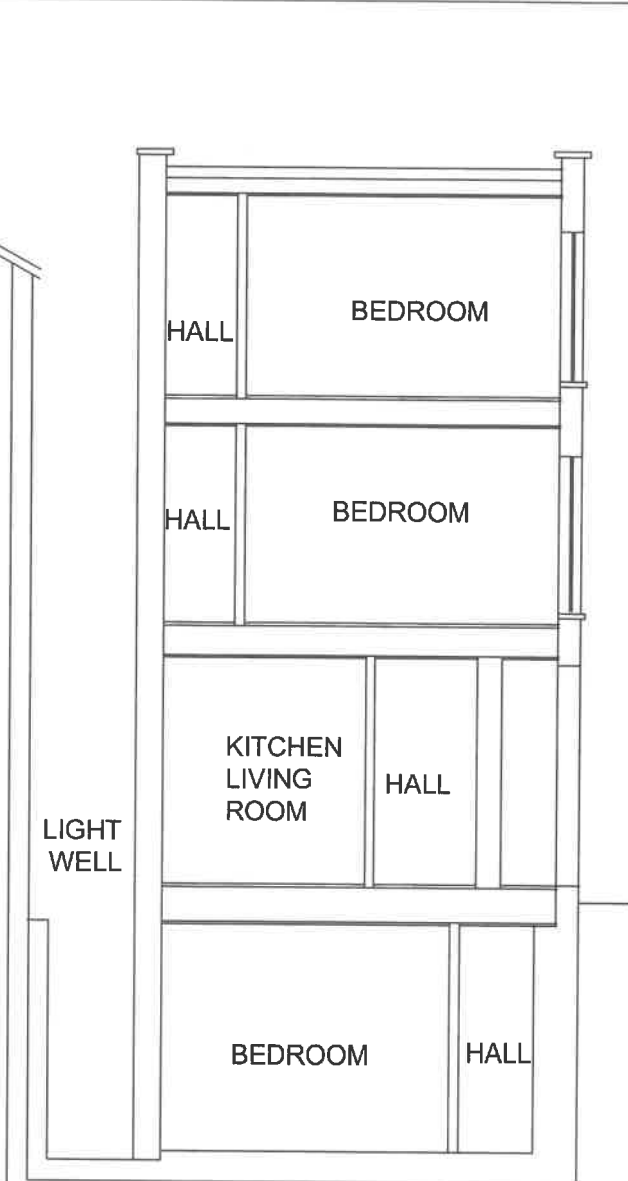

SECTION B - B
(PROPOSED/AS BUILT)

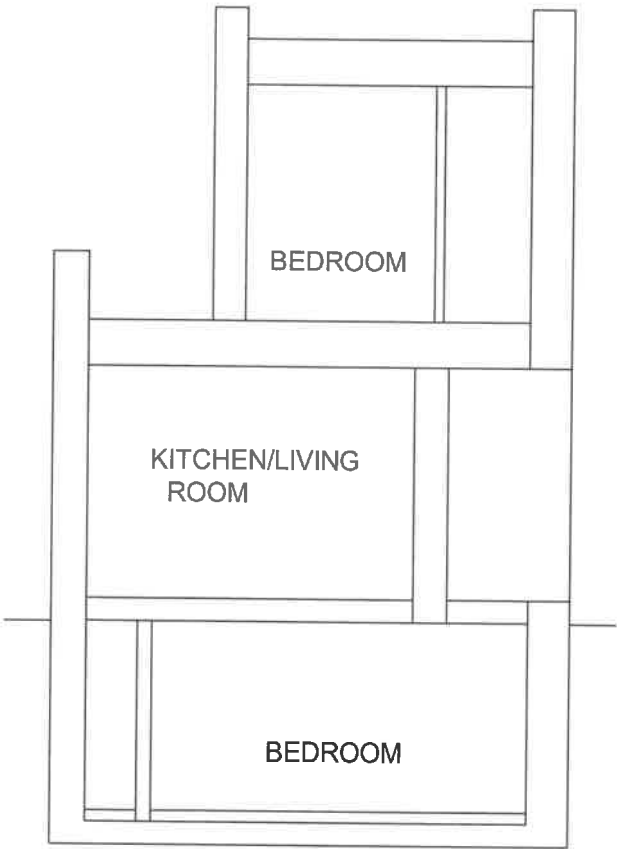

SECTION C - C
(ORIGINAL PLANNING)



SECTION C - C
(PROPOSED/AS BUILT)



ORIGINAL PLANNING/PROPOSED

Suffix	Revision	Date
KLF STRUCTURAL DESIGN LIMITED Consulting Engineers SBC House Wallington SM6 7AH 020 8619 0359 KLF_Structural_Design@yahoo.com		
Job 201 TO 203 PRINCE OF WALES ROAD (FORMERLY 62A HAVERSTOCK HILL) LONDON NW3		
Title ORIGINAL PLANNING/AS BUILT SECTIONS B - B AND C - C		
Drawn TM	Date MAR 25	Checked Date Scale 1:100 @ A3
Sheet Size A3		Sheet No. 21064/C11
Revision		