



This drawing should be read in conjunction with all drawings prepared as part of the detail design package. Ensure site dimensions are checked prior to manufacture and installation. Ensure all joinery is restrained to structural envelope as necessary. All finishes to be applied as manufacturers instructions.


These drawings are for design intent purposes only. Contractor to develop construction design accordingly.

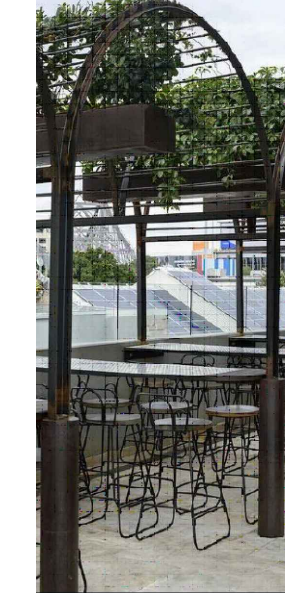

Reference Image

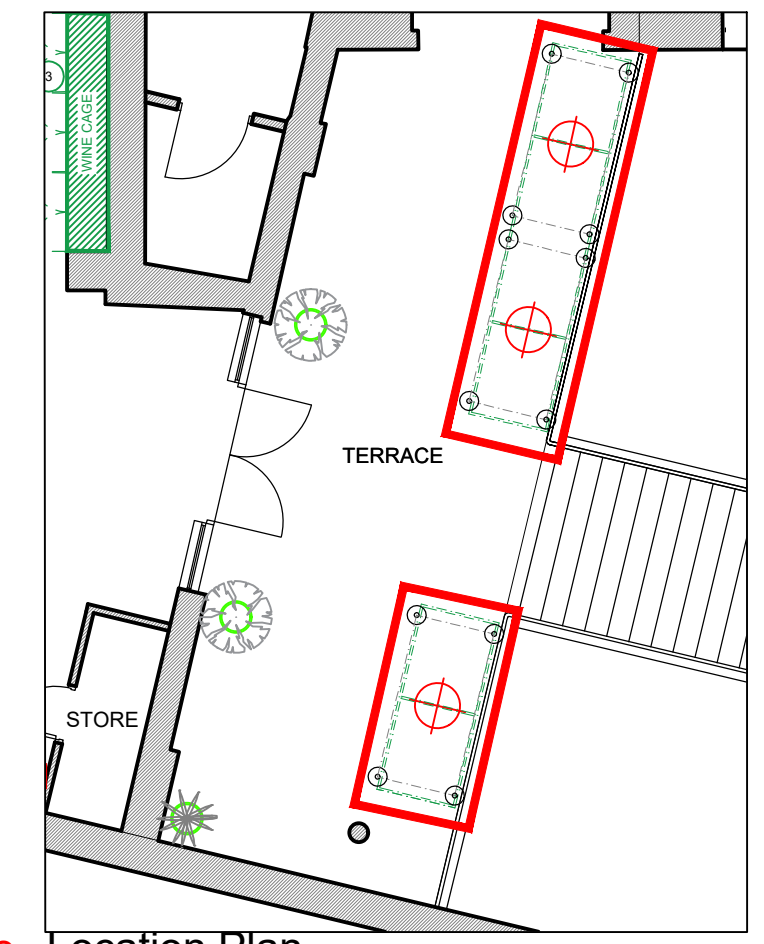


Location Plan
1:100

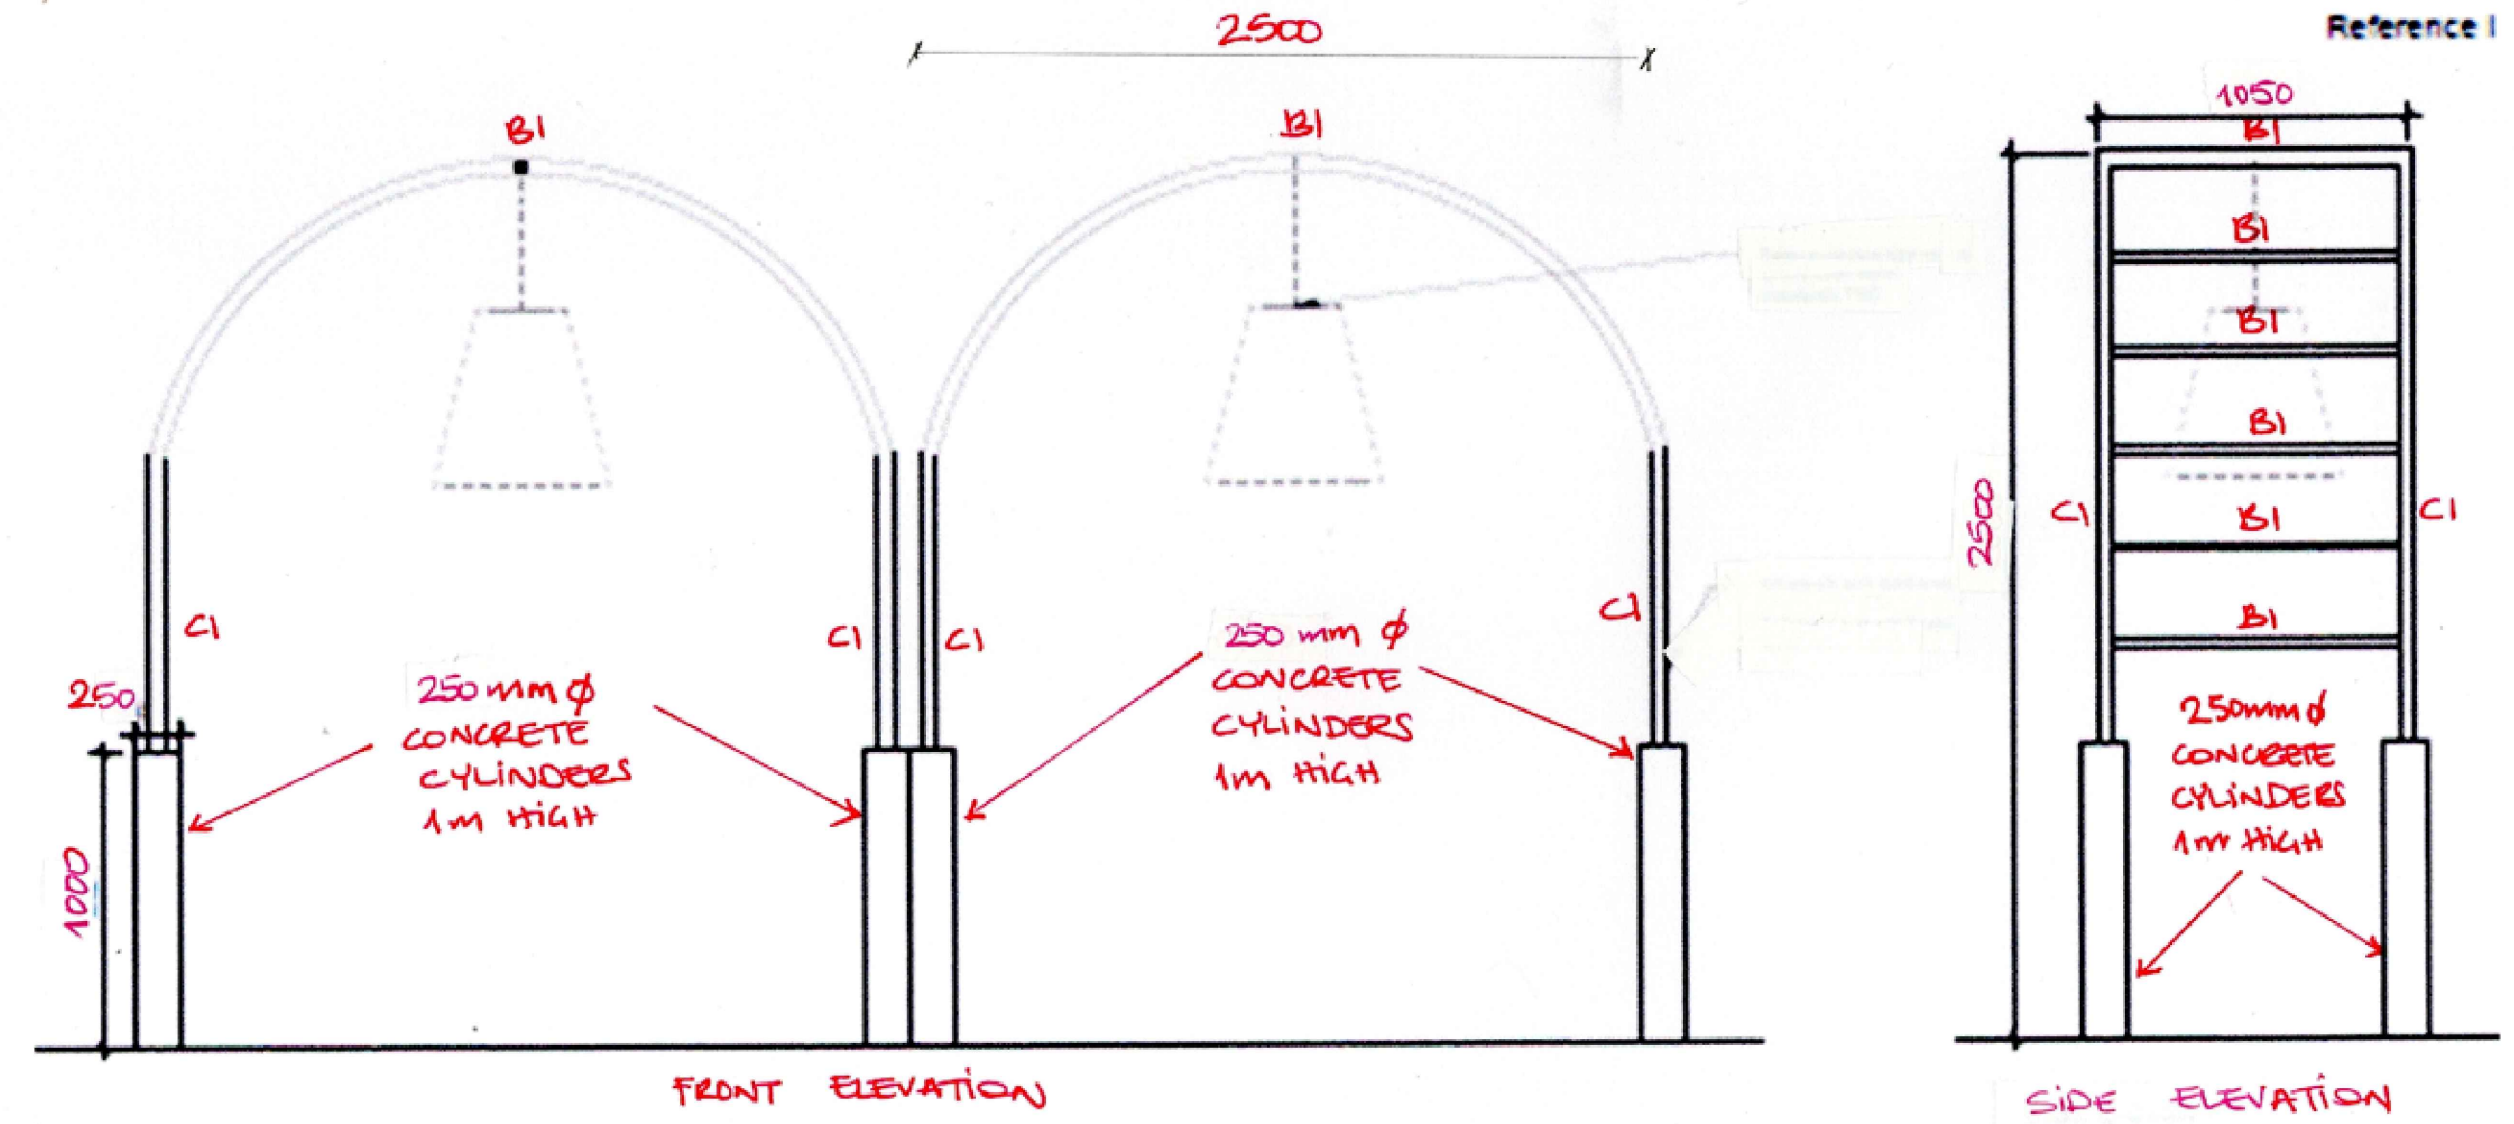


BI & CI 60.3x6.3 CHS (SS304)
MAXIMUM UNFACTORED JOINT LOAD PER LEG ONTO SLAB 1.6 KN.

bg consulting
Mark Up with
Structural Details
225111 / SK02 RC1A


TERRACE METAL ARCHES

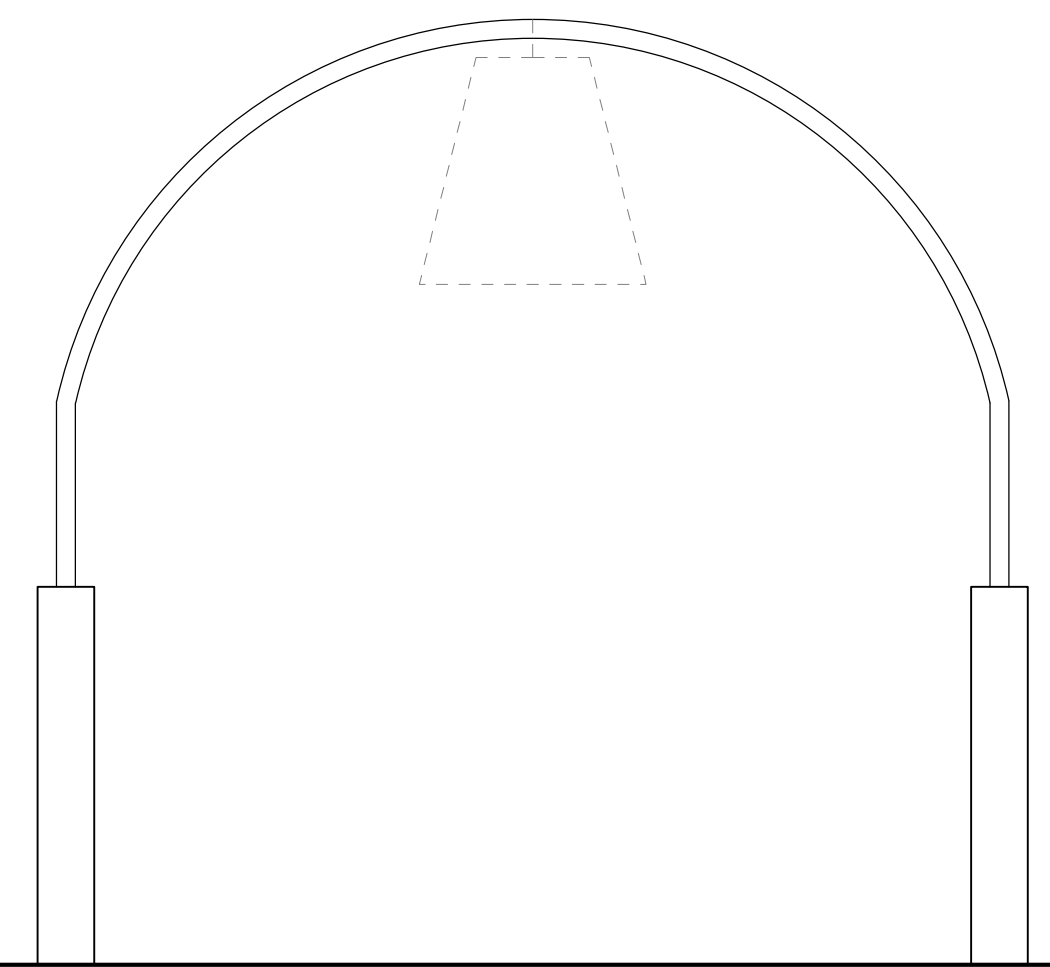


Front Elevation
Scale 1:20

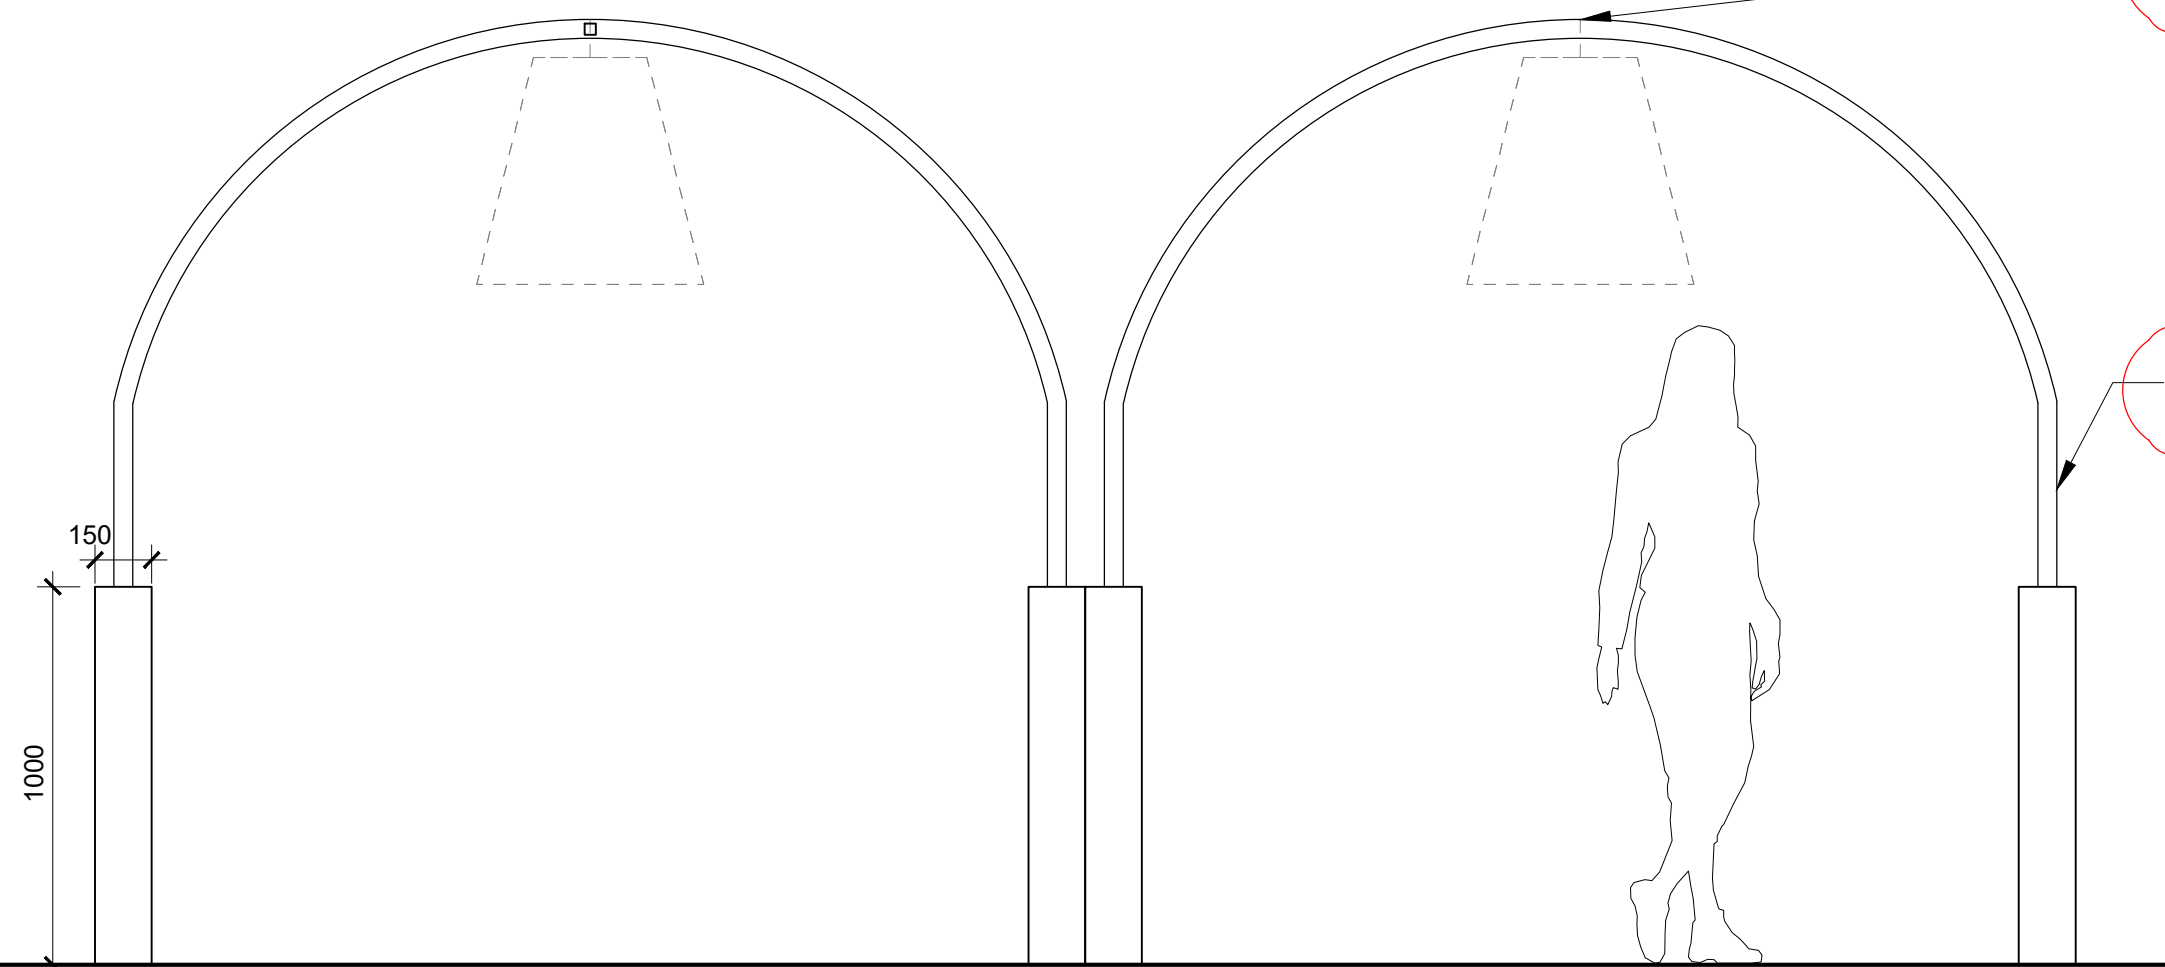

Side Elevation
Scale 1:20

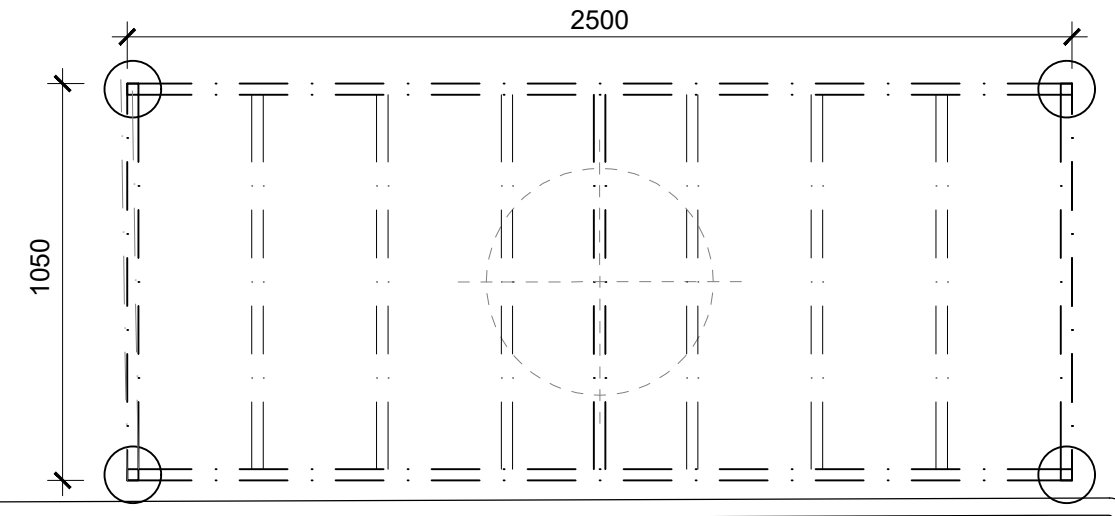

Plan
Scale 1:20

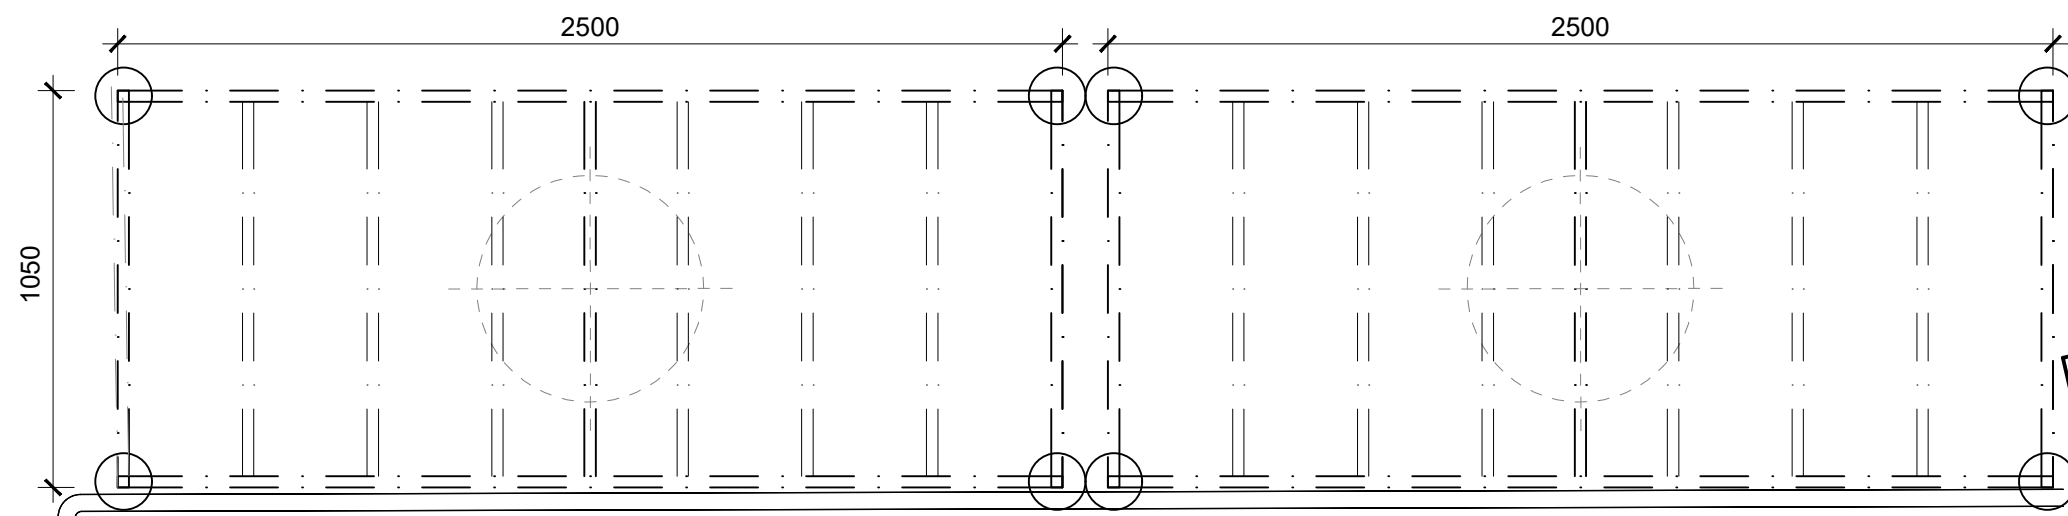

REFER TO STRUCTURAL
ENGINEERS DETAILS.

B	Sketch added. Feature lighting and metalwork arch notes amended.	BW	21.05.25
A	Overall height amended	SMP	08.05.25
Rev.	Revision Details	Initials	Date

newman|gauge

E.design@newmangaugue.com T. 0121 212 9800
47A George St. Birmingham B3 1QA
newmangaugue.com

Client



Project

**THE PARCEL YARD
KINGS CROSS STN**

Drawing Title

**DETAIL - TERRACE
METAL ARCHES**

Project Type

LISTED BUILDING APP

Date	Scale	Drawn By
FEB'25	1:20@A1	BW
Project No.	Drawing No.	Revision
3185	515	B

This drawing is the property of NEWMAN GAUGE DESIGN ASSOCIATES. Copyright is reserved by them and the drawing is issued on the condition that it is not copied, either wholly or in part without the prior consent in writing of Newman Gauge Design Associates. All dimensions are to be checked on site prior to the commencement of any work or shop drawings. This drawing is to be read in conjunction with other drawings and specifications where existing.

