
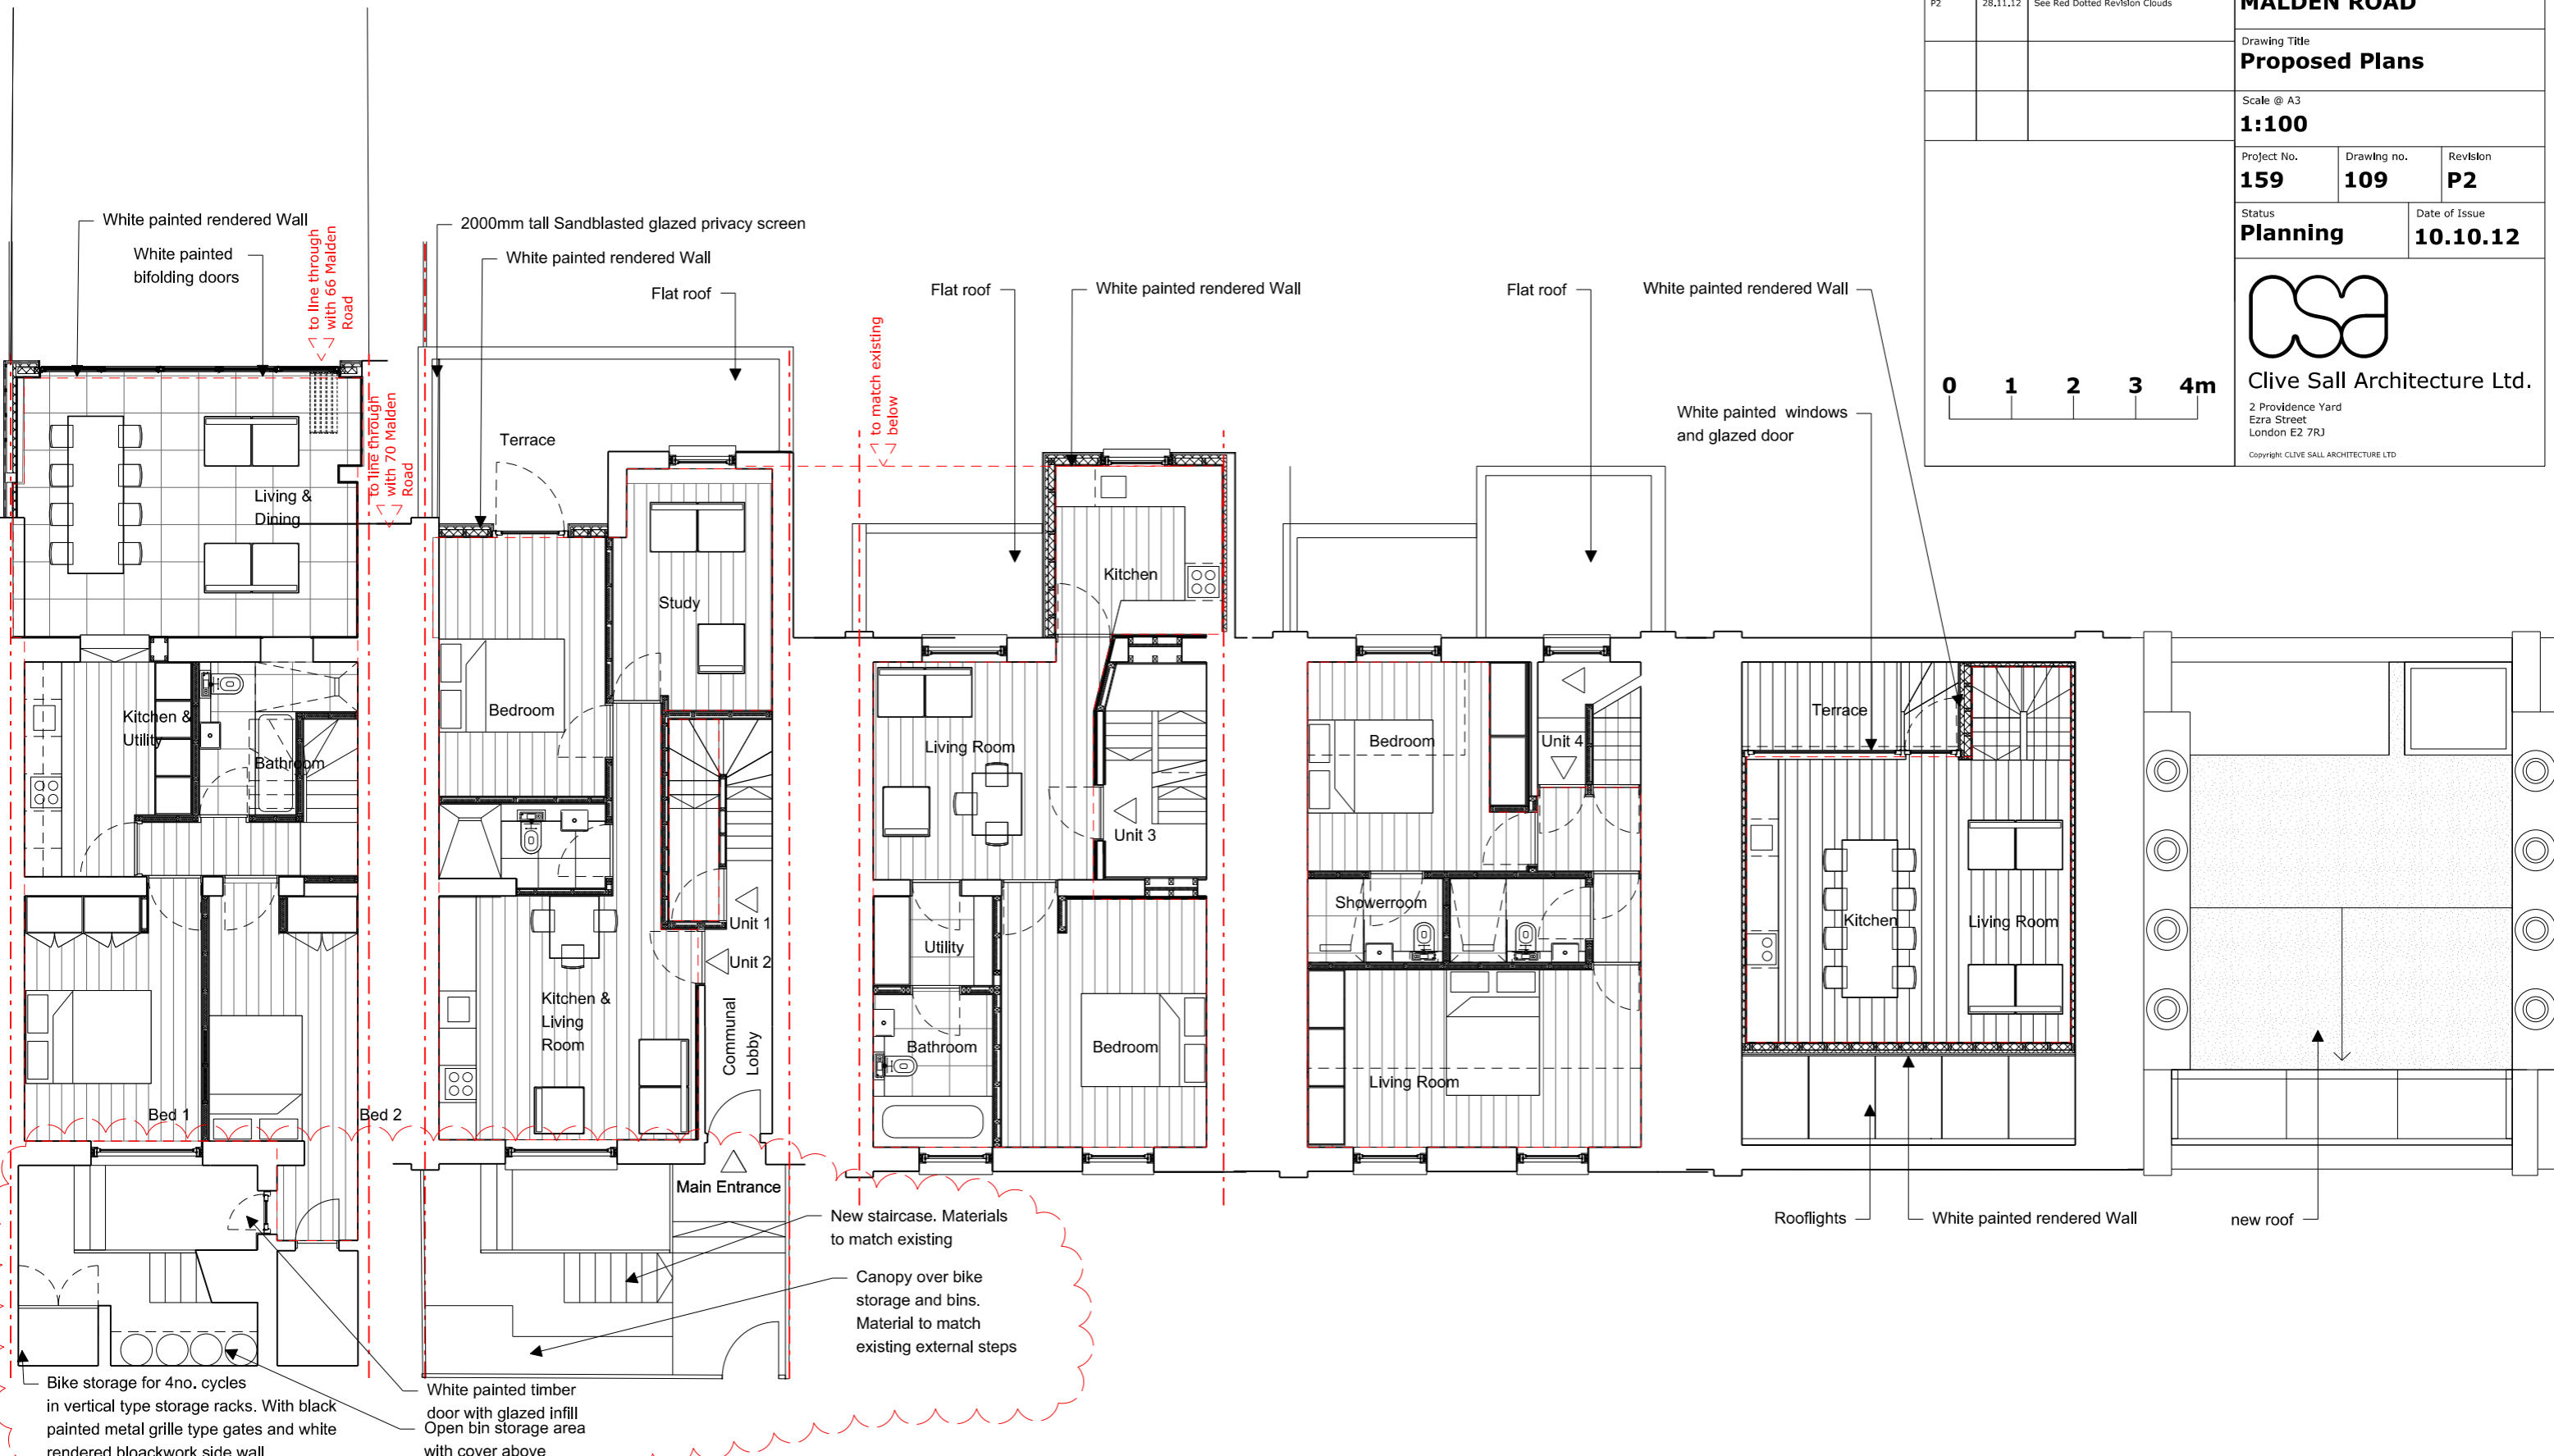
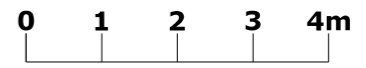


All drawings to be read in conjunction with structural engineer's and service engineer's			A3	Services
				Structures David Joseph Consulting
Rev	Date	Note	Client Urbanisation	
P1	10.10.12	Planning Submission	Project title MALDEN ROAD	
P2	28.11.12	See Red Dotted Revision Clouds	Drawing Title Proposed Plans	
			Scale @ A3 1:100	
Project No. 159		Drawing no. 109	Revision P2	
Status Planning		Date of Issue 10.10.12		
 Clive Sall Architecture Ltd. 2 Providence Yard Ezra Street London E2 7RJ <small>Copyright CLIVE SALL ARCHITECTURE LTD</small>				



-1	Lower Ground Floor	0	Ground Floor	1	First Floor - 1 person flat	2	Second Floor - 1 person flat	2	Third Floor	3	Roof
GIA (within dotted red line) 71.2 sqm		GIA (within dotted red line) 44.0 sqm		GIA (within dotted red line) 42.1 sqm		GIA (within dotted red line) 40.6 sqm		GIA (within dotted red line) 40.6 sqm			