

SECTION AA

Sign off

North point


NORTHY



General notes Issued dates

Scale Bar 1:100 Om. 5m. 10m.


 $\langle \rangle$

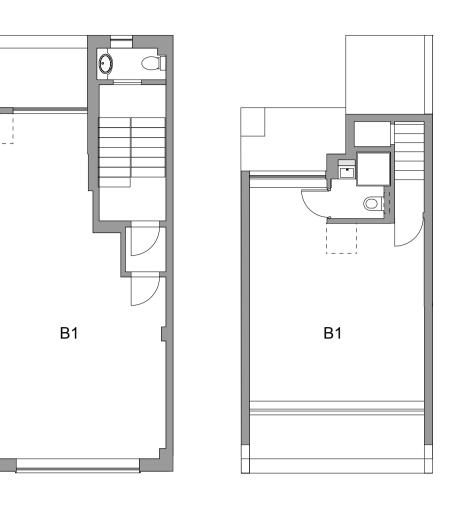




THIRD

FOURTH

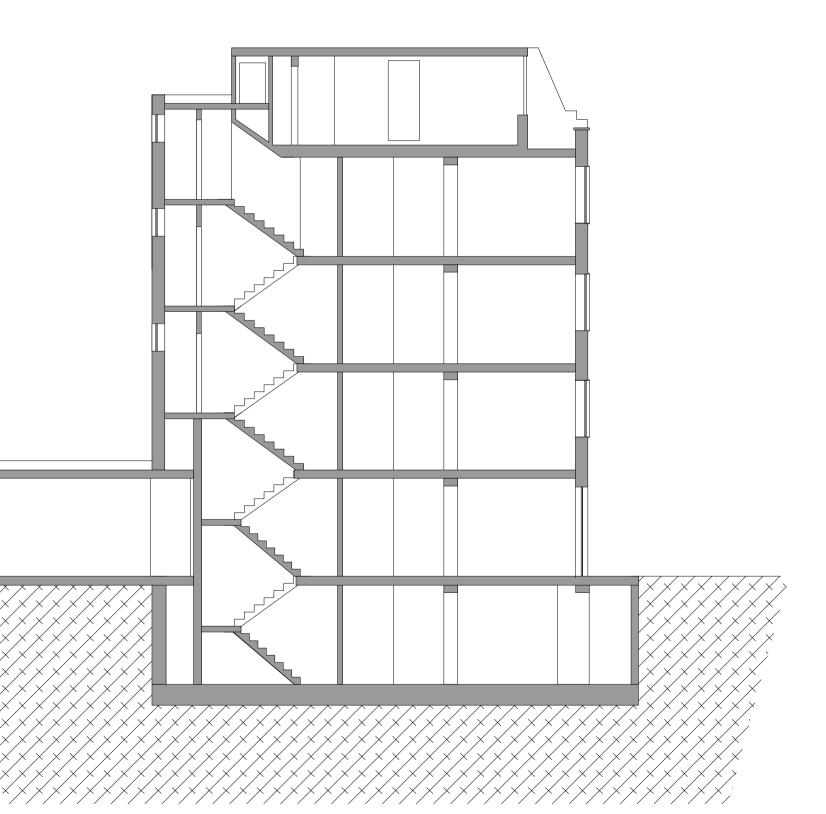

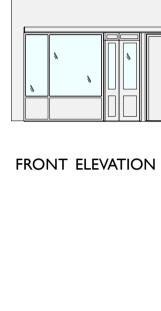





SECTION BB

	Legal
B 08.01.14 NOTES ADDED RE USE A 08.10.13 UPDATED TO AS BUILT	This dra of Hodg and the It is issu that it w reprodu or in pa party w from Ho



REAR ELEVATION

egal notes	Client:			Drg:						
is drawing is the property Hodgkinson Design d they reserve the copyright. s issued on the understanding ti ti will not be copied, produced or disclosed in whole in part to any unauthorised ty without written permission m Hodgkinson Design	OAKLEAF		EXISTING BUILDING			ARCHITECTURE INTERIOR DESIGN CORPORATE IDENTITY 29 Alexander Street London W2 5NU T 020 7221 7557 F 020 7221 6336				
	Project:		Status:							
	5 WINDMILL STREET LONDON WI		PLANNING							
	Drawn:	Checked:	Date:	Job N°:	Scale:	Drg N°:	E info@hodgkinson-design.co.uk			
	SQ	-	6 MARCH	507.00	1:100/A1	P .002-B	www.hodgkinson-design.co.uk			