

Wildwood Lodge NW3
Design and Access Statement

November 2013



Ref: 025-A-RP-10-006

Rev: -

Issue and Revision Record

Revision	Date	Originator	Checked	Description
-	28/11/2013	CFA	MC	Planning issue

Contents

1.0	Introduction	5
1.1	Purpose of this Document	
1.2	The Site	
2.0	Current Approved Planning Application and Listed Building Consent	6
2.1	Approved Building Consents	
3.0	Design Statement	12
3.1	Use, Layout and Scale	
3.2	Landscaping	
3.3	Appearance	
3.4	Access	
3.5	Demolition	
3.6	Drawings list	
3.7	Basement Impact Assessment	
3.8	Heritage Statement	
4.0	Appendix	13
4.1	Schedule of Variations	
4.2	Demolition Drawings	
4.3	Proposed Drawings	
4.4	Approved Drawings	

1.0 Introduction

1.1 Purpose of this Document

- 1.1.1 Canaway Fleming Architects have been commissioned to oversee the design of the proposed basement addition and alteration of Wildwood Lodge, North End for Mr Dodi..
- 1.1.2 This document forms the Design and Access Statement to accompany the drawings and documentation for the application of *condition variations* and *listed building consent*
- 1.1.3 The statement provides a description of the design process undertaken in developing the scheme proposals. This process involves an initial assessment and evaluation of the characteristics of the site, establishing an appropriate design approach to the development on the site and developing the design proposals.
- 1.1.4 This document is supported by the planning drawings, design construction statement and heritage significance appraisal by the Museum of London Archeology

1.2 The Site

- 1.2.1 The site is located at No. 9 North End. Wildwood Lodge is a grade II listed building situated in the north west of the London Borough of Camden, near Golders Green Underground Station. The site is within the outlying conservation area of North End and Archeological Priority Area.



Location plan (indicated in red)




Aerial photograph of the site (indicated in red)

2.0 Current Approved Planning Application and Listed Building Consent

2.1 Approved Building Consents


- 2.1.1 Planning permission and listed building consent was given for the extension and alterations in October 2007. The works permitted the extensive excavation of additional basement level and replacement of east garage with rear courtyard and light well. The main body of the house is predominantly untouched and remains as the dominant element.
- 2.1.2 The application references are 2007/2895/P and 2007/2896/L. Both of these applications have subsequently been granted renewal in September 2011 with reference 2010/4924/P and 2010/4930/L.
- 2.1.3 Further planning consents have been granted thereafter, including planning condition variations, discharge of planning conditions and non-material amendments during the course of construction. See table over page.

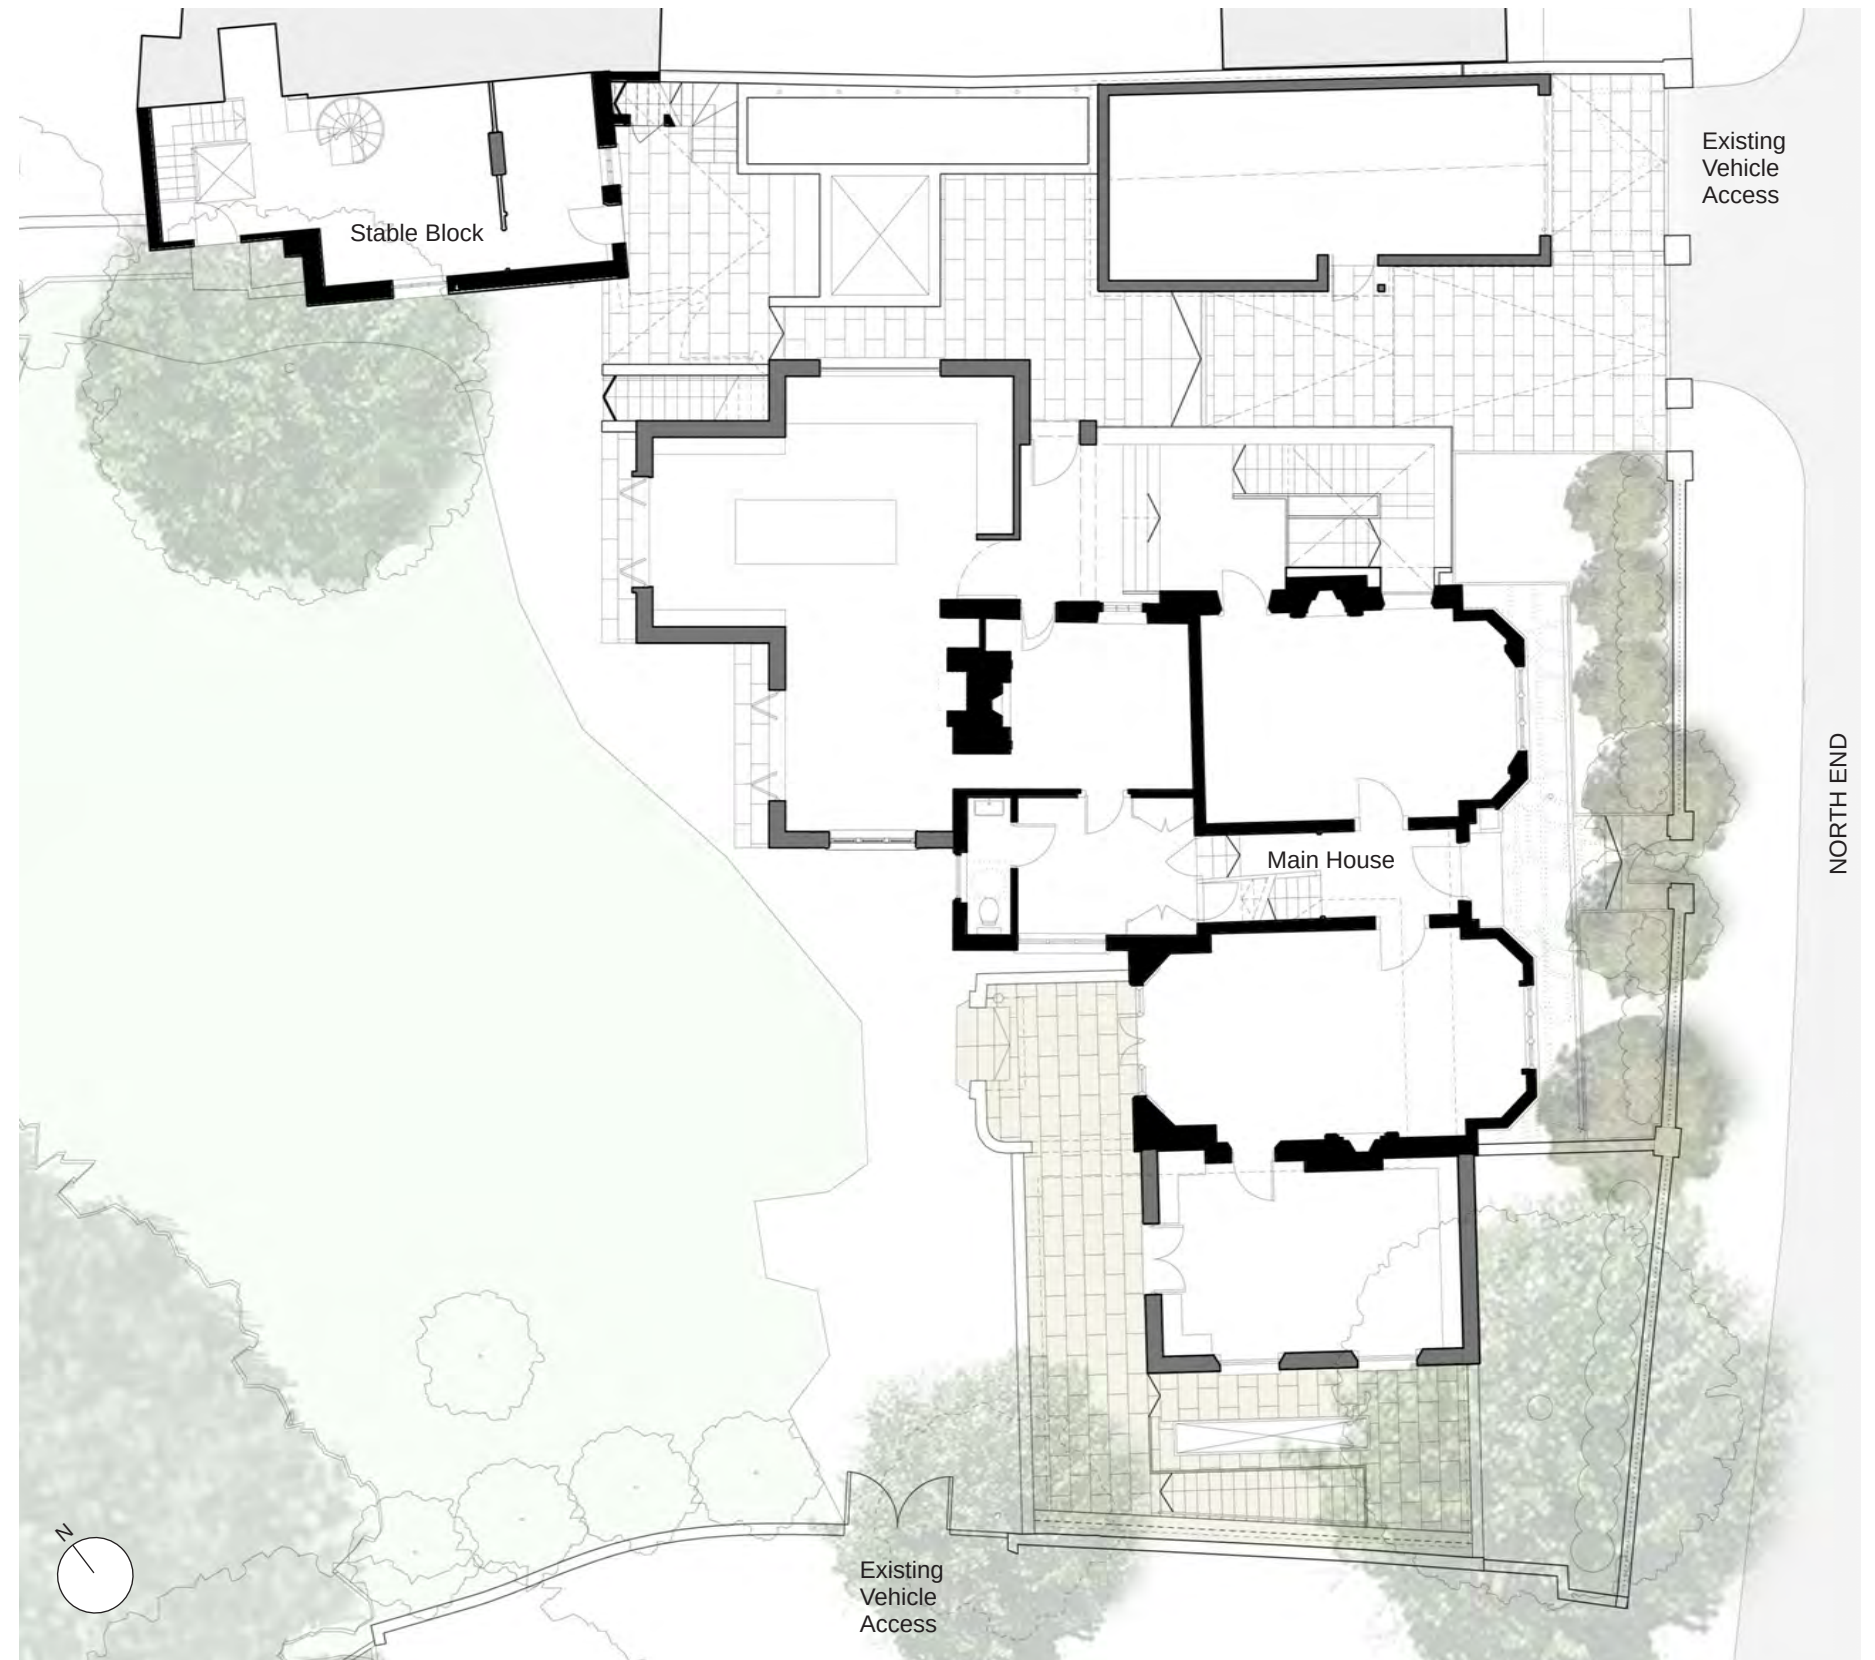

Consented Ground Floor Plan 2012/4611/P and 2012/4615/L

KEY

- Main House and Stable Block
- Consented Extension

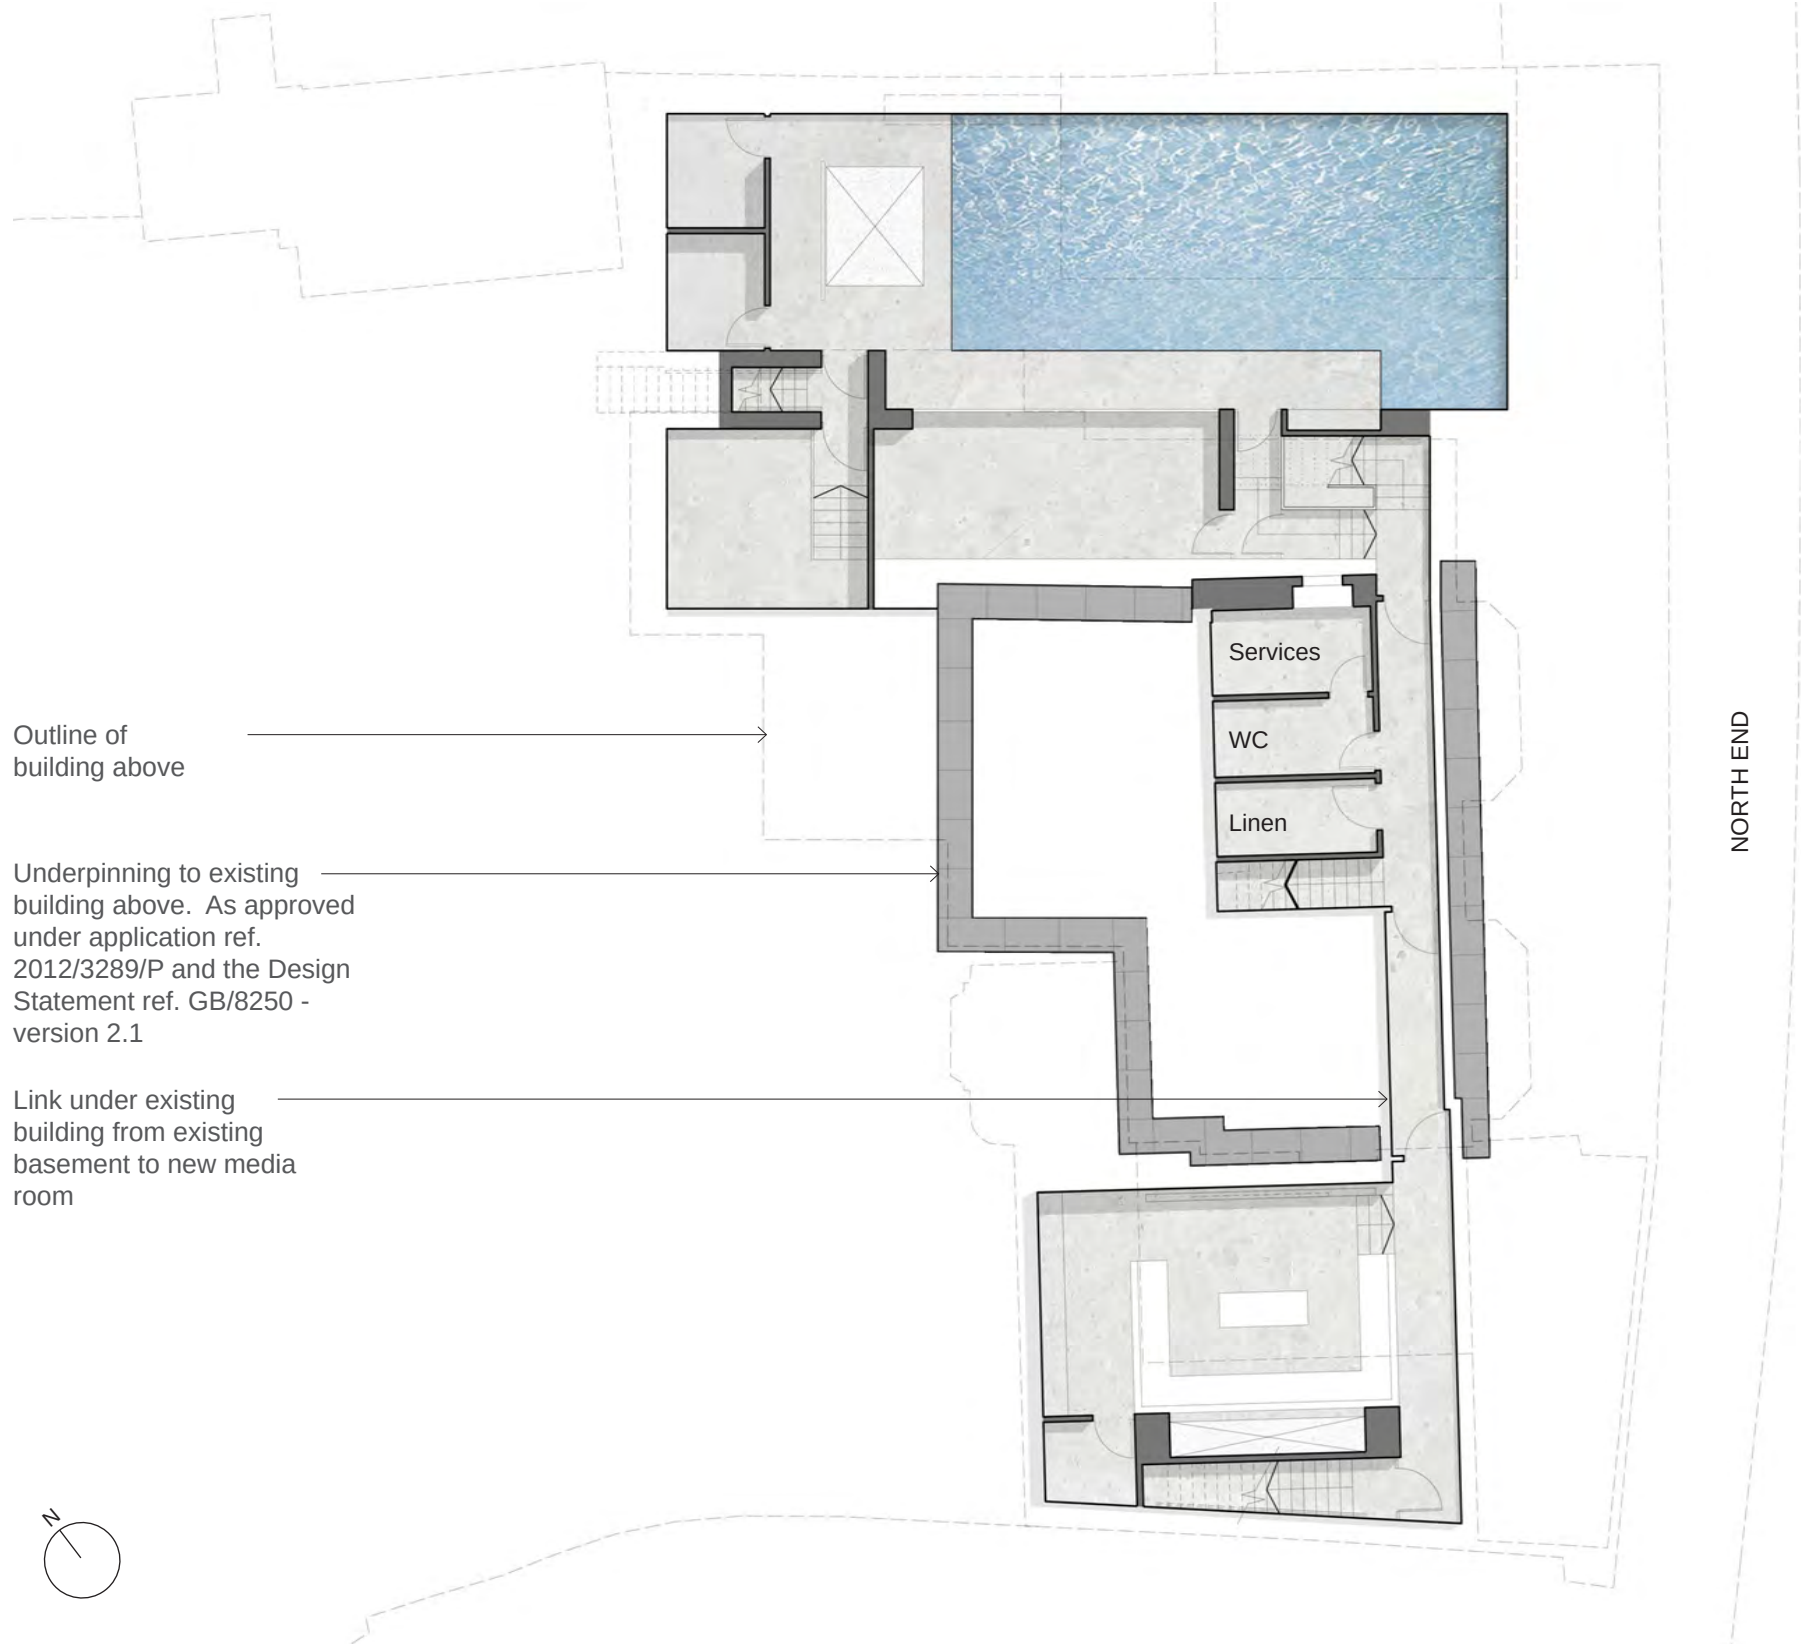


Consented Basement Floor Plan 2012/4611/P and 2012/4615/L

Planning Application Consents

Application Number (and associated Listed Building application number where applicable)	Description	Decision	Decision Date
2013/6927/P 2013/6988/L (<i>pending</i>)	Non-material amendment: to increase the aperture size of the two consented windows on the west elevation of the library wing	GRANTED	25.11.2013
2013/5202/P 2013/5344/L	Non-material amendment: to change the approved monopitch roof to the library extension by a hipped roof with roof light.	GRANTED	16.09.2013
2013/1136/L	Details of conditions 3a-e (railings, windows & doors, eaves & parapet, joinery for conservatory, and facing materials of Listed building consent	GRANTED	25.04.2013
2012/4611/P 2012/4615/L	Variation to condition 7: variations involve re-configuration and rear extension of basement accommodation, redesign of conservatory extension, amendments to fenestration on rear elevation of house, and amended hard landscaping of courtyard	GRANTED	31.10.2012
2012/3289/P	Details of design and method statement for below ground level construction works required by condition 8 of planning permission	GRANTED	10.08.2012
2012/2503/P	Details of trees, hard and soft landscaping required by Conditions 3 & 4 of planning permission	GRANTED	06.08.2012
2010/4924/P 2010/4930/L	Renewal of listed building consent (ref 2007/2896\L) granted on 01/10/2007 for the erection of a replacement garage with rear courtyard and light well, and excavation of additional basement level to provide a swimming pool and ancillary plant, as an amendment to the listed building consent dated 7/11/06 (Ref: 2006/3957/L) for demolition of one and two storey rear extensions, side garage and side conservatory and erection of replacement two storey plus basement rear extension with pitched roof, one storey rear kitchen extension, single storey west side extension and single storey east side conservatory extension, plus associated external and internal alterations, and alterations to front boundary wall.	GRANTED	19.09.2011
2007/6255/P 2008/0476/L	Excavation of a basement room under west wing of dwelling house, with associated roof lights and access staircase within terrace	GRANTED	04.04.2008
2007/2895/P 2007/2896/L	Erection of a replacement garage with rear courtyard and lightwell, and excavation of additional basement level to provide a swimming pool and ancillary plant, as an amendment to planning permission dated 7/11/06 (Ref: 2006/3956/P) for Demolition of one and two storey rear extensions, side garage and side conservatory and erection of replacement two storey plus basement rear extension with pitched roof, one storey rear kitchen extension, single storey west side extension and single storey east side conservatory extension, plus associated external and internal alterations, and alterations to front boundary wall	GRANTED	01.10.2007
2006/3956/P 2006/3957/L	Demolition of one and two storey rear extensions, side garage and side conservatory and erection of replacement two storey plus basement rear extension with pitched roof, one storey rear kitchen extension, single storey west side extension and single storey east side conservatory extension, plus associated external and internal alterations, and alterations to front boundary wall.	GRANTED	07.11.2006


Note: The records are for informative purposes only and have been collated from the Statutory Planning Register held by Camden Council. The accuracy of these records are the responsibility of the local authority and not Canaway Fleming Architects.

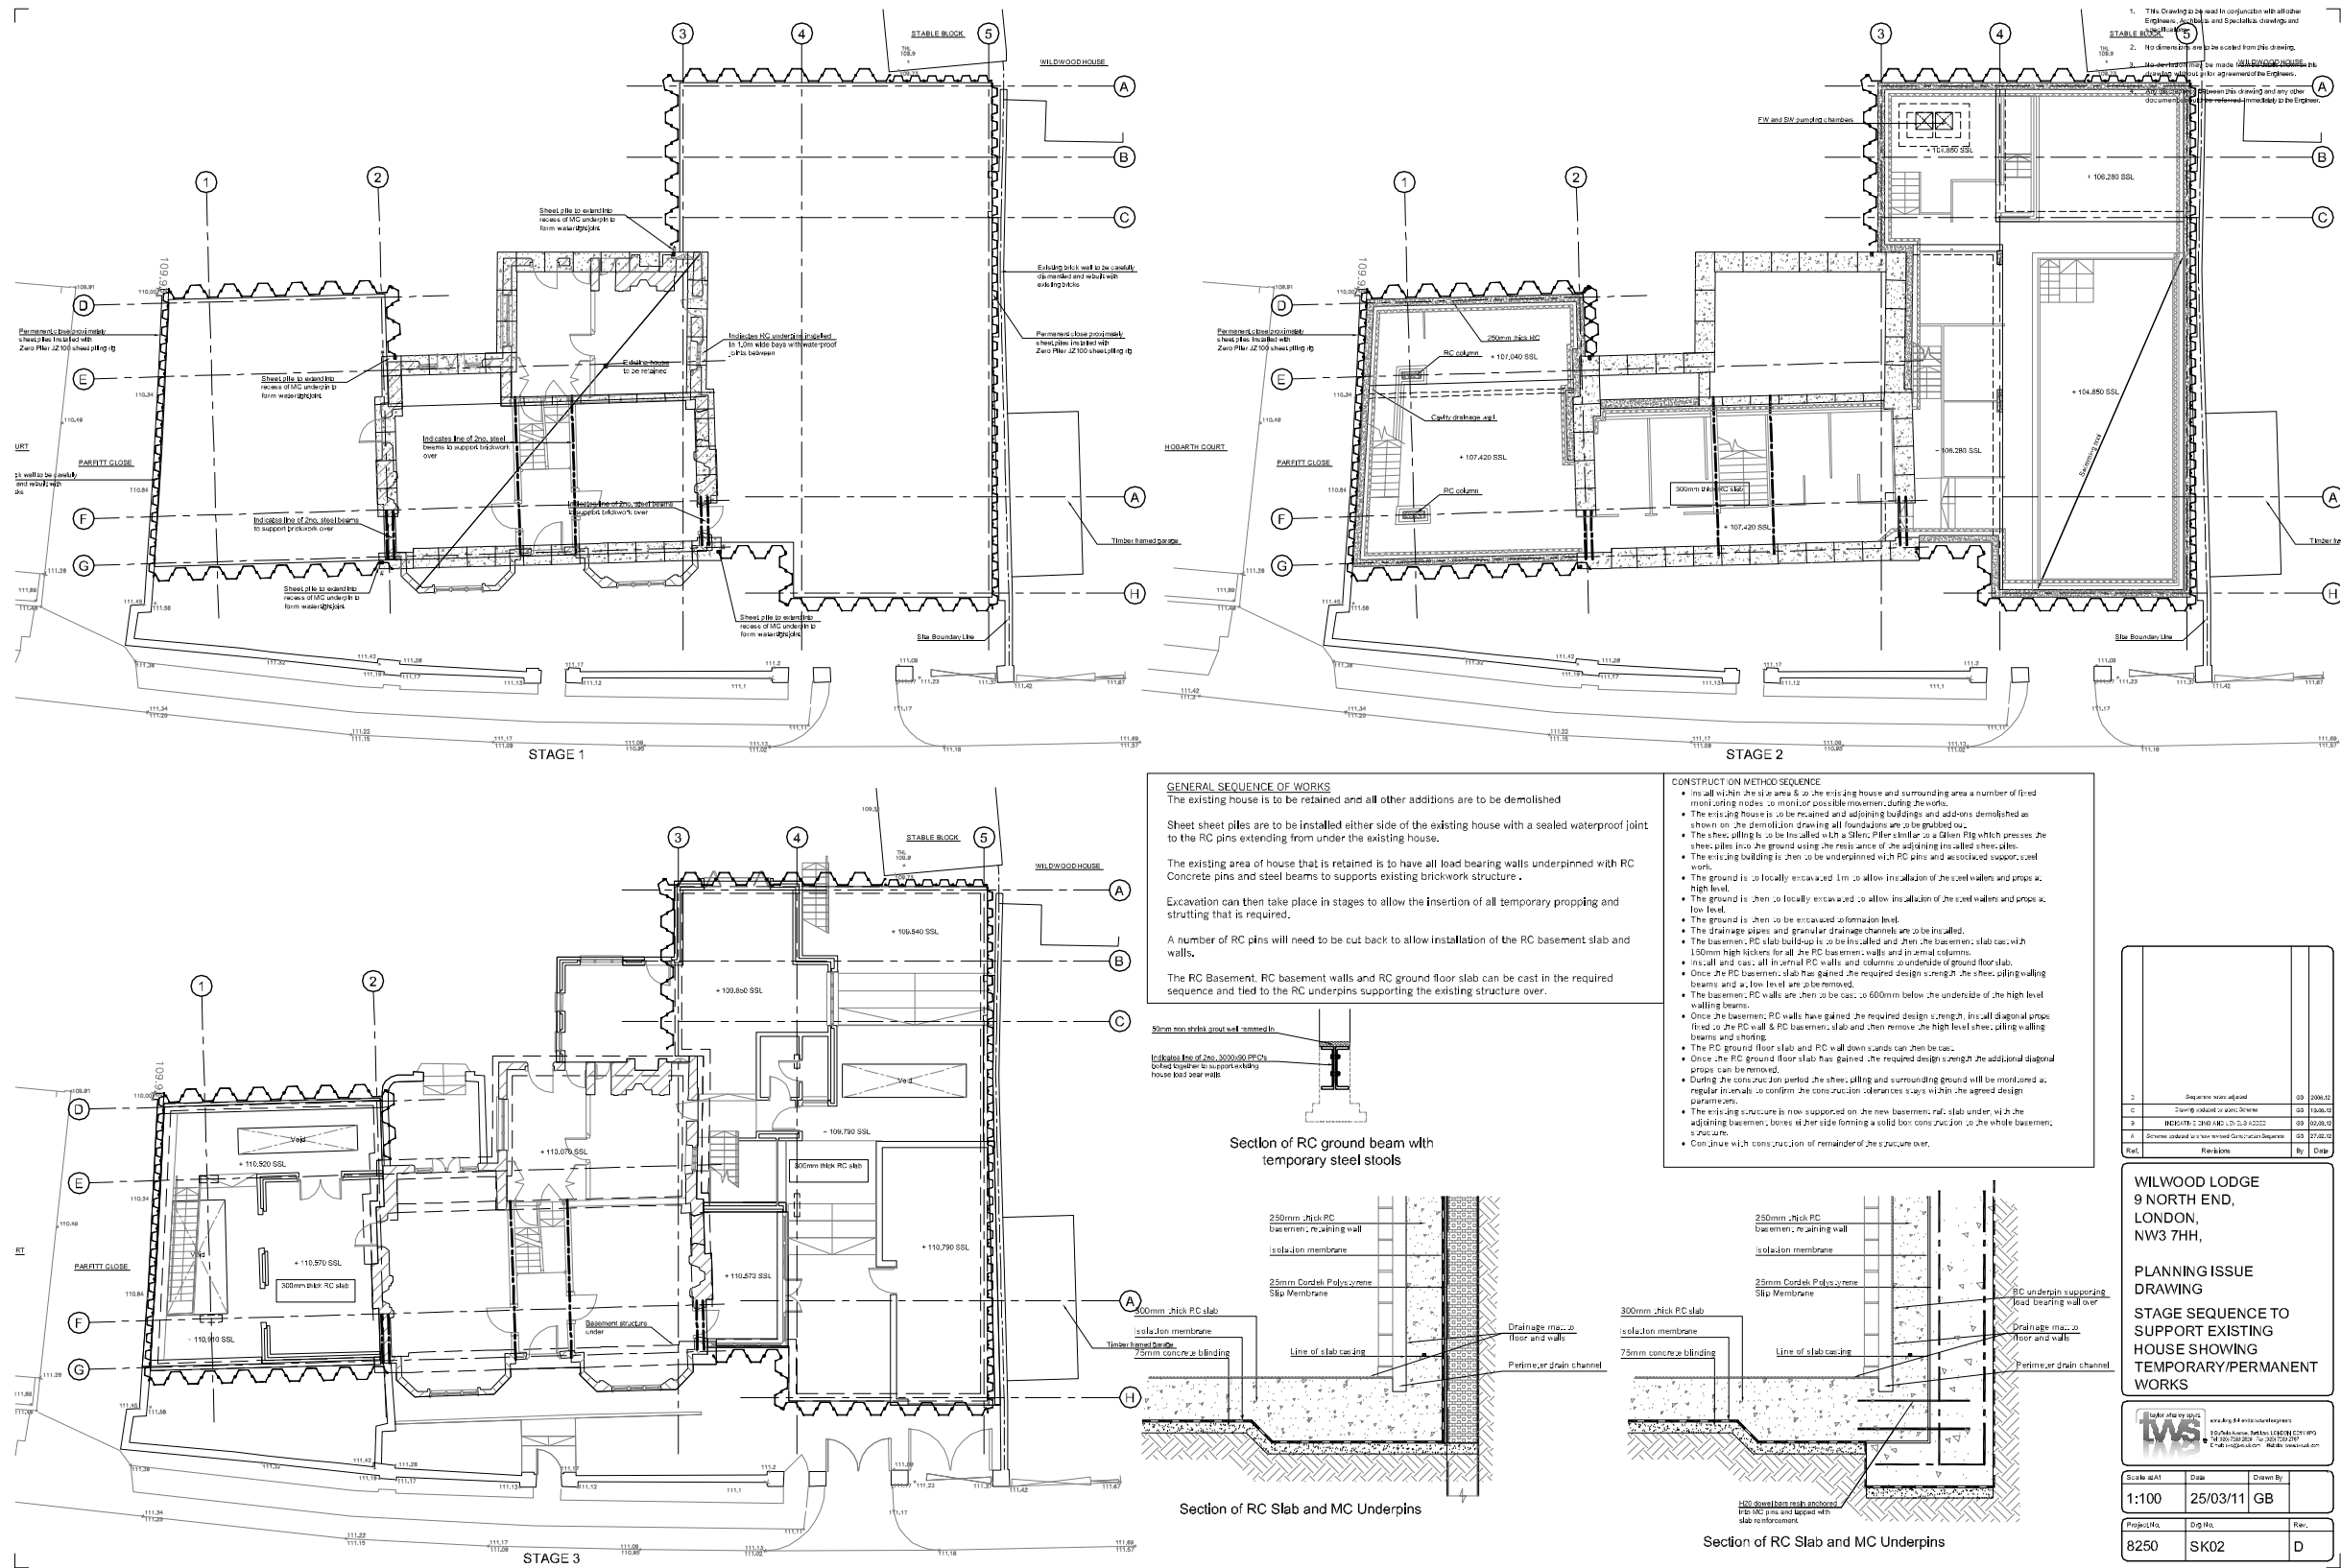


2.1.4 New Proposal Under this Application

KEY

- Main House and Stable Block
- Consented Extension
- ① External staircase from media room omitted and roof light position amended

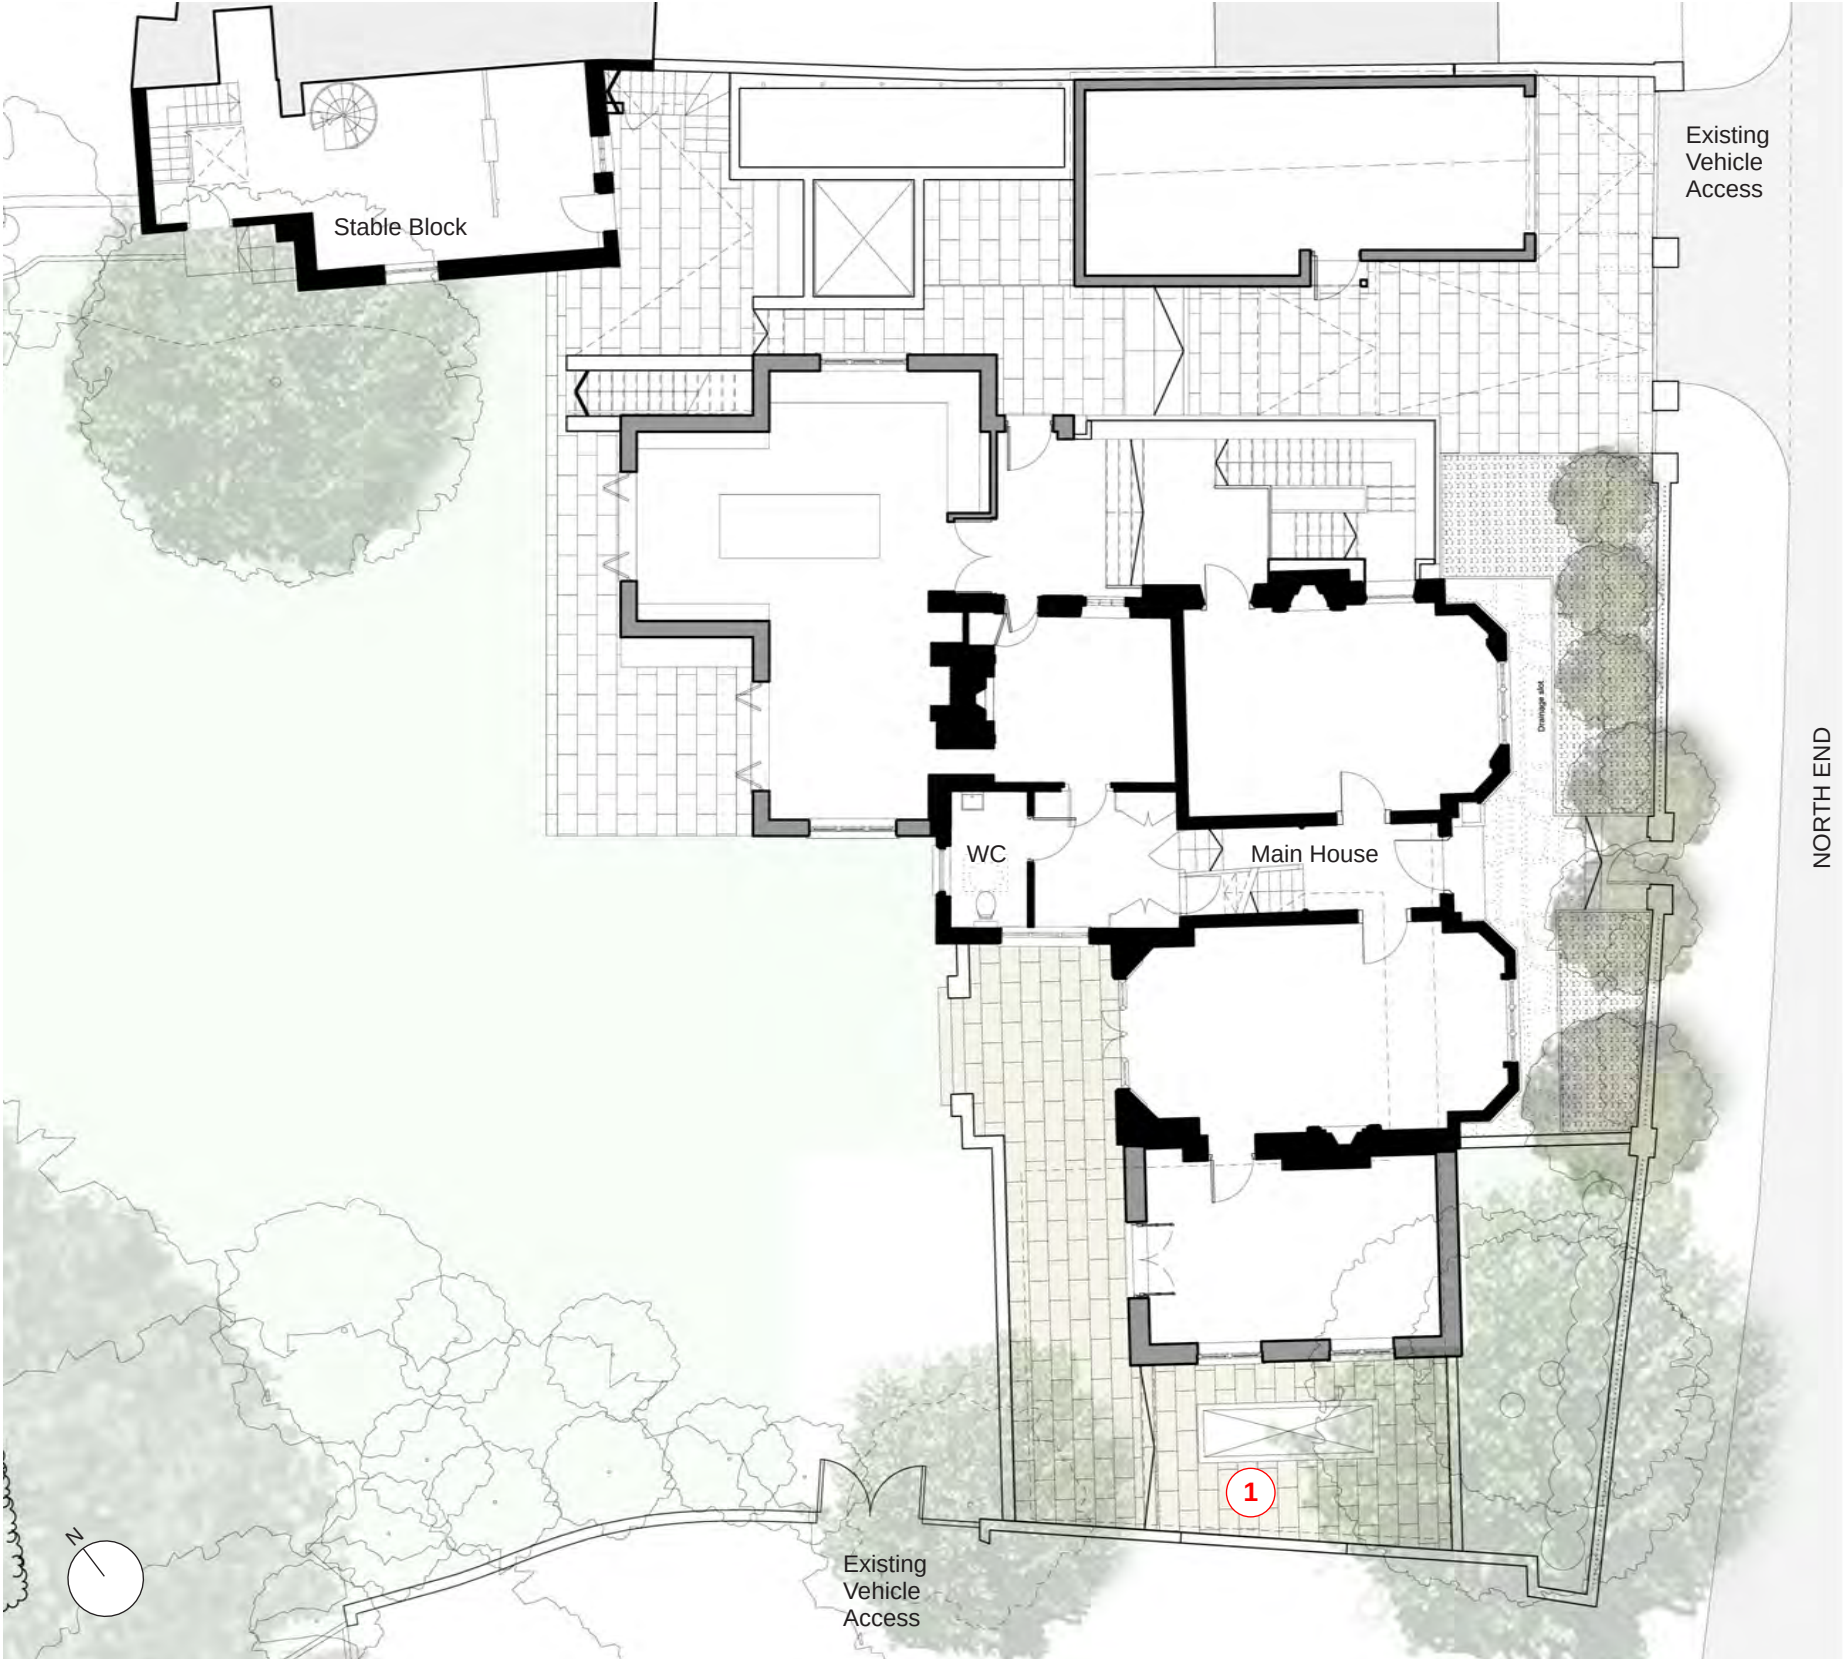

Proposed Ground Floor Plan

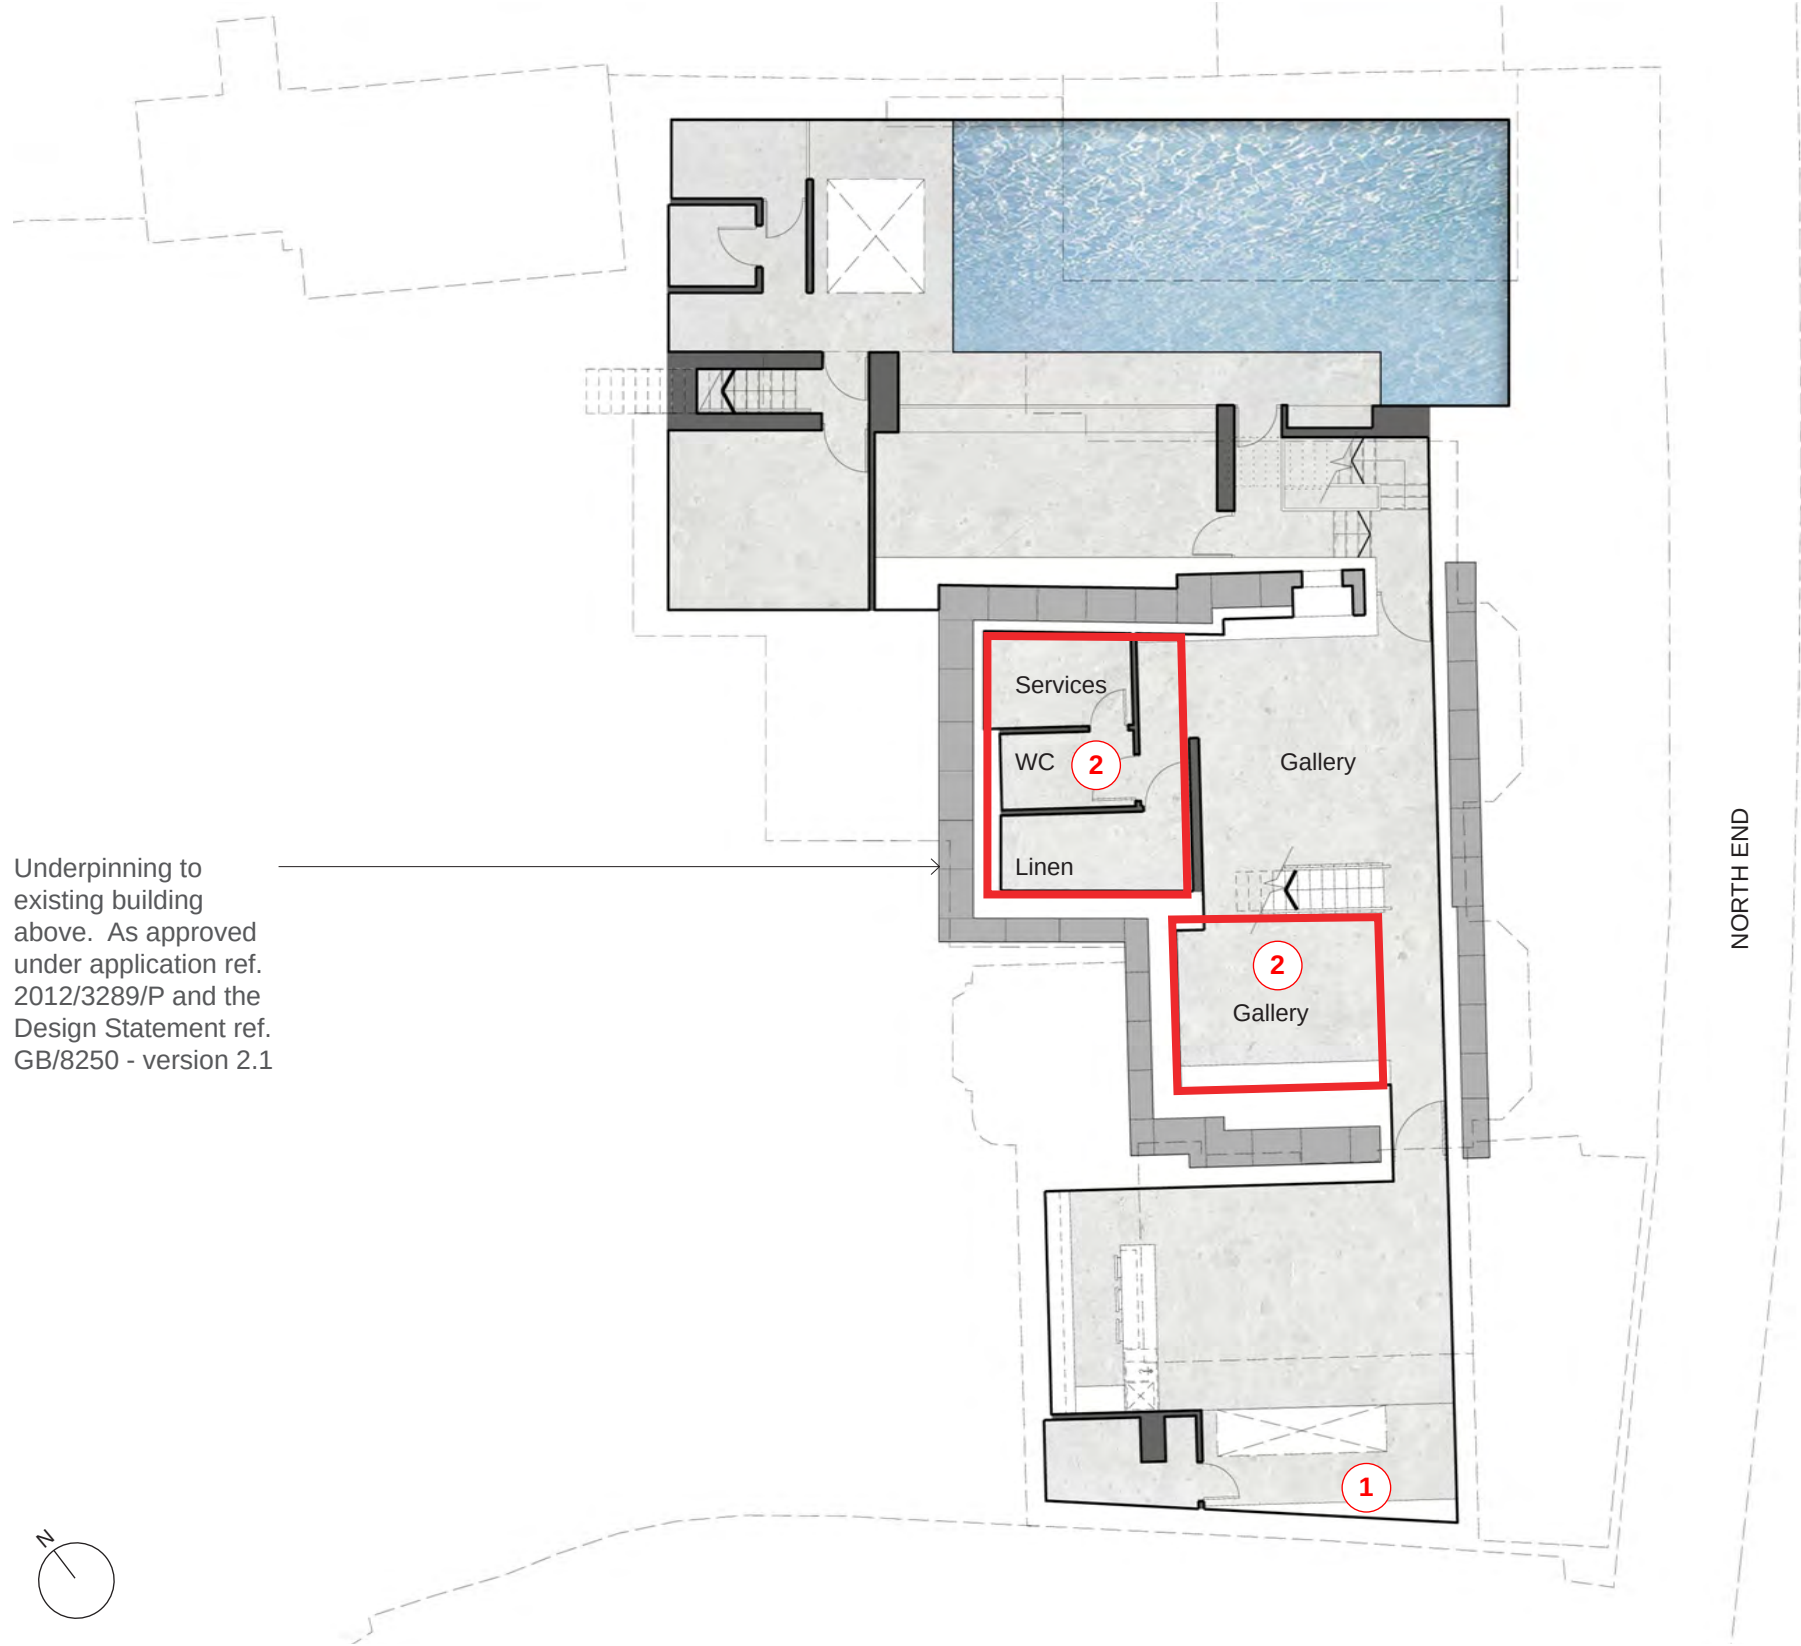

Underpinning to existing building above. As approved under application ref. 2012/3289/P and the Design Statement ref. GB/8250 - version 2.1

KEY

- 1 External staircase from media room omitted and roof light position amended
- 2 Basement extension under existing house and revised internal layout to Plant room, WC, and Linen Store
- Area of extension

Proposed Basement Floor Plan

3.0 Design Statement

3.1 Use, Layout and Scale

- 3.1.1 The building remains a single house family dwelling. The application addresses the internal layout revisions in the basement with the omission of the previously approved external staircase to the West terrace.
- 3.1.2 The further basement extension makes use of the voids created under the house as a result of the necessary underpinning works that had been carried out as consented (ref 2012/3289/P)
- 3.1.3 See attached drawings and schedule of changes for further details.

3.2 Landscaping

- 3.2.1 Approved soft and hard landscaping remains unchanged. The omission of the staircase to the media room annex has enabled the roof light to be resized and relocated to better suit the layout of the terrace and the media room below.

3.3 Appearance

- 3.3.1 The proposed extensions to the basement are all below ground level and will have no impact on the external appearance and materiality of the house. The only alteration will be the removal of the glass balustrade as a consequence to the omission of the West staircase, this is very minor in the context of the whole scheme and will make no material difference to the overall appearance of the building and character of the conservation area and street scene.

3.4 Access

- 3.4.1 Vehicular access, private parking and inclusive access remain as approved.

3.5 Demolition

- 3.5.1 See appendix for drawings and photos to extent of partial demolition within the curtilage of the listed building, they are all at basement level ;
 - 025-A-P-B1-D212 rev.A Basement Demolition Plan
 - 025-A-P-B1-D213 rev.A Photos Basement Demolition Proposals

3.6 Drawings list

- 3.6.1 See attached 2 no. sets of drawings (as approved and as proposed) and schedule of changes for full details of amendments to scheme.
- 3.6.2 Approved drawings list
 - 025-A-P-B1-D200 Basement Plan
 - 025-A-P-00-D201 Ground Floor Plan
 - 025-A-X-BB-D205 Section BB
 - 025-A-E-Nth-D208 North Elevation
 - 025-A-E-Wst-D210 West Elevation
- 3.6.3 Proposed drawings list
 - 025-A-P-SI-D001 Site Location Plan
 - 025-A-P-B1-D200 rev.C Basement Plan
 - 025-A-P-00-D201 rev.B Ground Floor Plan
 - 025-A-X-BB-D205 rev.C Section BB
 - 025-A-X-DD-D214 rev.B Section DD
 - 025-A-X-EE-D215 rev.B Section EE
 - 025-A-E-Nth-D208 rev.B North Elevation
 - 025-A-E-Wst-D210 rev.B West Elevation

3.7 Basement Impact Assessment

- 3.7.1 The application site is located within an identified area susceptible to hydrological factors, as covered by policies DP27 of the Local Development Framework (LDF)
- 3.7.2 This application includes document GB/8250 - version 2.0 Design Construction Statement addendum dated October 2013 by Taylor Whalley Spyra, that provides a statement on meeting the terms of DP27, addressing the following:
 - Impact of proposals on surface flow and flooding
 - Impact of proposals on groundwater flow
 - Impact of proposals on structural stability

3.8 Heritage Statement

- 3.8.1 In accordance to the requirements on where proposed developments involve work carried out on a listed building and where the property is located in a conservation area, this application includes a heritage statement by the Museum of London Archaeology dated 20th November 2013, providing the necessary information to meet the criteria outlined in the Planning Policy Statement 5 (PPS5) - Planning for the Historical Environment

4.0 Appendix

4.1 Schedule of Variations

4.2 Demolition Drawings

4.3 Proposed Drawings

4.4 Approved Drawings

Title: Schedule of Variations
Project: Wildwood Lodge, North End, Hampstead

General Arrangment	Ref	Variation	Comments	Existing Drawing	Approved Drawing [ref: 2012/4611/P]	Proposed Drawing
Basement	B1 B2	- Plant room, WC, and Linen Store layout relocated below existing Snug. - Previously approved external staircase from media room to external terrace omitted and rooflight position amended.	Extension below Snug and Living Room within area of approved underpinning to the existing house.	11025-A-P-B1-D100	025-A-P-B1-D200	025-A-P-B1-D200 rev.C
Ground Floor	G1	- Previously approved external staircase from media room to external terrace omitted and rooflight position amended.		11025-A-P-00-D101	025-A-P-00-D201	025-A-P-00-D201 rev.B
Section BB		- Previously approved staircase from media room to external terrace omitted [as above] - Plant room, WC, Linen Store layout relocated [as above]		-	025-A-X-BB-D205	025-A-X-BB-D205 rev.C
Section DD		- Plant room, WC, Linen Store layout relocated [as above]		-	-	025-A-X-DD-D214 rev.B
Section EE		- Plant room, WC, Linen Store layout relocated [as above]		-	-	025-A-X-EE-D215 rev.B
North Elevation		- Previously approved staircase from media room to external terrace omitted [as above]	No visible change to North Elevation. No material difference to the overall appearance of the building and character of the conservation area and street scene	-	025-A-E-Nth-D208	025-A-E-Nth-D208 rev.B
West Elevation		- Previously approved staircase from media room to external terrace omitted [as above]	No visible change to West Elevation. No material difference to the overall appearance of the building and character of the conservation area and street scene	-	025-A-E-Wst-D210	025-A-E-Wst-D210 rev.B




Notes
Copyright remains the property of Canaway Fleming Architects and this drawing is not to be used for any purposes without the express permission of the Architect. No Implied License is given for its use.

Do not scale from this drawing. All dimensions should be checked on site for accuracy.

Planning
These drawings are for preliminary Planning Purposes must not be used for any other purpose without the express permission of Canaway Fleming Architects. These are not for detailed construction purposes.

Structural Work
All indications as to structure are for graphic purposes only and must not be relied upon for accuracy in terms of size, detail or position. All structure and temporary propping to be confirmed by a suitably qualified structural engineer before beginning works.

Key
 Red hatch indicate extent of demolition

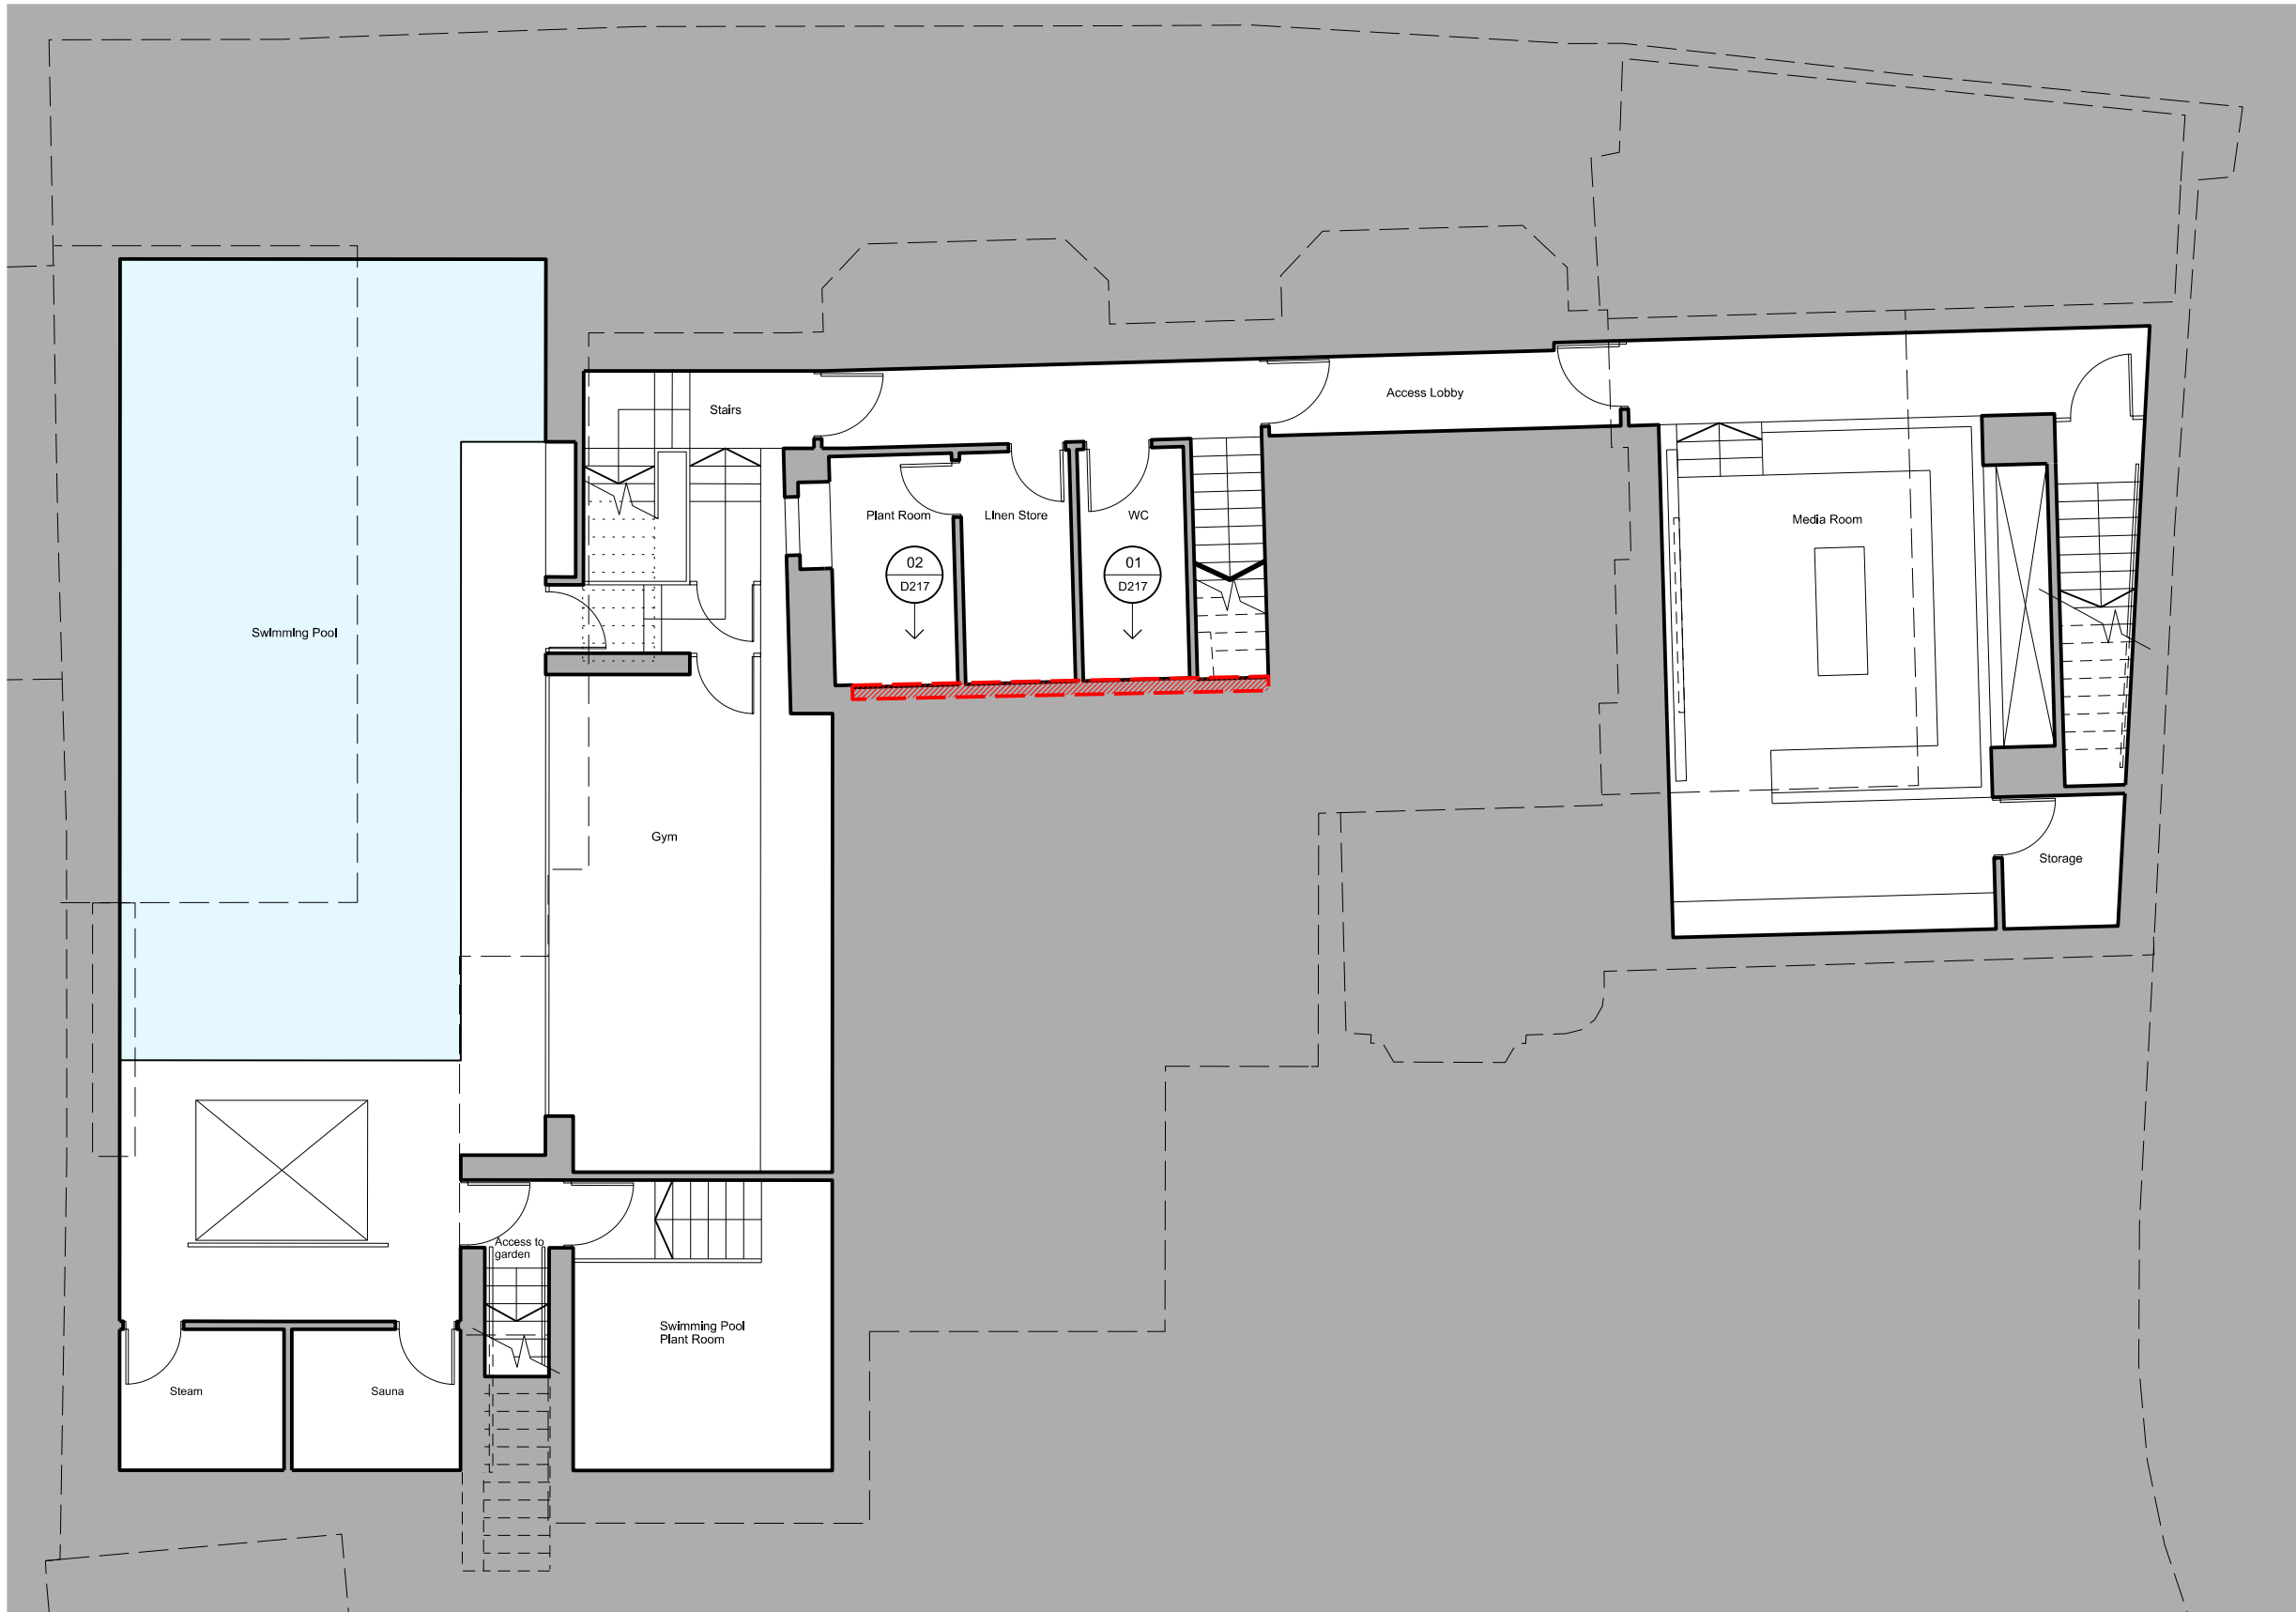

As Proposed

Rev A 18.06.13 Updated application ref: 2013/2247
Revisions

CANAWAY FLEMING ARCHITECTS

Canaway Fleming Architects Ltd
The Dutch House
307 - 308 High Holborn
London WC1V 7LL
T: 020 7430 2262
F: 020 7430 2274
E: mail@canawayfleming.com

Client Mr Avi Dodi

Project Wildwood Lodge, North End
New Extension and Alterations

Drawing Title Basement Extension
Demolition of approved Basement Plan
App. ref: 2012/4611/P

Date March 2013 Scale 1:50@A1

01 PROPOSED DEMOLITION PLAN OF APPROVED BASEMENT
D216 PROPOSED 1:50



Project	Origin	Type	Level/Vine	Package Diag No.	Revision
025	A	P	B1	D216	A
Status	Planning	Drawn	CT	Checked	MC

Notes
Copyright remains the property of Canaway Fleming Architects and this drawing is not to be used for any purposes without the express permission of the Architect. No Implied License is given for its use.

Do not scale from this drawing. All dimensions should be checked on site for accuracy.

Planning
These drawings are for preliminary Planning Purposes must not be used for any other purpose without the express permission of Canaway Fleming Architects. These are not for detailed construction purposes.

Structural Work
All indications as to structure are for graphic purposes only and must not be relied upon for accuracy in terms of size, detail or position. All structure and temporary propping to be confirmed by a suitably qualified structural engineer before beginning works.


- Key
- Red outline indicate extent of demolition
- New steel beam to strengthen existing joists and pick up load above.



01

D217

VIEW PB-01

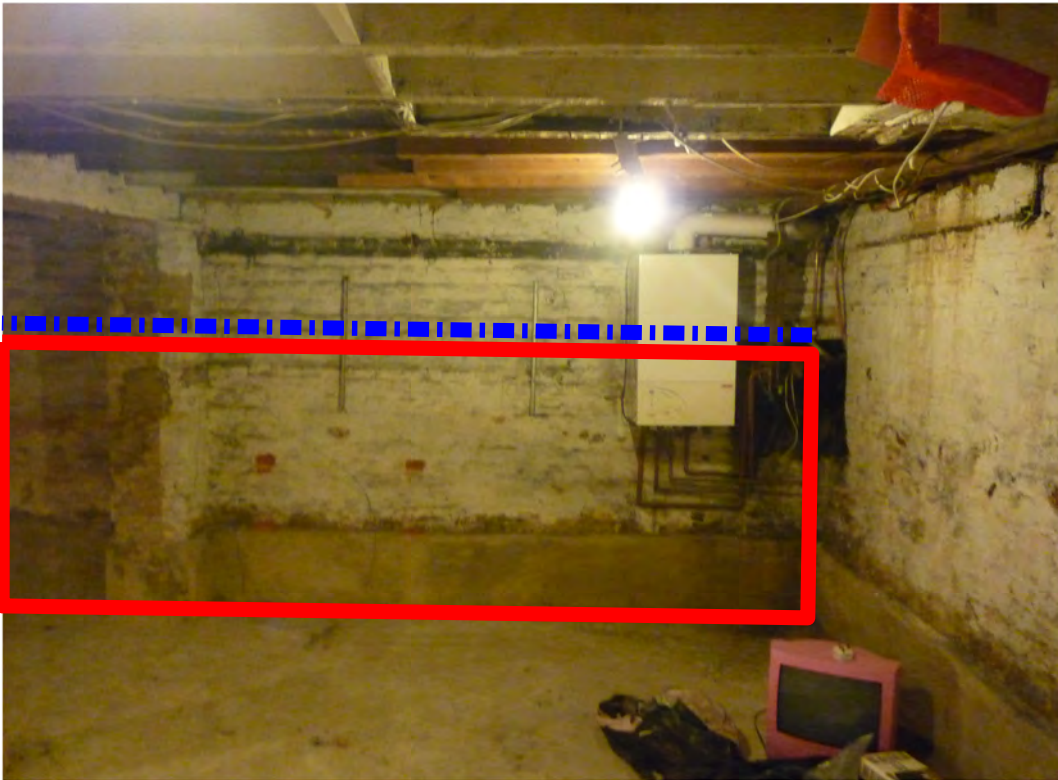

02

D217

VIEW PB-02

As Proposed

Rev A 18,06,13 Updated application ref: 2013/2247
Revisions

CANAWAY FLEMING ARCHITECTS

Canaway Fleming Architects Ltd
The Dutch House
307 - 308 High Holborn
London WC1V 7LL

T: 020 7430 2262
F: 020 7430 2274
E: mailbox@canawayfleming.com

Client Mr Avi Dodi

Project Wildwood Lodge, North End
New Extension and Alterations

Drawing Title Basement Extension
Demolition of Approved Basement Photos
App. ref: 2012/4611/P

Date March 2013 Scale nts.

Project	Origin	Type	Level/View	Package/Draw No.	Revision
025	A	P	B1	D217	A
Status	Planning			Drawn	Checked
				CT	MC



Notes
Copyright remains the property of Canaway Fleming Architects and this drawing is not to be used for any purposes without the express permission of the Architect. No Implied License is given for its use.


Do not scale from this drawing. All dimensions should be checked on site for accuracy.

Planning
These drawings are for preliminary Planning Purposes must not be used for any other purpose without the express permission of Canaway Fleming Architects. These are not for detailed construction purposes.

Structural Work
All indications as to structure are for graphic purposes only and must not be relied upon for accuracy in terms of size, detail or position. All structure and temporary propping to be confirmed by a suitably qualified structural engineer before beginning works.

Key:
 Dotted red line denotes new basement extension

 Variation reference, document 025-A-SH-01-001 rev B

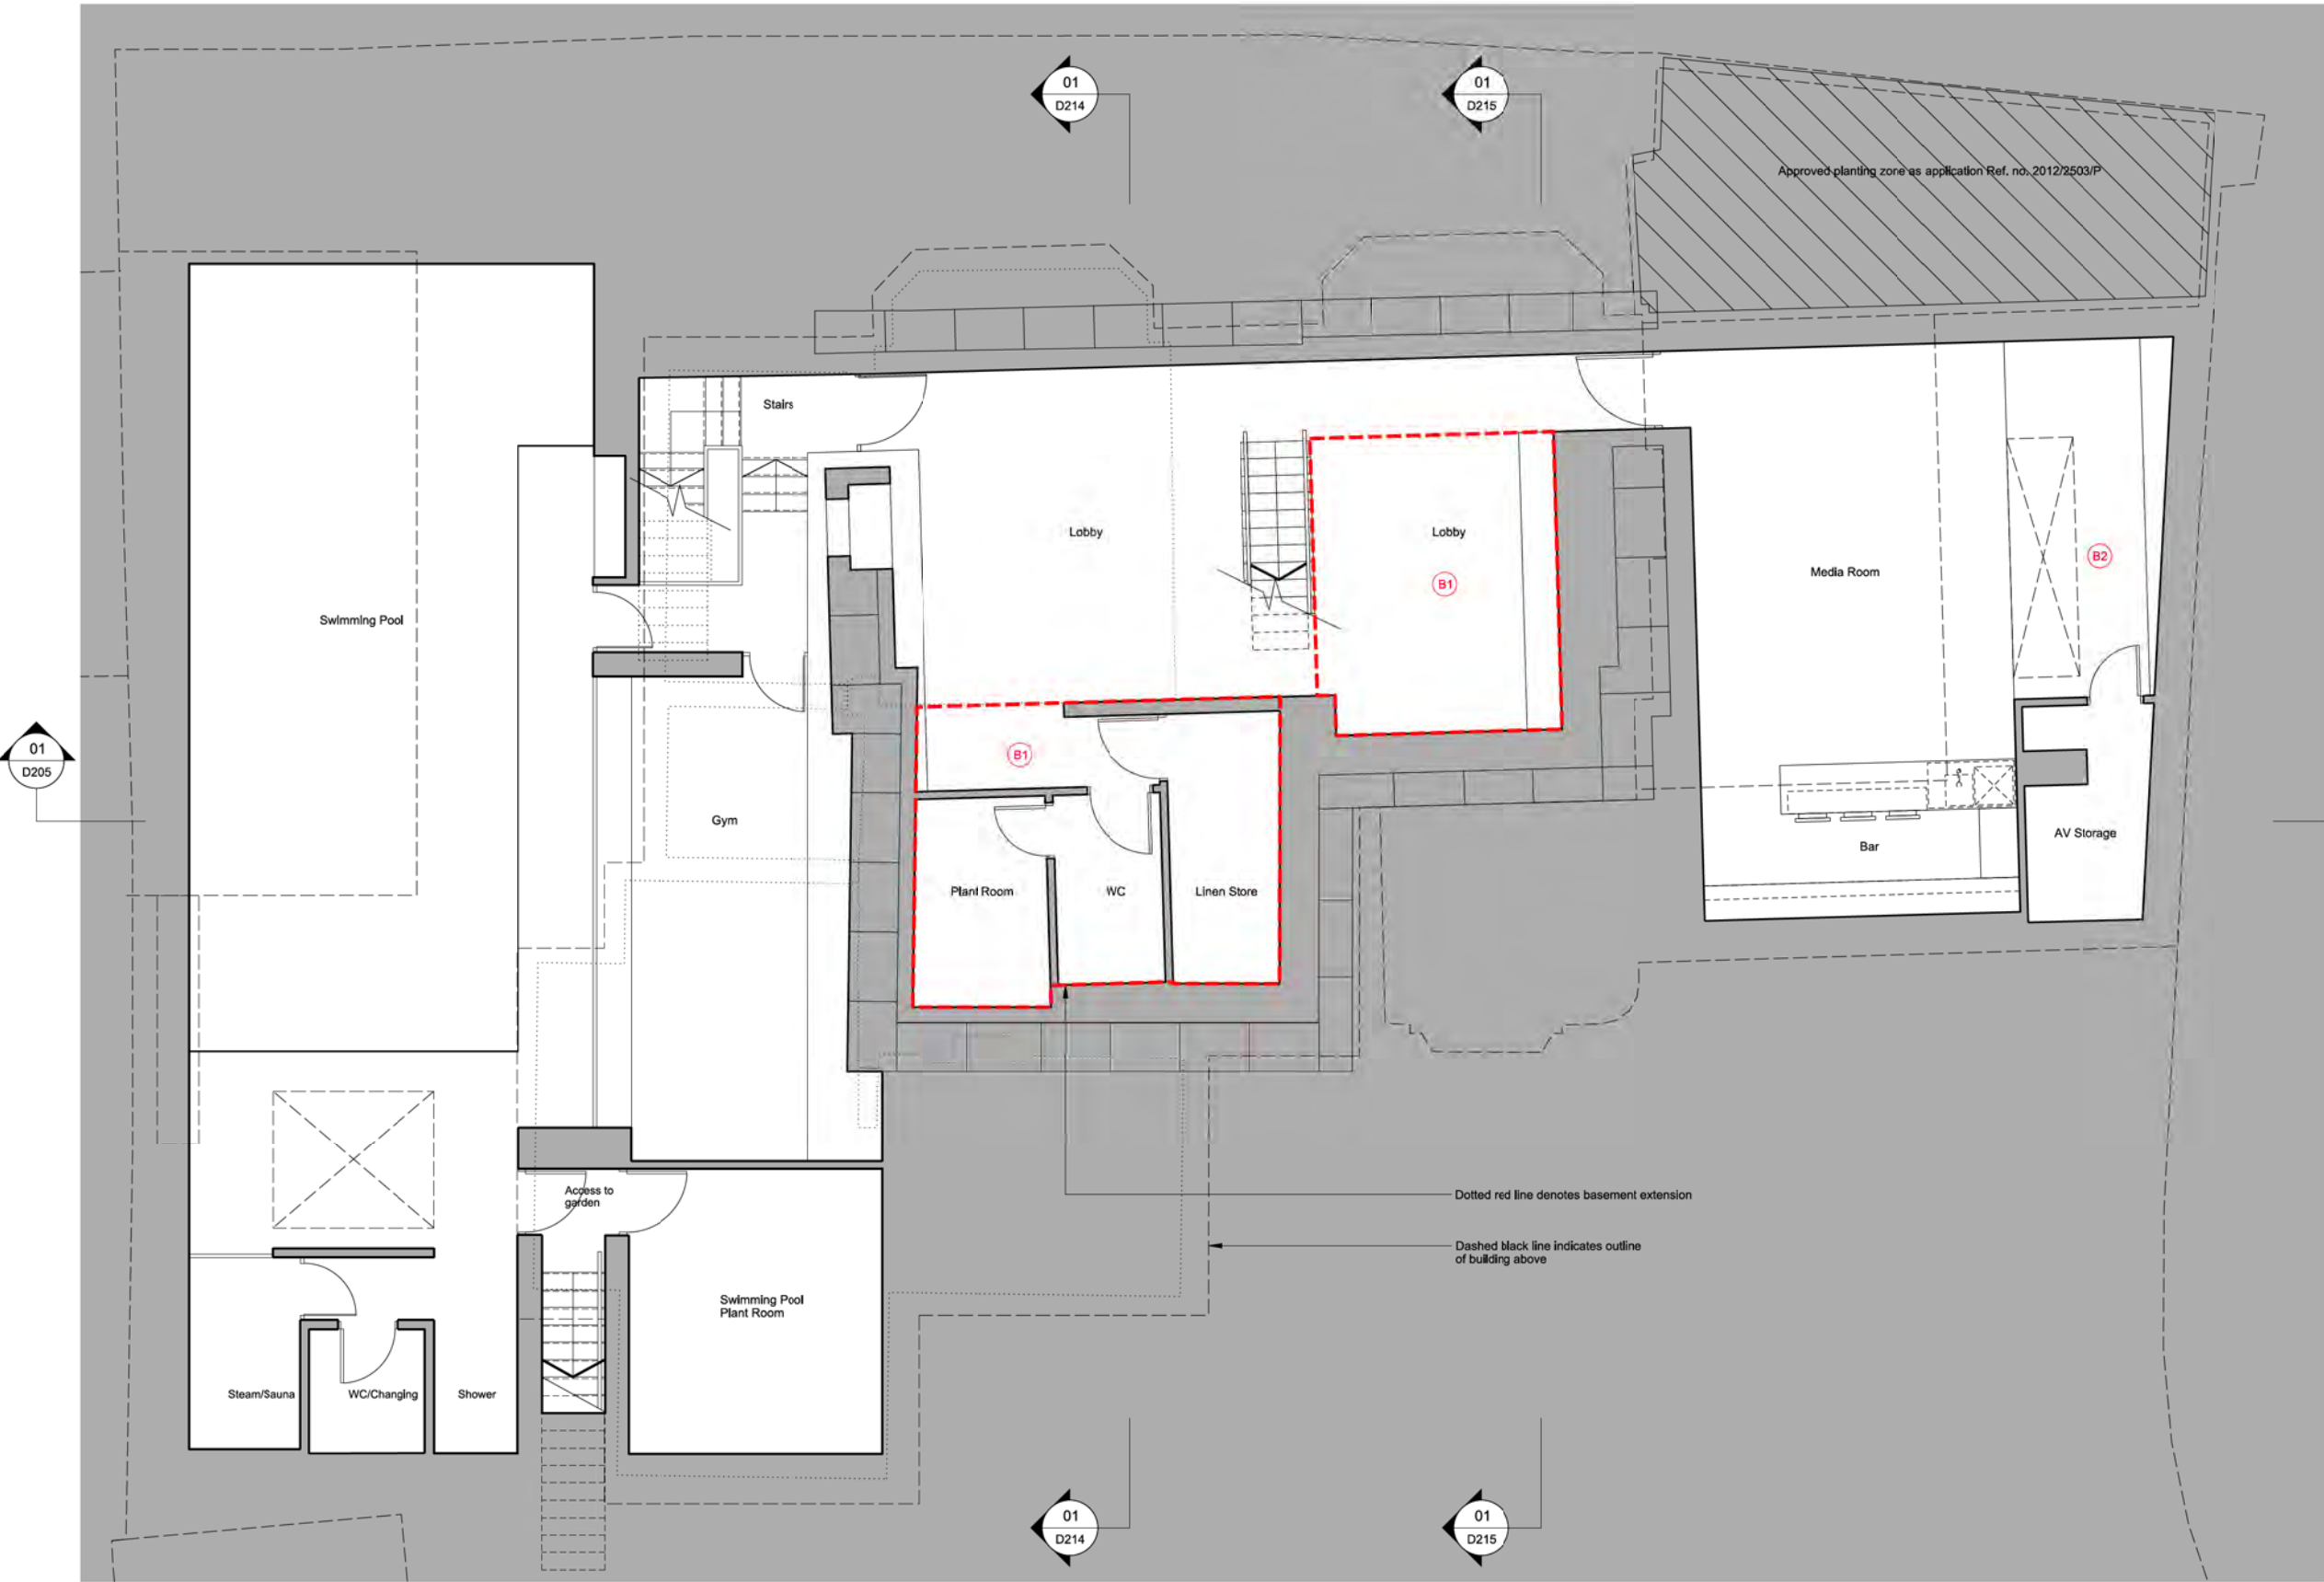

As Proposed

Rev C 27.09.13 Basement layout amended.
Rev B 15.06.13 Updated application ref: 2013/2247
Rev A 22.03.11 Basement layout amended.

Revisions

CANAWAY FLEMING ARCHITECTS

Canaway Fleming Architects Ltd
The Dutch House
307 - 308 High Holborn
London WC1V 7UL
T: 020 7430 2282
F: 020 7430 2274
E: mail@canawayfleming.com

Client Mr Avi Dodi

Project Wildwood Lodge, North End
New Extension and Alterations


Drawing Title Basement Extension
Proposed Basement Plan

Date June 2013 Scale 1:50@A1

Project	Origin	Type	Level/View	Package/Sheet No.	Revision
025	A	P	B1	D200	C
Discipline	Planning	Drawn	CT	Checked	MC

01 BASEMENT PLAN
D200 PROPOSED 1:50

0 0.5 1 5
metres

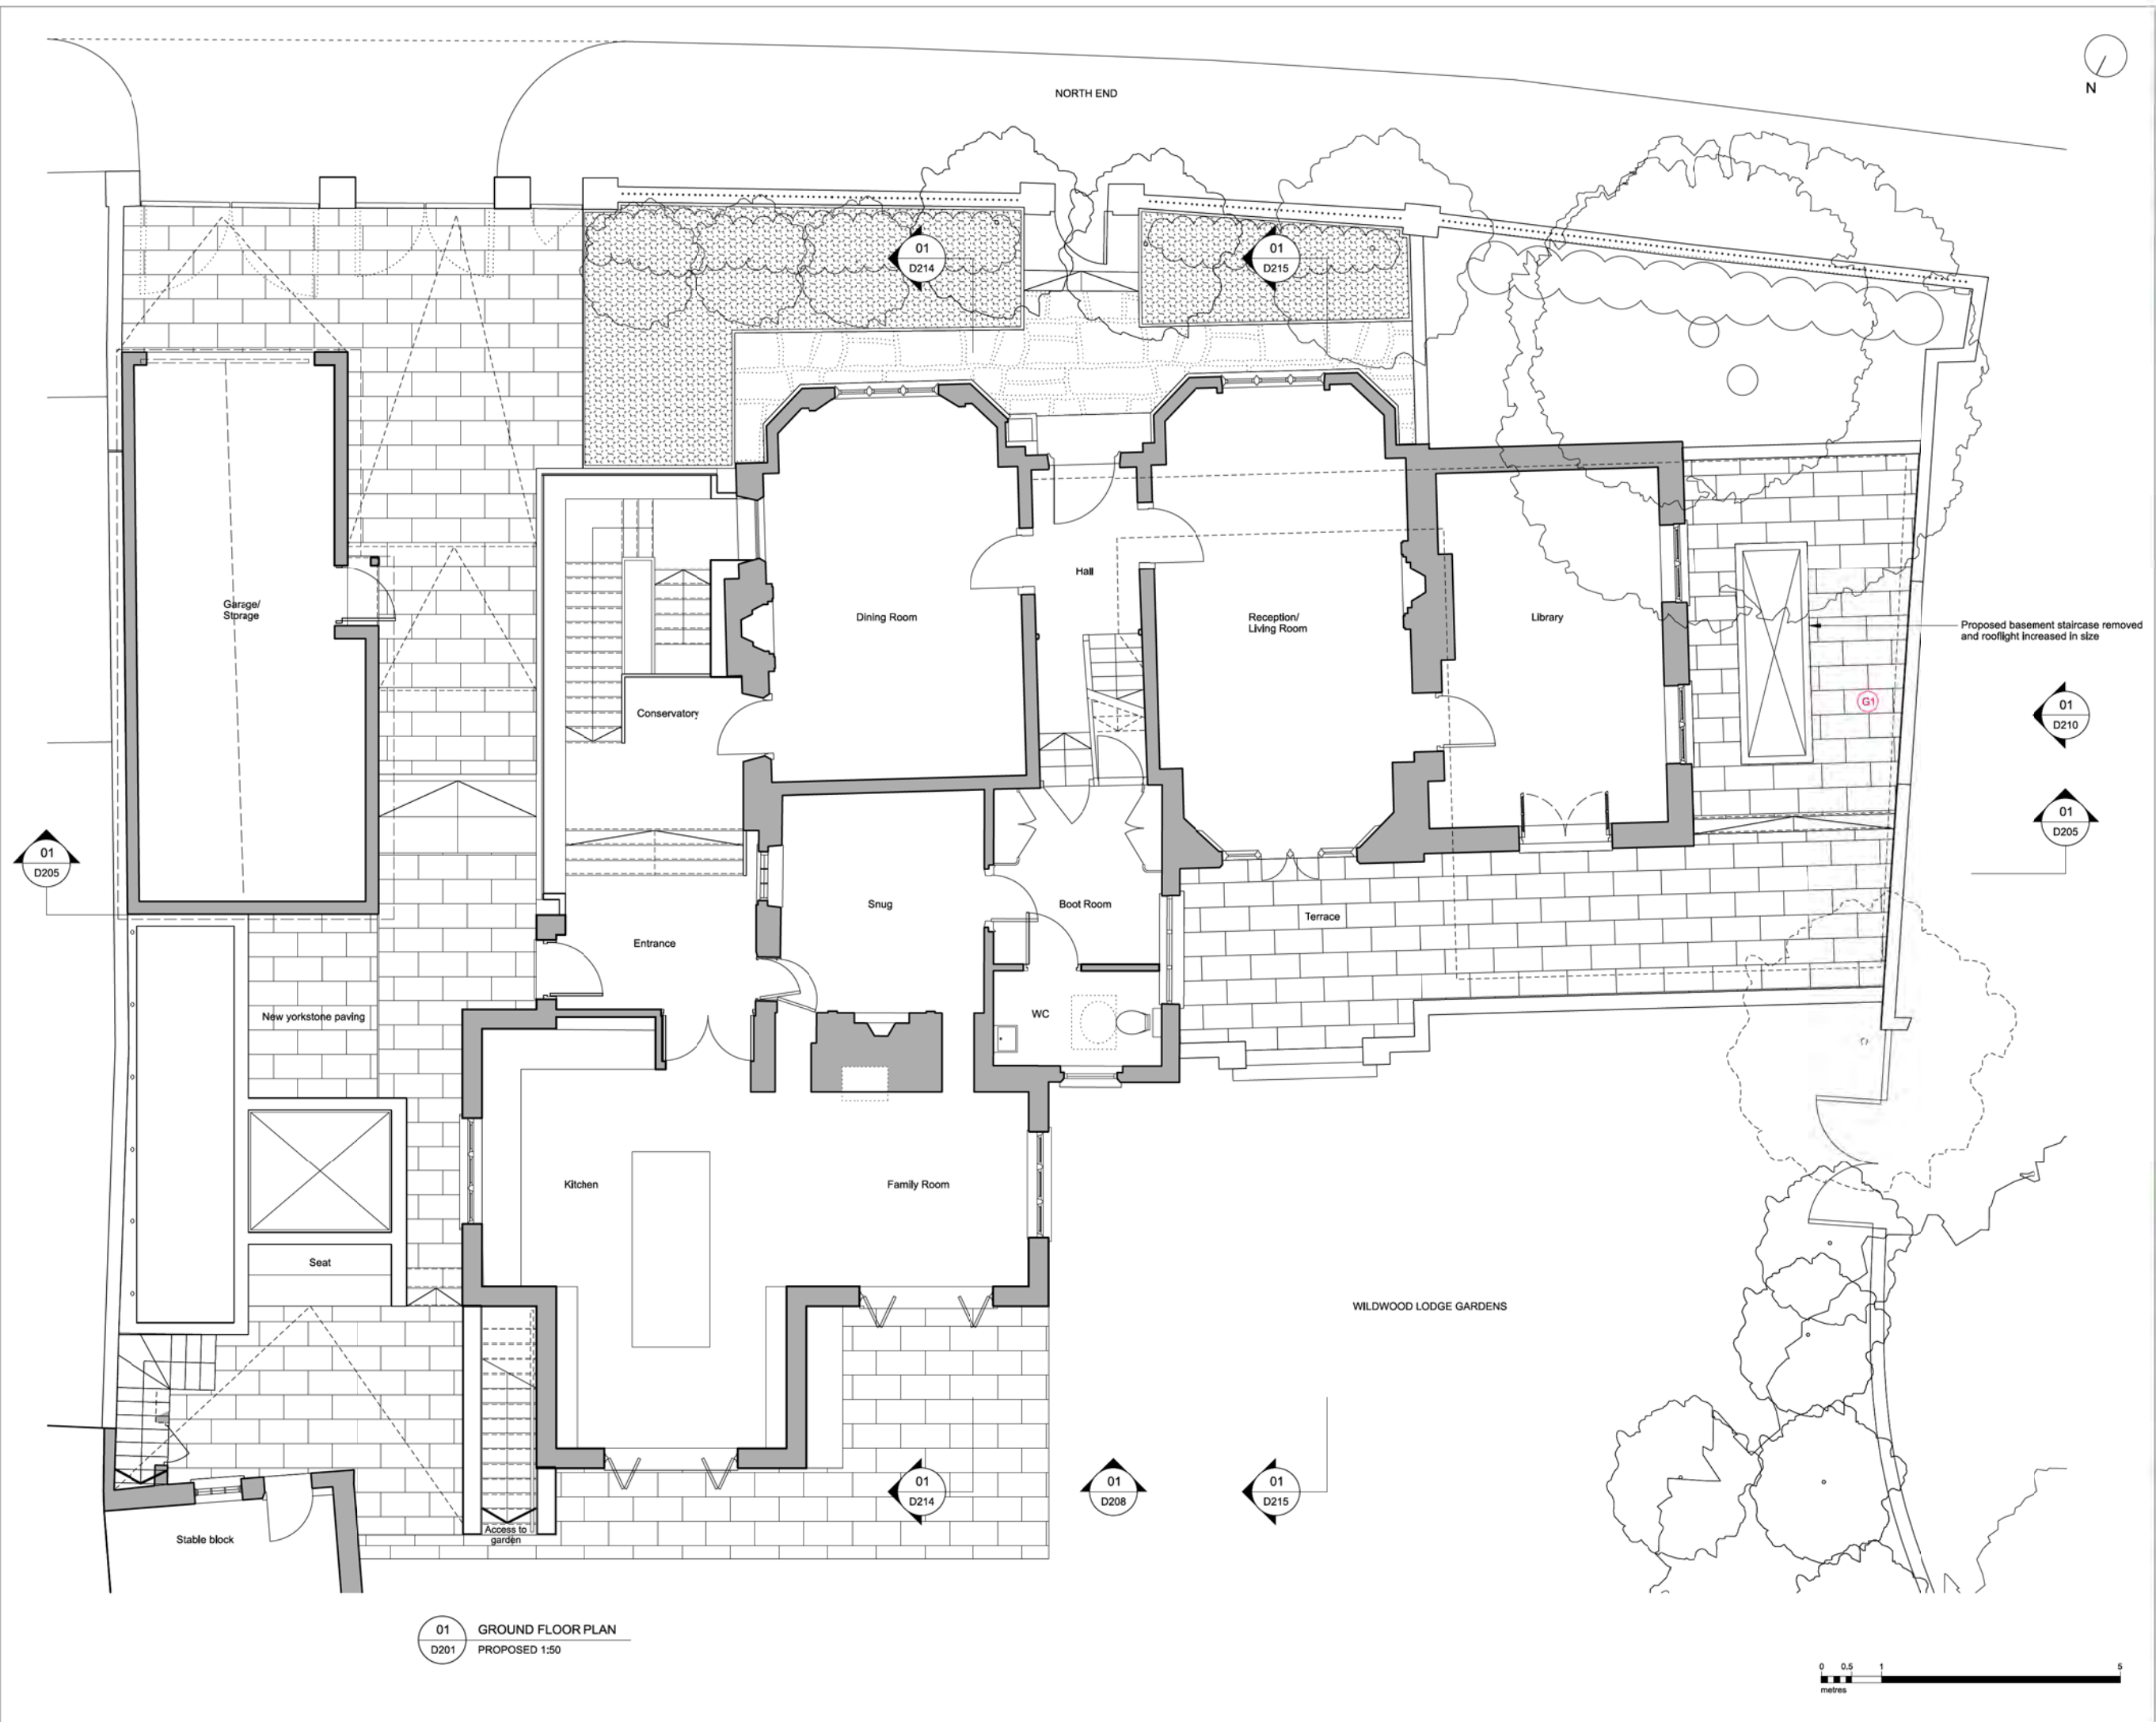

Notes
Copyright remains the property of Canaway Fleming Architects and this drawing is not to be used for any purposes without the express permission of the Architect. No Implied License is given for its use.

Do not scale from this drawing. All dimensions should be checked on site for accuracy.

Planning
These drawings are for preliminary Planning Purposes must not be used for any other purpose without the express permission of Canaway Fleming Architects. These are not for detailed construction purposes.

Structural Work
All indications as to structure are for graphic purposes only and must not be relied upon for accuracy in terms of size, detail or position. All structure and temporary propping to be confirmed by a suitably qualified structural engineer before beginning works.

G1 Variation reference, document 025-A-SH-01-001 rev B

As Proposed

Rev B 27.09.13 Basement staircase removed.
Rev A 18.06.13 Updated application ref: 2013/2247

Windows

CANAWAY FLEMING ARCHITECTS

Canaway Fleming Architects Ltd
The Dutch House
307 - 308 High Holborn
London WC1V 7UL
T: 020 7430 2282
F: 020 7430 2274
E: mail@canawayfleming.com

Client Mr Avi Dodi

Project Wildwood Lodge, North End
New Extension and Alterations

Drawing Title Basement Extension
Proposed Ground Floor Plan

Date June 2013 Scale 1:50@A1

Project	Origin	Type	Level/View	Package/Draw No.	Revision
025	A	P	00	D201	B
Discipline	Planning	Drawn	CT	Checked	MC

Notes
Copyright remains the property of Canaway Fleming Architects and this drawing is not to be used for any purposes without the express permission of the Architect. No Implied License is given for its use.

Do not scale from this drawing. All dimensions should be checked on site for accuracy.

Planning
These drawings are for preliminary Planning Purposes must not be used for any other purpose without the express permission of Canaway Fleming Architects. These are not for detailed construction purposes.

Structural Work
All indications as to structure are for graphic purposes only and must not be relied upon for accuracy in terms of size, detail or position. All structure and temporary propping to be confirmed by a suitably qualified structural engineer before beginning works.

G1 Variation reference, document 025-A-SH-01-001 rev B



As Proposed

Rev B 27.06.13 Basement staircase removed.
Rev A 18.06.13 Updated application ref: 2013/2247
Revisions

CANAWAY FLEMING ARCHITECTS

Canaway Fleming Architects Ltd
The Dutch House
307 - 308 High Holborn
London WC1V 7UL
T: 020 7430 2282
F: 020 7430 2274
E: mailbox@canawayfleming.com

Client Mr Avi Dodi

Project Wildwood Lodge, North End
New Extension and Alterations

Drawing Title Basement Extension
Proposed North Elevation

Date June 2013 Scale 1:50@A1

Project	Origin	Type	Level/View	Package/Sheet No.	Revision
025	A	E	Nth	D208	B
Discipline	Author	Checker	Drawn	Checked	Approved
Planning			CT		MC

01 ELEVATION NORTH
D208 PROPOSED 1:50

0 0.5 1 5
metres

Notes
Copyright remains the property of Canaway Fleming Architects and this drawing is not to be used for any purposes without the express permission of the Architect. No implied License is given for its use.

Do not scale from this drawing. All dimensions should be checked on site for accuracy.

Planning
These drawings are for preliminary Planning Purposes must not be used for any other purpose without the express permission of Canaway Fleming Architects. These are not for detailed construction purposes.

Structural Work
All indications as to structure are for graphic purposes only and must not be relied upon for accuracy in terms of size, detail or position. All structure and temporary propping to be confirmed by a suitably qualified structural engineer before beginning works.

G1 Variation reference, document 025-A-SH-01-001 04.09



As Proposed

Rev B 27.09.13 Basement staircase removed.
Rev A 18.06.13 Updated application ref: 2013/2247
Revisions

CANAWAY FLEMING ARCHITECTS

Canaway Fleming Architects Ltd
The Dutch House
307 - 308 High Holborn
London WC1V 7LL
T: 020 7430 2282
F: 020 7430 2274
E: mailbox@canawayfleming.com

Client: Mr Avi Dodi

Project: Wildwood Lodge, North End
New Extension and Alterations

Drawing Title: Proposed Conservatory
Ground and Roof plans

Date: June 2013 Scale: 1:50@A1

Project	Origin	Type	Level/View	Package/Draw No.	Revision
025	A	E	Wst	D210	B
Discipline	Planning	Drawn	CT	Checked	MC

01 ELEVATION WEST
D210 PROPOSED 1:50

0 0.5 1 5
metres



Notes
Copyright remains the property of Canaway Fleming Architects and this drawing is not to be used for any purposes without the express permission of the Architect. No implied License is given for its use.

Do not scale from this drawing. All dimensions should be checked on site for accuracy.

Planning
These drawings are for preliminary Planning Purposes must not be used for any other purpose without the express permission of Canaway Fleming Architects. These are not for detailed construction purposes.

Structural Work
All indications as to structure are for graphic purposes only and must not be relied upon for accuracy in terms of size, detail or position. All structure and temporary propping to be confirmed by a suitably qualified structural engineer before beginning works.

Key:

 Dotted red line denotes new basement extension

B1 Variation reference, document 025-A-SH-01-001 rev B

As Proposed

Rev C 27.09.13 Basement layout amended.
Rev B 18.06.13 Updated application ref: 2013/2247
Rev A 22.03.13 Basement layout amended.
Revisions

CANAWAY FLEMING ARCHITECTS

Canaway Fleming Architects Ltd
The Dutch House
307 - 308 High Holborn
London WC1V 7LL
T: 020 7430 2262
F: 020 7430 2274
E: mail@canawayfleming.com

Client Mr Avi Dodi

Project Wildwood Lodge, North End
New Extension and Alterations

Drawing Title Basement Extension
Proposed Section BB

Date August 2012 Scale 1:50@A1

Project	Origin	Type	Level/View	Package/Doc no.	Revision
025	A	X	BB	D205	C
Discipline	Planning		Drawn	DL	Checked MC

01 SECTION BB
D205 PROPOSED 1:50



Notes
Copyright remains the property of Canaway Fleming Architects and this drawing is not to be used for any purposes without the express permission of the Architect. No Implied License is given for its use.

Do not scale from this drawing. All dimensions should be checked on site for accuracy.

Planning
These drawings are for preliminary Planning Purposes must not be used for any other purpose without the express permission of Canaway Fleming Architects. These are not for detailed construction purposes.

Structural Work
All indications as to structure are for graphic purposes only and must not be relied upon for accuracy in terms of size, detail or position. All structure and temporary propping to be confirmed by a suitably qualified structural engineer before beginning works.

Key:
 Dotted red line denotes new basement extension
 Variation reference, document 025-A-SH-01-001 rev B



Dotted red line denotes
basement extension

As Proposed

Rev B 27.09.13 Basement layout amended.

Rev A 18.06.13 Updated application ref: 2013/2247

Revisions

CANAWAY FLEMING ARCHITECTS

Canaway Fleming Architects Ltd
The Dutch House
307 - 308 High Holborn
London WC1V 7LL

T: 020 7430 2282
F: 020 7430 2274
E: mail@canawayfleming.com

Client Mr Avi Dodi

Project Wildwood Lodge, North End
New Extension and Alterations

Drawing Title Basement Extension
Proposed Section DD

Date June 2013 Scale 1:50@A1

Project	Origin	Type	Level/View	Package/Draw No.	Revision
025	A	X	DD	D214	B
Drawn	Planning			Drawn	Checked
				CT	MC

01 SECTION DD
D214 PROPOSED 1:50

Notes
Copyright remains the property of Canaway Fleming Architects and this drawing is not to be used for any purposes without the express permission of the Architect. No Implied License is given for its use.

Do not scale from this drawing. All dimensions should be checked on site for accuracy.

Planning
These drawings are for preliminary Planning Purposes must not be used for any other purpose without the express permission of Canaway Fleming Architects. These are not for detailed construction purposes.

Structural Work
All indications as to structure are for graphic purposes only and must not be relied upon for accuracy in terms of size, detail or position. All structure and temporary propping to be confirmed by a suitably qualified structural engineer before beginning works.

Key:
 Dotted red line denotes new basement extension
 Variation reference, document 025-A-SH-01-001 rev B



As Proposed

Rev B 27.09.13 Basement layout amended.
Rev A 18.06.11 Updated application ref: 2013/2247
Revisions

CANAWAY FLEMING ARCHITECTS

Canaway Fleming Architects Ltd
The Dutch House
307 - 308 High Holborn
London WC1V 7UL
T: 020 7430 2282
F: 020 7430 2274
E: mailbox@canawayfleming.com

Client Mr Avi Dodi

Project Wildwood Lodge, North End
New Extension and Alterations

Drawing Title Basement Extension
Proposed Section EE

Date June 2013 Scale 1:50@A1

Project	Origin	Type	Level/View	Package/Sheet No.	Revision
025	A	X	EE	D215	B
Discipline	Planning	Drawn	CT	Checked	MC

01 SECTION EE
D215 PROPOSED 1:50

0 0.5 1 5
metres

Approved basement under application Ref. no. 2010/4924/P




Notes
Copyright remains the property of Canaway Fleming Architects and this drawing is not to be used for any purposes without the express permission of the Architect. No implied License is given for its use.

Do not scale from this drawing. All dimensions should be checked on site for accuracy.

Planning
These drawings are for preliminary Planning Purposes must not be used for any other purpose without the express permission of Canaway Fleming Architects. These are not for detailed construction purposes.

Structural Work
All indications as to structure are for graphic purposes only and must not be relied upon for accuracy in terms of size, detail or position. All structure and temporary propping to be confirmed by a suitably qualified structural engineer before beginning works.

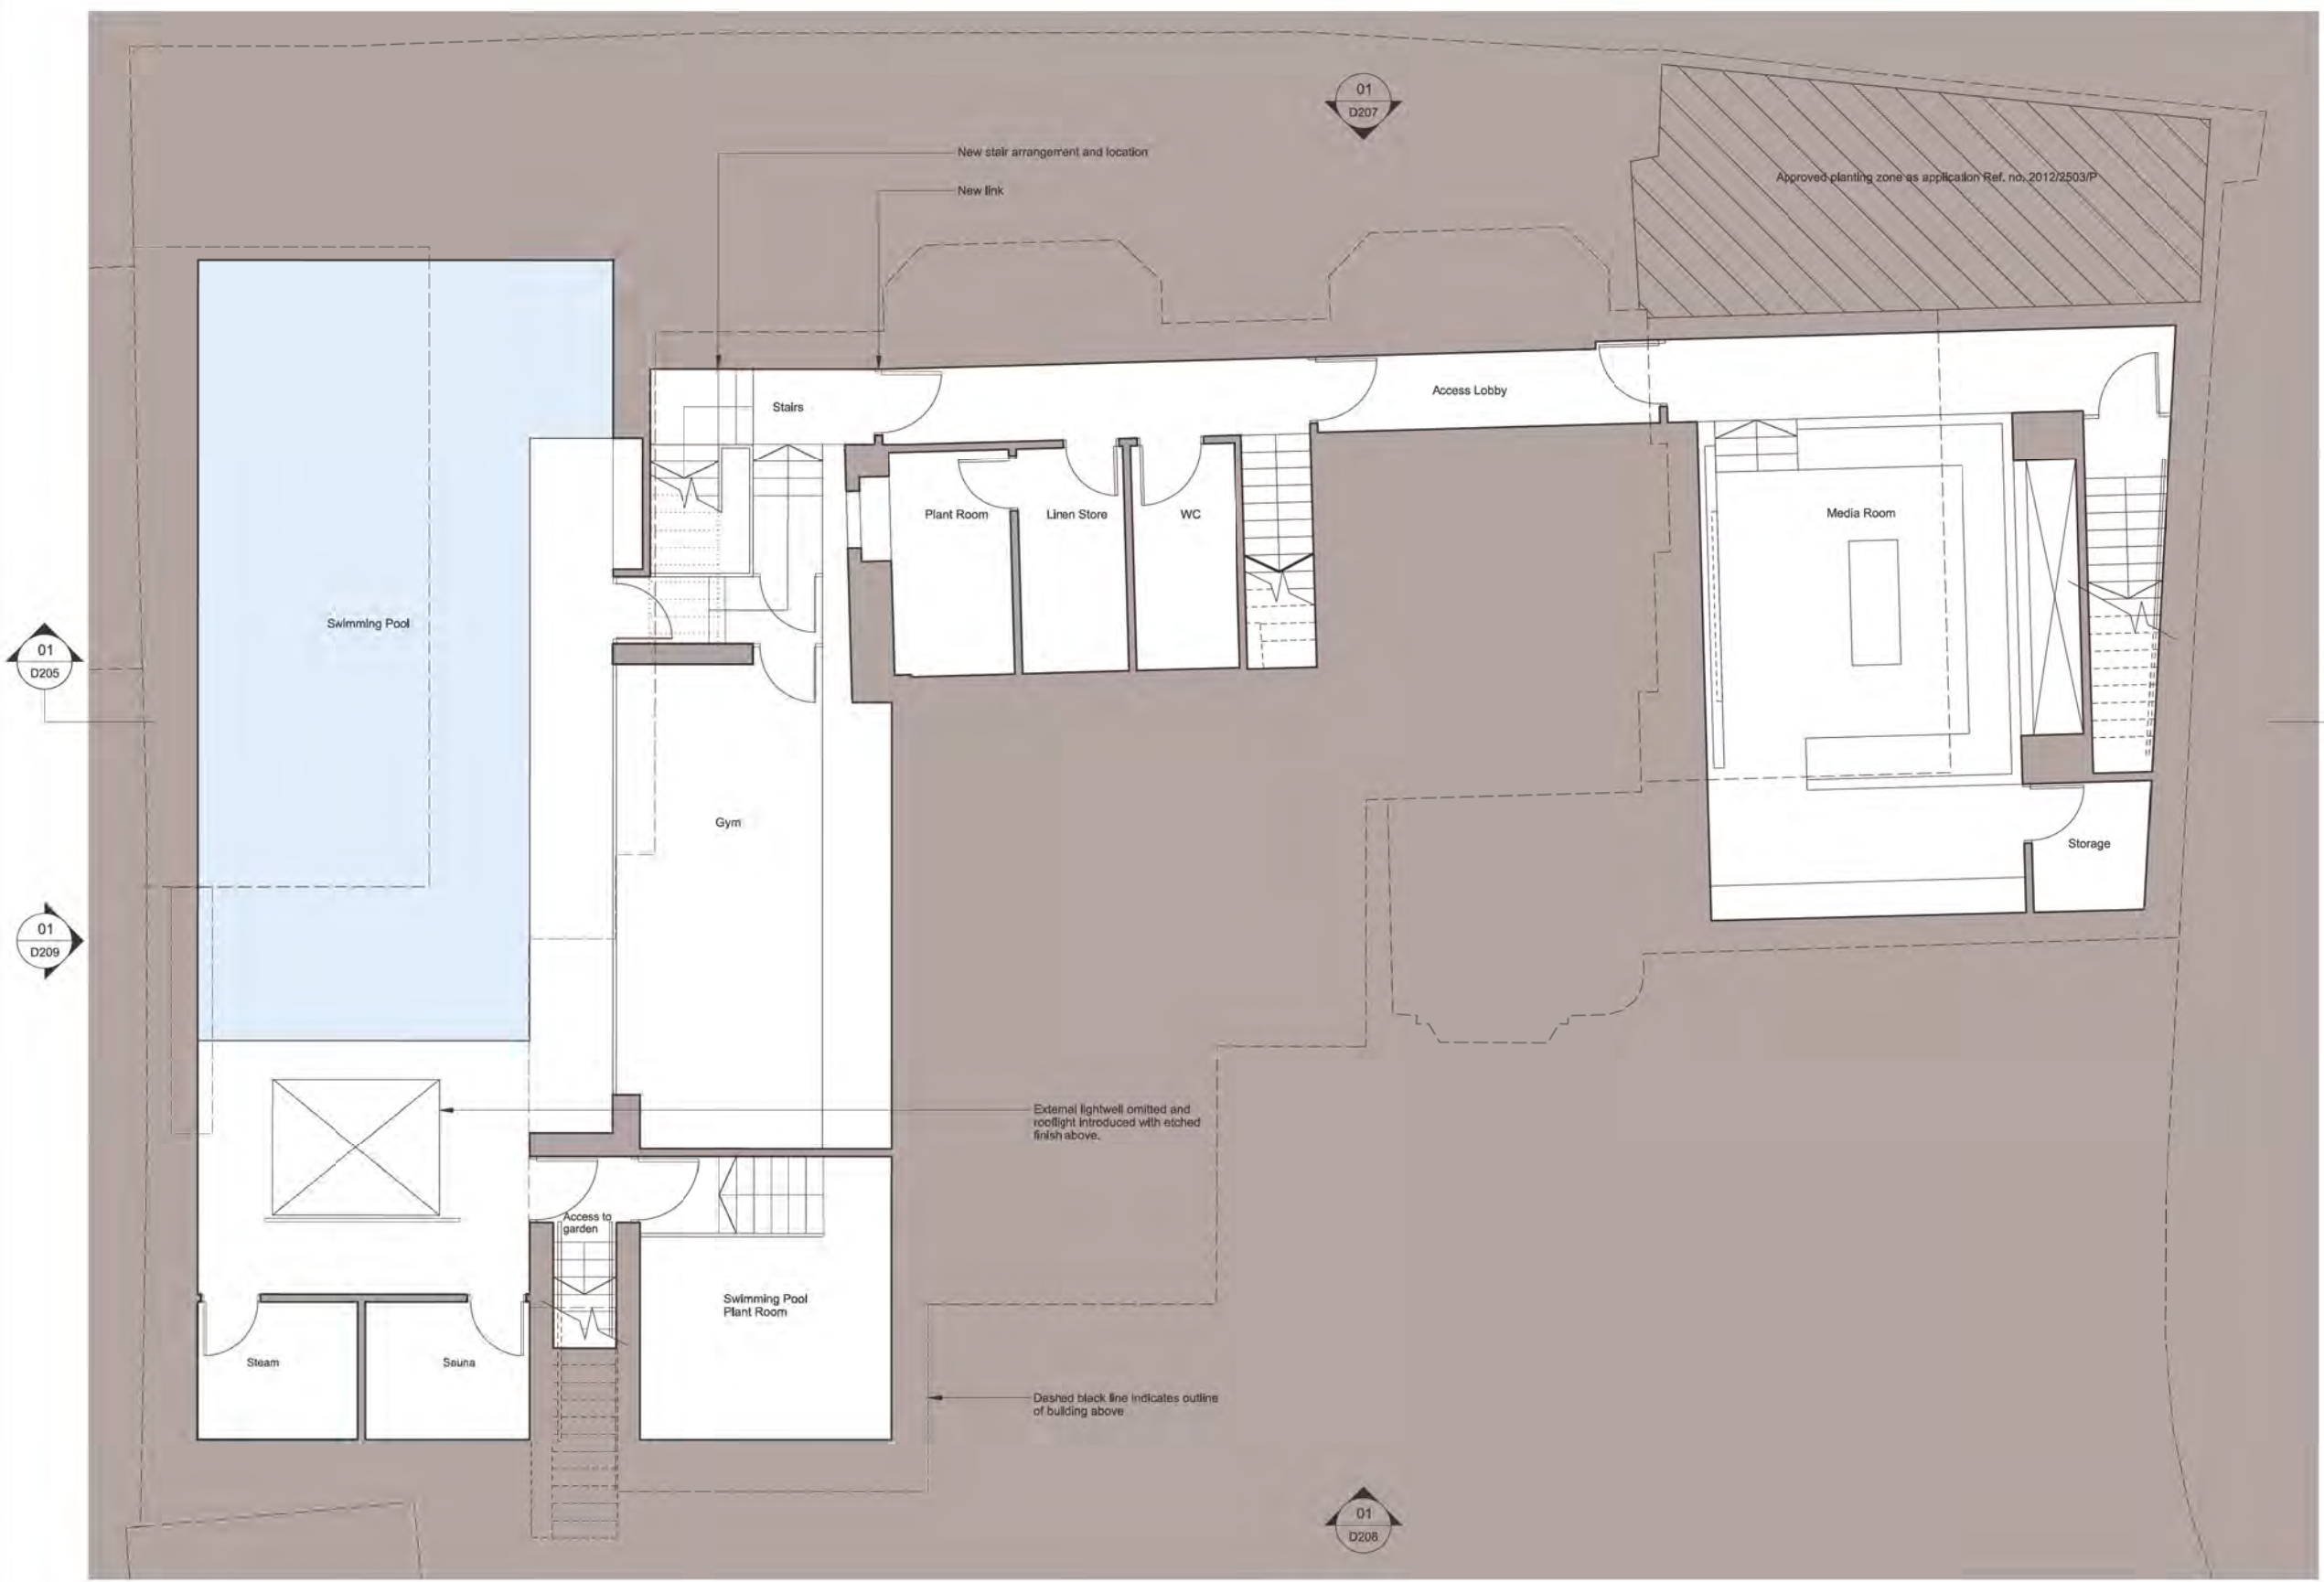

01 BASEMENT PLAN
D200 PROPOSED 1:50

As Approved
Ref: 2012/4611/P and 2012/4615/L

Revisions

CANAWAY FLEMING ARCHITECTS

Canaway Fleming Architects Ltd
The Dutch House
307 - 308 High Holborn
London WC1V 7LL
T: 020 7430 2282
F: 020 7430 2274
E: info@canawayfleming.com


Client Mr Avi Dodi

Project Wildwood Lodge, North End
New Extension and Alterations

Drawing Title Basement Extension
Proposed Basement Plan

Date August 2012 Scale 1:50@A1

Project	Origin	Type	Level/View	Package Draw No.	Revision
025	A	P	B1	D200	-
Discipline	Planning	Drawn	DL	Checked	MC

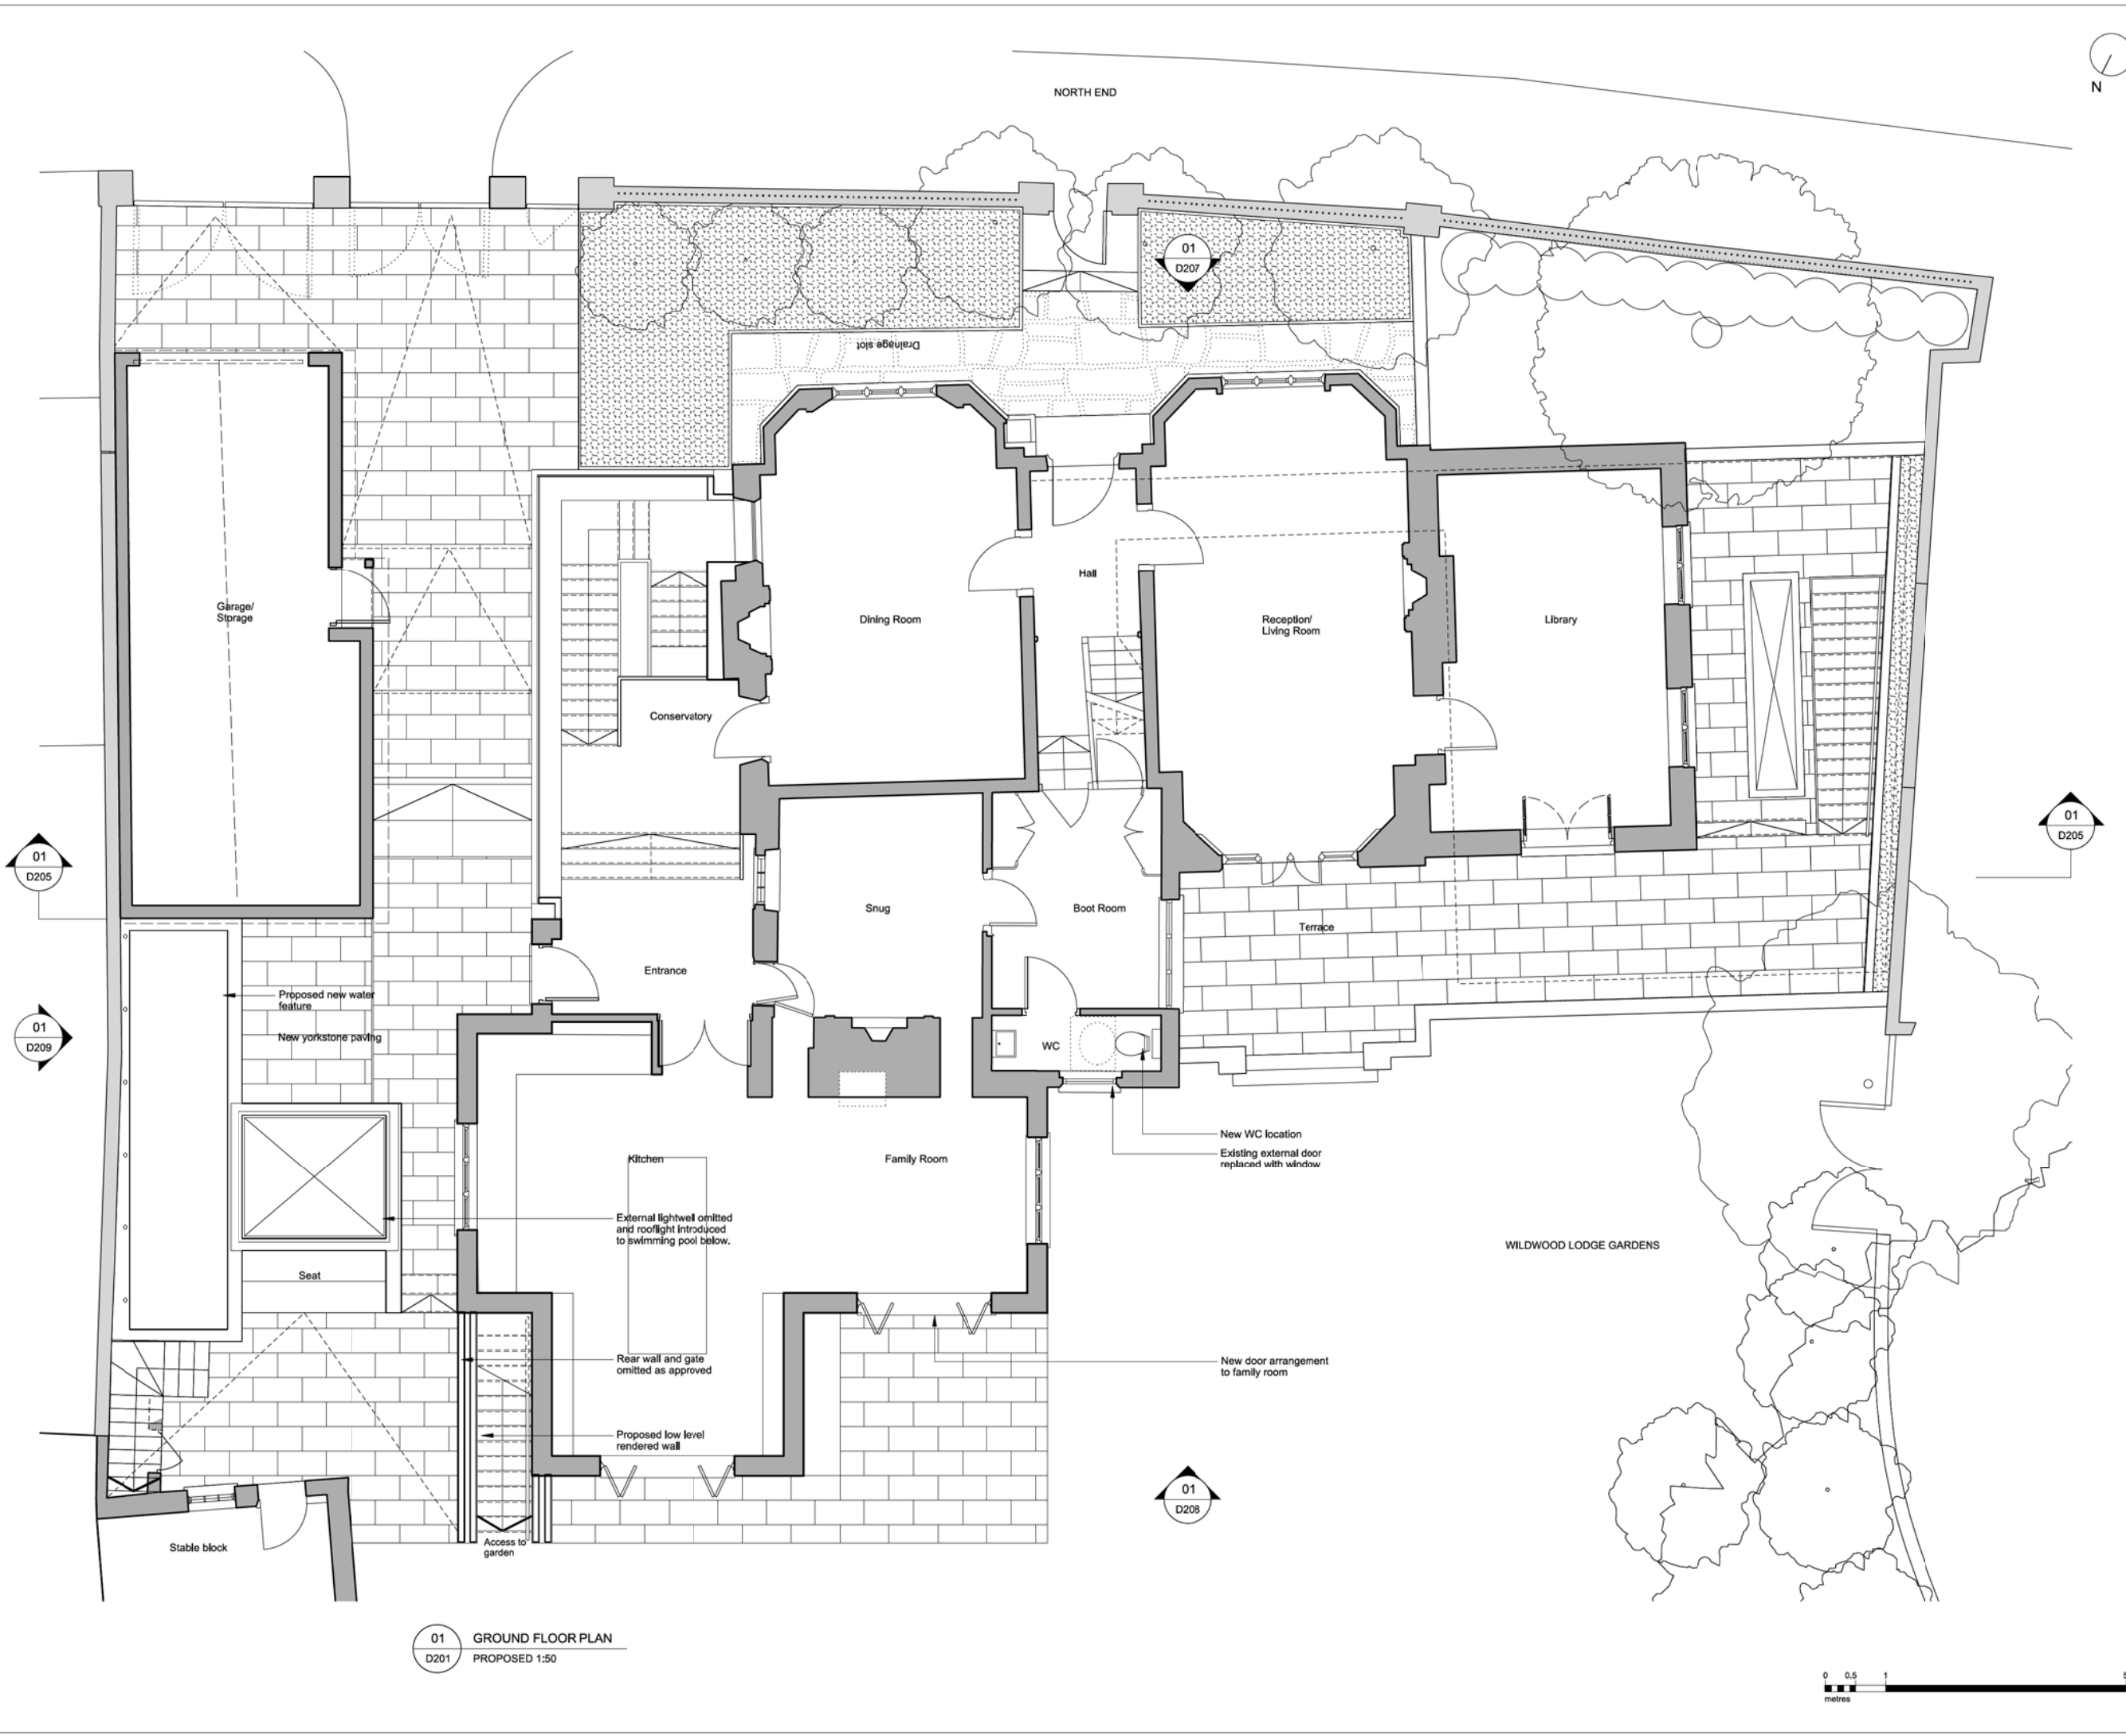

Notes
Copyright remains the property of Canaway Fleming Architects and this drawing is not to be used for any purposes without the express permission of the Architect. No implied License is given for its use.

Do not scale from this drawing. All dimensions should be checked on site for accuracy.

Planning
These drawings are for preliminary Planning Purposes must not be used for any other purpose without the express permission of Canaway Fleming Architects. These are not for detailed construction purposes.

Structural Work
All indications as to structure are for graphic purposes only and must not be relied upon for accuracy in terms of size, detail or position. All structure and temporary propping to be confirmed by a suitably qualified structural engineer before beginning works.

As Approved
Ref: 2012/4611/P and 2012/4615/L

Canaway Fleming Architects Ltd
The Dutch House
307 - 308 High Holborn
London WC1V 7LL
T: 020 7430 2282
F: 020 7430 2274
E: mail@canawayfleming.com

Client: Mr Avi Dodi
Project: Wildwood Lodge, North End
New Extension and Alterations
Drawing Title: Basement Extension
Proposed Ground Floor Plan

Date: August 2012 Scale: 1:50@A1

Project	Origin	Type	Level/View	Package/Draw No.	Revision
025	A	P	00	D201	-
Drawn	Checked	Drawn	Checked	Drawn	Checked
Planning	DL	MC			

Notes
Copyright remains the property of Canaway Fleming Architects and this drawing is not to be used for any purposes without the express permission of the Architect. No implied License is given for its use.

Do not scale from this drawing. All dimensions should be checked on site for accuracy.

Planning
These drawings are for preliminary Planning Purposes must not be used for any other purpose without the express permission of Canaway Fleming Architects. These are not for detailed construction purposes.

Structural Work
All indications as to structure are for graphic purposes only and must not be relied upon for accuracy in terms of size, detail or position. All structure and temporary propping to be confirmed by a suitably qualified structural engineer before beginning works.



As Approved
Ref: 2012/4611/P and 2012/4615/L

Revisions

CANAWAY FLEMING ARCHITECTS

Canaway Fleming Architects Ltd
The Dutch House
307 - 308 High Holborn
London WC1V 7LL
T: 020 7430 2262
F: 020 7430 2274
E: mail@canawayfleming.com

Client Mr Avi Dodi

Project Wildwood Lodge, North End
New Extension and Alterations

Drawing Title Basement Extension
Proposed Section BB

Date August 2012 Scale 1:50@A1

01 SECTION BB
D205 PROPOSED 1:50



Project	Origin	Type	Level/View	Package/Draw no.	Revision
025	A	X	BB	D205	-
Discipline	Planning	Drawn	DL	Checked	MC

Notes
Copyright remains the property of Canaway Fleming Architects and this drawing is not to be used for any purposes without the express permission of the Architect. No implied License is given for its use.

Do not scale from this drawing. All dimensions should be checked on site for accuracy.

Planning
These drawings are for preliminary Planning Purposes must not be used for any other purpose without the express permission of Canaway Fleming Architects. These are not for detailed construction purposes.

Structural Work
All indications as to structure are for graphic purposes only and must not be relied upon for accuracy in terms of size, detail or position. All structure and temporary propping to be confirmed by a suitably qualified structural engineer before beginning works.



As Approved
Ref: 2012/4611/P and 2012/4615/L

Revisions

CANAWAY FLEMING ARCHITECTS

Canaway Fleming Architects Ltd
The Dutch House
307 - 308 High Holborn
London WC1V 7UL
T: 020 7430 2282
F: 020 7430 2274
E: mailbox@canawayfleming.com

Client: Mr Avi Dodi

Project: Wildwood Lodge, North End
New Extension and Alterations

Drawing Title: Basement Extension
Proposed North Elevation

Date: August 2012 Scale: 1:50@A1

Project	Origin	Type	Level/View	Package/Sheet No.	Revision
025	A	E	Nth	D208	-
Drawn	Checked	Drawn	Checked	Drawn	Checked
Planning		DL		MC	

01 ELEVATION NORTH
D208 PROPOSED 1:50



Notes
Copyright remains the property of Canaway Fleming Architects and this drawing is not to be used for any purposes without the express permission of the Architect. No implied License is given for its use.

Do not scale from this drawing. All dimensions should be checked on site for accuracy.

Planning
These drawings are for preliminary Planning Purposes must not be used for any other purpose without the express permission of Canaway Fleming Architects. These are not for detailed construction purposes.

Structural Work
All indications as to structure are for graphic purposes only and must not be relied upon for accuracy in terms of size, detail or position. All structure and temporary propping to be confirmed by a suitably qualified structural engineer before beginning works.



As Approved
Ref: 2012/4611/P and 2012/4615/L

Revisions

CANAWAY FLEMING ARCHITECTS

Canaway Fleming Architects Ltd
The Dutch House
307 - 309 High Holborn
London WC1V 7UL
T: 020 7430 2282
F: 020 7430 2274
E: mail@canawayfleming.com

Client: Mr Avi Dodi

Project: Wildwood Lodge, North End
New Extension and Alterations

Drawing Title: Proposed Conservatory
Ground and Roof plans

Date: August 2012 Scale: 1:50@A1

Project	Origin	Type	Level/View	Package/Draw No.	Revision
025	A	E	Wst	D210	-
Drawn	Checked	Drawn	Checked	Drawn	Checked
Planning		DL		MC	

01 ELEVATION WEST
D210 PROPOSED 1:50

0 0.5 1 2
metres

CANAWAY FLEMING ARCHITECTS

The Dutch House
307-308 High Holborn
London WC1V 7LL

T. +44 (0) 207 430 2262
E. mailbox@canawayfleming.com
www.canawayfleming.com

© Copyright Canaway Fleming Architects

We accept no responsibility for the consequences of this document being relied upon by any other party, or being used for any other purpose, or containing any error or omission which is due to an error or omission in data supplied to us by other parties.

This document contains confidential information and proprietary intellectual property. It should not be shown to other parties without consent from us and from the party that commissioned it.