


Derby Lodge 7 - 11 Britannia Street

Wicklow Street

Centre for Auditory Research

North Elevation

Outline of Royal National Throat
Nose and Ear Hospital behind
shown dashed

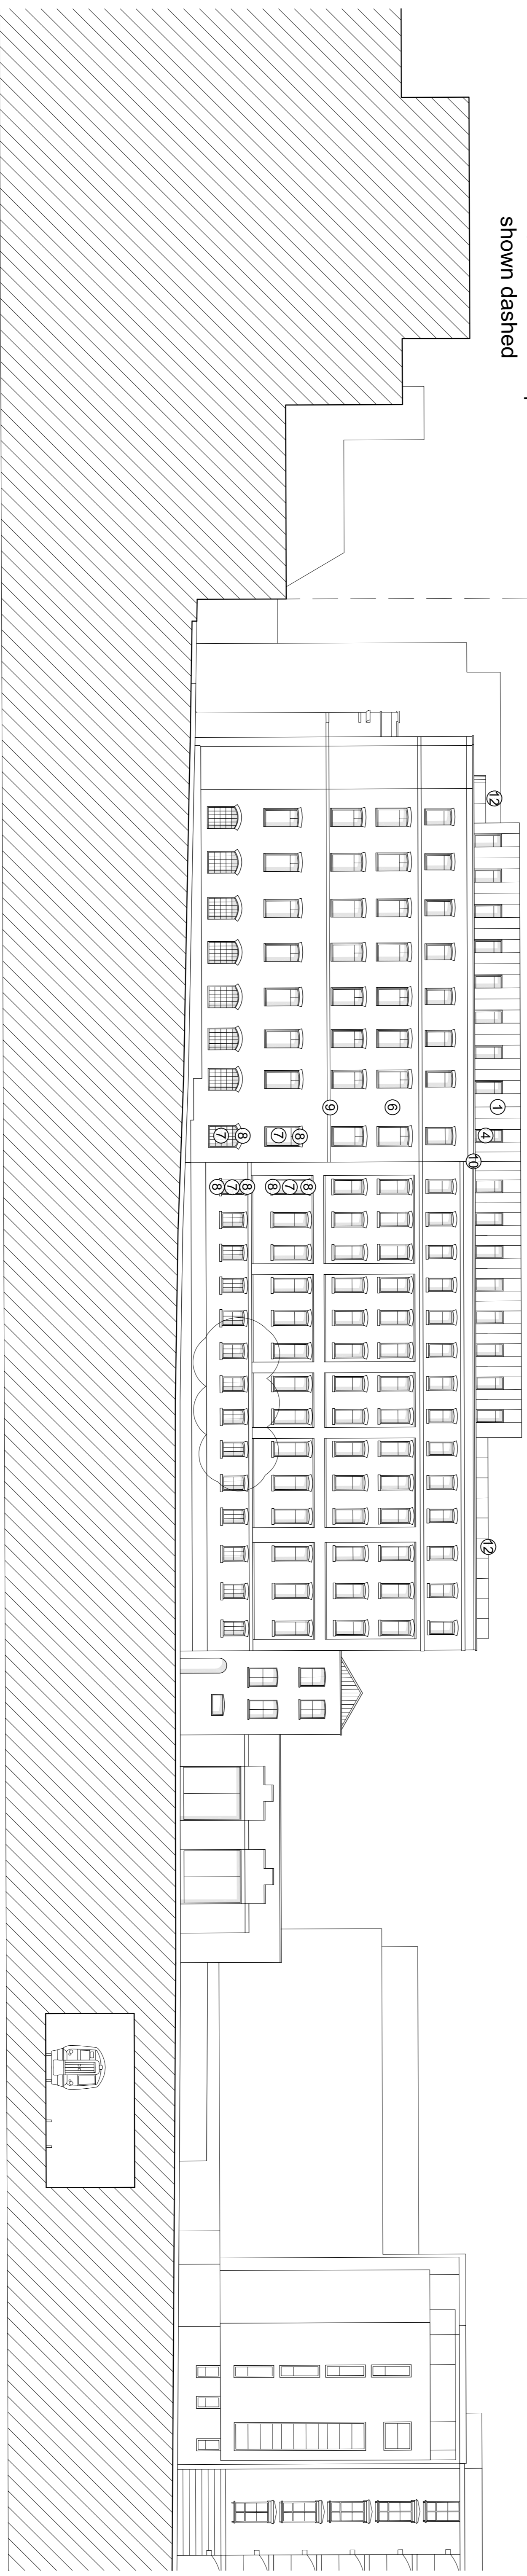

Royal National Throat Nose and Ear Hospital

146 Wicklow Street

South Elevation

0 2 4 6 8 10m
Scale 1:200

- | | | |
|---------------------------------------|---|---|
| ① Zinc composite panel | ⑤ RAL 9007 Gun Metal Grey Anodised Aluminium Louvre Panel | ⑨ Slate grey stretcher course brickwork |
| ② London Yellow Stock Brick | ⑥ Recycled London Yellow Stock Brick to match existing | ⑩ Stone coping at parapet level |
| ③ Slate grey wearing course brickwork | ⑦ Double Glazed Timber framed window unit | ⑪ Grey Stock brick |
| ④ Metal framed window unit | ⑧ Red Stock brick | ⑫ Glass Balustrade |
| | | ⑬ Flue |
| | | ⑭ Lift Overrun |

Proposed North and South Elevation

Contractor must submit A4 drawings of all features comprising any work for their signature. If this includes any to be fabricated within the work it is intended, CAD format drawings to be submitted from the supplier. Do not scale of this drawing. Double check on Callans Scale and / or existing record drawings - design and drawing content subject to Site Survey, Structural Survey, Site Investigations, Planning and Statutory Requirements and Approvals. Amended reproduction from Callans Survey Map with permission of the Controller of Her Majesty's Stationery Office. Crown Copyright reserved. copyright reserved. Carey Jones Chapman Tolcher (Surrey South) Limited Copyright.

Windows on South Elevation Restored
Flue & lift overrun added to North Elevation
Other Comments Incorporated
Drawing Marked
Rev. Des.

SSS 26/09/13 JSW
KAC 18/06/13 JSW
SSS 01/08/12 JSW
SSS 19/07/12 JSW
SSS 01/08/12 JSW
By Date

Rev. Des. By Date

Project: Britannia Street 23083
Location: London
Title: Proposed North and South Elevation
Scale: 1:200 @ A1 1:400 @ A3 SES
Date: May 2012
Drawn By: JSW
Checked By: JSW
Revision: F

Vertical House, Southampton Row
Eboracshire, London WC1R 4EA
Tel: +44 (0)20 7289 9400
Fax: +44 (0)20 7289 9401
Rosa Ward, Earl Street
Leeds LS1 8BE
Tel: +44 (0)113 224 5000
Fax: +44 (0)113 224 5001
Rosedale House, 49 Rosedale
Market Harborough, Leicestershire
Tel: +44 (0)1509 212 1190
www.careyjones.com
careyjones
chapmantolcher

Planning