


ELEVATION  
see Drawing - No.: 21471-B-101

VERTICAL SECTION  
205 - 205

9 See Drawing  
21471-B-204

Drawing-No	21471 - B - 205	Revision	01
CAD-No	B-205b detail section	Drawn by/Date	22.03.2013, sen
Project	St. Edmunds Terrace, London N18	Checked	
Architect	Squire and Partners, London	Status	
Contractor		Approved for construction	<input type="checkbox"/> A
Scale	1:1	Approved for construction with corrections, resubmission required	<input type="checkbox"/> B
Title	Window Type 03	Not approved for construction, resubmission required	<input type="checkbox"/> C
Author	1189 x 841	Copyright by Metatrader Print	
Client	Window Type 03		
Version	03 amended see comments 03.04.13		
Revision	03		

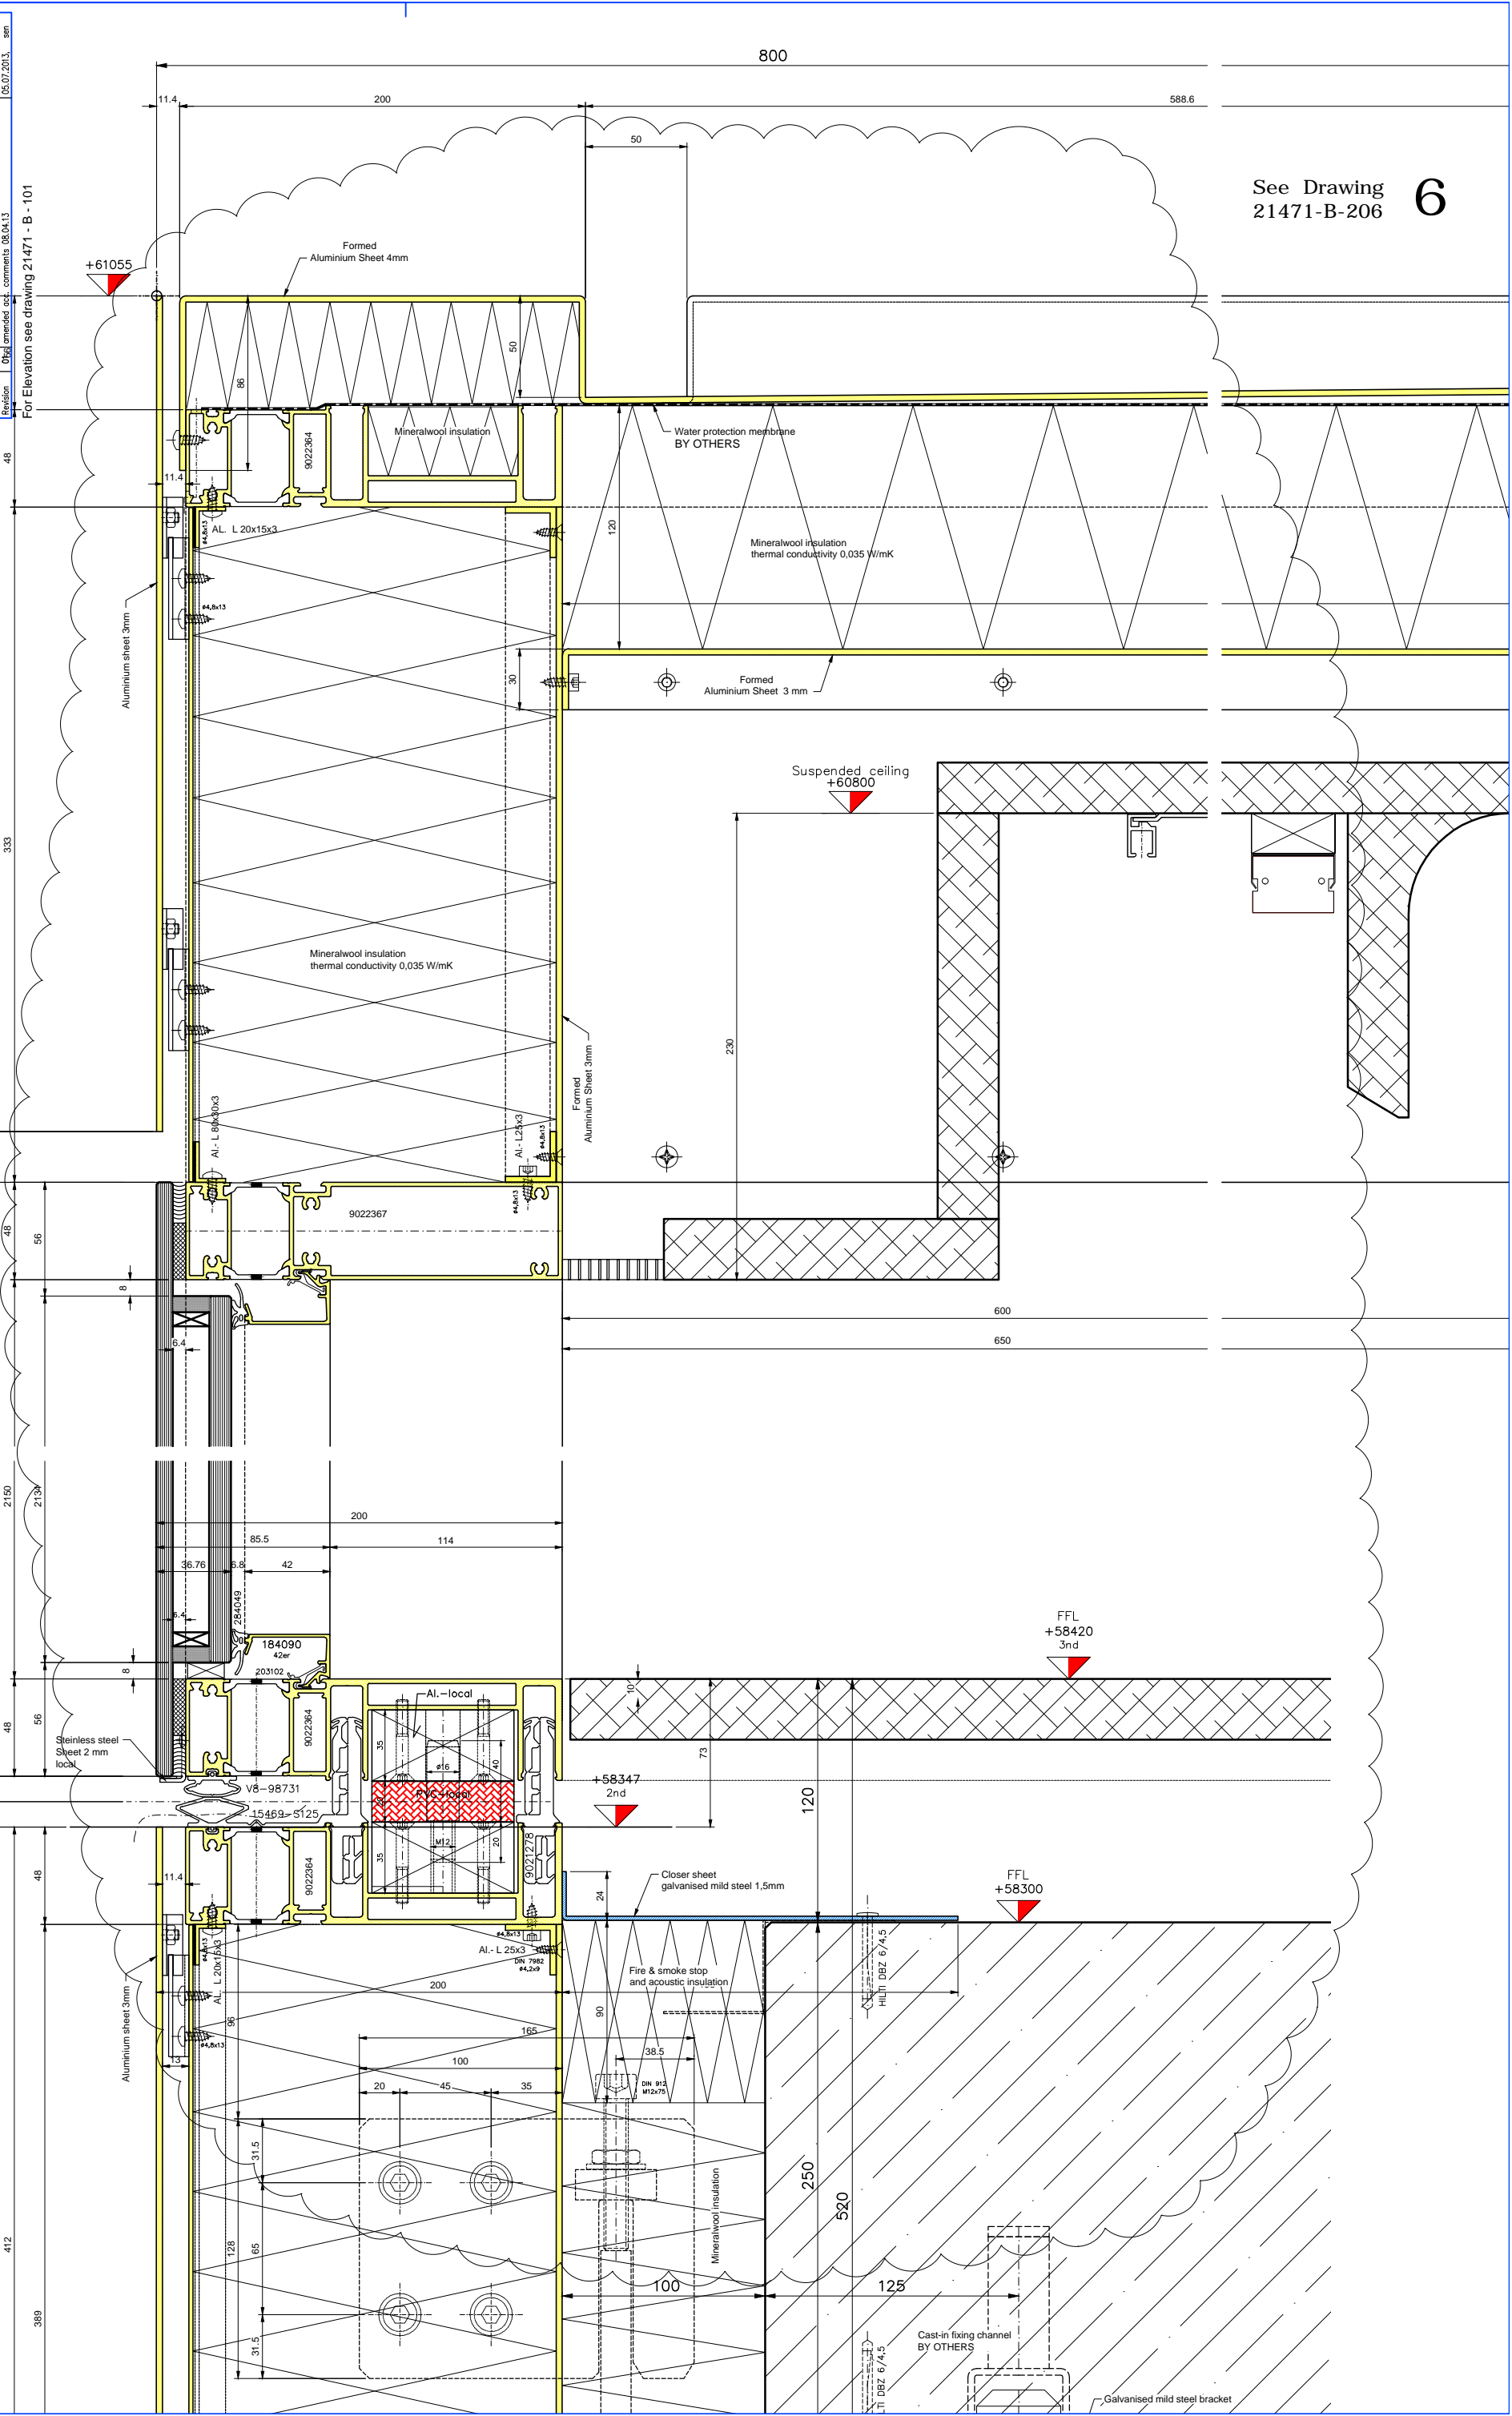

See Drawing  
21471-B-206

6