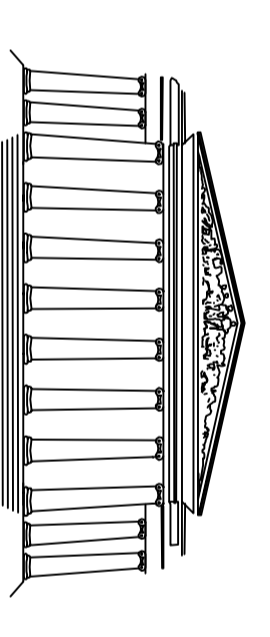
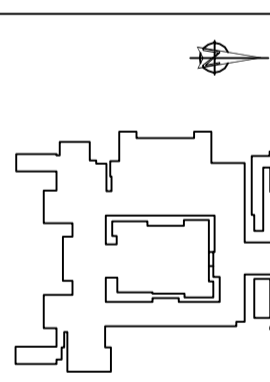


EXTRACT OF EXISTING ELECTRICAL SERVICES
 RECORD DRAWING FOR LEVEL 1 KITCHEN

ISSUED FOR LISTED
 BUILDING CONSENT

Rev	Date	Modification	Rev	Date	Modification	Rev	Date	Modification	Rev	Date	Modification

 <p>THE BRITISH MUSEUM</p>		 <p>Key:</p>	
<p>tga CONSULTING ENGINEERS</p> <p>TGA Consulting Engineers LLP The Regent Centre Avenue House, Dalman City, Dal 1 5TS E: info@tga.co.uk T: 0191 5862314</p>		<p>Contractor:</p> <p>Scale: 1:100 (A1) M5 (A3)</p>	
<p>Date: JULY 2013</p>		<p>Date: JULY 2013</p>	
<p>Drawn: JRS</p>		<p>Checked: SWW</p>	
<p>Date: JULY 2013</p>		<p>Date: JULY 2013</p>	
<p>Approved: -</p>		<p>Date: JULY 2013</p>	
<p>Project No: 7244-TGA-E-7030</p>		<p>Issue No: 1</p>	
<p>Rev: P</p>		<p> </p>	