



DO NOT SCALE FROM THIS DRAWING.
ALL DIMENSIONS TO BE CHECKED ON SITE
PRIOR TO WORKS. ANY DISCREPANCIES TO
BE REPORTED IMMEDIATELY.
IF IN DOUBT ASK!
THIS DRAWING IS COPYRIGHT AND REMAINS
THE PROPERTY OF RML ARCHITECTURE LTD.

REVISIONS

REV	REVISION NOTES	DATE
A	Amended to suit planning resubmission.	22-04-13
B	Notes added for construction.	22-04-13
C	Head detail updated post site meeting 14-05-13.	17-05-13
D	Amended to show fascia and projecting sign height.	15-06-13
E	Level access through proposed entrance shown.	09-07-13

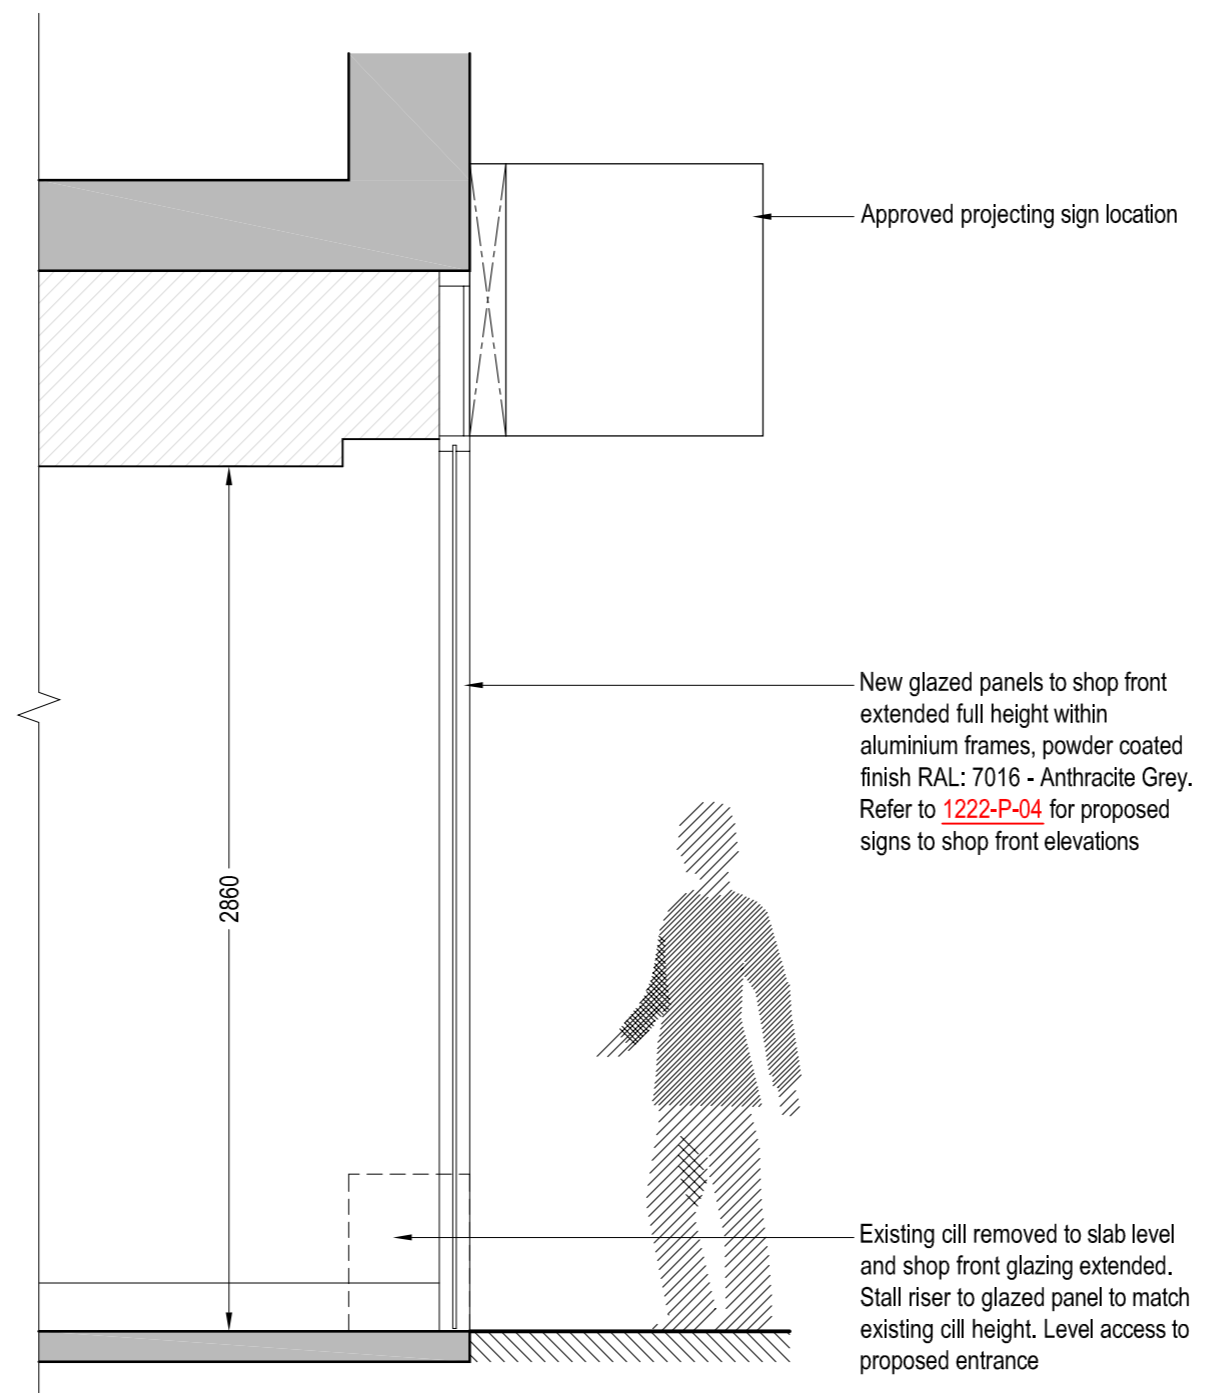

Section A Through Shop Front
(Location of section as shown on drawing 1222-P-04)

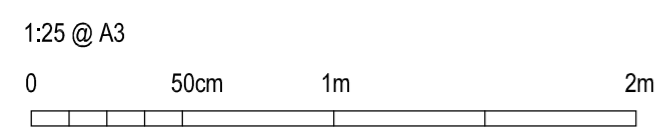

DRAWING STATUS

AS BUILT

CLIENT



JOB NUMBER

1222

DRAWN BY

RML

PROJECT TITLE

ITSU TOTTENHAM COURT ROAD 2
53-54 TOTTENHAM COURT ROAD
LONDON
W1T 2EL

DRAWING TITLE

SECTION THROUGH SHOP FRONT

DATE

DECEMBER 2012

SCALES

1:25 @ A3

DRAWING NUMBER

1222-P-05

REVISION

E

RMLArchitecture

28 foundry street brighton BN1 4AT
07973 151 494