

NOTES

F	March 04	AS BUILT	DW	JH
E	15.07.03	CONST ISSUE UPDATE	DW	JH
D	06.05.03	PLANNING	DW	JH
C	02.05.03	CONSTRUCTION ISSUE	DW	JH
B	18.03.03	UPDATE	DW	JH
A	20.01.03	TENDER	CJM	DW


REVISION	DATE	COMMENTS	ISSUED BY	CHECKED BY



JESTICO+WHILES

1 Coleridge Street, London NW1 2NP
Tel: 020 7380 0382 Fax: 020 7380 0511
E mail: j+w@jesticowhiles.co.uk
ARCHITECTS LONDON + PRAGUE + MUNICH

JOB: THE FOUNDLING MUSEUM
40 BRUNSWICK SQUARE, LONDON
CLIENT: THE BOARD OF TRUSTEES
THE FOUNDLING MUSEUM
SCALE: 1:50 @A1; 1:100 @A3 DATE: DECEMBER 2002
DRAWN: CS CHECKED: JH
TITLE: PROPOSED
WEST ELEVATION
DRAWING NO: 1764/208 REF: F
PREVIOUSLY DRAWING 1764/059

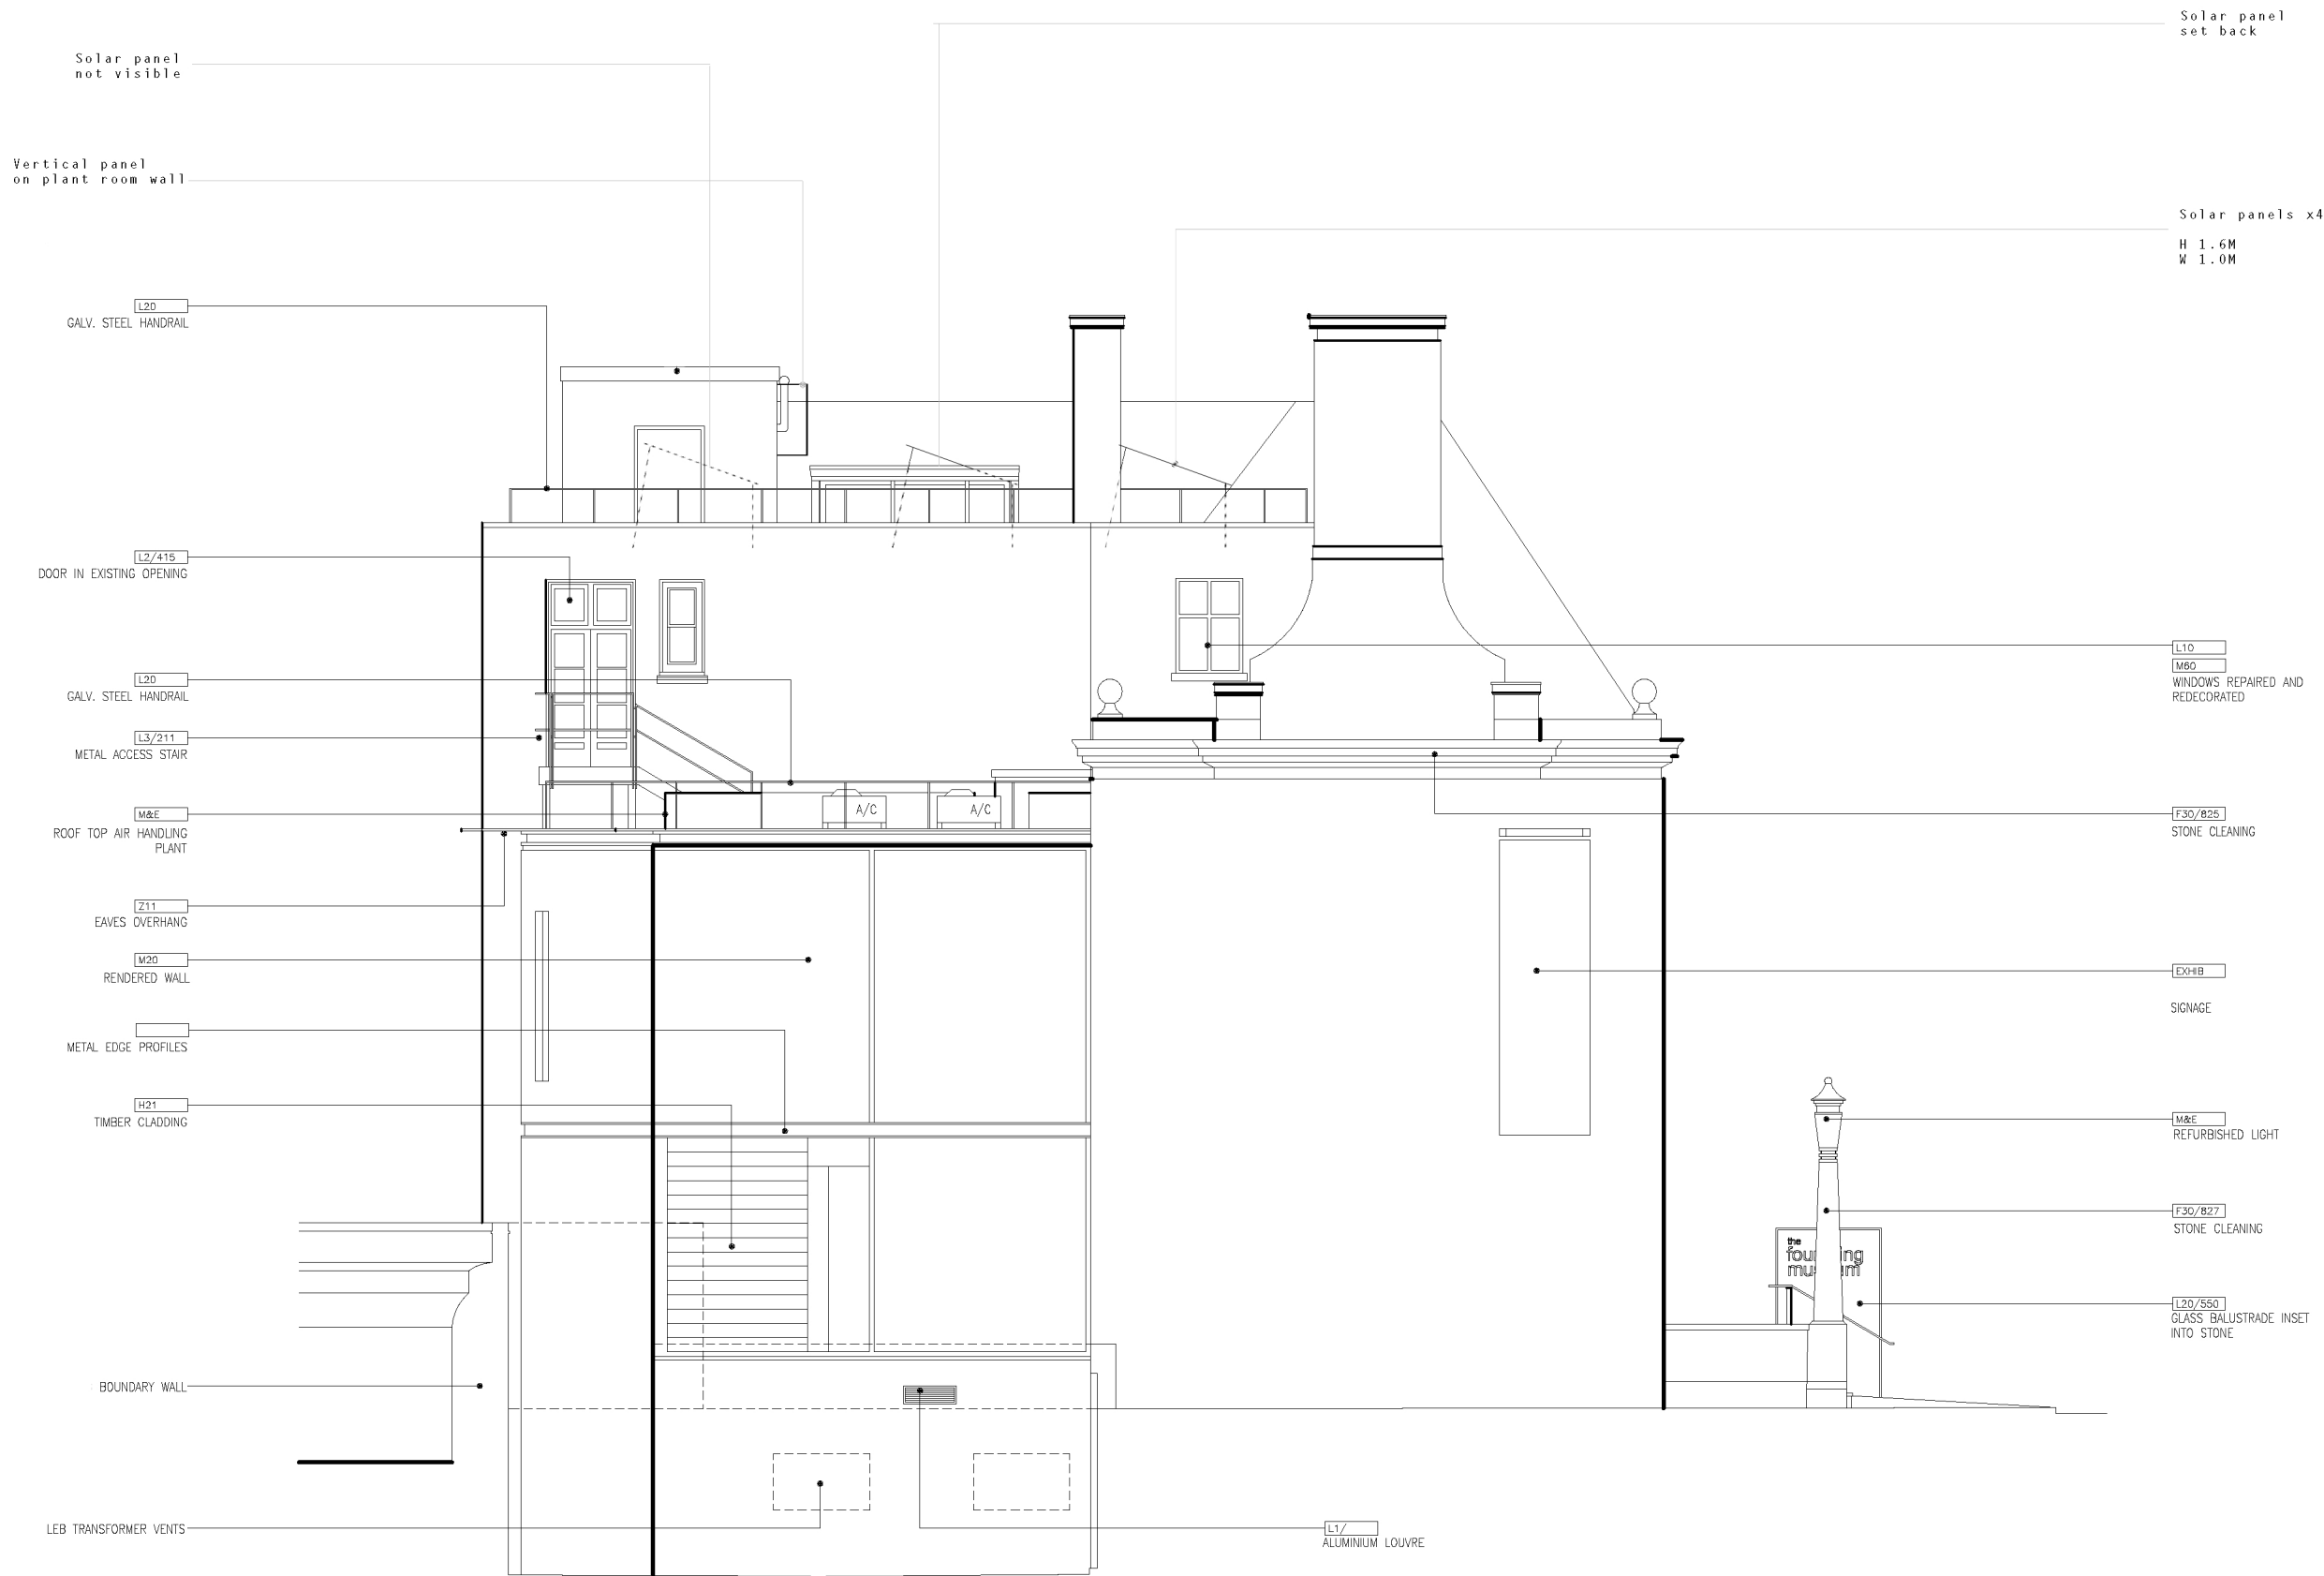

1 WEST ELEVATION - PROPOSED
208 1:50