


**NOTES.**  
 Please note that all dimensions must be checked on site and not scaled off this drawing.  
 Planning Consent:  
 Until planning consent has been granted and all conditions contained in that consent complied with, no building works whatsoever should be undertaken. Any building works started beforehand are entirely at Client's own risk.  
 Building Regulations (Notice of Passing of Plans) Until unconditional approval of plans has been issued by Building control (The Council's District Surveyors Service), all works undertaken beforehand are entirely at Client's own risk. District Surveyors frequently require amendments to submitted plans, and any such changes or changes arising from different presumed site conditions, can radically affect building procedures.  
 Therefore we do not recommend that any works at all are started before obtaining both planning & unconditional: Notice of Passing of Plans.

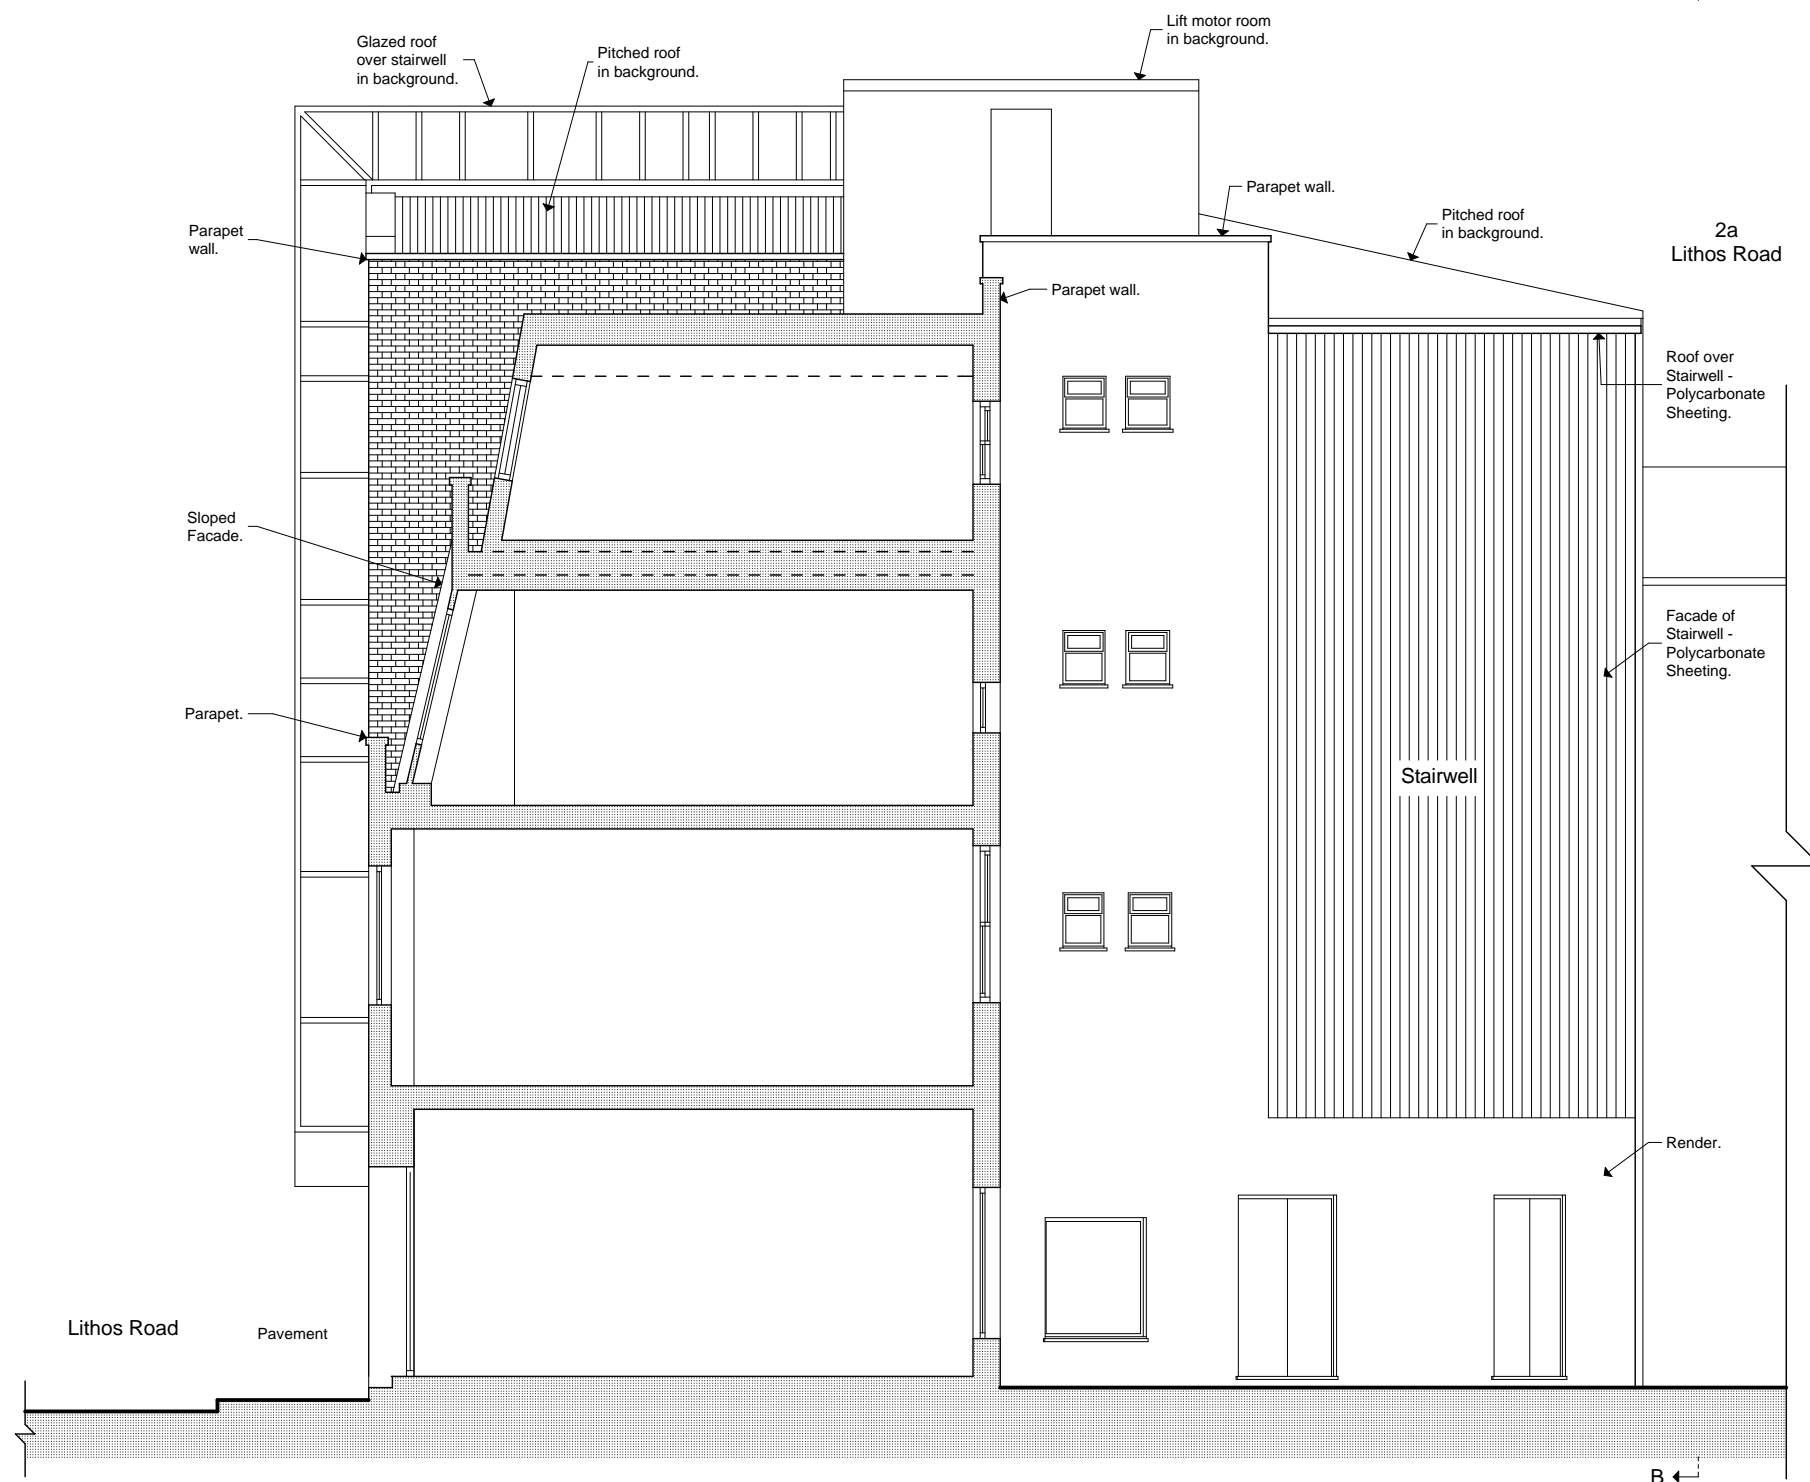

Existing East Elevation / Section A-A

Please note that all dimensions must be checked on site and not scaled off this drawing  
 File Ref: 1080 - AB - Plans 7.pln

NOTES.

Preliminary	
Planning	■
Building Regs.	
Tender	
Construction	
As-built	■

Rev	Date

© Copyright  
  
**DONALD SHEARER**  
 CHARTERED ARCHITECTS  
 Scholar's House, Shottery Brook Office Park, Timothy's Bridge Road, Stratford-upon-Avon, Warwickshire, CV37 9NR  
 Tel: 01789 294 560 Fax: 01789 294 549 donald@ds-architects.demon.co.uk

Project	Lithos House, 307 Finchley Road	Reference Number	1080-BA-105		
Client	Gallery Zadah Pension Fund	Date	Jun 13	Scale	1:100
Drawing	Existing Section A-A / East Elevation				
		Drawing size	A3		