




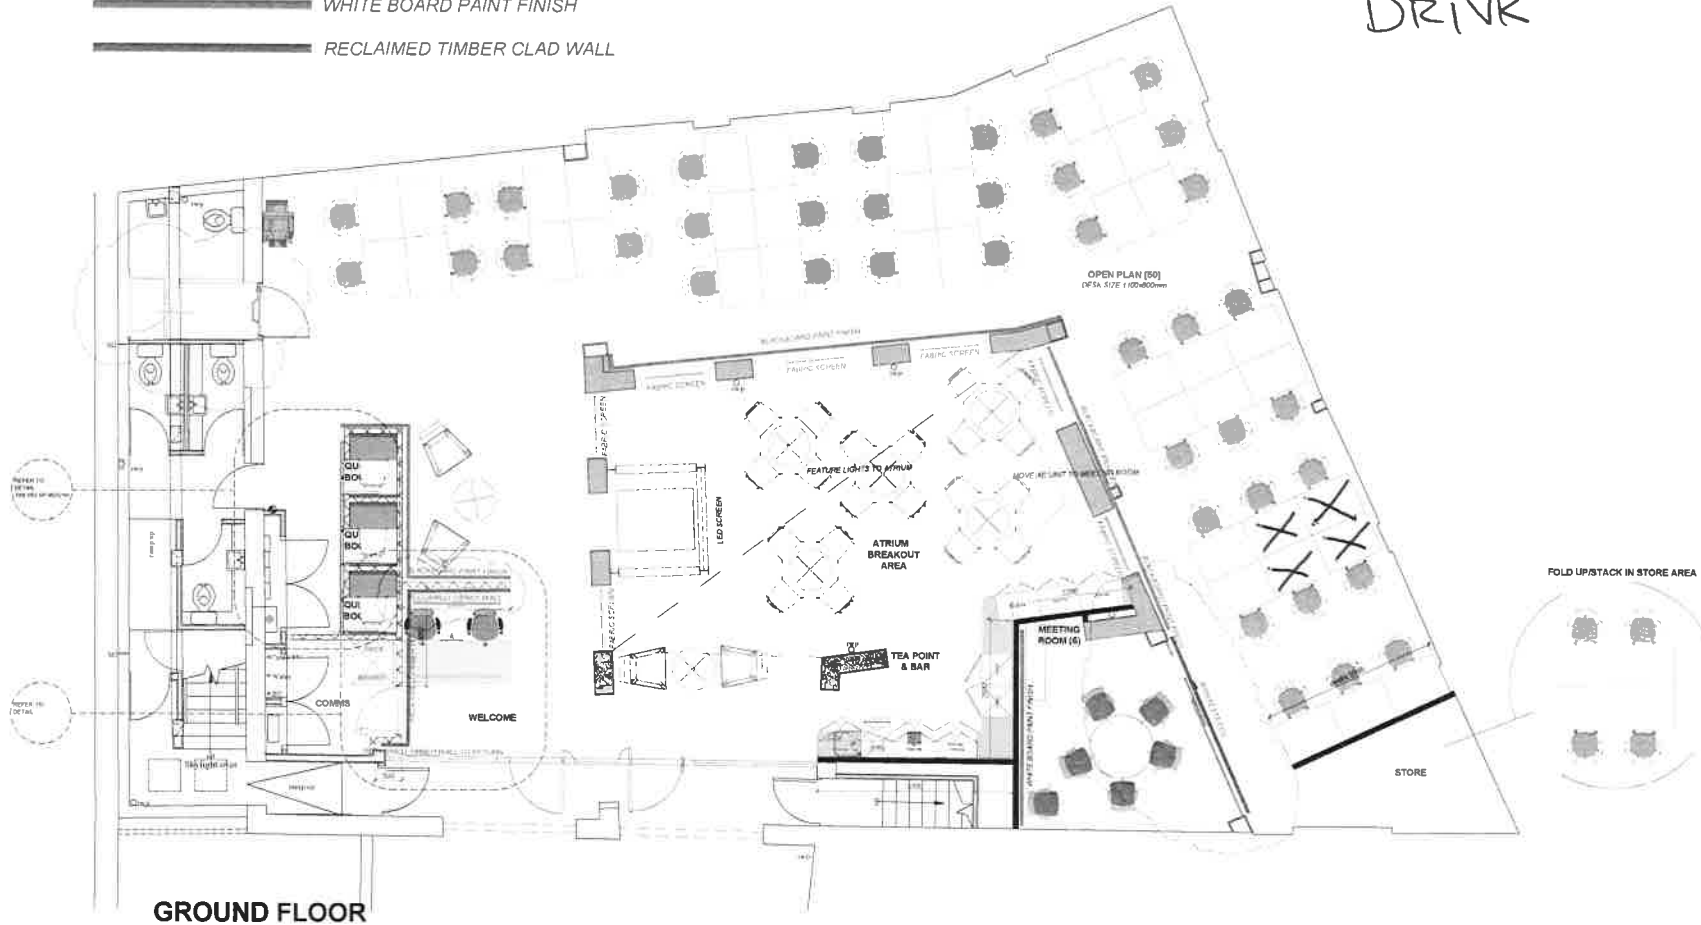


-  SIGNAGE
-  MANIFESTATION TO GLAZING
-  BLACKBOARD PAINT FINISH
-  WHITE BOARD PAINT FINISH
-  RECLAIMED TIMBER CLAD WALL

X Represents  
CLICK A TAXI /  
DRIVER



**GROUND FLOOR**



**Copyright**  
Copyright of this drawing belongs to it is issued by THIRDMWAY INTERIORS and may not be reproduced or altered without consent by THIRDMWAY INTERIORS. Any person, firm or company unlawfully reproducing or distributing the drawing or in anyway infringing the copyright herein will be prosecuted. This document is the property of THIRDMWAY INTERIORS. Copyright is reserved by them, and the drawing is issued on the condition that it is not copied, reproduced or released by, nor disclosed to any unauthorised person, either wholly or in part, without the consent in writing from THIRDMWAY INTERIORS.

**Note**  
ALL DIMENSIONS MUST BE CHECKED ON SITE. DO NOT SCALE FROM THIS DRAWING. THIS DRAWING IS FOR DISCUSSION PURPOSES ONLY AND IS SUBJECT TO FIRE OFFICER AND BUILDING REGULATION APPROVALS BEING OBTAINED.

**Drawing Approval**

Client Signature	
Project Name	
Prop. Office Location	
Date	
Manufacturer Ref	

- Status**
- Preliminary/Info
  - Contract
  - Construction
  - Approval/Comment
  - As-Built
  - Building Control

**Revision Detail**

Rev	Detail	By	Date

D: 13 09 13 MANIFESTATION INDICATED TO GLAZING SIGNAGE TO RECEPTION  
C: 18 04 13 TEA POINT AND SHOWER AMENDED  
R: 11 04 13 ZIP TAP AND SINK HIGHLIGHTED TO OF TEAPOINT WALL FINISHES ADDED  
**CONSTRUCTION DRAWING**

**Client**  
PLAYFAIR

**Project Title**  
PLAYFAIR WARNER YARD  
8 WARNER YARD  
LONDON  
EC1

**Drawing Title**  
GROUND FLOOR  
WORKING DRAWING  
GENERAL ARRANGEMENT

Date 05 D4 13 Drawn By SOS

Scale 1:100@A3 R/w D

Drawing No TWI-SB2-GF-GA

**ThirdWay Interiors**  
General Office  
30 St John's Lane  
London EC1M 4NR  
020 7554 1145 020 7549 5474



Copyright of this drawing belongs to its author and may not be reproduced or used in any form without the written consent of THE DRAWING OFFICE. Any person, firm or company who reproduces or uses this drawing without the written consent of THE DRAWING OFFICE shall be liable to legal action. The copyright herein will be protected.

This document is the property of THE DRAWING OFFICE and is loaned to you on the condition that it is not to be copied, reproduced or used in any form without the written consent of THE DRAWING OFFICE. If you are unable to return it to THE DRAWING OFFICE, please contact them at the address below.

**Note**  
ALL DIMENSIONS MUST BE CHECKED ON SITE. DO NOT SCALE FROM THIS DRAWING.  
THE DRAWING OFFICE SHALL NOT BE RESPONSIBLE FOR ANY DAMAGE TO PERSONS OR PROPERTY CAUSED BY THE USE OF THIS DRAWING. THE DRAWING OFFICE SHALL NOT BE RESPONSIBLE FOR ANY DAMAGE TO PERSONS OR PROPERTY CAUSED BY THE USE OF THIS DRAWING.

**Drawing Approval**  
Drawn By: \_\_\_\_\_  
Checked By: \_\_\_\_\_  
Head Office: \_\_\_\_\_  
Project No: \_\_\_\_\_  
Drawing No: \_\_\_\_\_

**Revision Control**

Rev	Date	By	Date

**Preliminary/Info**  
Contract: \_\_\_\_\_  
Construction: \_\_\_\_\_  
Approval/Comment: \_\_\_\_\_  
As-Built: \_\_\_\_\_  
Building Control: \_\_\_\_\_

**CONSTRUCTION DRAWING**  
A 1:2000 MANIFESTATION INDICATED TO GLAZING IS TO BE USED FOR ALL PROJECTS.






**Project Title**  
PLAYFAIR


**Project File**  
PLAYFAIR WARNER YARD  
8 WARNER YARD  
LONDON  
EC1

**Drawing Title**  
FIRST FLOOR  
WORKING DRAWING  
GENERAL ARRANGEMENT

**Date** 05/04/13  
**Drawn By** SOC  
**Scale** 1:1000@A3  
**Rev** B  
**Drawing No** TMI-552-FF-GA

**The Drawing Office**  
100, Abchurch Lane  
London EC4M 6NS  
Tel: 020 7417 1100  
Fax: 020 7417 1101

-  SIGNAGE
-  MANIFESTATION TO GLAZING
-  BLACKBOARD PAINT FINISH
-  WHITE BOARD PAINT FINISH
-  RECLAIMED TIMBER CLAD WALL

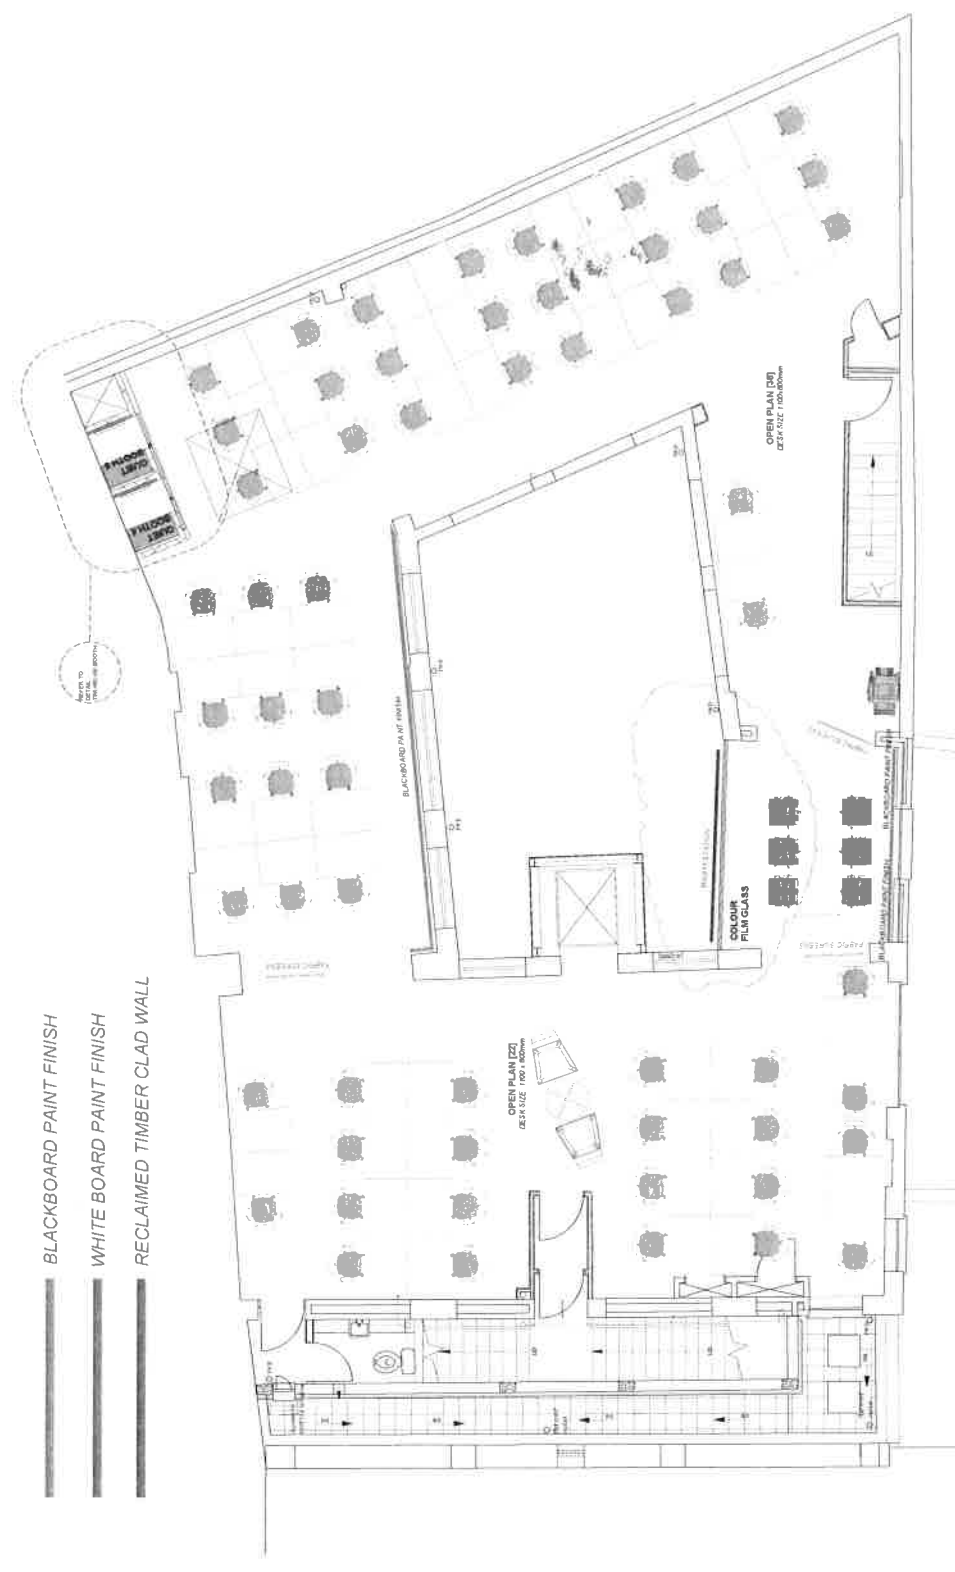



Copyright © 2013. This drawing is the property of the architect and shall remain the property of the architect. It is to be used only for the project and site for which it is prepared. It is not to be reproduced, stored in a retrieval system, or transmitted in any form or by any means, electronic, mechanical, photocopying, recording, or by any information storage and retrieval system, without the prior written permission of the architect.

**NOTE**  
ALL DIMENSIONS MUST BE CHECKED ON SITE. DO NOT SCALE FROM THIS DRAWING.  
DRAWING IS FOR INFORMATION PURPOSES ONLY AND IS SUBJECT TO FIRE OFFICER AND BUILDING REGULATION APPROVALS BEING OBTAINED.

**Planning Approval**  
 Design Approvals  
 Planning System  
 Theatrical / Performance  
 Other  
 Date: 05/04/13

Preliminary/Info	
Contract	
Construction	
Approval/Comment	
As-Built	
Building Control	
Revision Detail	
Rev	Date

B.13.00.13 MANIFESTATION ADDED TO GLAZING  
**CONSTRUCTION DRAWING**

Client:  
**PLAYFAIR**



Project Title:  
**PLAYFAIR WARNER YARD  
WARNER YARD  
LONDON  
EC1**

Drawing Title:  
**SECOND FLOOR  
WORKING DRAWING  
GENERAL ARRANGEMENT**

Date	05/04/13	Drawn By	SOC
Scale	1:100@A3	Rev	B
Drawing No.	TMI-582-SF-GA		

The Architect:  
**30 St. James Lane  
London EC1A 1BE  
020 7554 1105 | 020 7544 5471**

- SIGNAGE
- MANIFESTATION TO GLAZING
- BLACKBOARD PAINT FINISH
- WHITE BOARD PAINT FINISH
- RECLAIMED TIMBER CLAD WALL

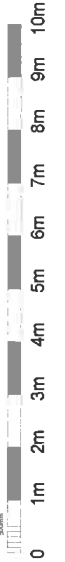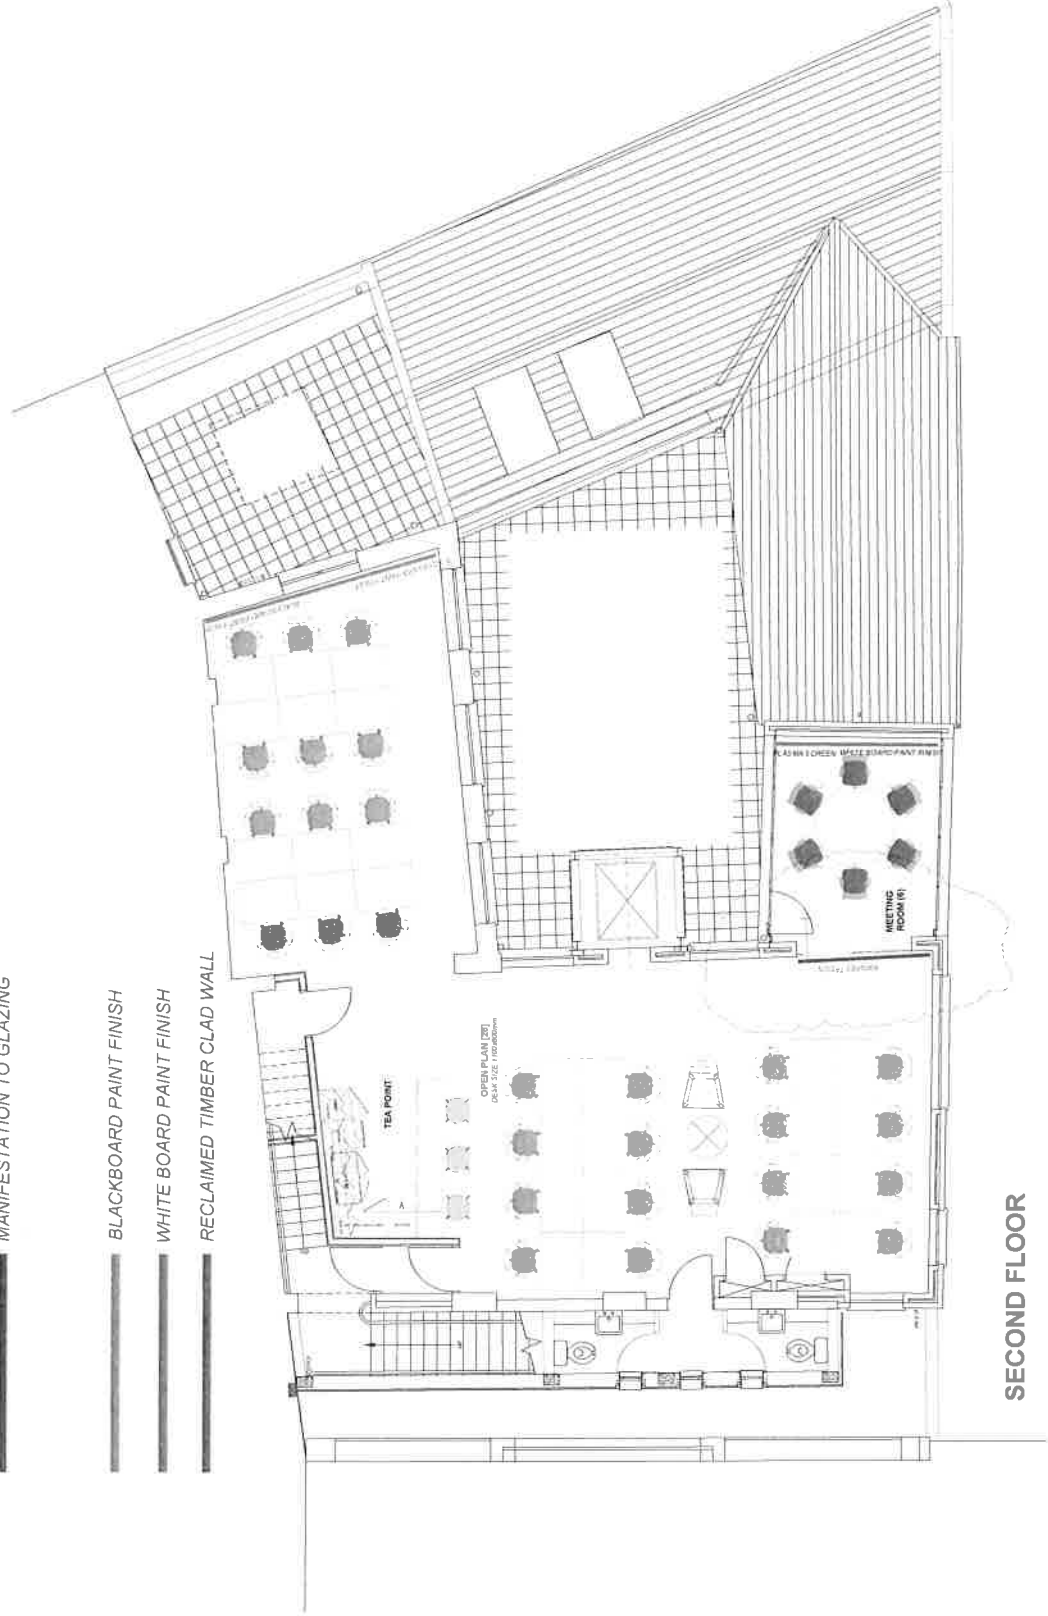

**SECOND FLOOR**


SIGNAGE

MANIFESTATION TO GLAZING

BLACKBOARD PAINT FINISH

WHITE BOARD PAINT FINISH

RECLAIMED TIMBER CLAD WALL

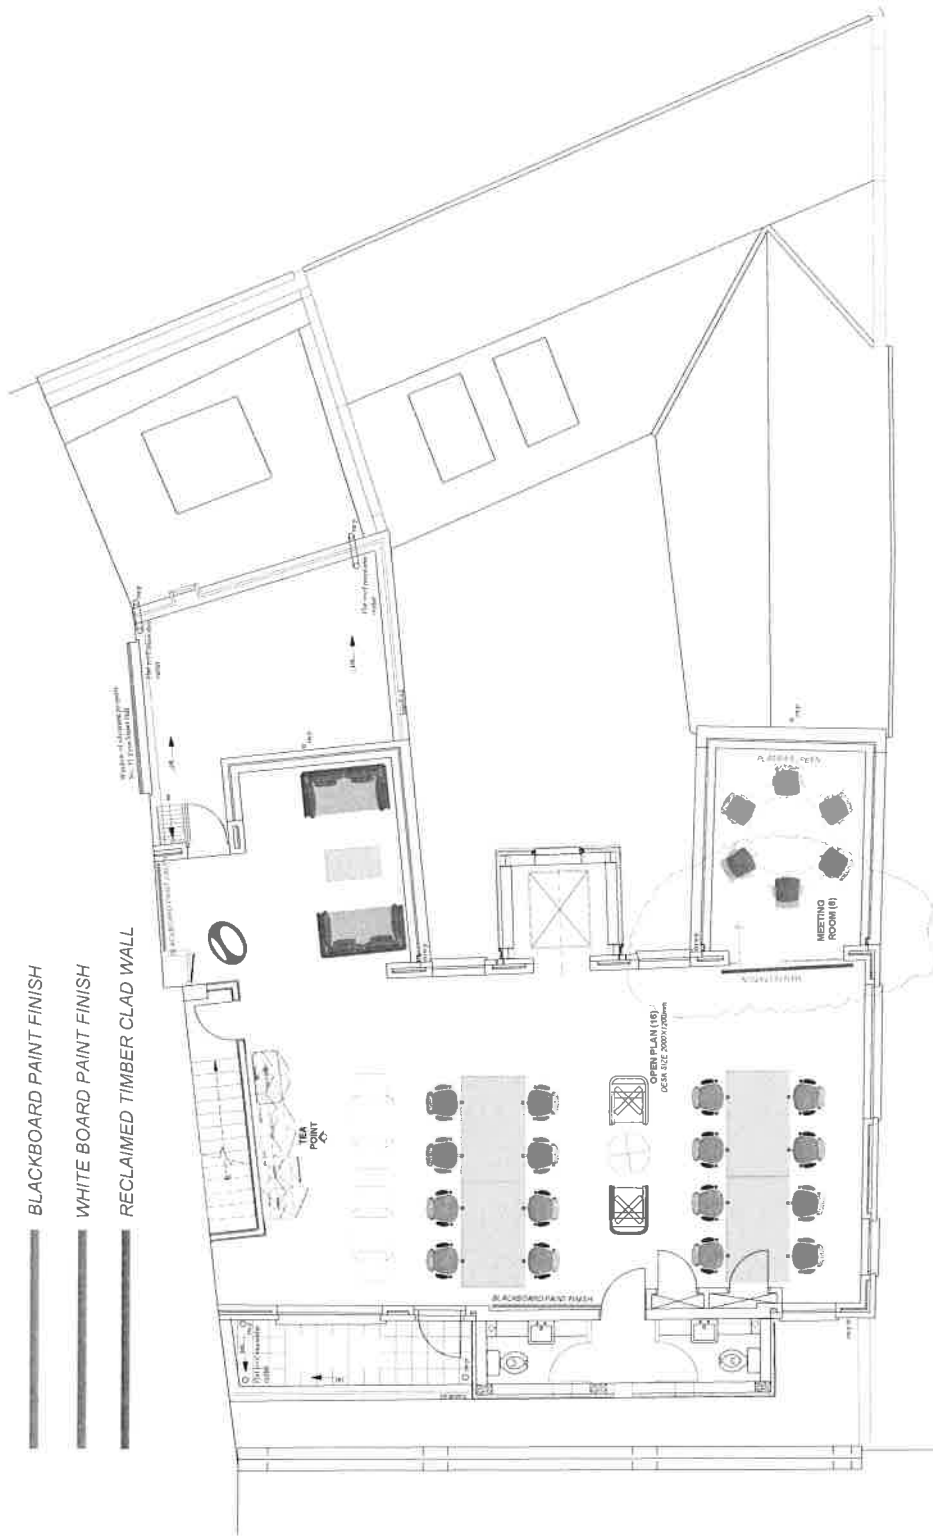

### THIRD FLOOR



Copyright © 2013. All rights reserved. This drawing is the property of TWI-582-TF-GA and may not be reproduced or altered without written consent by TWI-582-TF-GA. The user assumes all liability for any errors or omissions in this drawing or its interpretation. The user agrees to hold TWI-582-TF-GA harmless from and against all claims, damages, costs and expenses, including reasonable attorneys' fees, arising from the use of this drawing.

**NOTE**  
ALL DIMENSIONS MUST BE CHECKED ON SITE. DO NOT SCALE FROM THIS DRAWING. DIMENSIONS IN THIS DRAWING ARE FOR INFORMATION PURPOSES ONLY AND IS SUBJECT TO FIRE OFFICER AND BUILDING DEPARTMENT APPROVALS BEING OBTAINED.

**REVISIONS**

Rev	Detail	By	Date

**Approval**

Client Approval  
 Project Manager  
 Building Services  
 Fire Officer  
 Building Control  
 Date: 05/04/13

**Approval/Comment**

Preliminary/Info  
 Contract  
 Construction  
 Approval/Comment  
 As-Built  
 Building Control

**Revision Detail**

Rev	Detail	By	Date

**CONSTRUCTION DRAWING**

05/04/13 MANIFESTATION ADDED TO GLAZING

**Project Title**  
PLAYFAIR WARNER YARD  
WARNER YARD  
LONDON  
EC1

**Project File**  
PLAYFAIR WARNER YARD  
WARNER YARD  
LONDON  
EC1

**Drawing Title**  
THIRD FLOOR  
MANIFESTATION  
GENERAL ARRANGEMENT

**Date** 05/04/13 **Drawn By** SOC  
**Scale** 1:100 @ A3 **Rw** B

**Drawing No.** TWI-582-TF-GA

**Twinkl Interiors**  
30 St John's Lane  
London EC4M 3NB  
020 7294 1163 1163 7294 9671