




Section AA - (as approved) 1:50

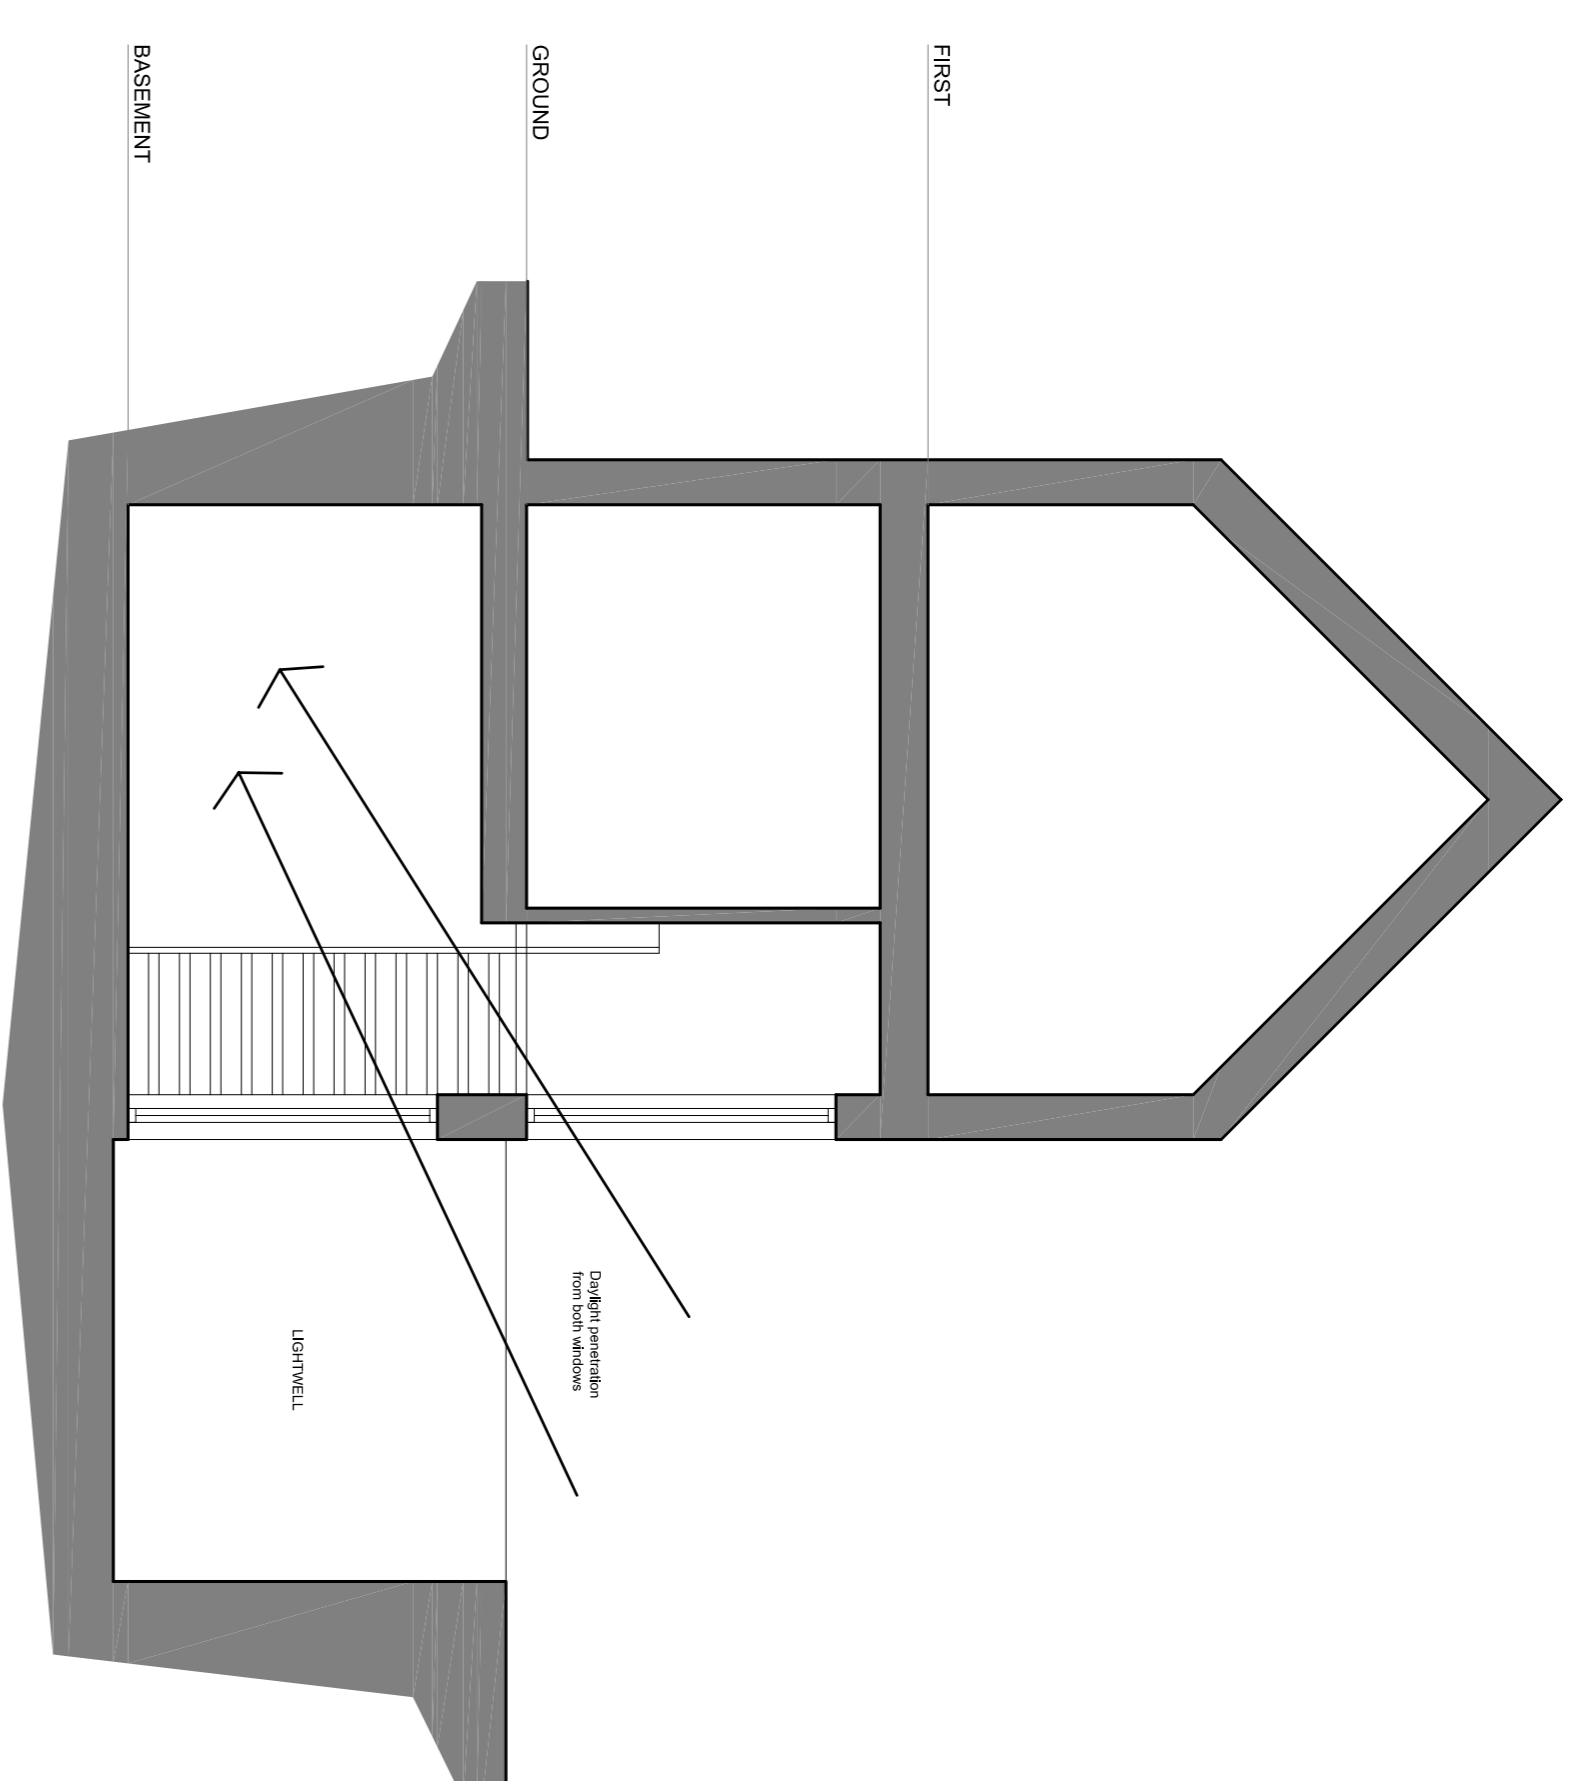

Section B B - (AS BUILT) 1:50

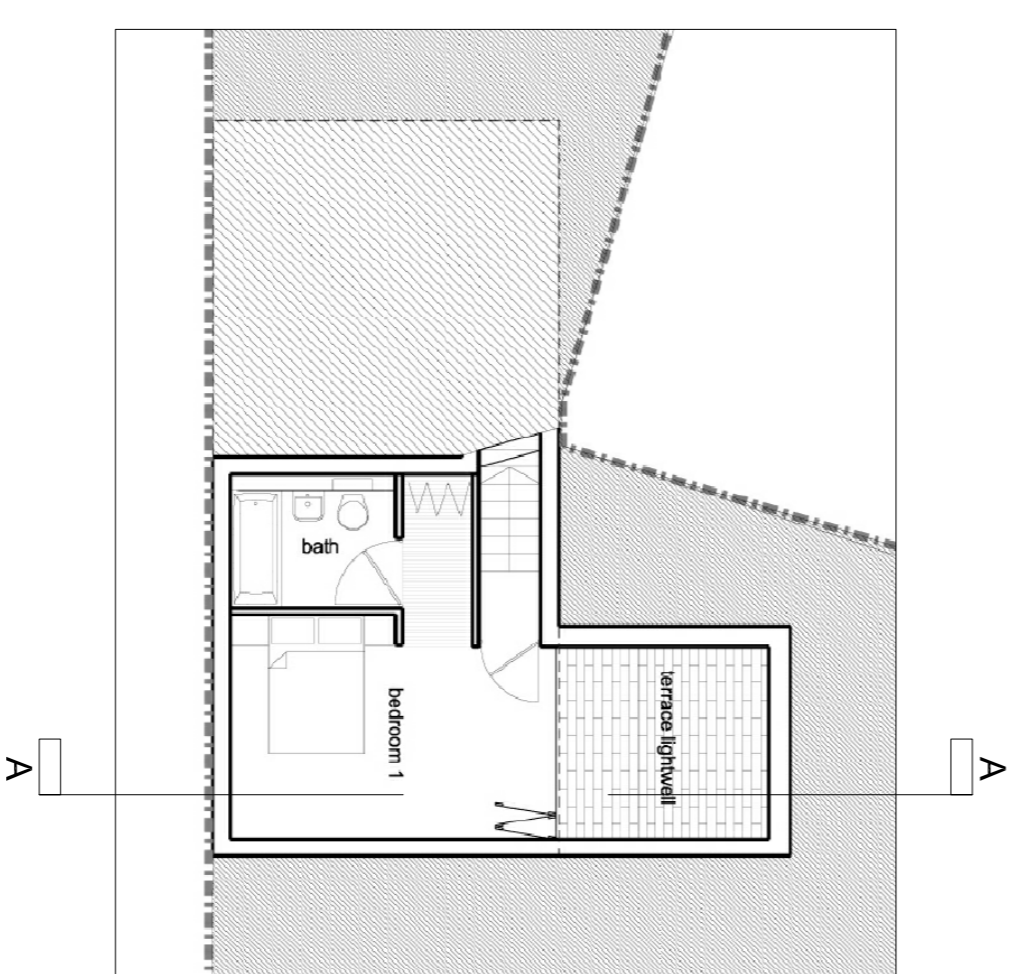

Basement Plan (as approved) 1:100

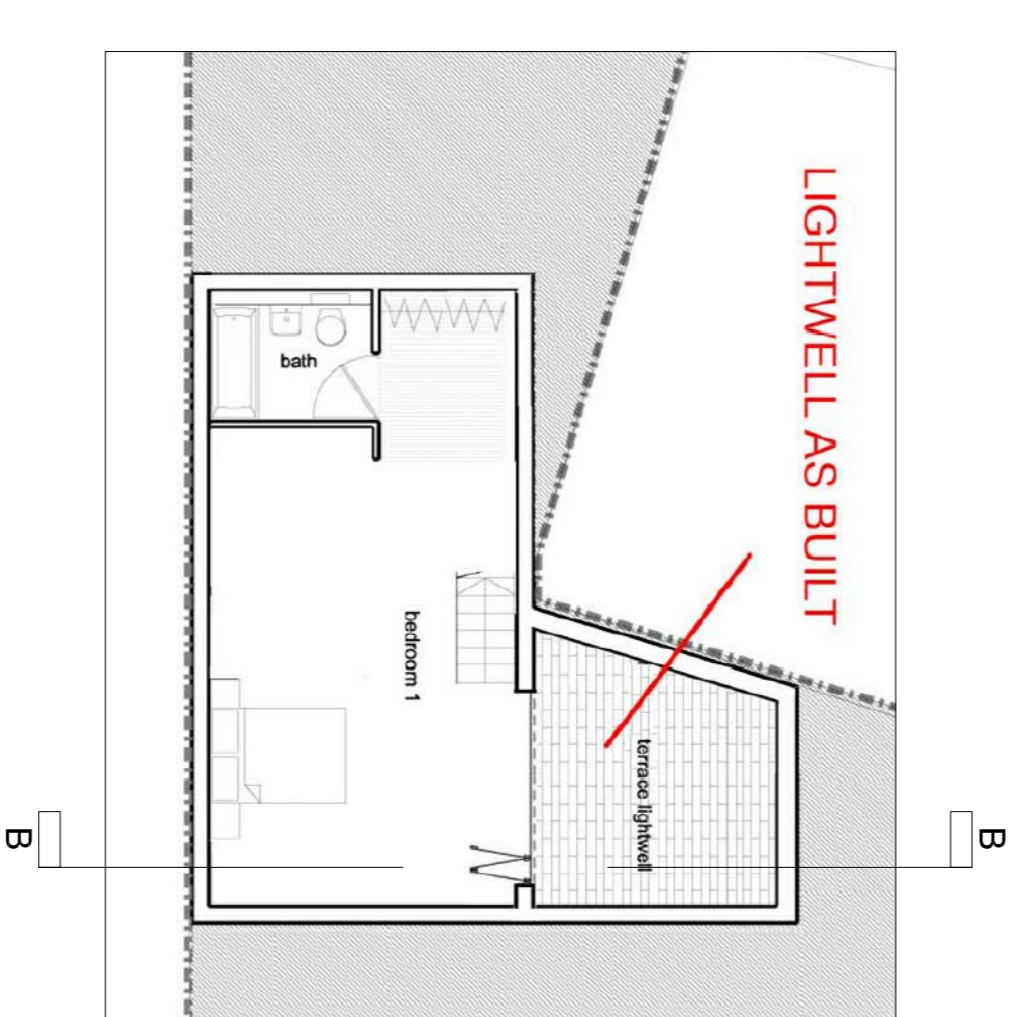

Basement Plan (AS BUILT) 1:100

Notes:	Rev	Notes	Date	By	Issued	Rev	Notes	Date	By	Issued
<p>DO NOT SCALE - A3 ORIGINAL CONTRACTOR CHECK ALL DIMENSIONS AND REVISIONS TO DRAWING FOR CONFORMANCE TO ARCHITECT DRAWING COPYRIGHT © AAVA Ltd</p>										
<p>Project: Gondar Gardens</p>										
<p>Status: AS BUILT</p>										
<p>Client: AVA</p>										
<p>Title: Sections Through Basement</p>										
			<p>Scale @ A3 1:50 / 1:100</p>		<p>Drawing Number 08_03_(U2)SK004</p>					
			<p>Drawing Date 17.05.2013</p>		<p>Revision Date</p>		<p>Revision</p>			