


This drawing is based on current available information and is subject to a full survey. All dimensions and areas are approximate. These proposals are subject to planning consent, Building regulation approval and Rights of Light and Party Wall agreements.

NOTES:

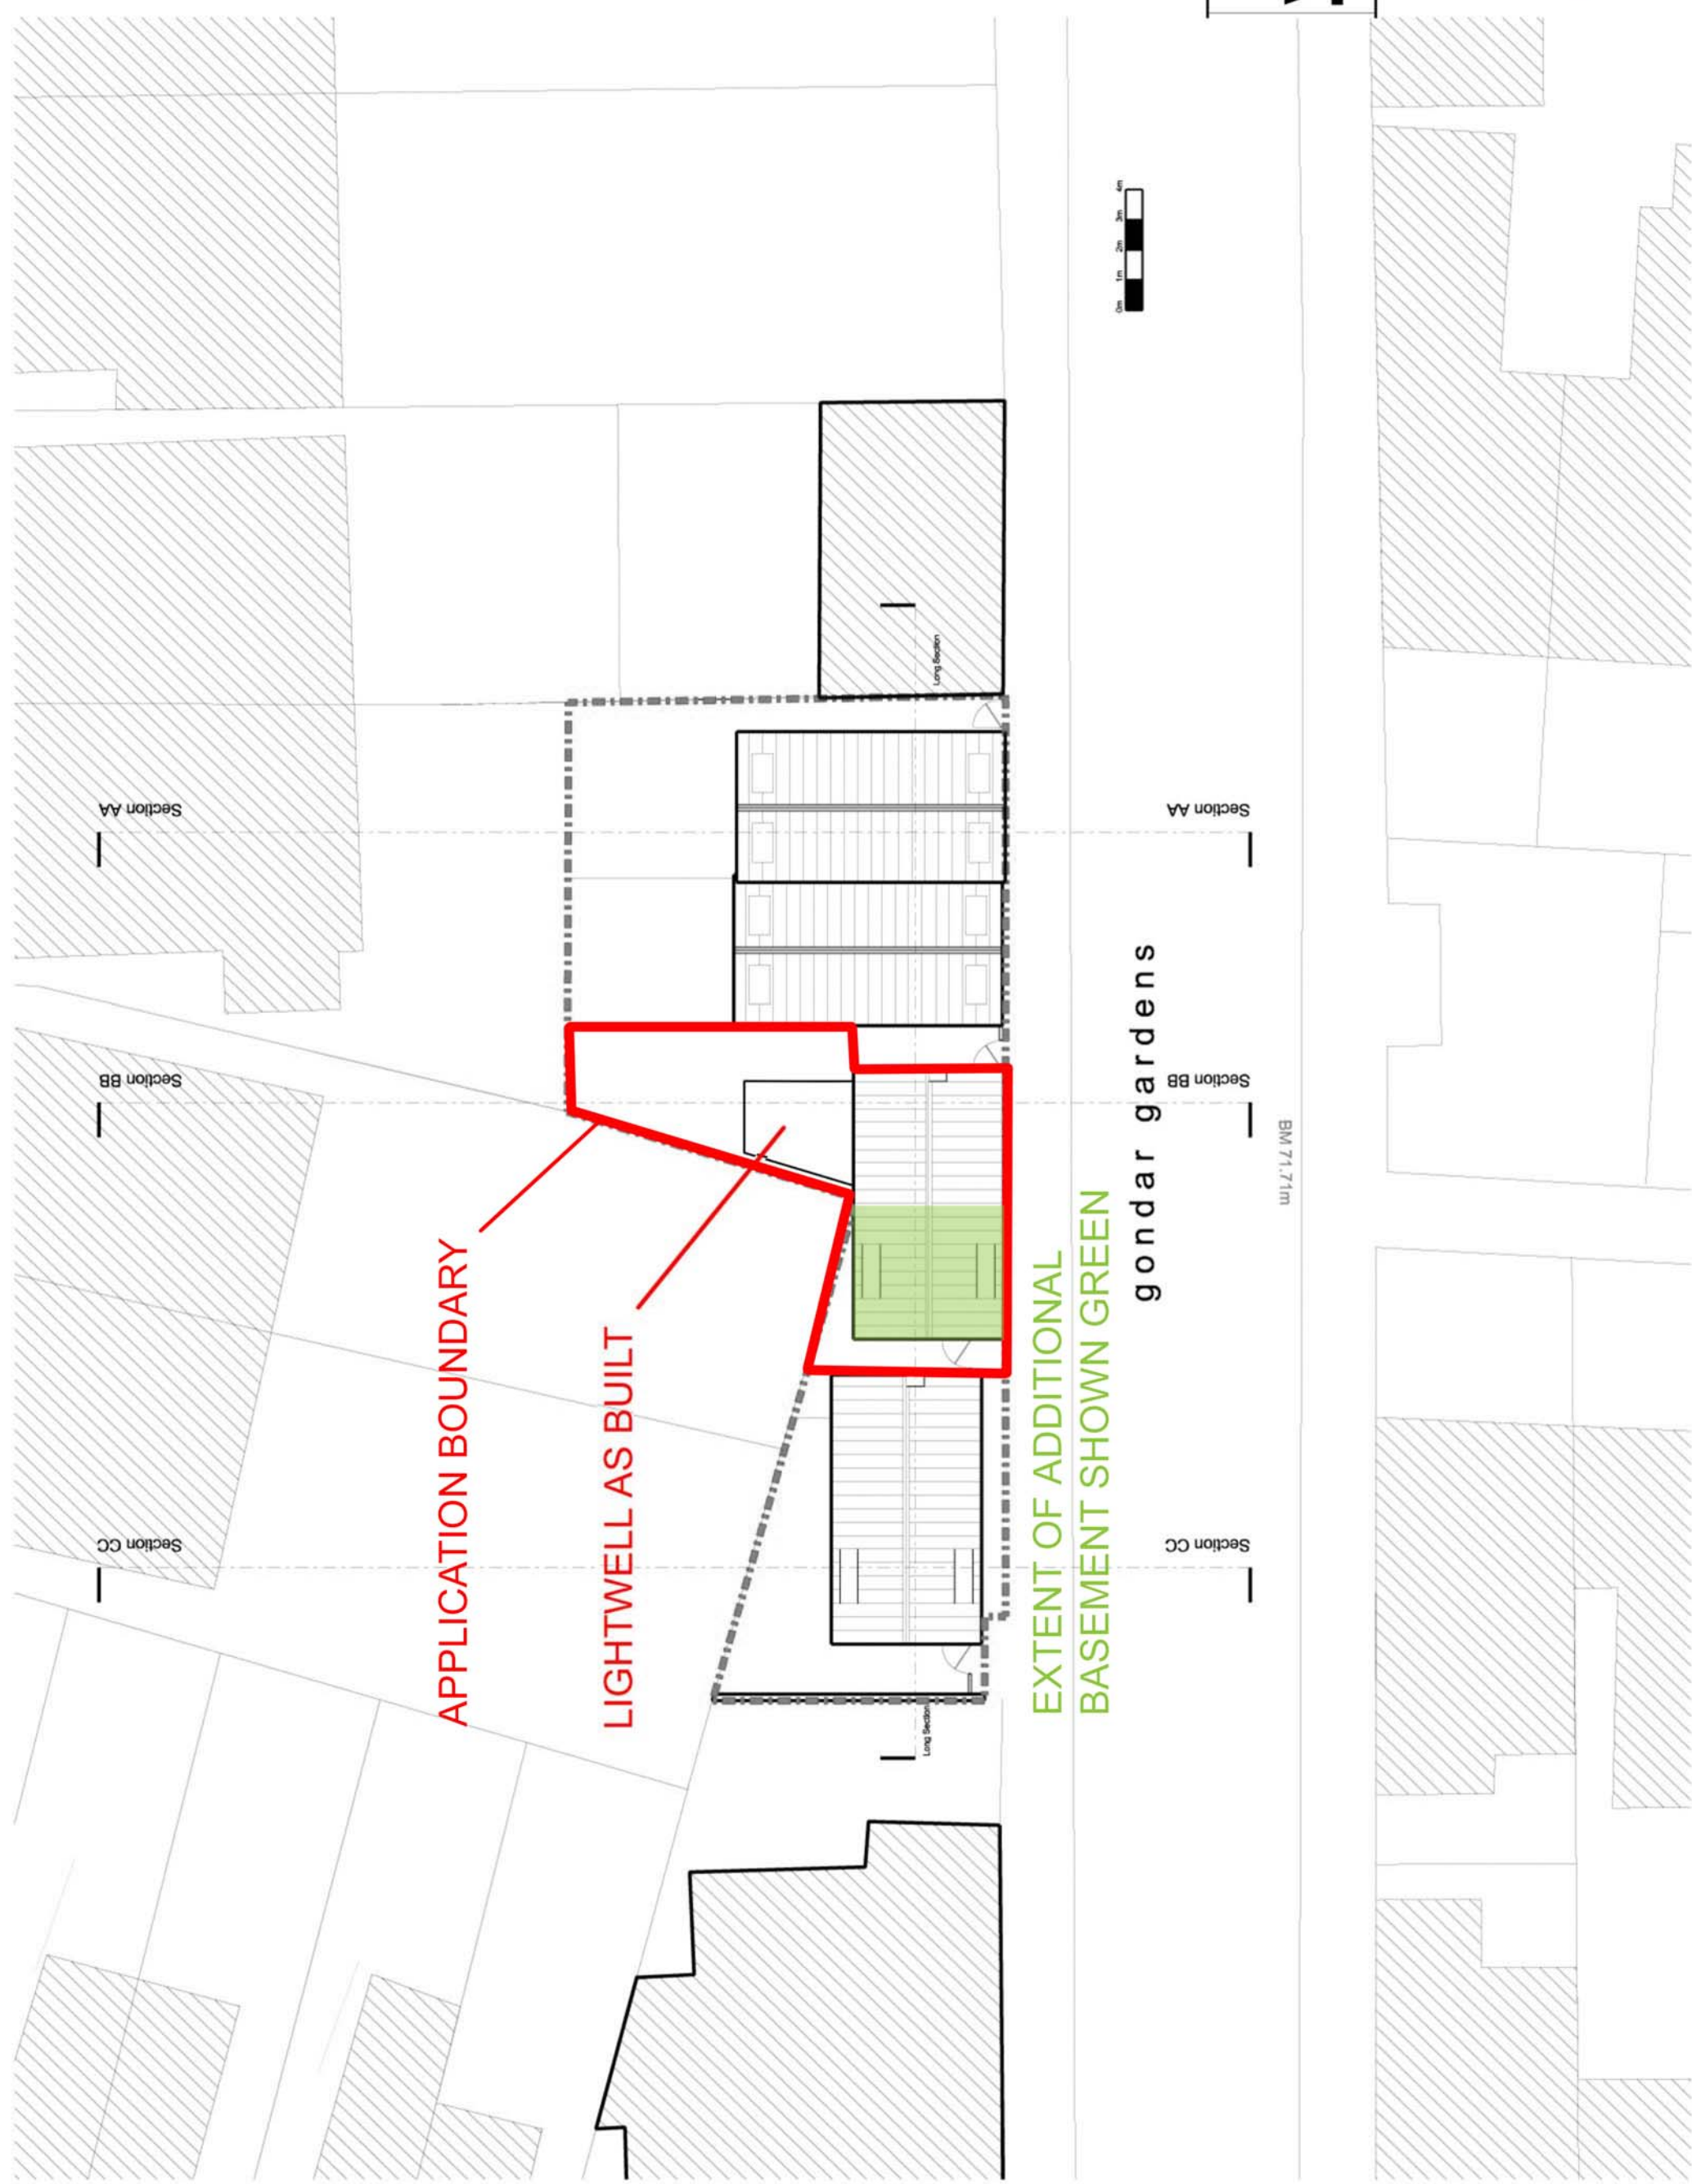

YAVF
 31-32 Sunbury Workshops
 Sunfield Street
 London E2 7JX
 T: +44(0)20 7 613099
 W: www.yavf.org.uk
 E: info@yavf.org.uk

client
 Standard Property Investments
 job
 1 Gondar Gardens - Camden
 drawing title

Proposed Site Plan
AS BUILT

scale	1:200	@A3 23.06.2007	DT	checked by	
job number	sp 01-			revision	B

Do not scale off this drawing. Use Squared dimensions only. All dimensions and levels to be checked and confirmed on site.