


This drawing is based on current available information and is subject to a full survey. All dimensions and areas are approximate. These proposals are subject to planning consent, Building regulation approval and Rights of Light and Party Wall agreements.

NOTES:

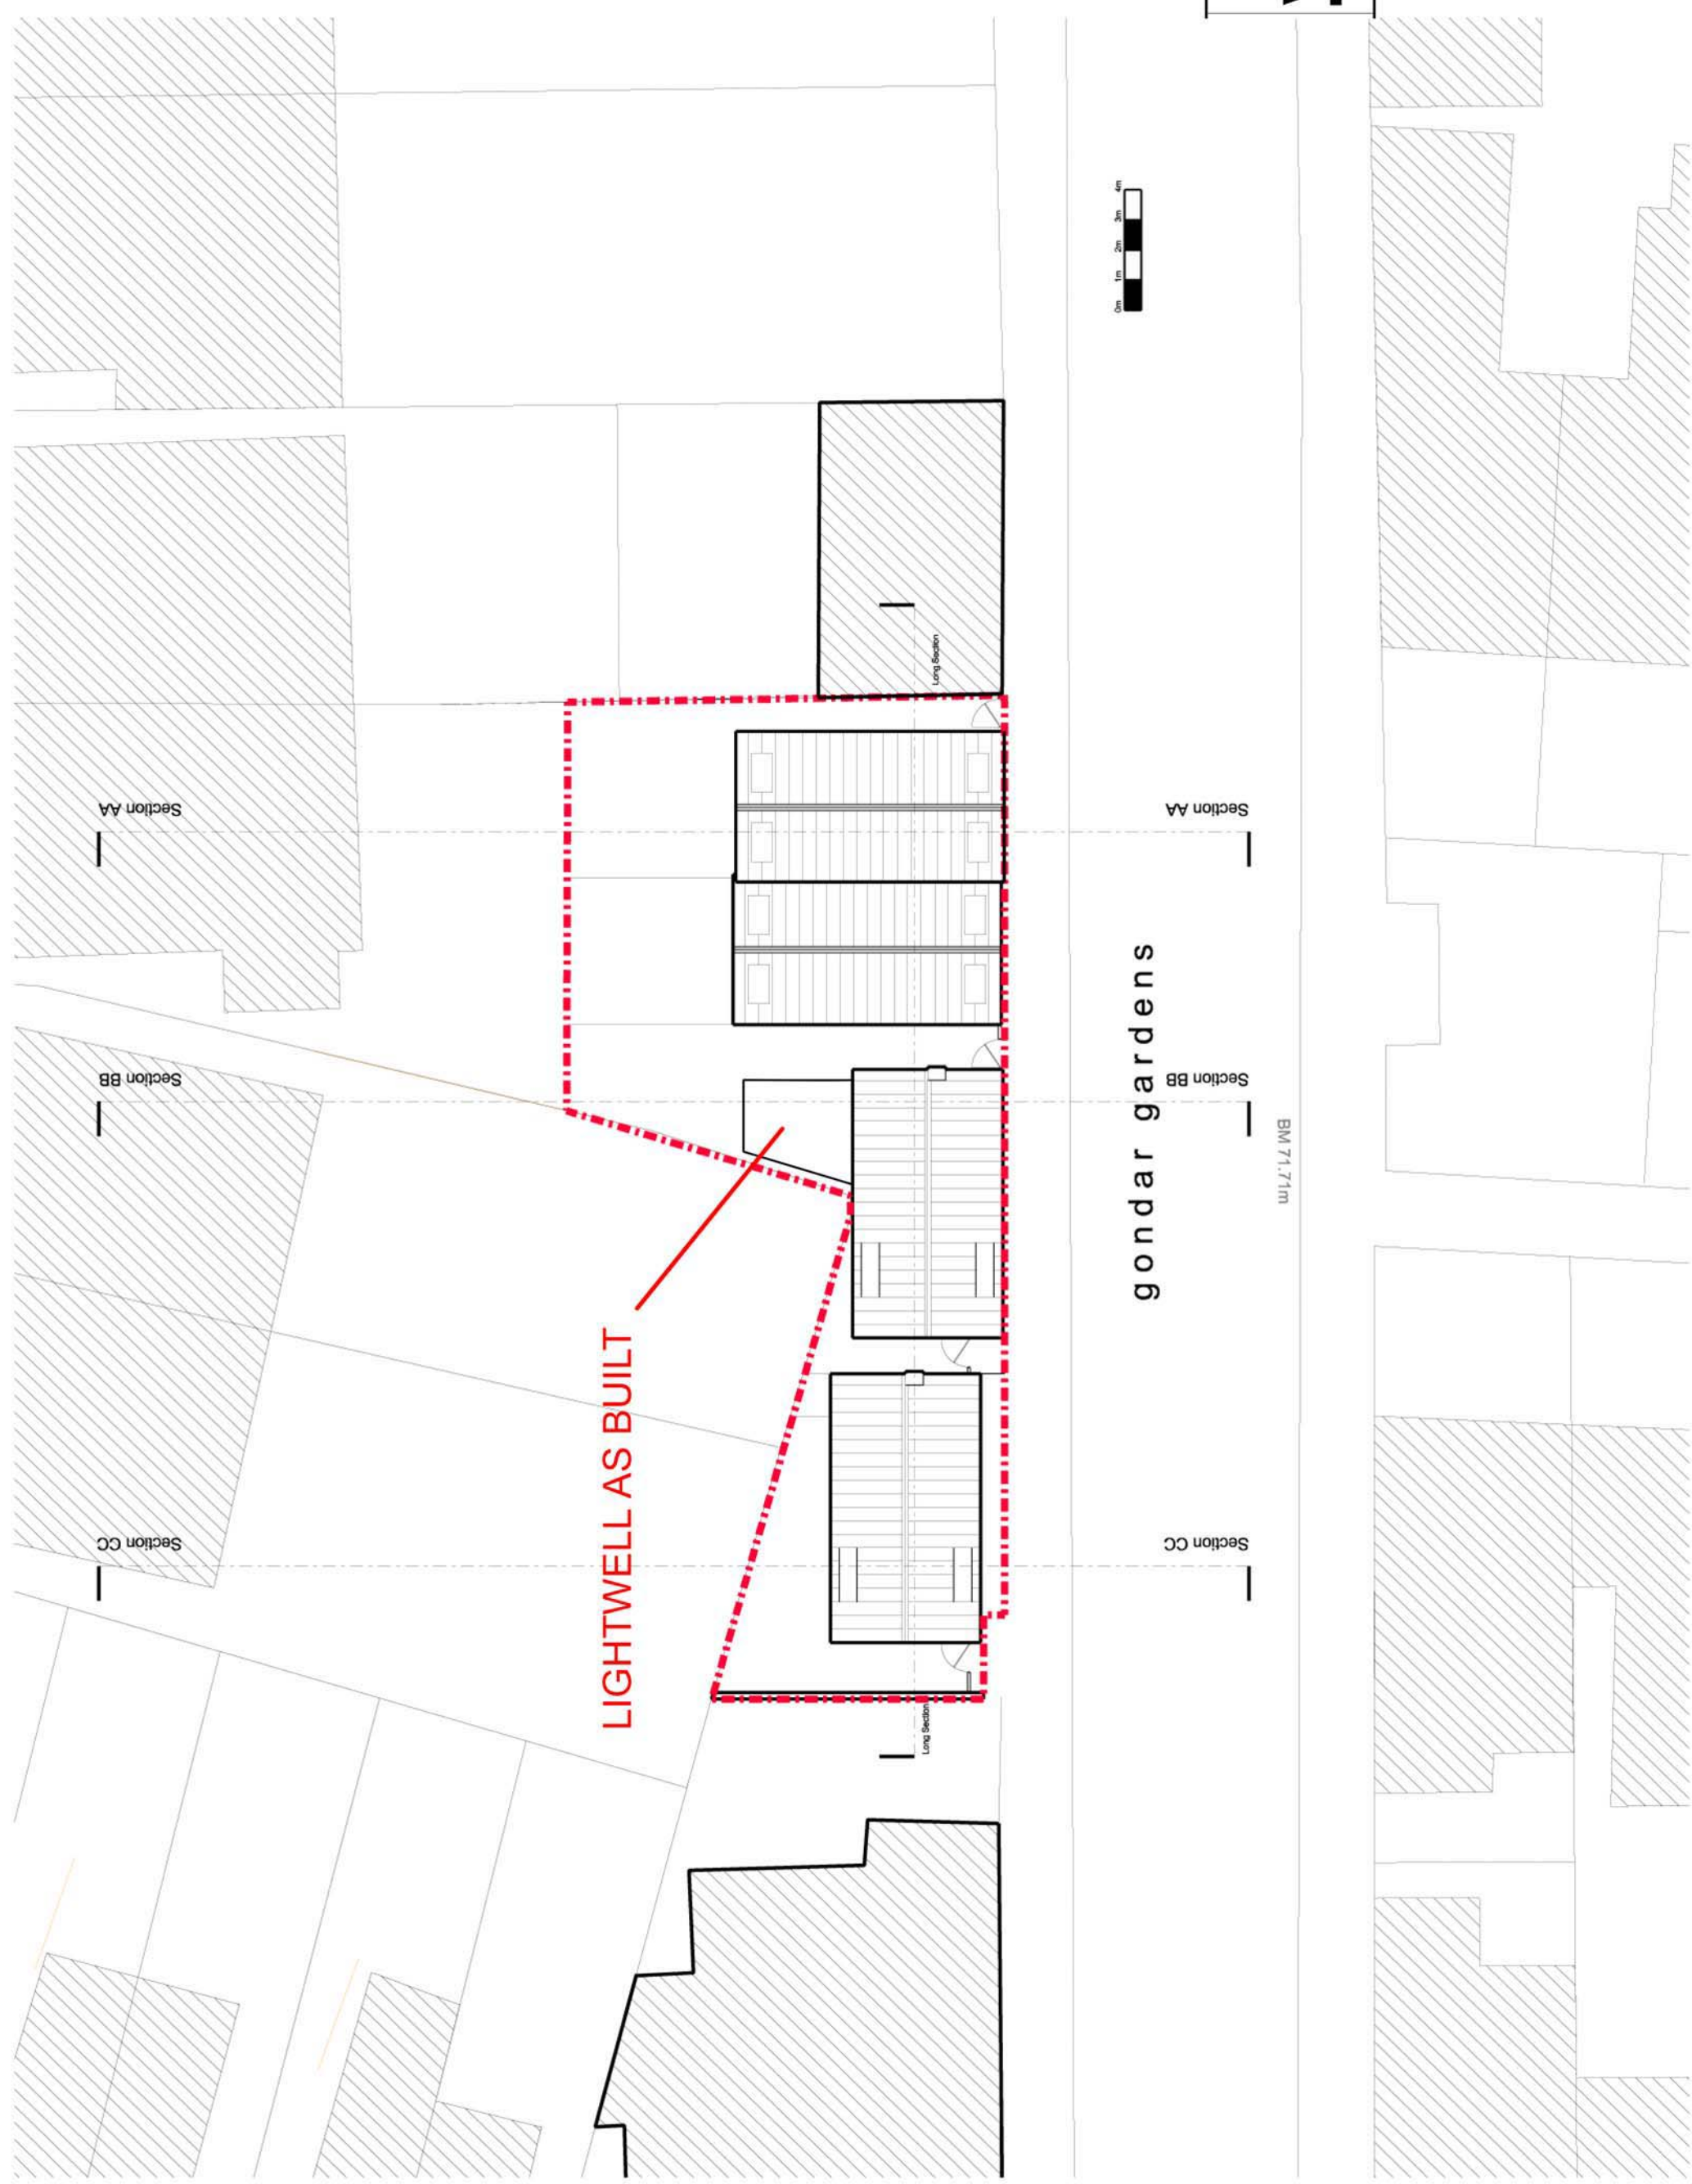

YAVF
 31-32 Sunbury Workshops
 Sunbury, Middlesex TW16 7NF
 London E20 7NF, UK
 t: +44(0)20 7 613599
 info@yavf.co.uk
 e: info@yavf.co.uk

client
 Standard Property Investments
 job
 1 Gondar Gardens - Camden
 drawing title



Proposed Site Plan
AS BUILT

scale	1:200	@A3	23.08.2007	DT	checked by	
job number	sp 01-				revision	B

Do not scale off this drawing. Use figured dimensions only. All dimensions and levels to be checked and confirmed on site.

This drawing is based on current available information and is subject to a full survey. All dimensions and areas are approximate. These proposals are subject to planning consent, Building Regulation approval and Rights of Light and Party Wall agreements.

NOTES:

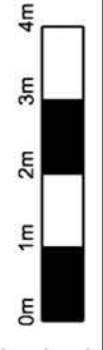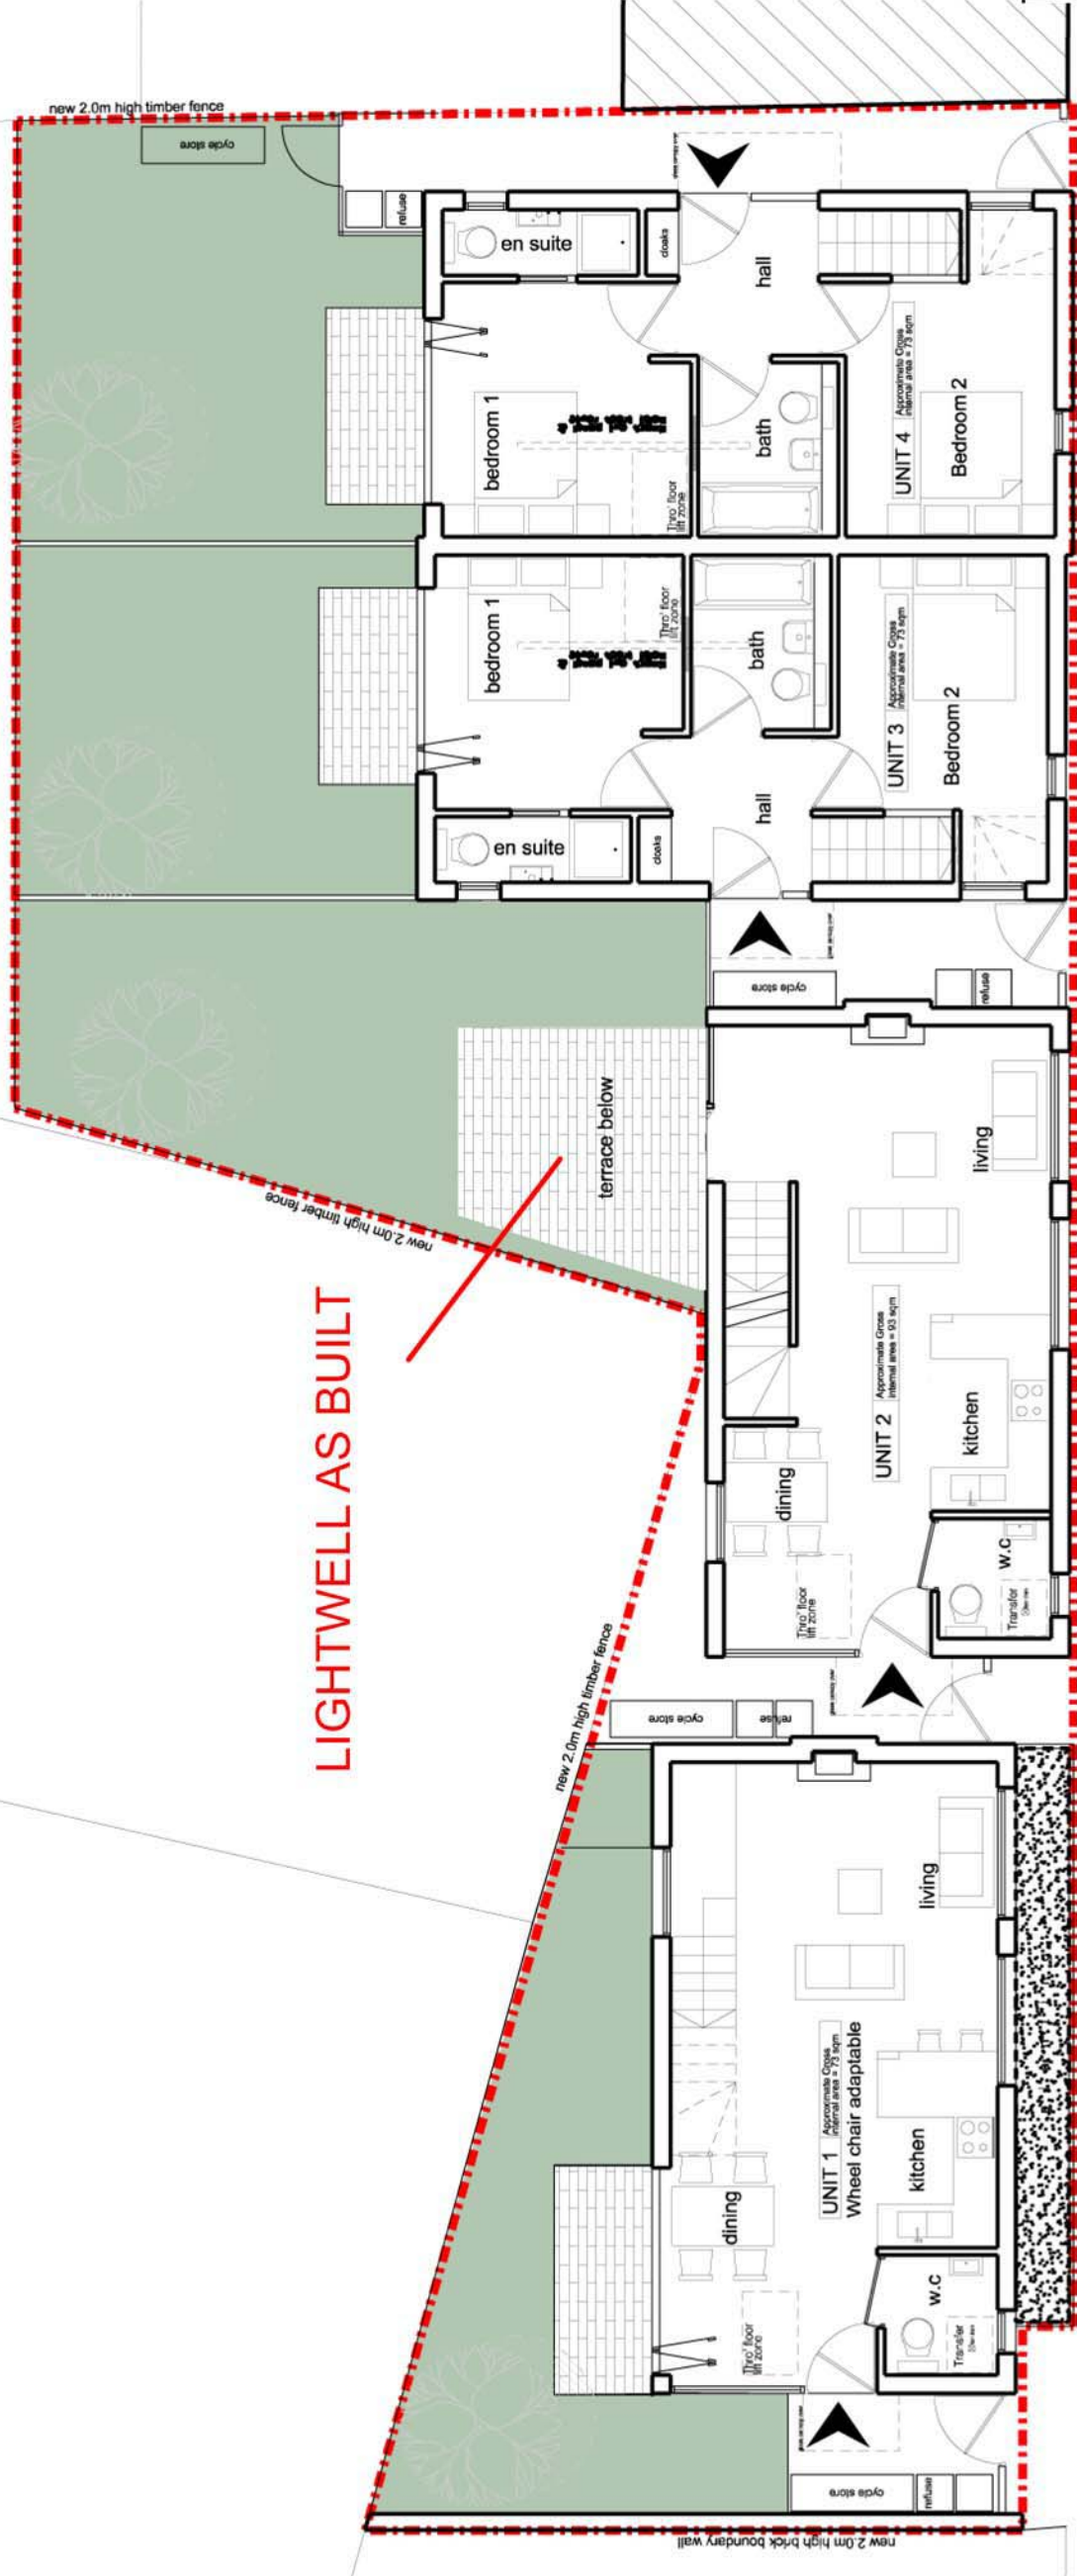

AVI
 31-32 Surrey Avenue
 London E2 7LJ
 UK
 T: +44(0)20 7 613099
 W: www.avi.org.uk
 E: info@avi.org.uk


client		Standard Property Investments	
job		1 Gondar Gardens - Camden	
drawing title			
Proposed Ground Floor			
AS BUILT			
scale	date	drawn by	checked by
1:100	@A3 23.06.2007	DT	
job number	pp 01	drawing number	revision
			C

Do not scale off this drawing. Use figured dimensions only. All dimensions and levels to be checked and confirmed on site.

gondar gardens

This drawing is based on current available information and is subject to a full survey. All dimensions and areas are approximate. These proposals are subject to planning consent, Building Regulation approval and Rights of Light and Party Wall agreements.

NOTES:

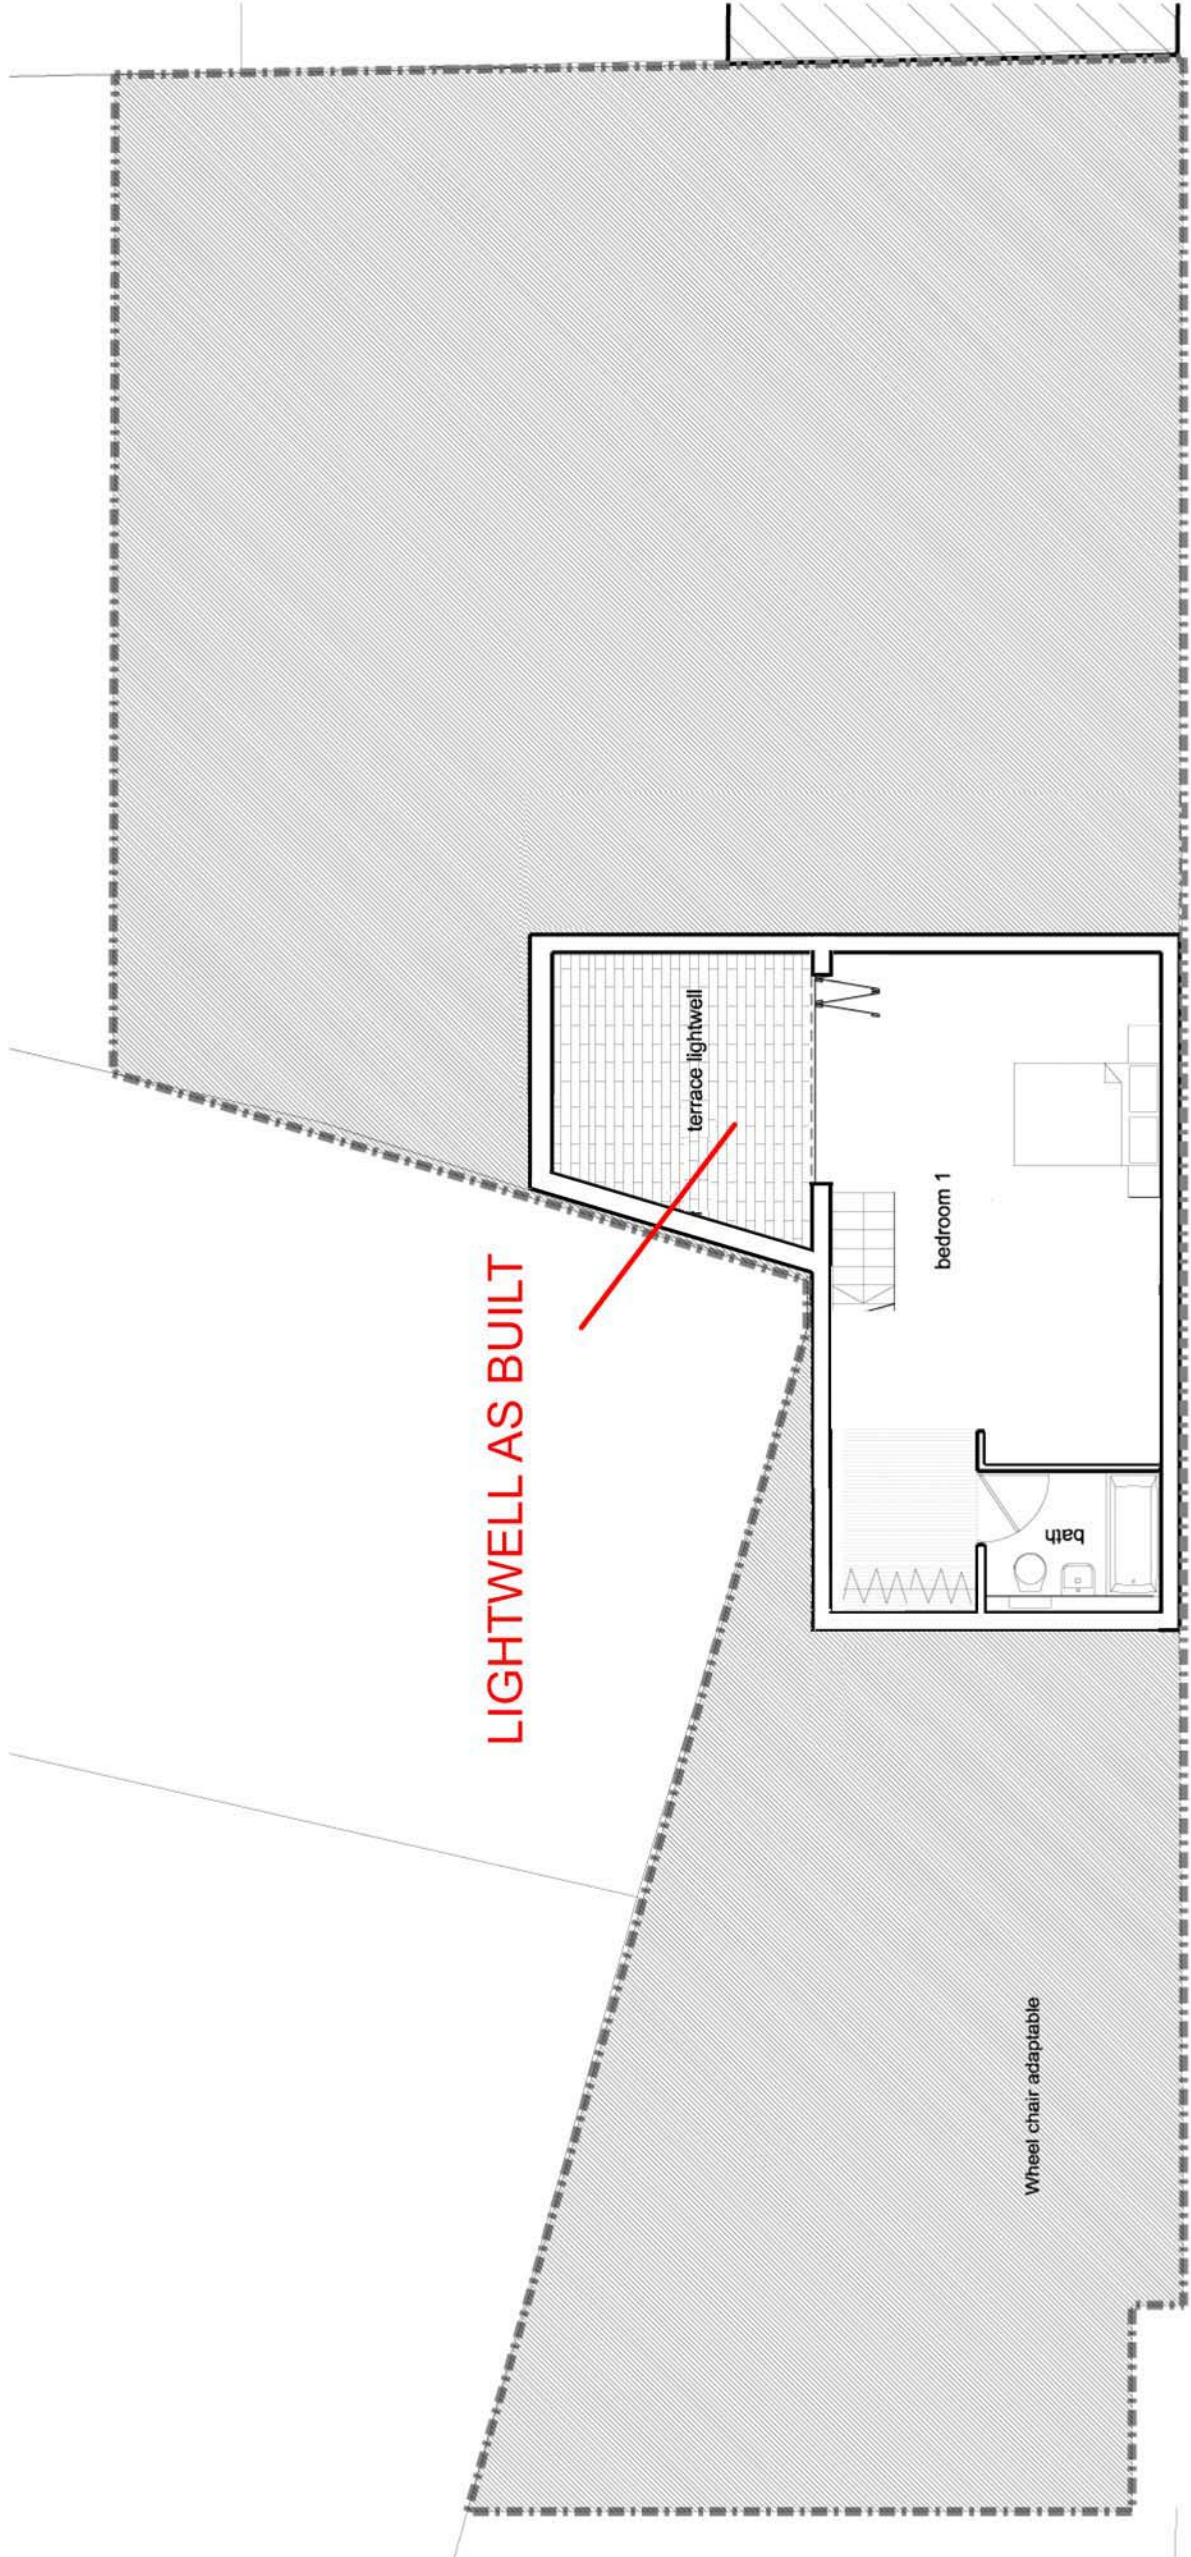

client: Standard Property Investments



job: 1 Gondar Gardens - Camden

drawing title:

Basement Plan
AS BUILT

date	drawn by	checked by
1:100 @ A3 23.06.2007	DT	DT
job number	drawing number	revision
pp 00		C

Do not scale off this drawing. Use figured dimensions only. All dimensions and levels to be checked and confirmed on site.

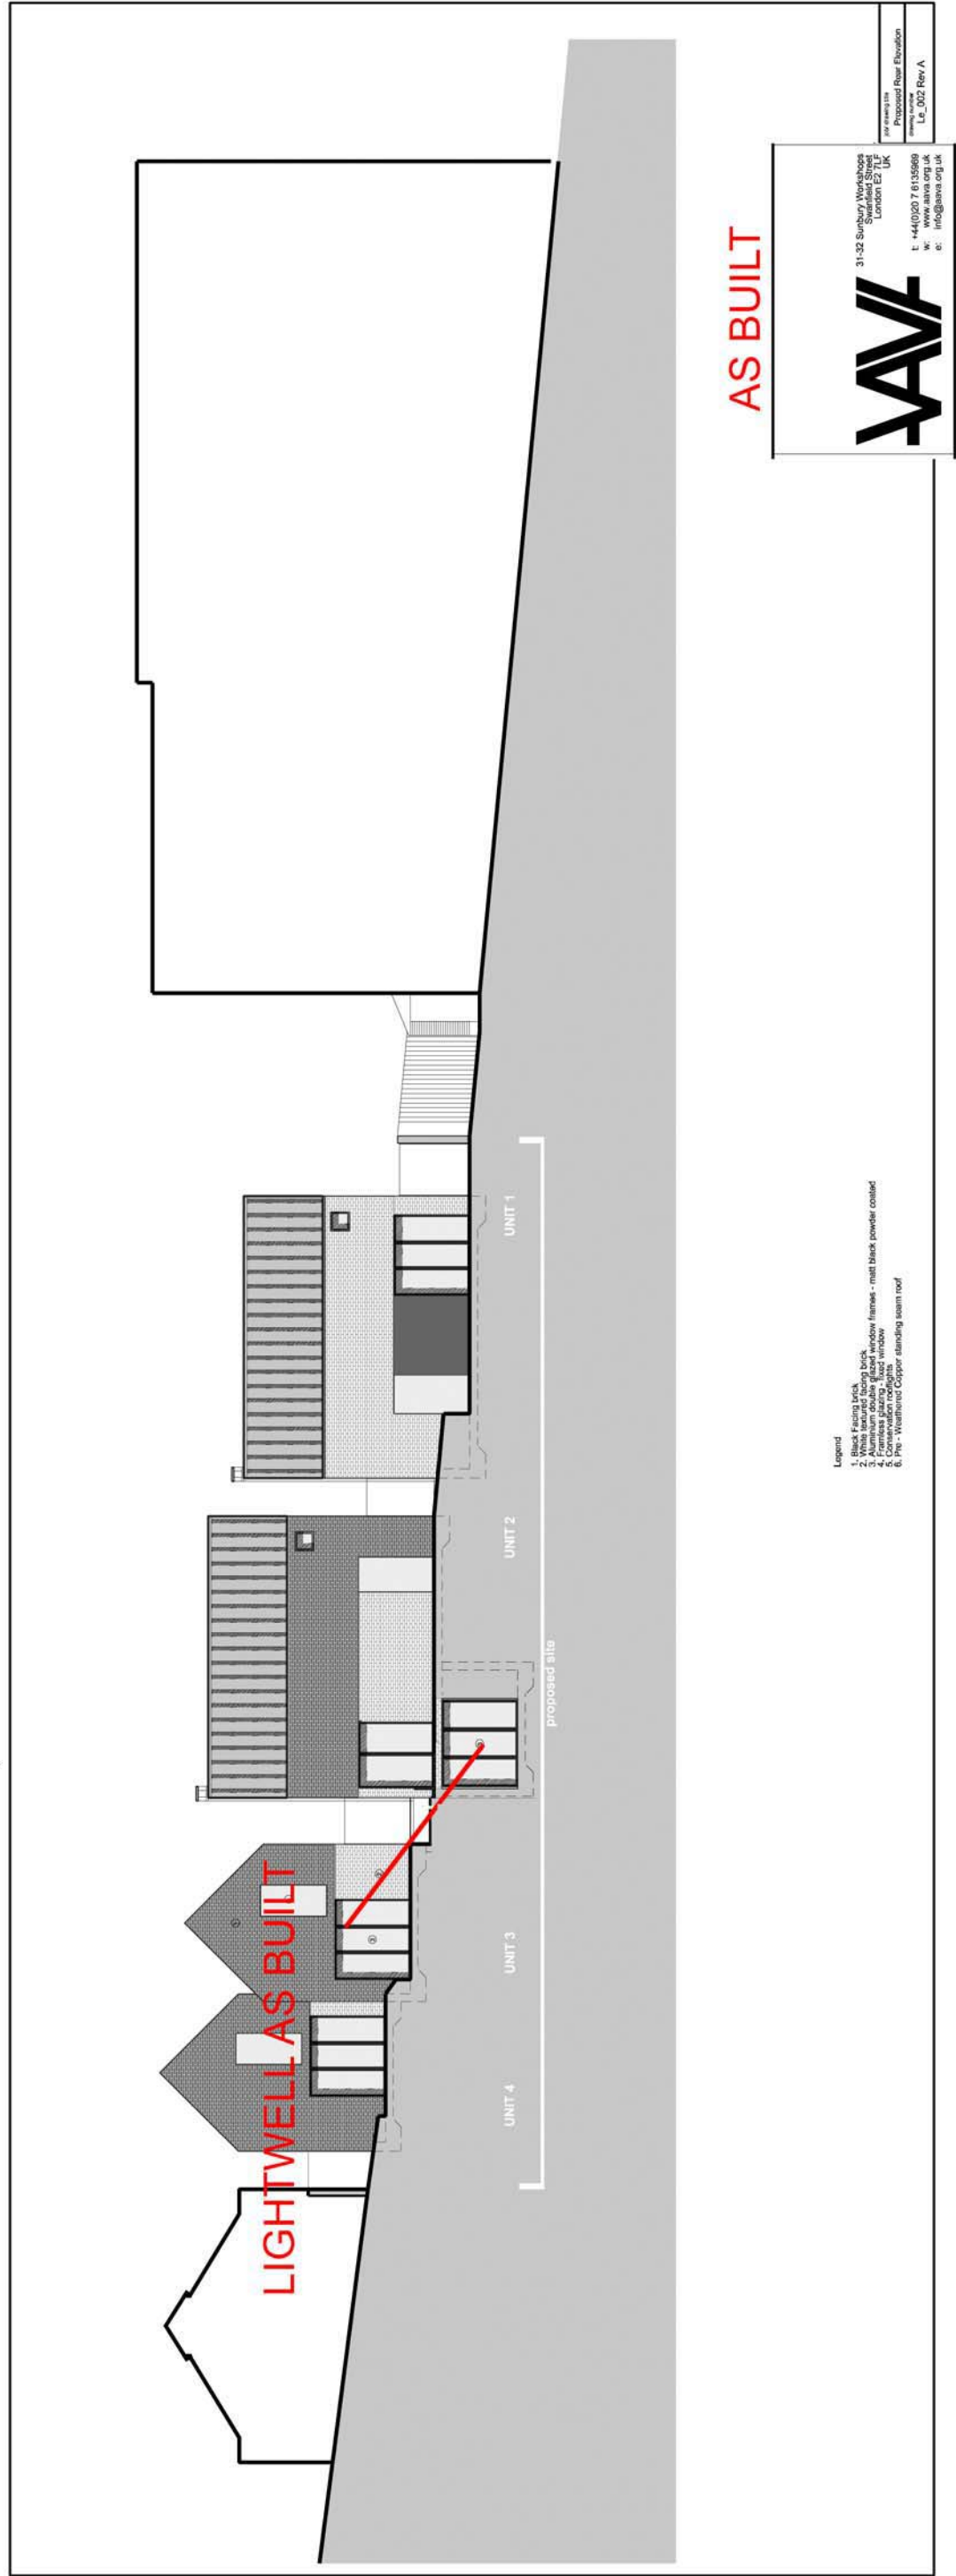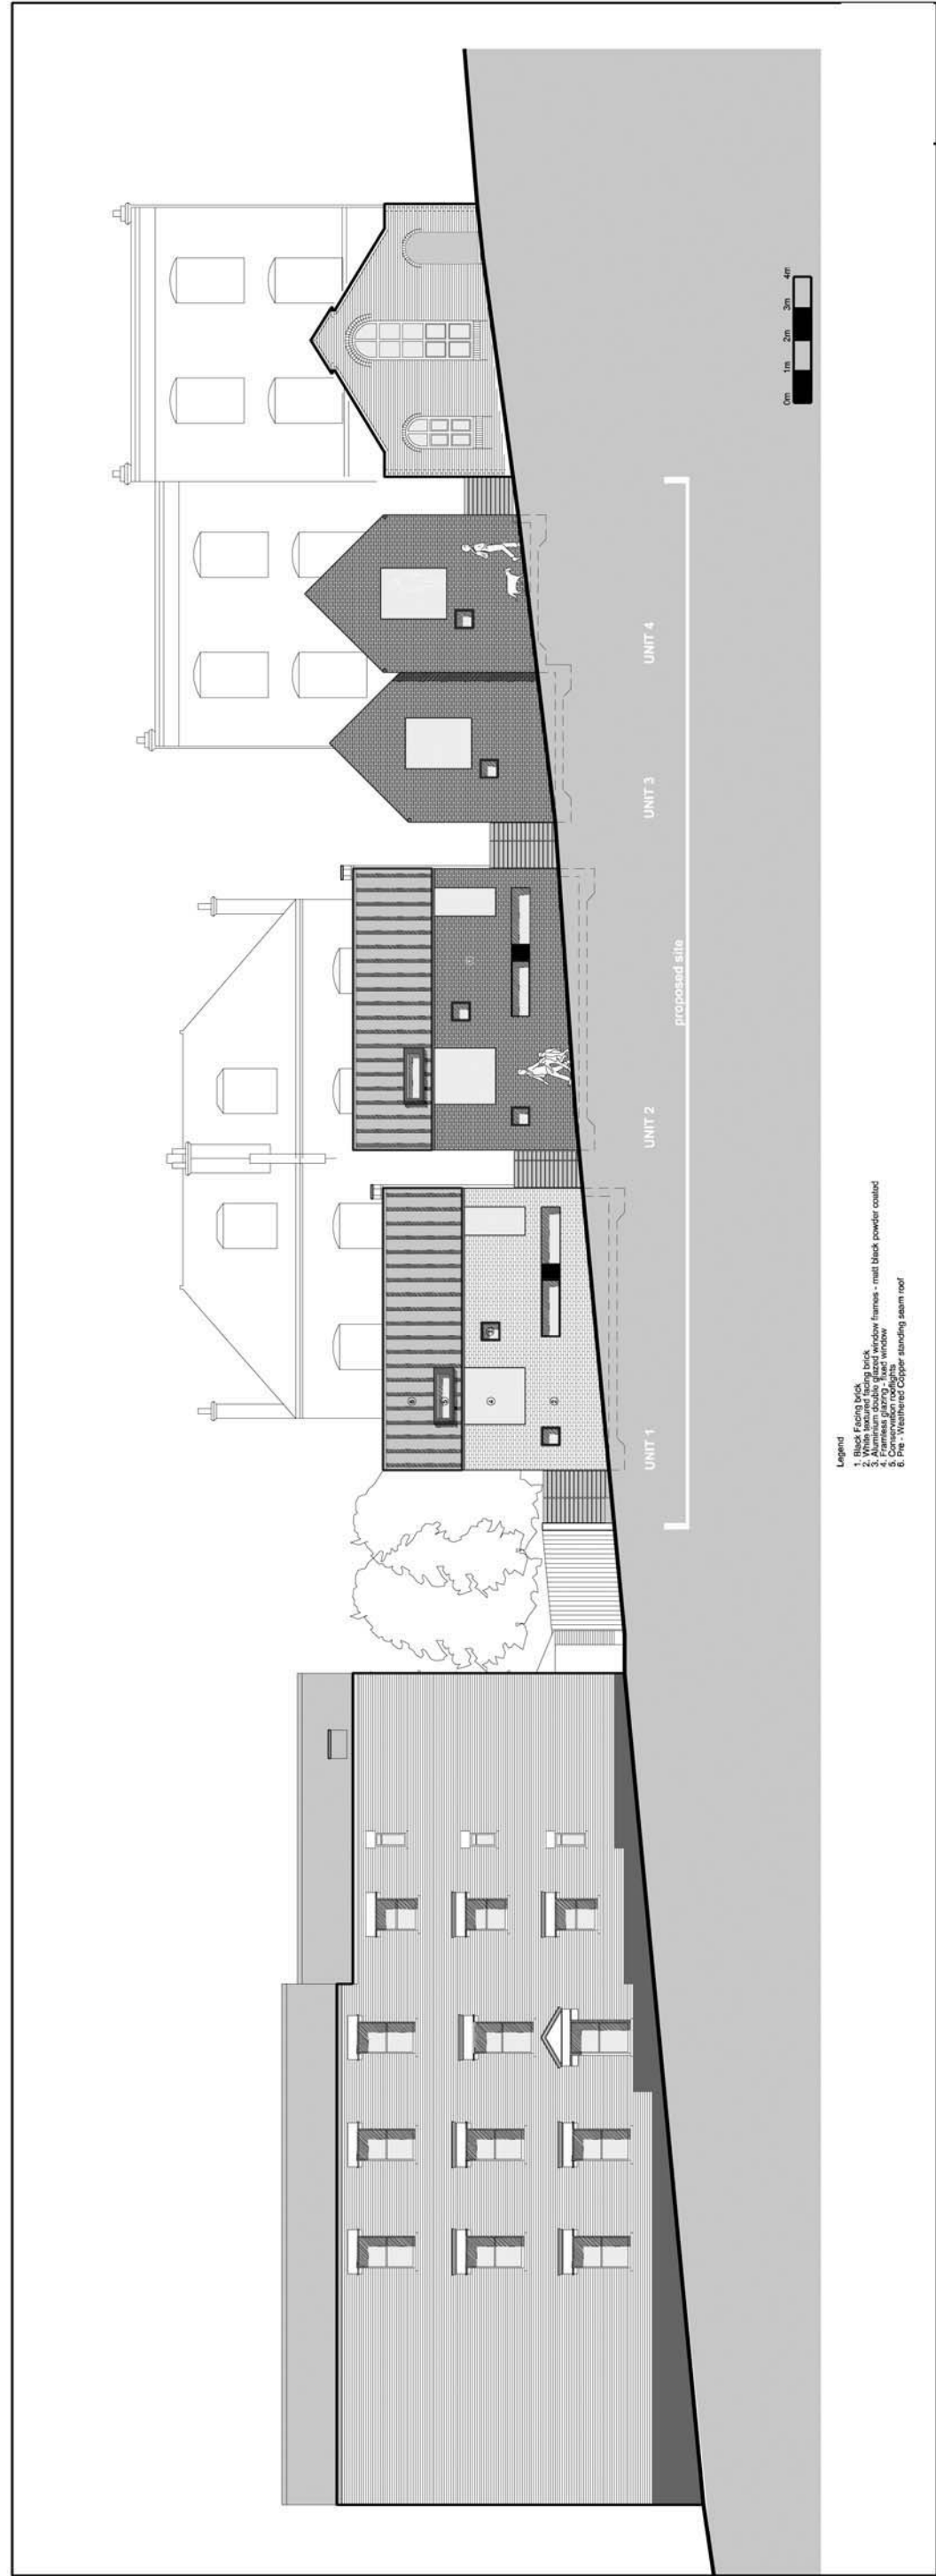

AS BUILT



31-32 Sunbury Workshops
 Sunbury
 London E11 1JF
 United Kingdom
 T: +44(0)20 7 615969
 E: info@javit.org.uk

Proposed Rear Elevation
 Le_002 Rev A