




BLOCK PLAN ~ 1:200

~ NOTES ~



LOCATION PLAN ~ 1:250

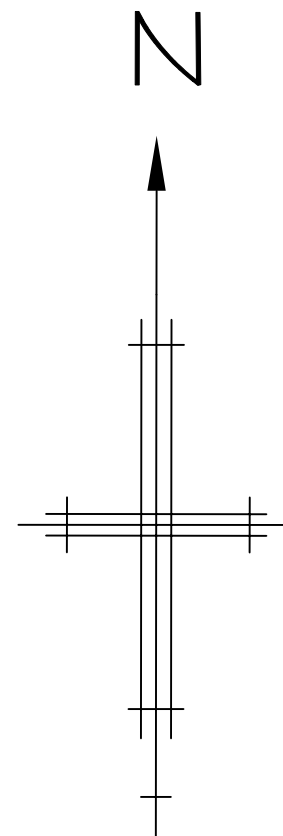

REV B – Rear dormer size and shape as built	09/10/2012
REV A – Rear dormer size and shape revised down	07/04/2012
REVISIONS	DATE

**Architectural
Design & Planning**

32 Grange Road
Plymouth PL7 2HY

t: 01752 341696
f: 01752 342503

**THE DESIGN
WORKS**

TITLE
LOCATION & BLOCK PLANS

ADDRESS
215 FORDWYCH ROAD
LONDON NW2 3NH

CLIENT
COBSTAR DEVELOPMENTS Ltd

SCALE
1:200 & 1:250

DATE
DEC 2011

DRAWING No. 111211/05

REV. B