




SCALE BAR ~ Meters




EXISTING SIDE ELEVATION

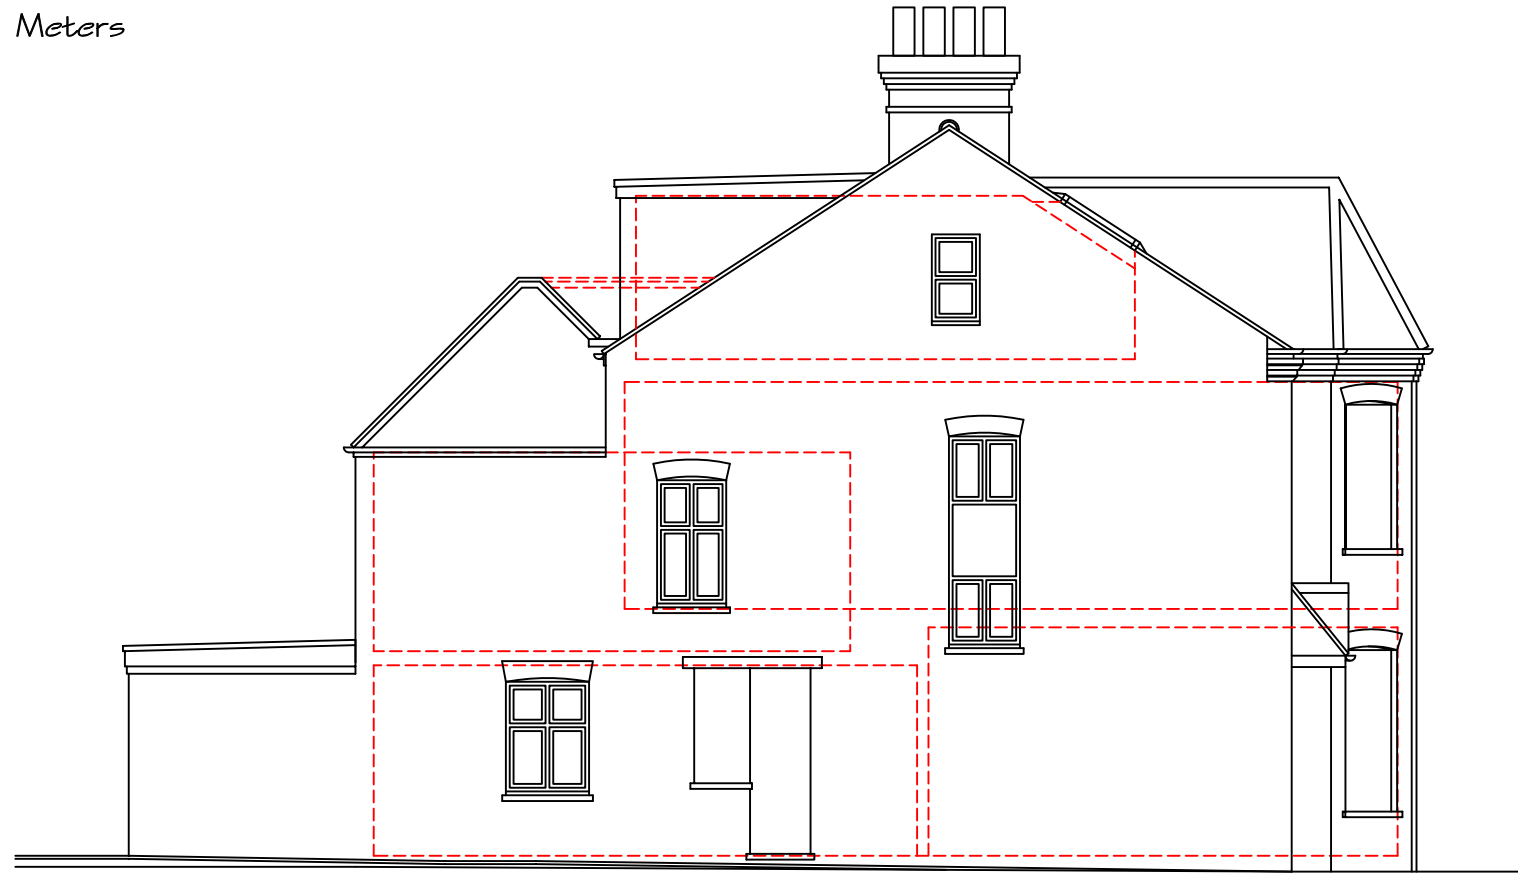

EXISTING REAR ELEVATION



EXISTING FRONT ELEVATION

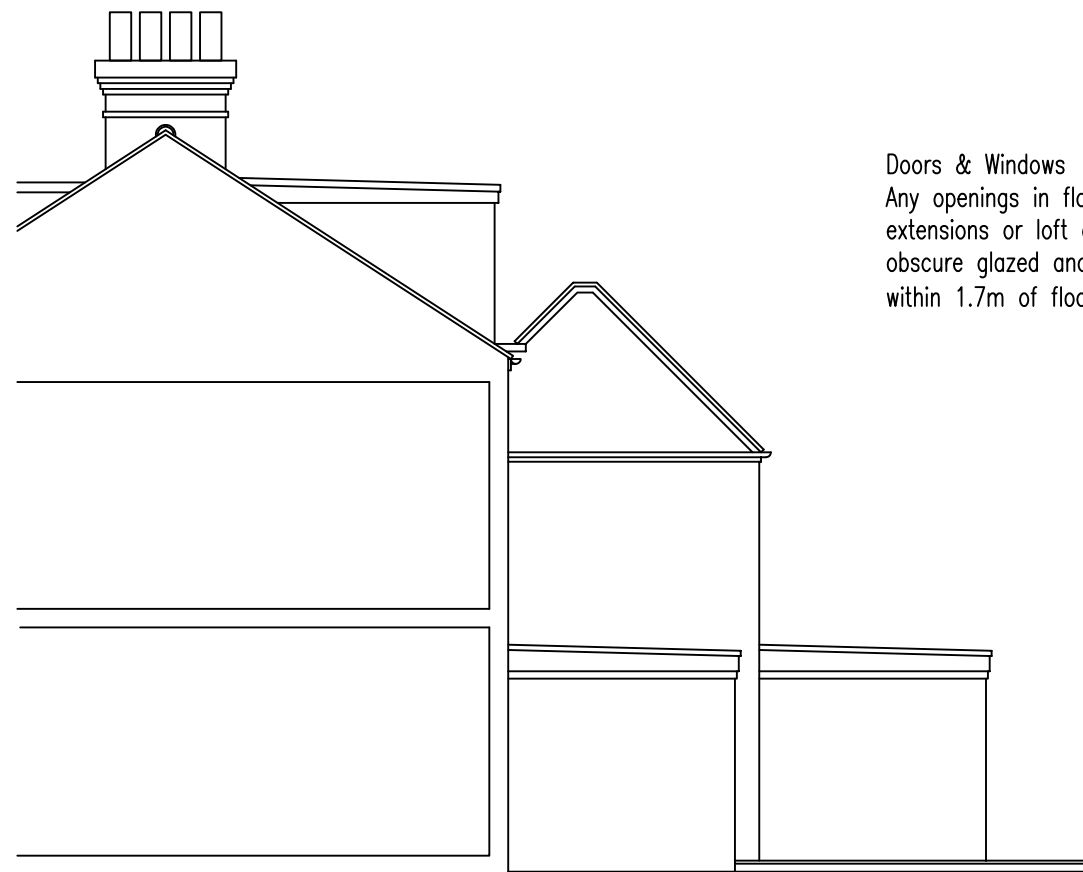

EXISTING SIDE ELEVATION

Doors & Windows
Any openings in flank walls of extensions or loft conversion to be obscure glazed and non opening within 1.7m of floor level

~ NOTES ~

REV B - Permitted development work as built 09/10/2012
REV A - Side elevation looking from North West 10/01/2012
REVISIONS DATE

Architectural
Design & Planning

32 Grange Road
Plymouth PL7 2HY

t: 01752 341696
f: 01752 342503

TITLE
SURVEY - ELEVATIONS

ADDRESS
215 FORDWYCH ROAD
LONDON NW2 3NH

CLIENT
COBSTAR DEVELOPMENTS Ltd

SCALE
1:50 & 1:100 A3 DATE DEC 2011

DRAWING No. 111211/02 REV. B

THE
DESIGN
WORKS