






SCALE BAR ~ Meters

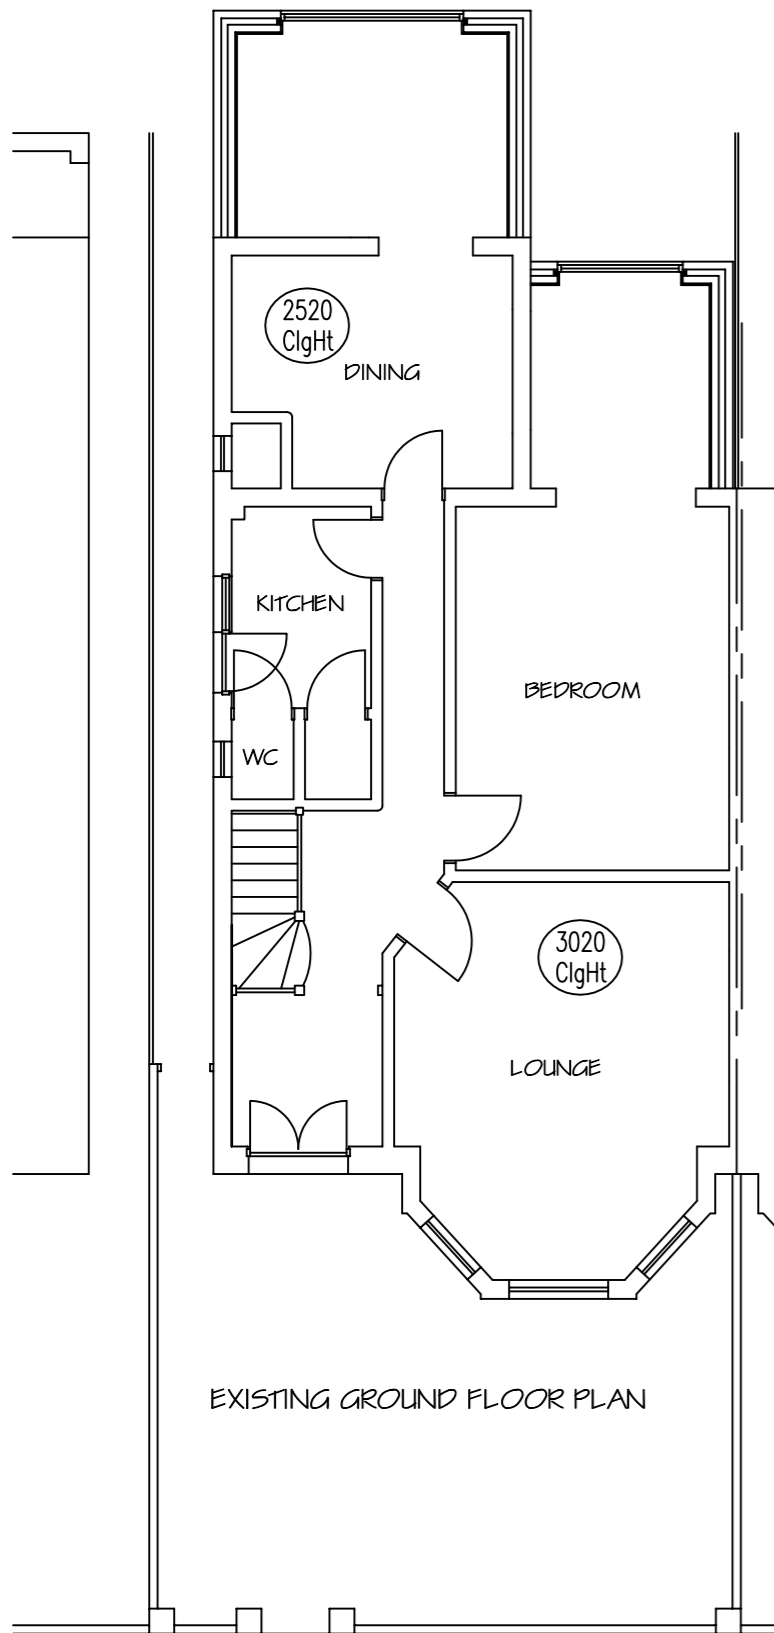


EXISTING GROUND FLOOR PLAN

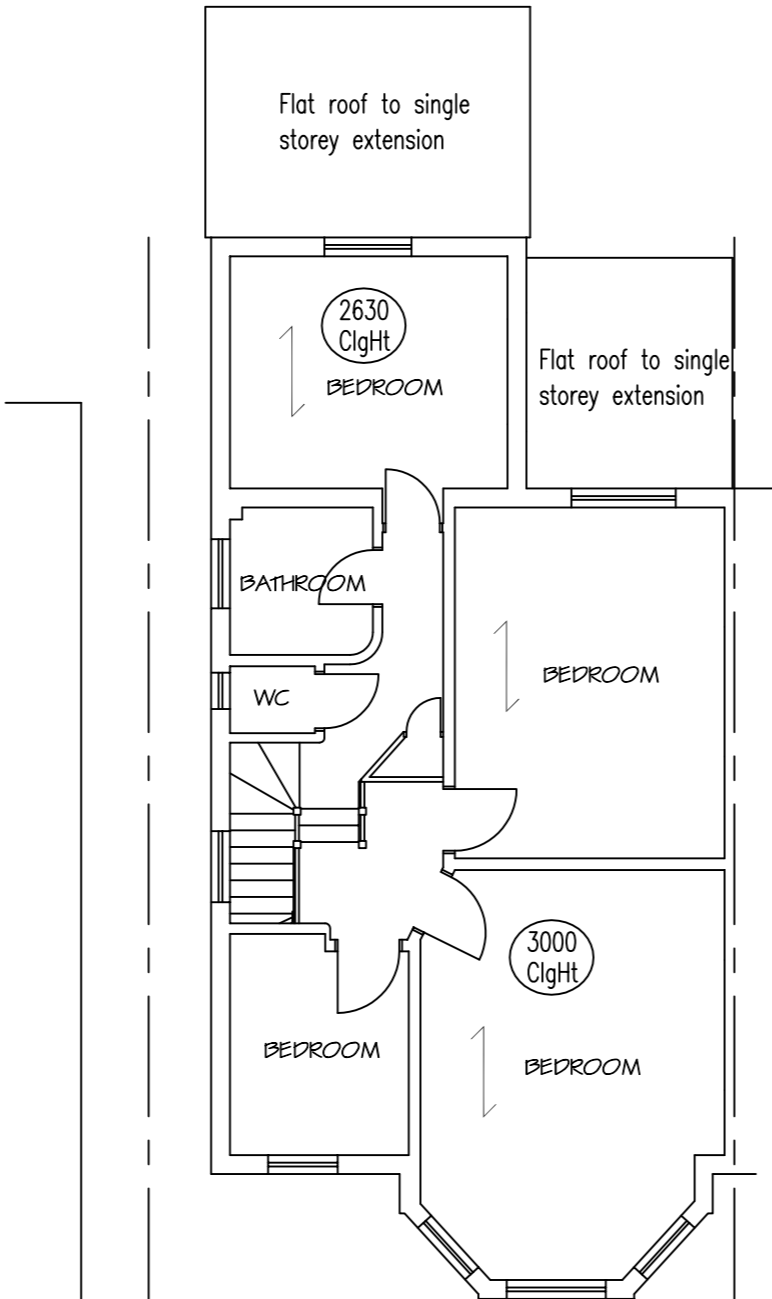

EXISTING FIRST FLOOR PLAN

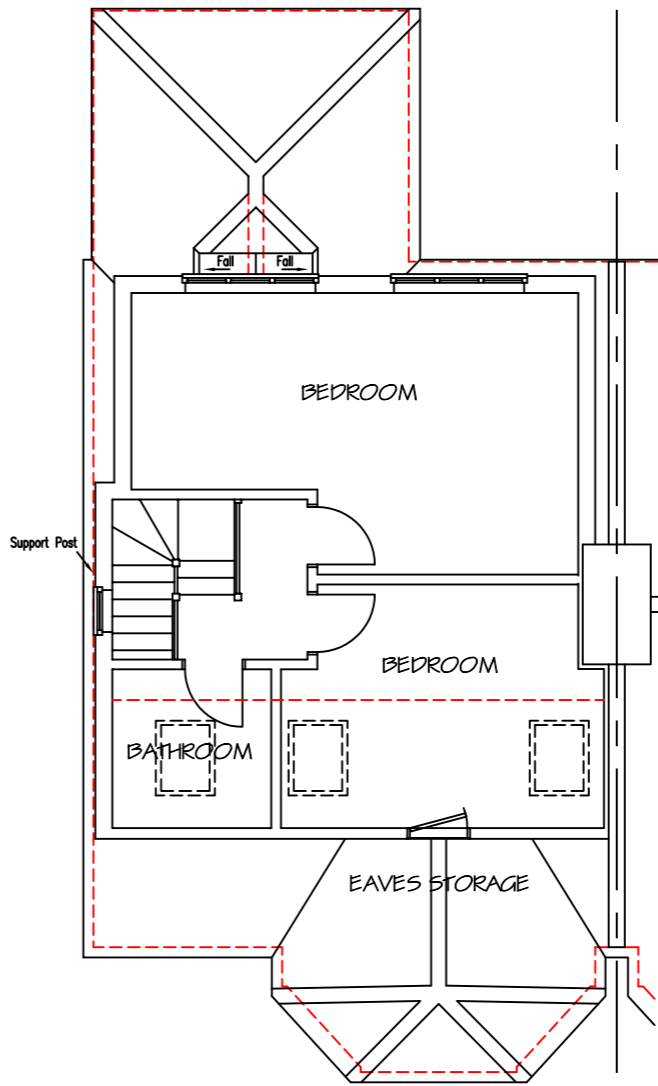

EXISTING SECOND FLOOR PLAN

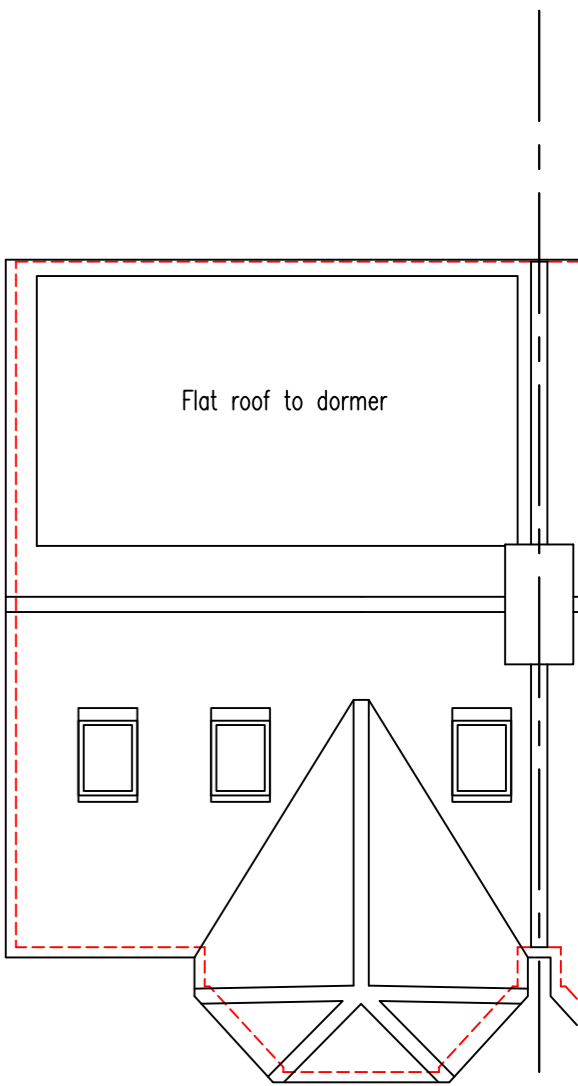

EXISTING MAIN ROOF PLAN

~ NOTES ~

ALL WORK TO BE TO CLIENT & LOCAL AUTHORITY APPROVAL.
ALL RELEVANT BS's & CP's TO BE COMPLIED WITH.
ANY DISTURBANCE TO BE MADE GOOD TO MATCH EXISTING.
ARCHITRAVES, CORNICES, DOORS & SKIRTINGS TO MATCH.
SERVICES TO BE ALTERED & EXTENDED AS NECESSARY.

REV A - Permitted development work as built	09/10/2012
REVISIONS	DATE
Architectural Design & Planning	
32 Grange Road Plymouth PL7 2HY	
t: 01752 341696 f: 01752 342503	
TITLE	
SURVEY - FLOOR & ROOF PLANS	
ADDRESS	
215 FORDWYCH ROAD LONDON NW2 3NH	
CLIENT	
COBSTAR DEVELOPMENTS Ltd	
SCALE	DATE
1:50 & 1:100	DEC 2011
DRAWING No.	REV.
111211 / 01	A