

Our Ref: Maida Vale/PCP027/WO/JB
Tel: 01634 661556
Email: planning@harlequin-group.com

Seonaid Carr
Planning Officer
Regeneration and Planning
Culture and Environment
London Borough of Camden Council
Town Hall Extension (Development Management)
Argyle Street
London
WC1H 8ND

30 October 2012

Dear Seonaid

NOTIFICATION OF THE SUBMISSION OF A PRIOR APPROVAL APPLICATION FOR THE INSTALLATION OF 1x OPENREACH BROADBAND CABINET WITHIN THE PUBLIC HIGHWAY.

PART 24 OF THE TOWN AND COUNTRY PLANNING (GENERAL PERMITTED DEVELOPMENT ORDER) (AS AMENDED) 1995 AND ALSO REGULATION 6 OF THE ELECTRONIC COMMUNICATIONS CODE (CONDITIONS AND REGULATIONS) 2003 AND IN ACCORDANCE WITH THEIR LICENCE.

Please find enclosed a Prior Approval application made under the legislation detailed above. Detailed below is the number of the PCP where the application has been submitted. For ease of validation a copy of the application has been included on a CD-Rom and has been enclosed with this letter.

Further to your email of 17 October and our subsequent telephone conversation, we have not included a fee with this application as the site location has not changed (your ref 2012/4530/P) refers.

PCP027 Abbey Road, S/O Sylvan Court, 145A Abbey Road, London, NW6 4SP 525626 184004

Attached are details pursuant to the proposed cabinet. I have included a location plan, a photomontage and a line drawing. Please note that Openreach refers to each site with a PCP reference. As such the location above relate to the PCP numbered below on the site details. Please could you always correspond using the PCP number as it will greatly assist us in identifying the correct cabinet.

The Harlequin Group • Innovation Centre • Maidstone Road • Chatham • Kent ME5 9FD
T: +44 (0)1634 683635 F: +44 (0)1634 661550 E: reception@harlequin-group.com

Offices: Livingston (Scotland), N. Ireland, Chatham (Kent) • Directors: David Summers BSc (Hons) MRICS, Andrew Wood, Philip Royal, Ian McIntosh BEng (Hons) CEng MICE, Russell Frith BSc (Hons)
Harlequin Ltd t/a The Harlequin Group registered in England and Wales • Registered Number: 2836322 • Registered Office: Innovation Centre • Maidstone Road • Chatham • Kent ME5 9FD

Should you have any queries or concerns arising from this matter please do not hesitate to contact me.


Yours sincerely

William Osborne MRTPI
Harlequin Group
For and on behalf of BT PLC (The Applicant)

ECI 128
Cabinet



PCP027 Abbey Road, S/O Sylvan Court, 145A Abbey Road, London, NW6 4SP 525626
184004

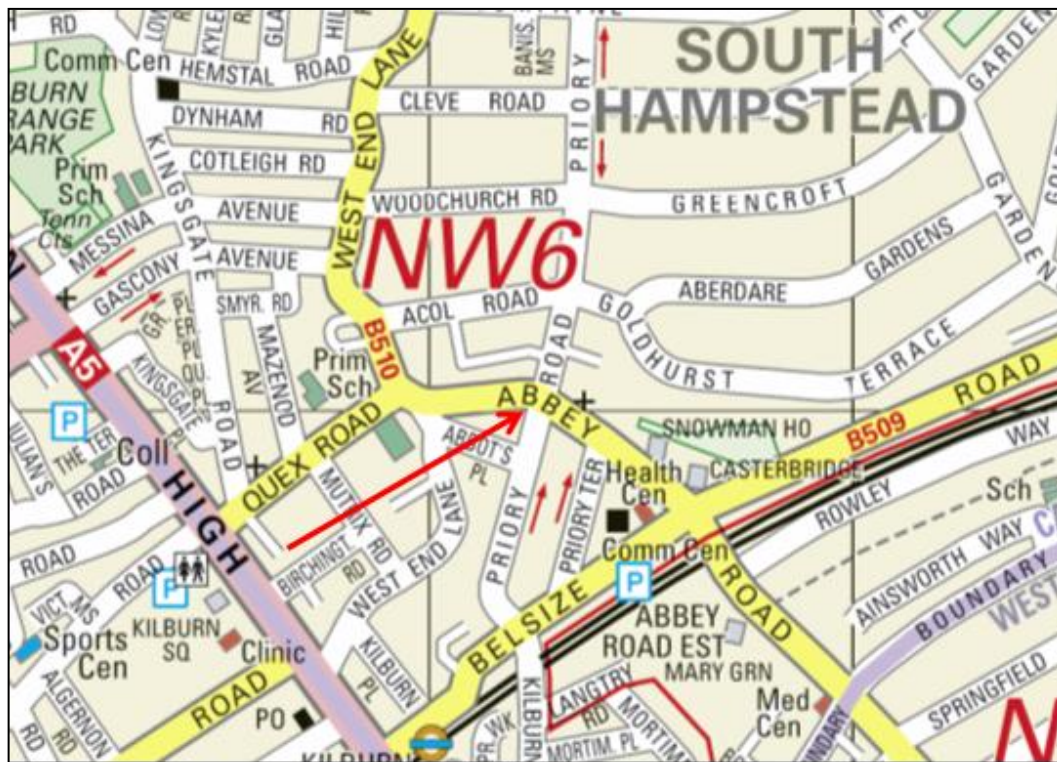

| | | |
|-------------------|-------------|-----------------|
| DSLAM to JB route | Power route | This montage is |
|-------------------|-------------|-----------------|

DSLAM CABINET LOCATION:

Abbey Road
S/O Sylvan Court, No.145A
Abbey Road
London
NW6 4SP
525626 184004

Measurements

PCP to DSLAM: **8.9** Metres
DSLAM to Junction
Box: **0.6** Metres
DSLAM Power
Excavation to LV: **0.6** Metres
Pavement Width @
DSLAM: **4.2** Metres

As Laid
Date:
Drawn By:
Comments:

Line Drawing

