


Note: Proposed alterations indicated in red

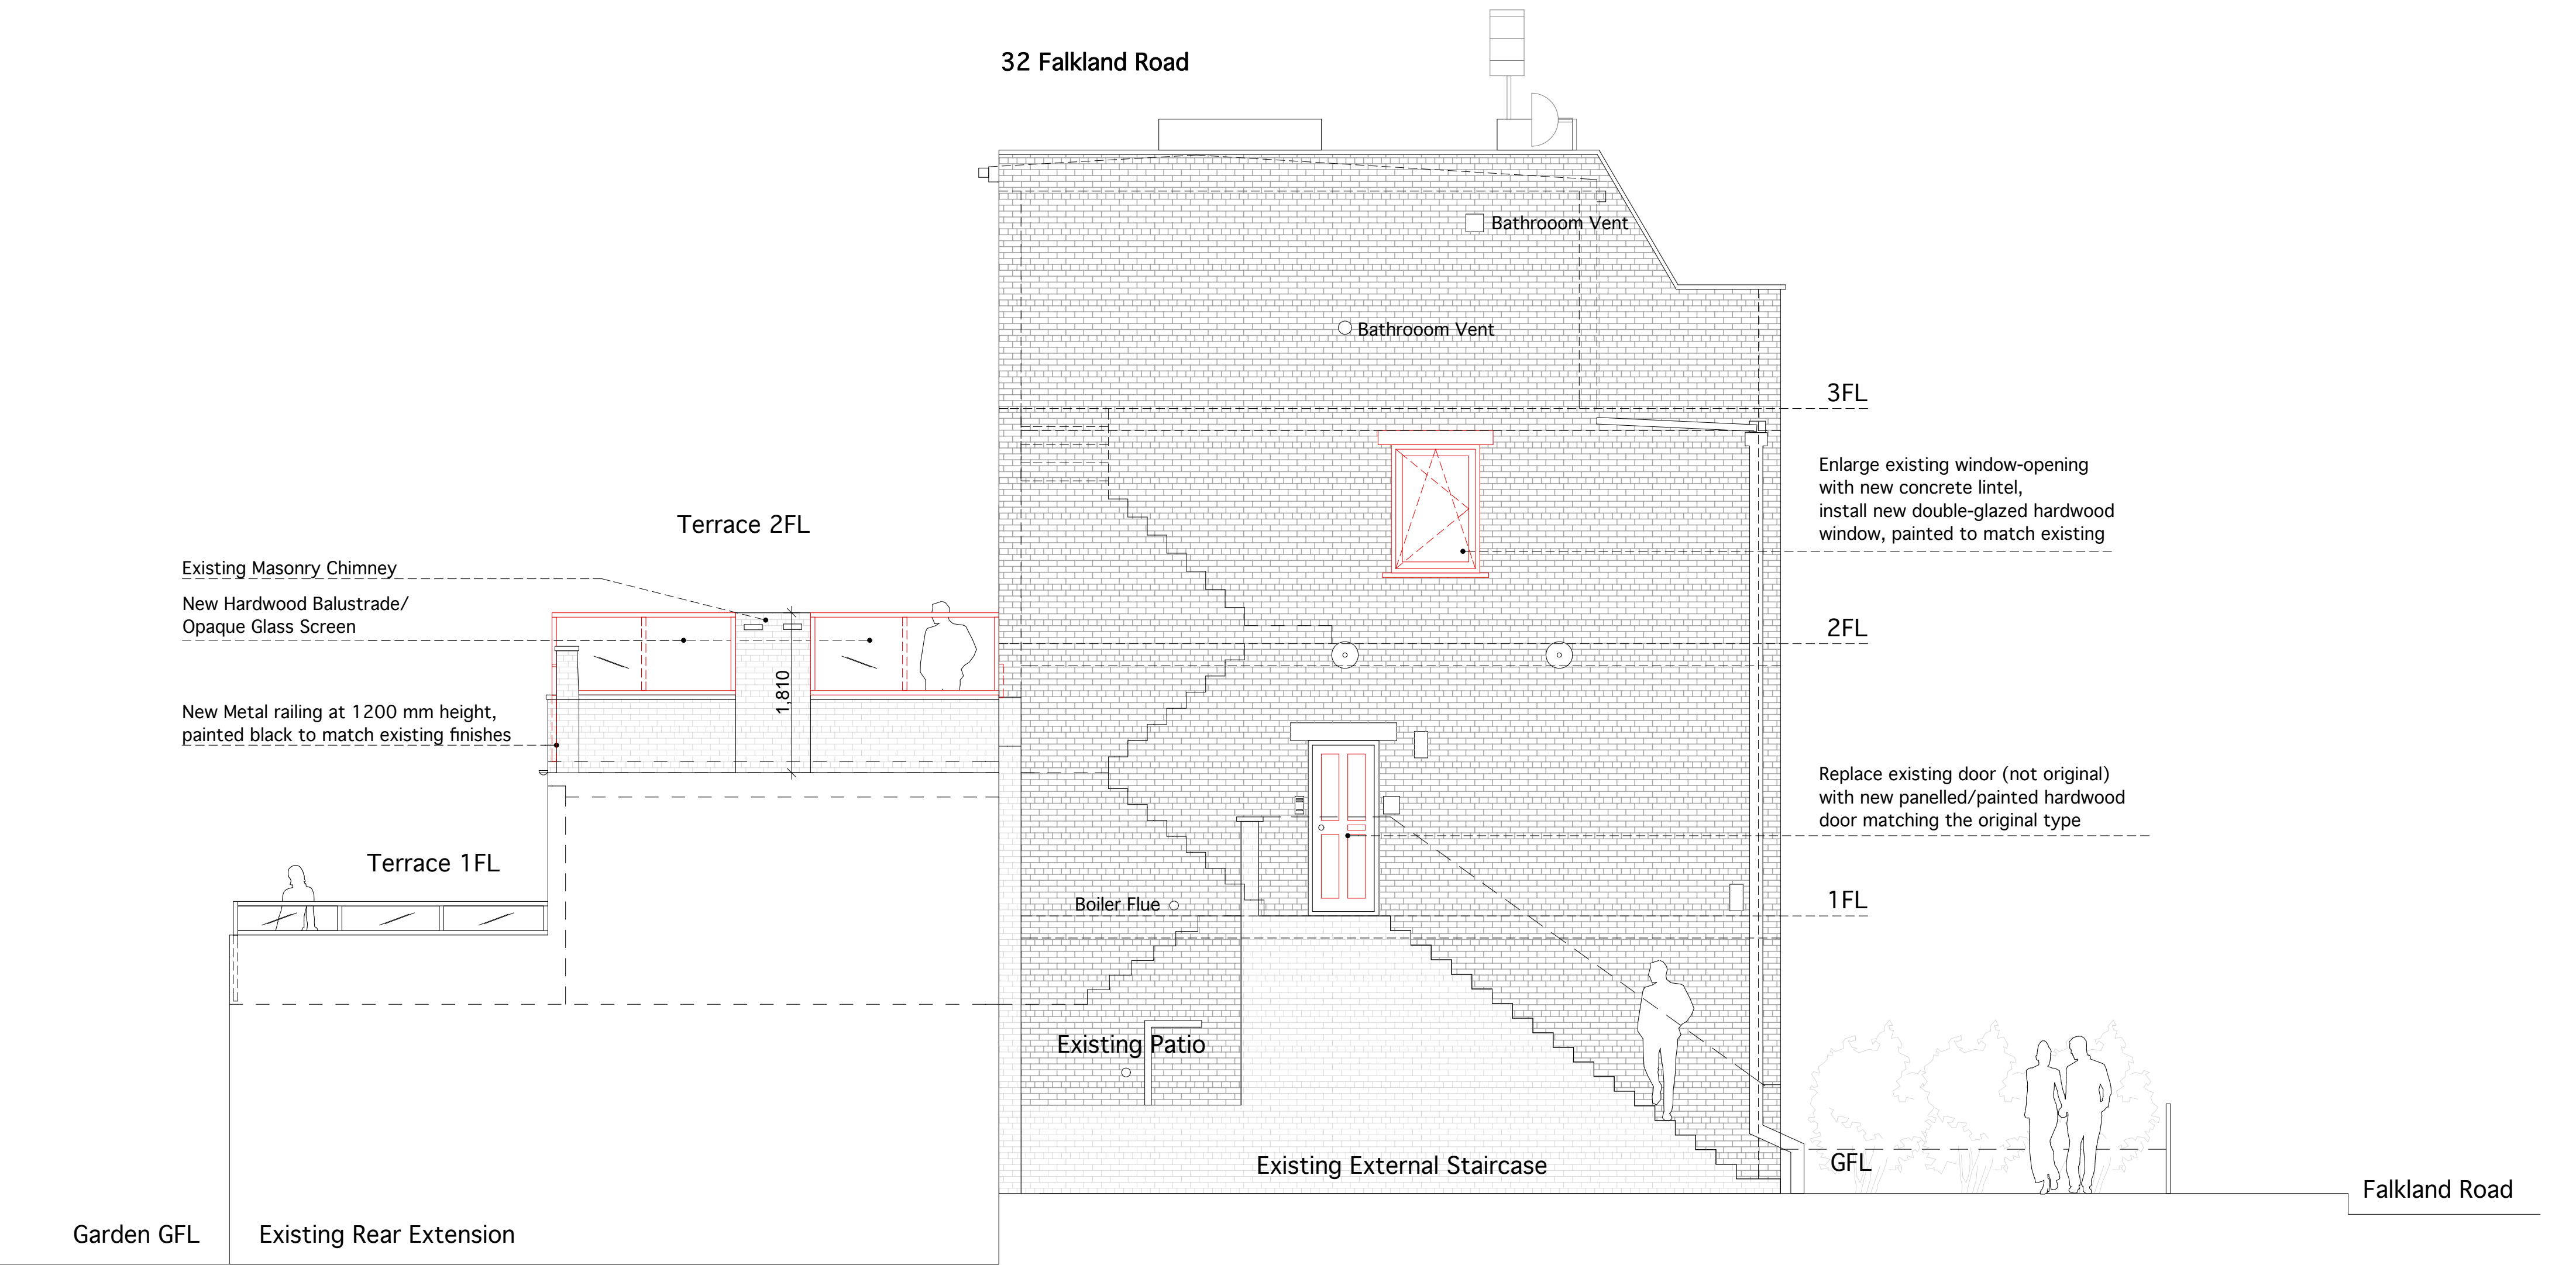

Proposed East Elevation

REV	DATE	DESCRIPTION	REV	DATE	DESCRIPTION	REV	DATE	DESCRIPTION
/	27.08.2012	PLANNING ISSUE						
A	18.10.2012	REVISIONS PRIVACY SCREEN						



SIR SOLUTIONS LONDON VIENNA

UK 6 FOURNIER STREET LONDON E1 6QE
A STUCKGASSE 3/3 A-1070 WIEN

T UK +44 (0)75 51 656 431
T A +43 (0) 680 250 80 25

E INFO@SIR-S.NET
W WWW.SIR-S.NET

32 FALKLAND ROAD, NW5 2PX, CAMDEN COUNCIL

PROPOSED EAST ELEVATION

PLANNING ISSUE

DRAWN **MI** CHECKED **MI**

1:50 @ **A2**

ISSUE DATE **18.10.2012** 1205 GA 502 REV **A**