
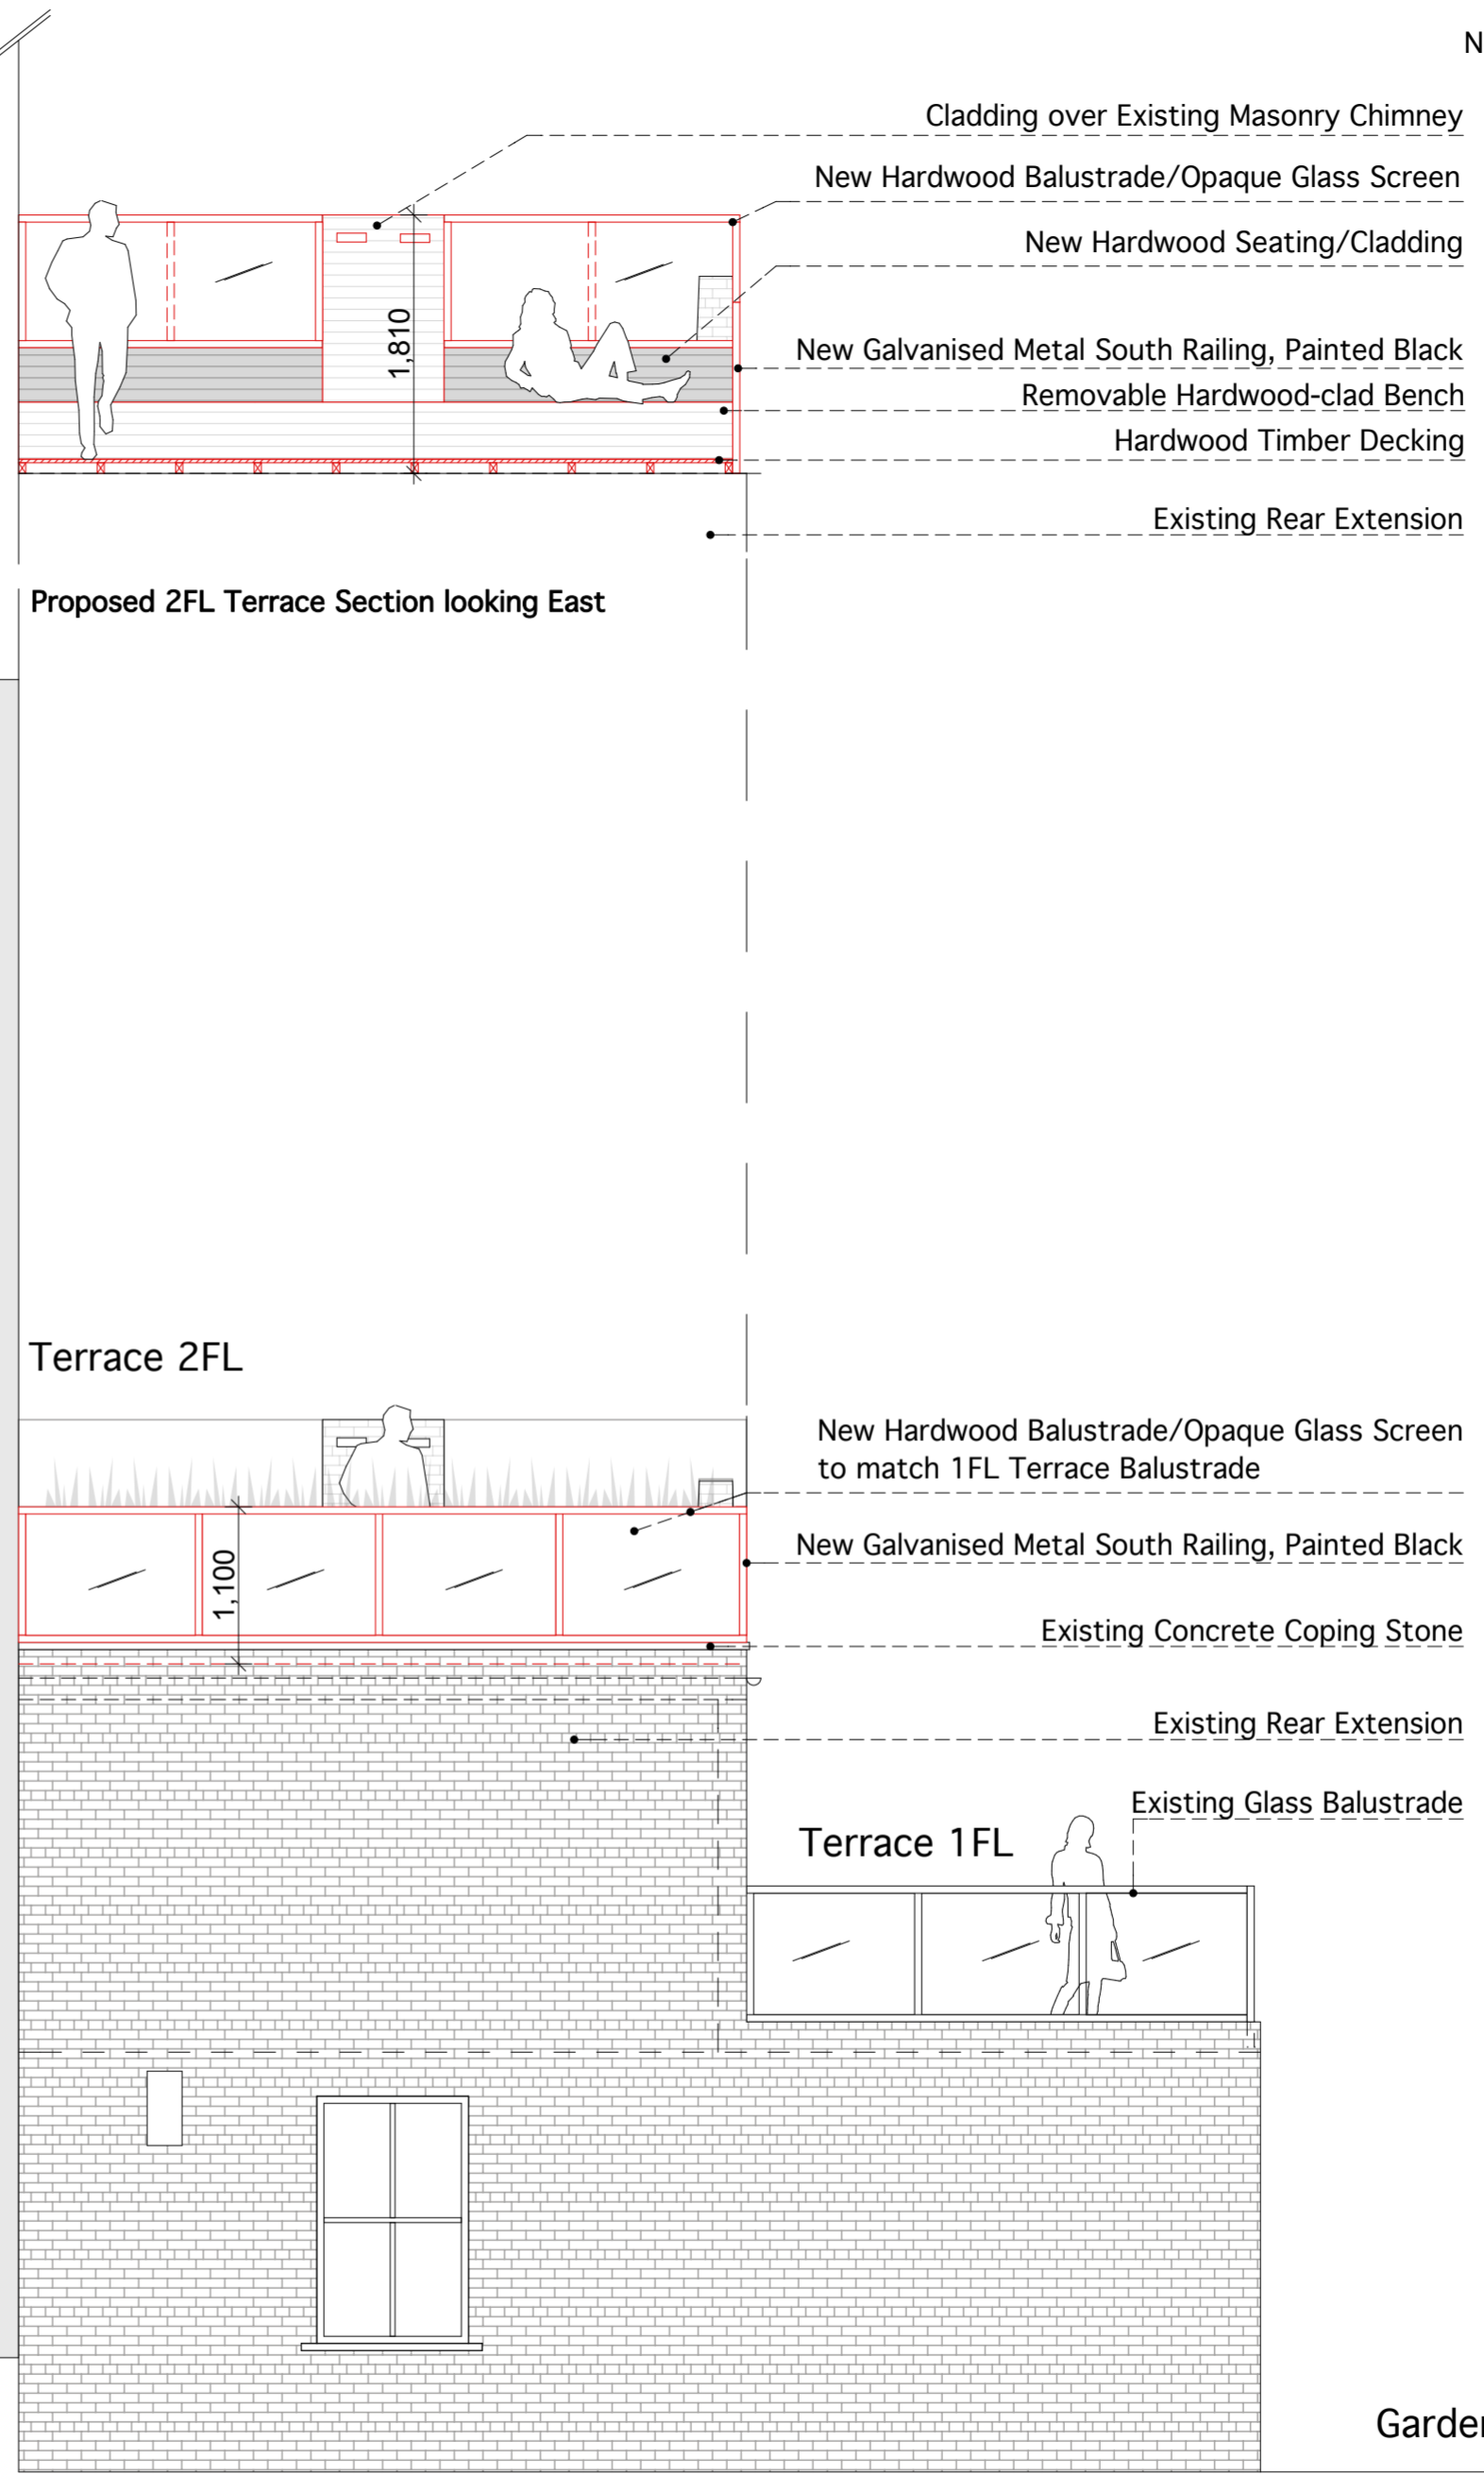


Note: Proposed alterations indicated in red

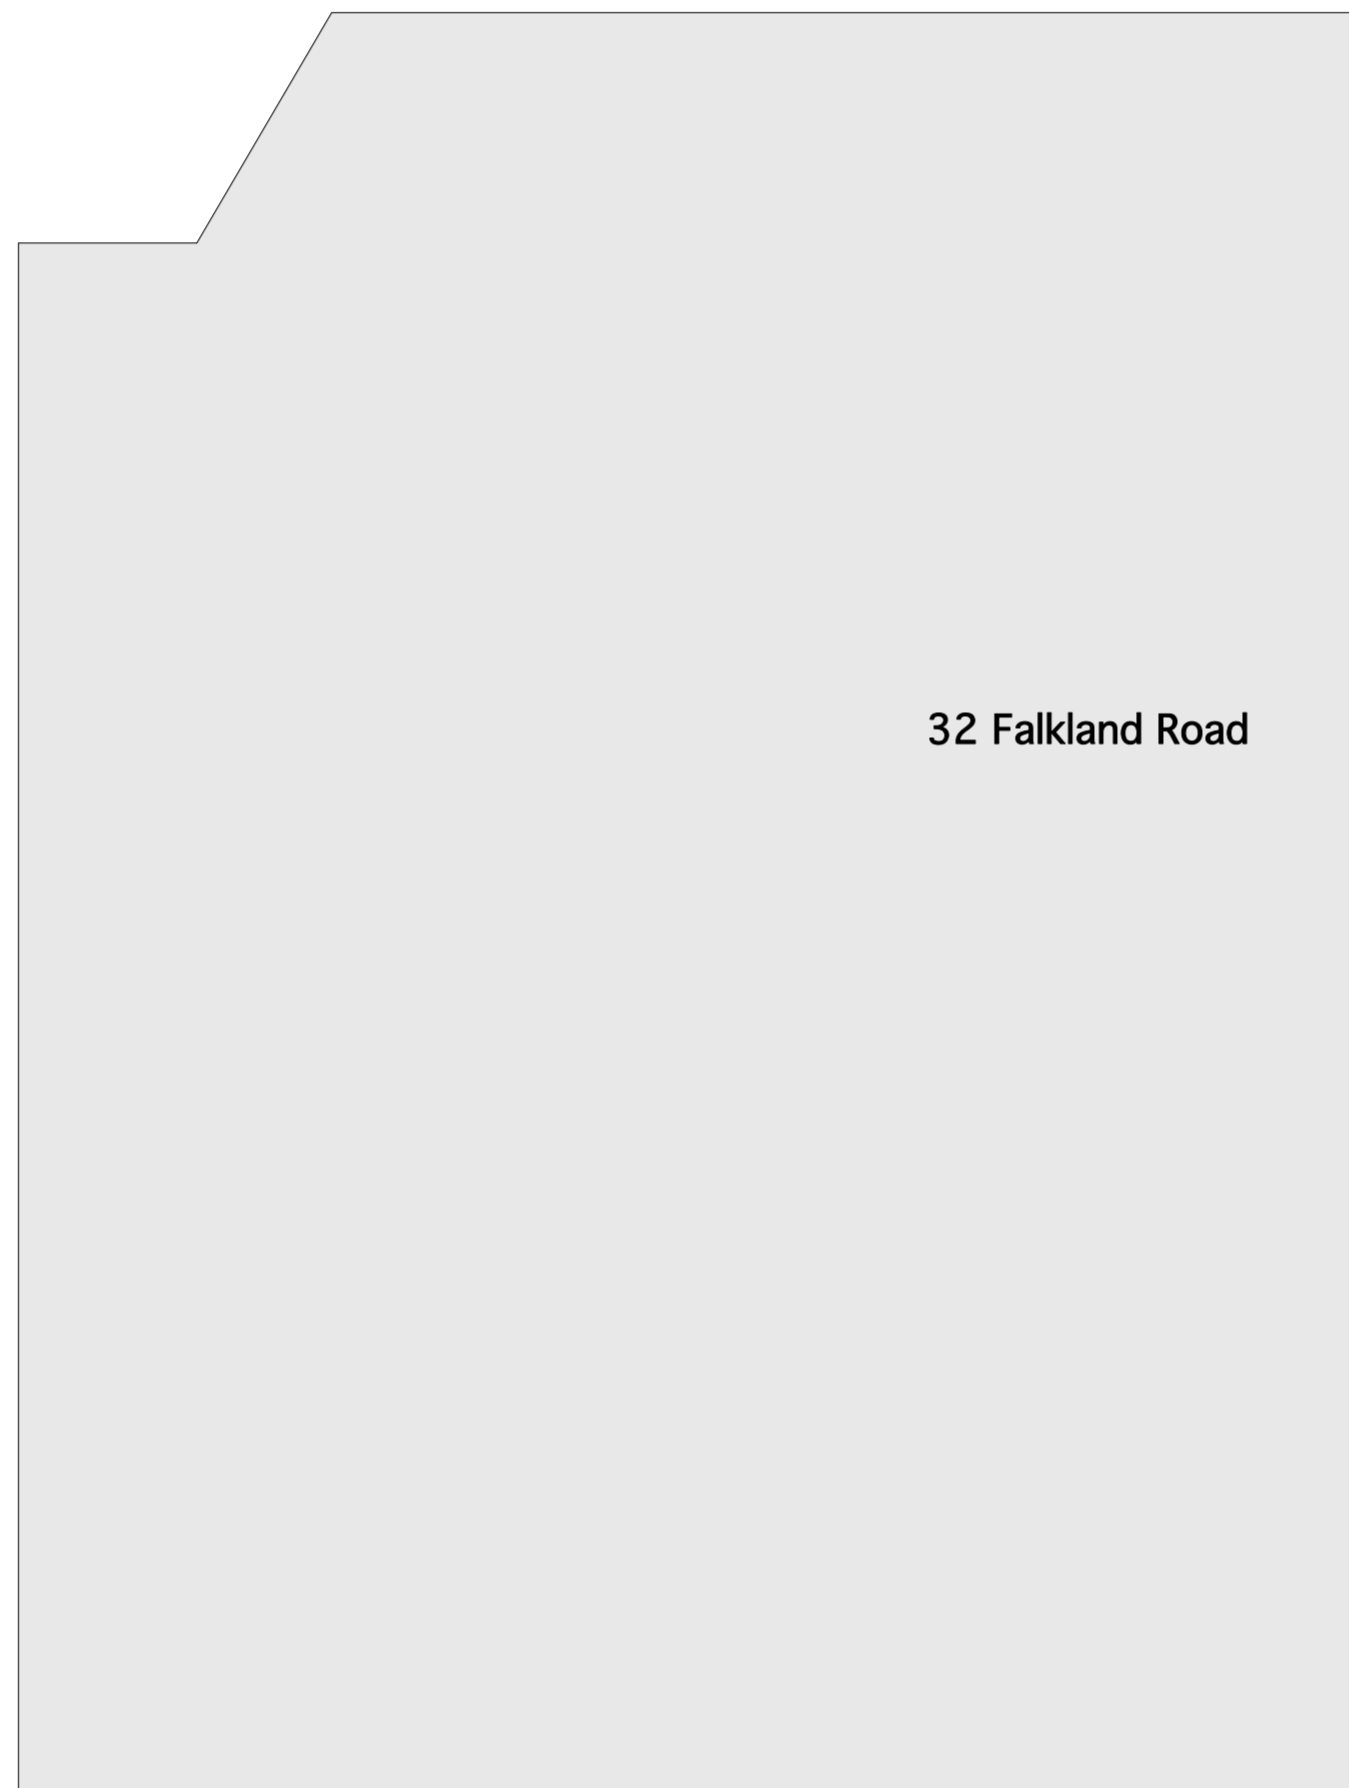

2FL Terrace Proposed West Elevation

REV	DATE	DESCRIPTION	REV	DATE	DESCRIPTION	REV	DATE	DESCRIPTION
/	27.08.2012	PLANNING ISSUE						
A	18.10.2012	REVISIONS PRIVACY SCREEN						


 UK 6 FOURNIER STREET LONDON E1 6DE T UK +44 (0)75 51 656 431 E INFO@SIR-S.NET
 A STUCKGASSE 3/3 A-1070 WIEN T A +43 (0) 680 250 80 25 W WWW.SIR-S.NET

32 FALKLAND ROAD, NW5 2PX, CAMDEN COUNCIL DRAWN **MI** CHECKED **MI**
 PROPOSED WEST ELEVATION 1:50 © **A2**
 PLANNING ISSUE ISSUE DATE **18.10.2012** 1205 GA 504 REV **A**