



# General Works:

1. Undertake brickwork repointing to areas as indicated by reference BR.
2. Undertake stonework repairs to areas as indicated by reference SR.
3. Prepare and redecorate all existing handrails as indicated by reference DH.
4. Overhaul hoppers, rain water pipes and refix all loose downpipe brackets, to all rainwater goods referenced RWP.
5. Stained brickwork and stonework is to be carefully cleaned beneath all eills and gutter clips to this elevation.
6. Replace light bulbs to all external lights to make fully operational.
7. Prepare and re-stain all existing timber doors as indicated by reference SD.
8. Remove parapet coping to level 4, renew DPC and rebed coping stones (indicated in red, labelled PCR).
9. Clean steps and repair stonework to main entrance steps (Elevation A).
10. Remove parapet coping stones to moat wall, renew DPC and rebed coping stones (Allow for 50% new coping stones and 50% existing).

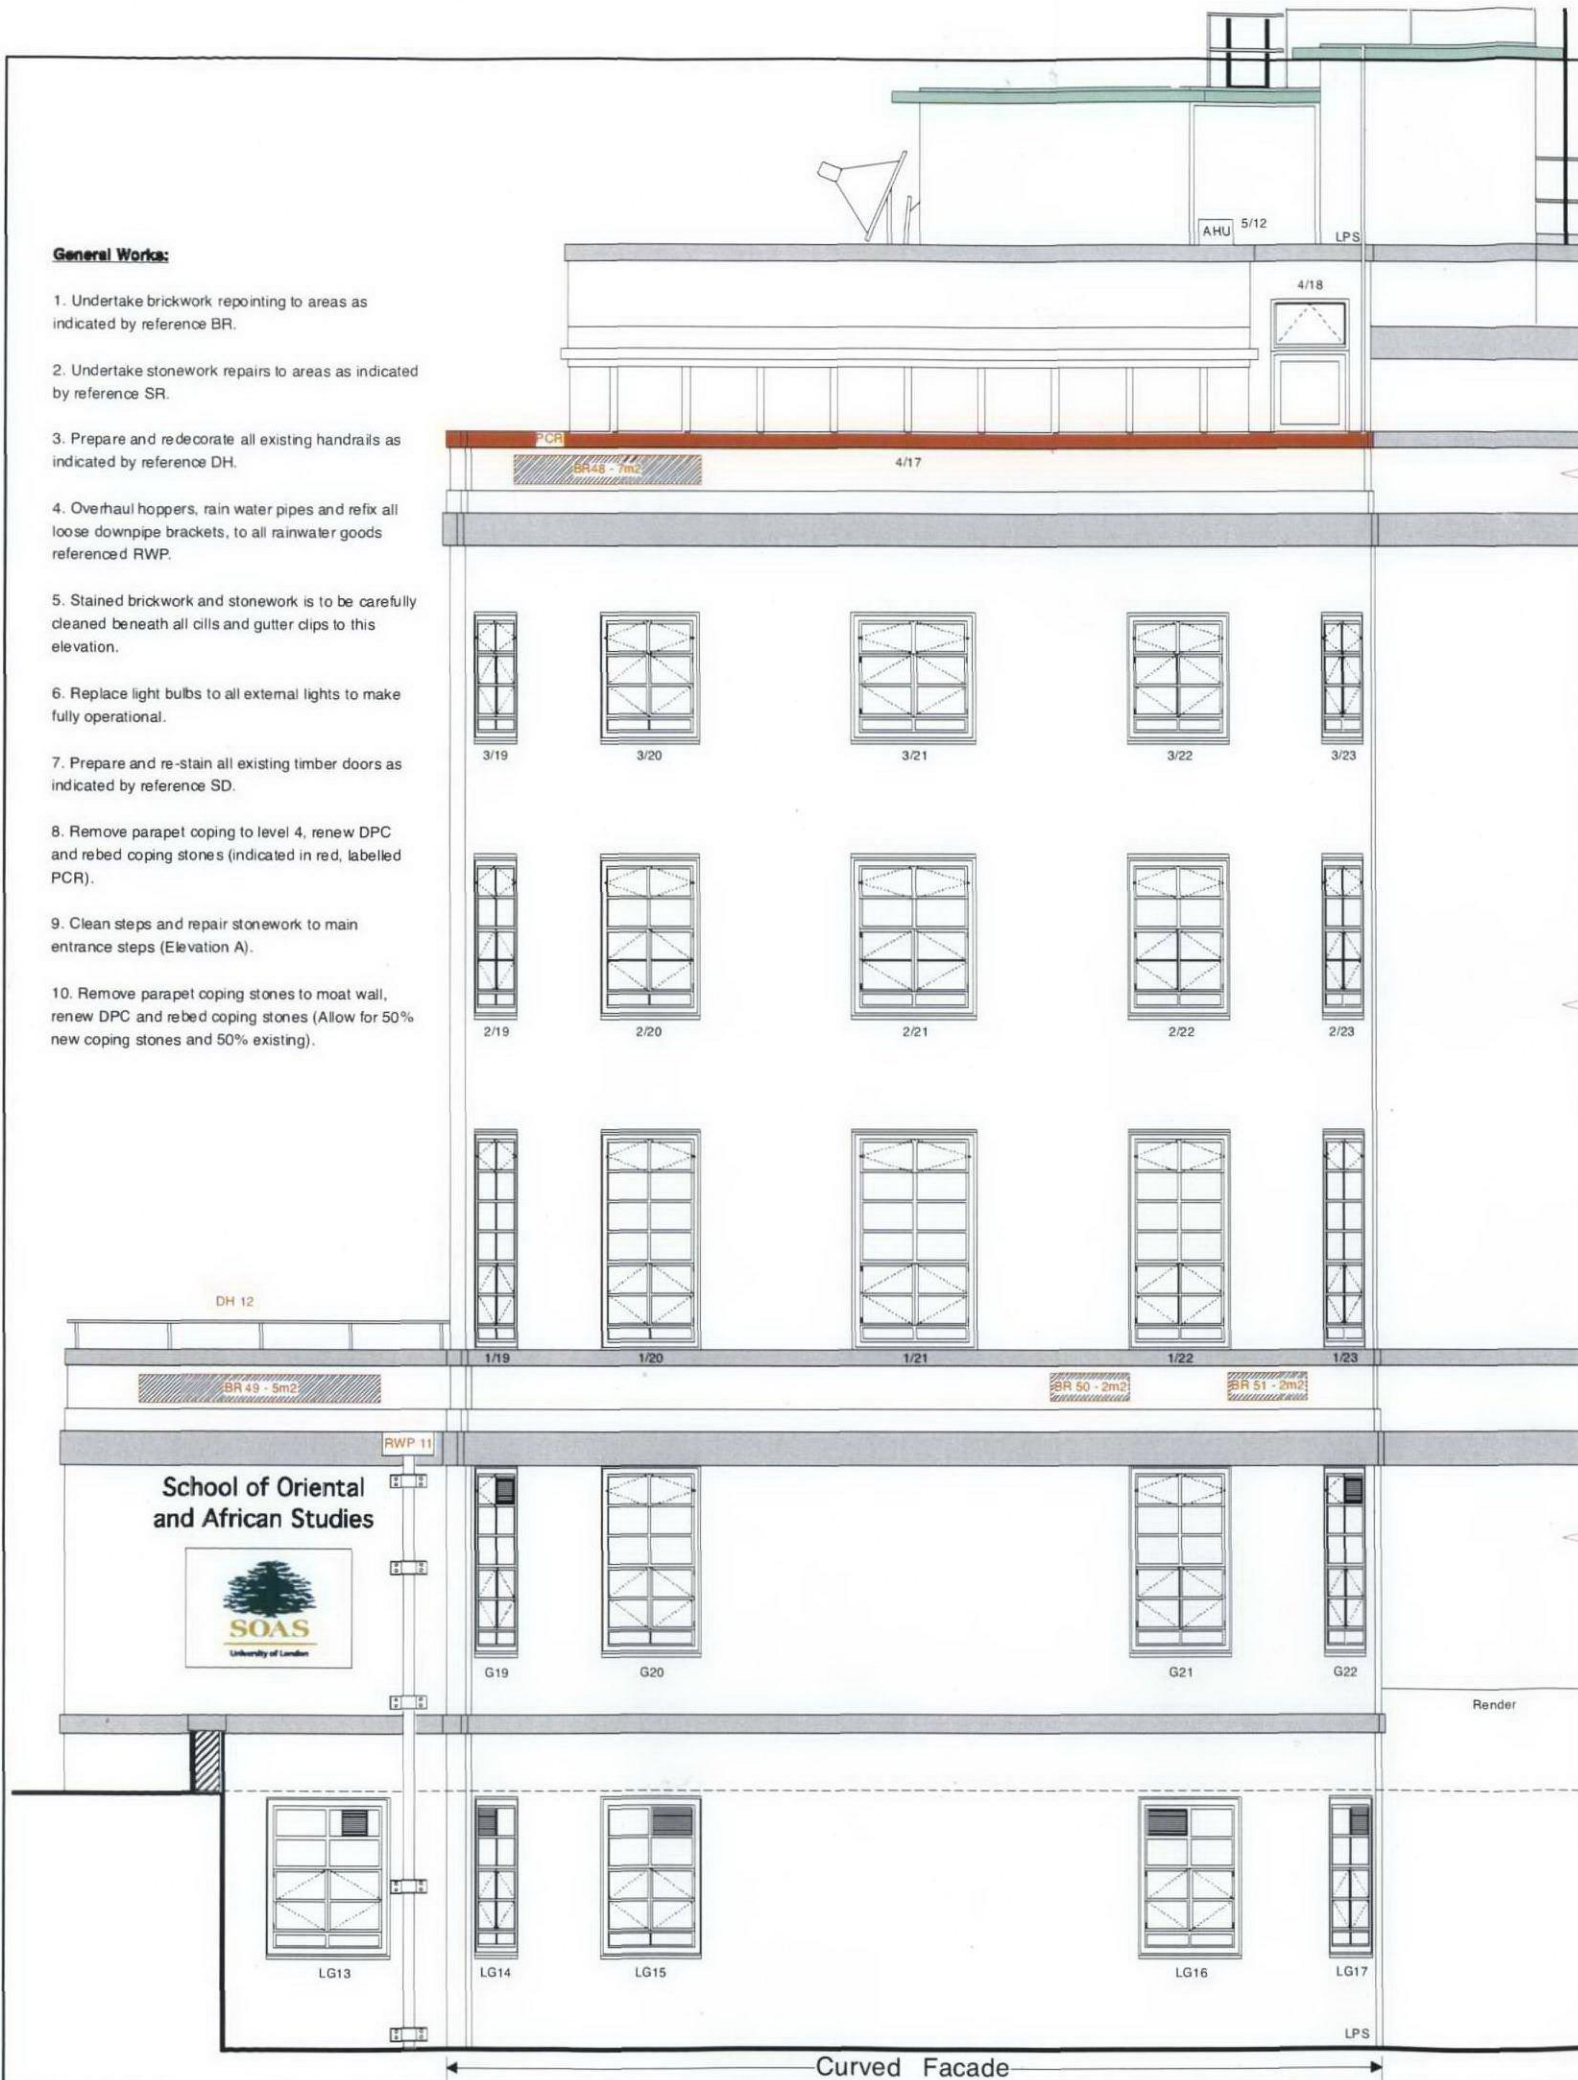

View H & J

0 1 2 3 4 5 6 7 8 9 10 metres

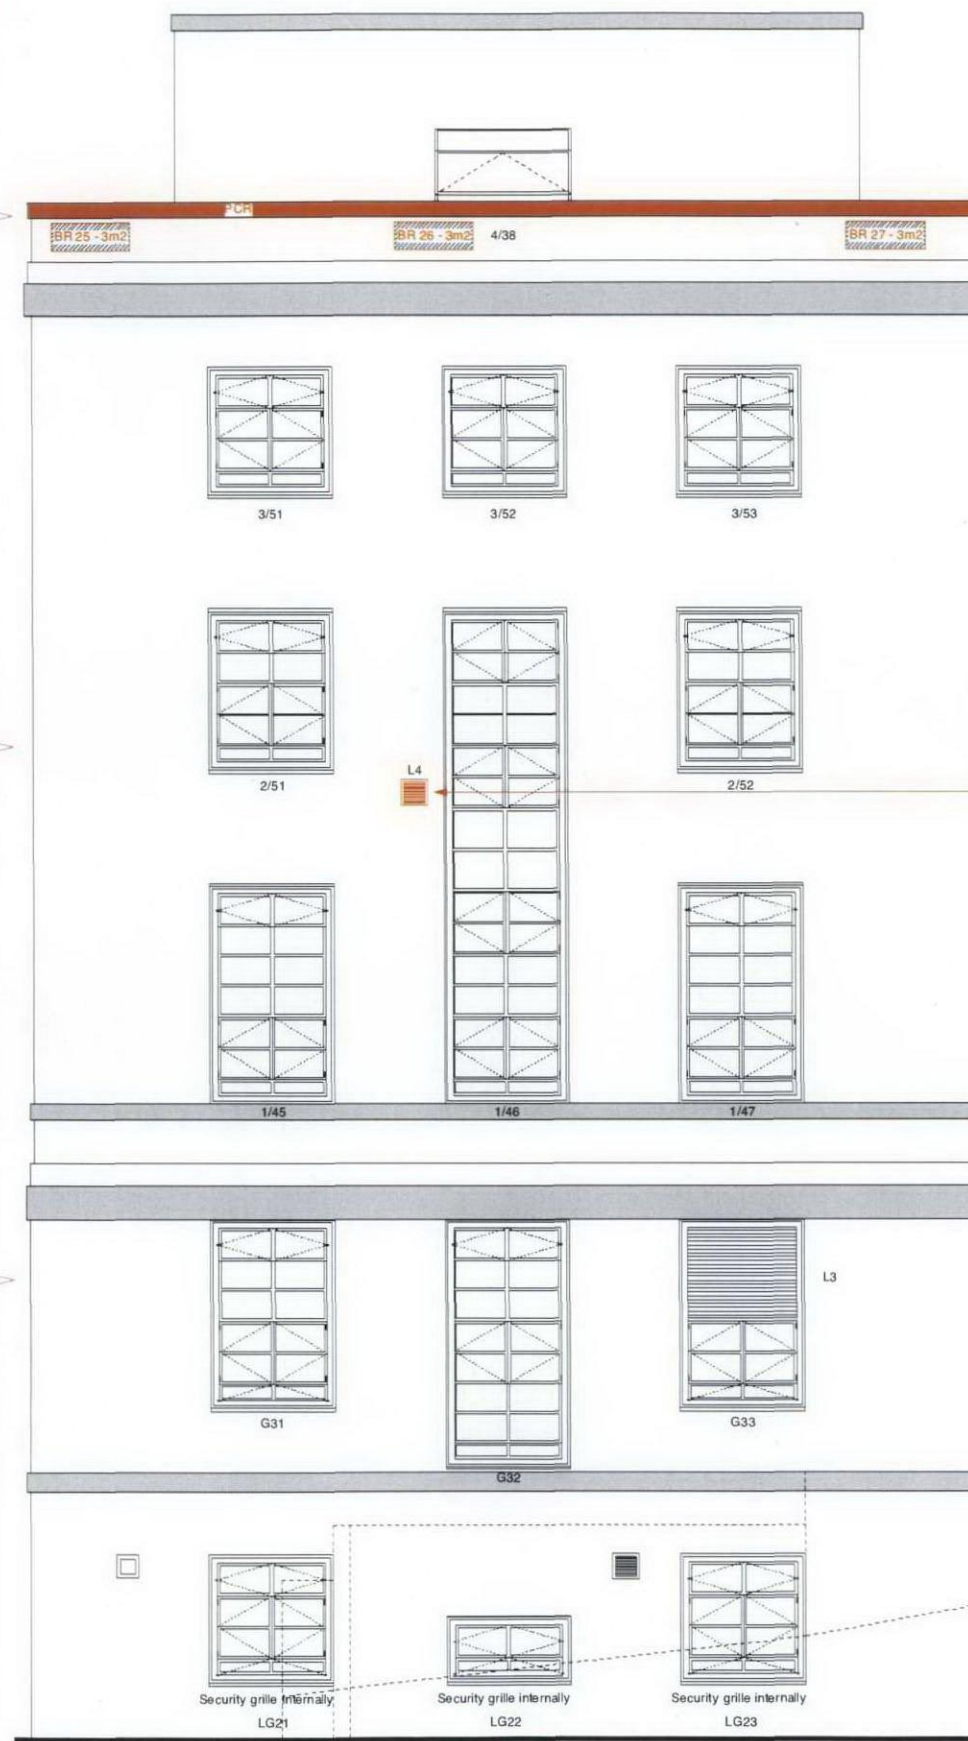


View C

Copyright.  
Do not scale this drawing.  
Check all dimensions and levels on site. Only to be used on the site for which designed. The electronic transmission of designs/information contained in this drawing is carried out entirely at the User's risk and Kendall Kingscott Ltd. will have no liability for any errors or inaccuracies arising therefrom. The production of amended or updated information from the said designs/information by the User is entirely the responsibility of the User and Kendall Kingscott shall have no responsibility in respect thereof whatsoever.

Rev.	Date	Note

**NOTE:**  
DRAWING IS FOR ILLUSTRATIVE PURPOSES.  
DO NOT SCALE. ALL DIMENSIONS TO BE  
VERIFIED ON SITE

Install new dedicated vent outlet in masonry adjacent window and redirect existing duct to suit. New window not to feature vent in glazing

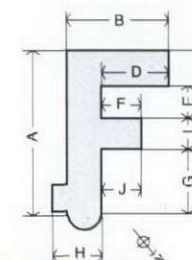

AS BUILT

Kendall Kingscott

Chartered Architects  
Chartered Building Surveyors  
Project Managers  
CDM Coordinators  
Sandford House  
1b Claremont Road  
Teddington  
Middlesex  
TW11 8DH  
T 020 8943 5300  
F 020 8977 0303  
www.kendallkingscott.co.uk

Project  
THE OLD BUILDING  
Refurbishment Of Windows  
Client  
SOAS  
Drawing Title  
Proposed Elevations  
Views C & H

CAD Ref: 1  
AS BUILT

080228 E(0)09G

Scale 1:50 @ A1  
Date July 2011  
Drawn JS  
Checked GC