

Copyright © 2011
 Draw all dimensions and details on this drawing to be used on the site for which designed. The electronic transmission of this drawing is for the use of the user only and is not to be used for any other purpose. The user is responsible for any errors or omissions in the drawing. The production of amended or updated information from this drawing is the responsibility of the user and the user shall have no responsibility in respect thereof.


No.	Date	Notes

NOTE:
 DRAWING IS FOR ILLUSTRATIVE PURPOSES.
 DO NOT SCALE. ALL DIMENSIONS TO BE
 VERIFIED ON SITE.




View A

0 1 2 3 4 5 6 7 8 9 10 metres

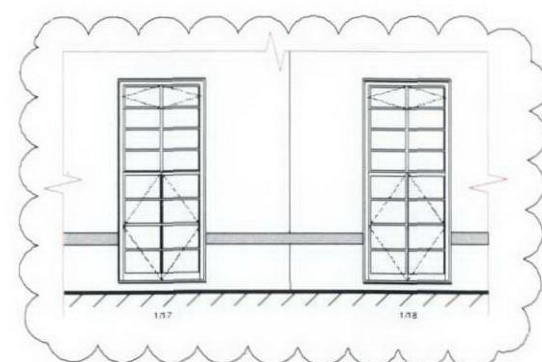

Full View of 1/17 & 1/18 Behind Terrace Wall

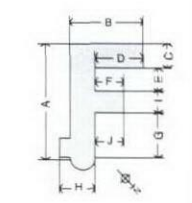

AS BUILT
Kendall Kingscott
 Chartered Architects
 Chartered Building Surveyors
 Project Managers
 CDM Coordinators
 Sandford House
 1b, Quincey Road
 Tadlington
 Middlesbrough
 TS11 5BN
 T: 020 8943 3300
 F: 020 8977 0300
 www.kendallkingscott.co.uk

THE OLD BUILDING
 Refurbishment Of Windows

Client: SDAS

Drawn by: AS BUILT

Existing Elevations
 View A

Scale: 1:50
 Date: Sept 2011

080228 E(0)01D

Scale: 1:50
 Date: Sept 2011