

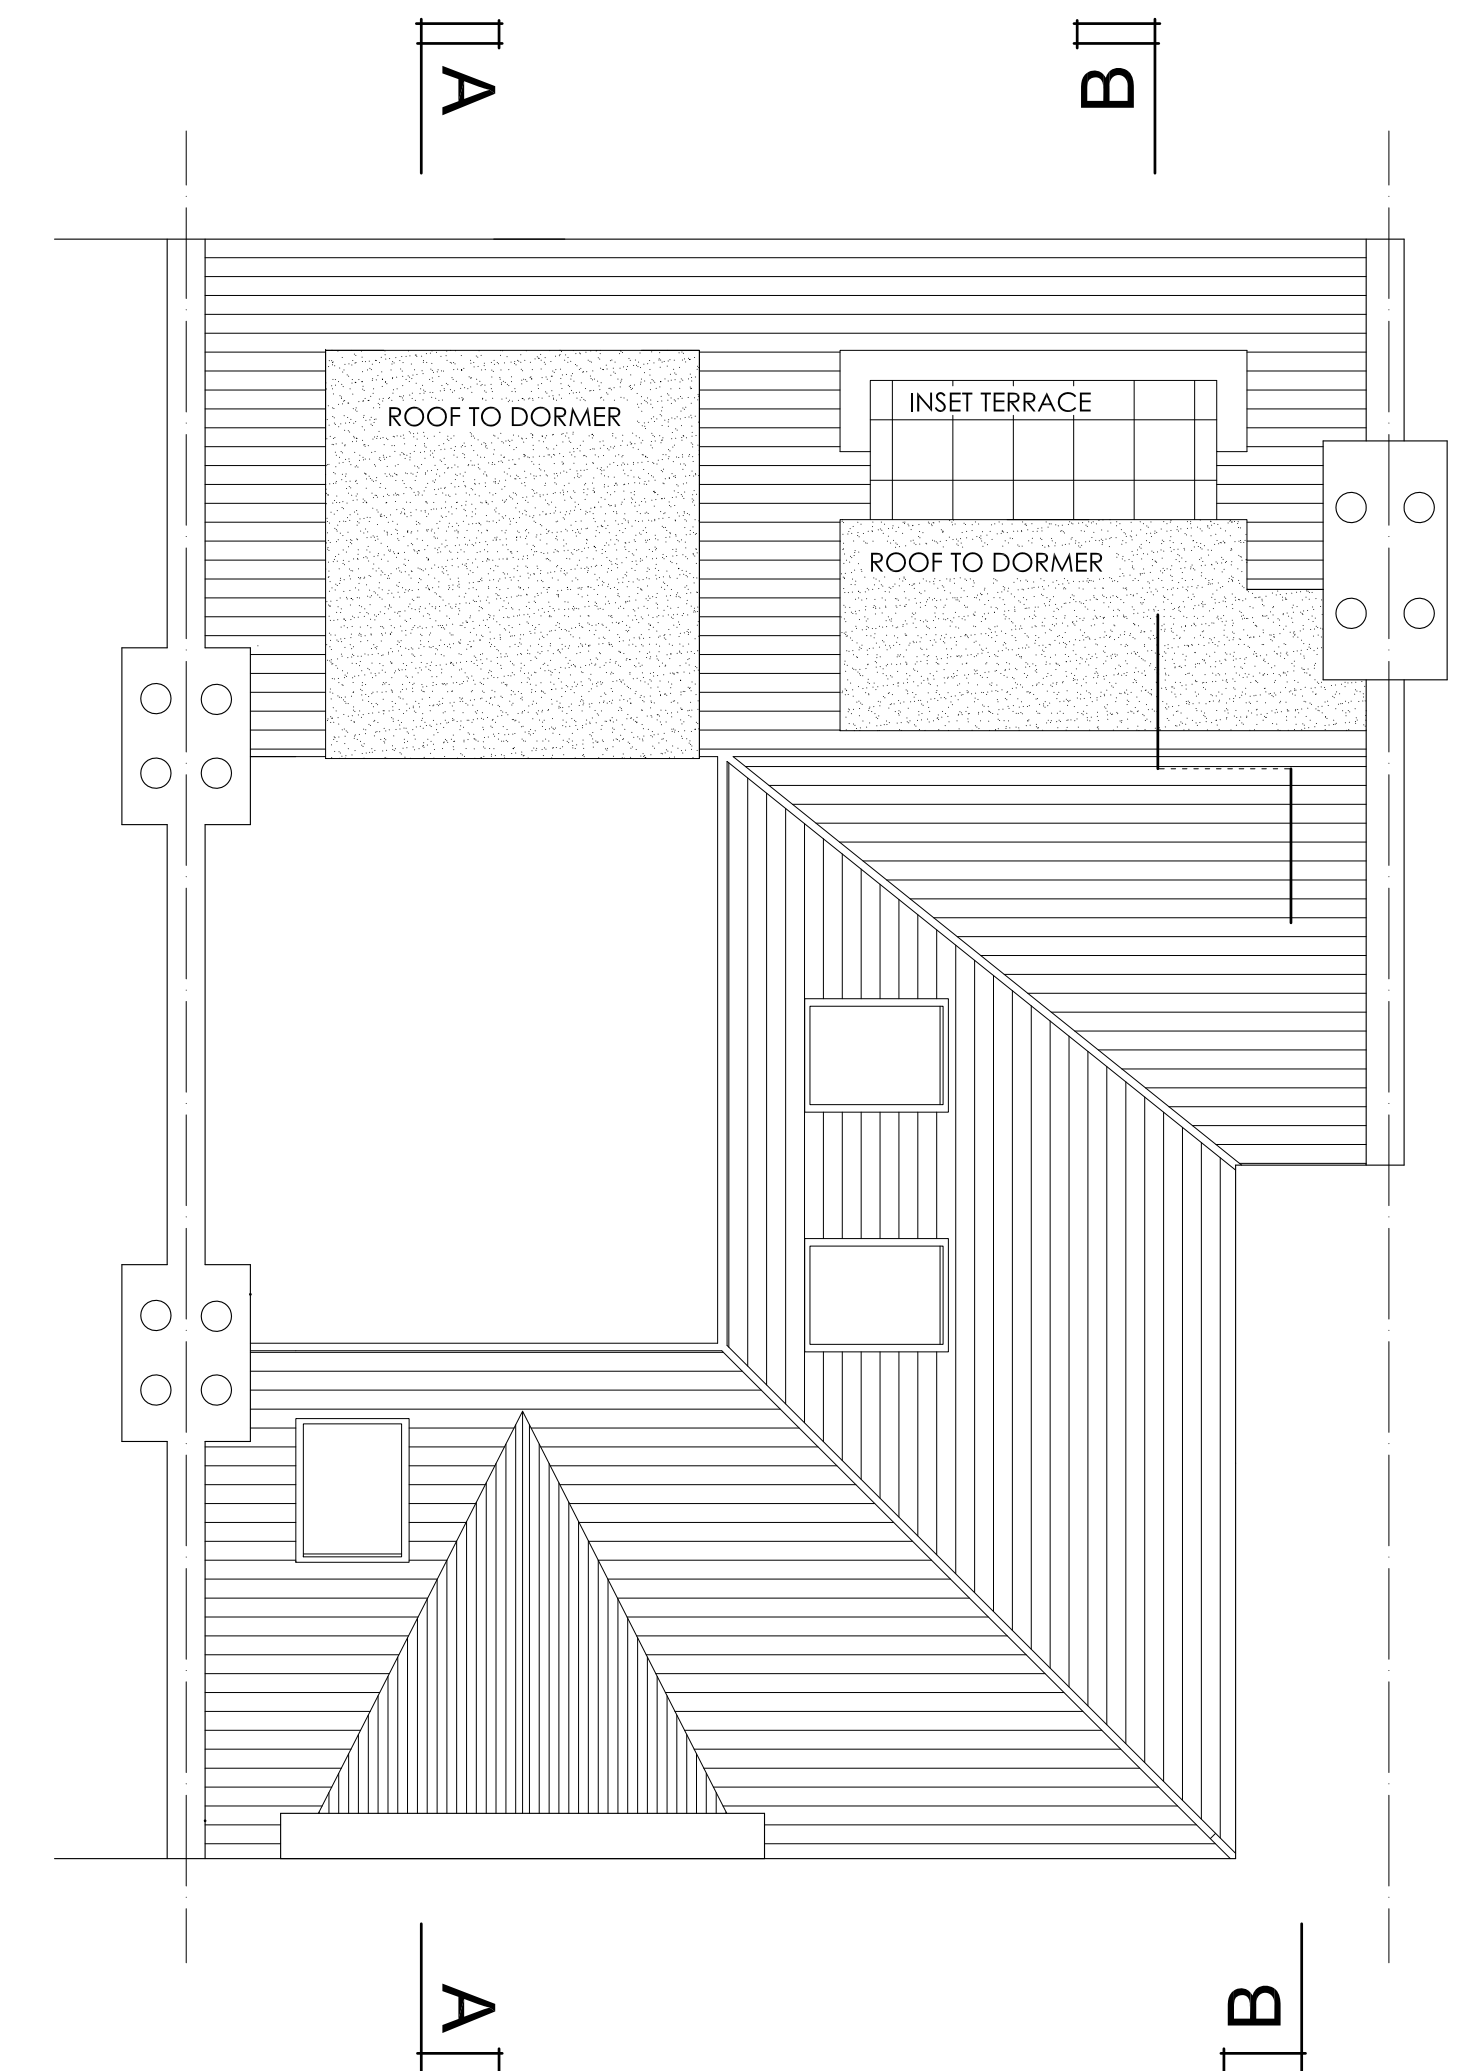
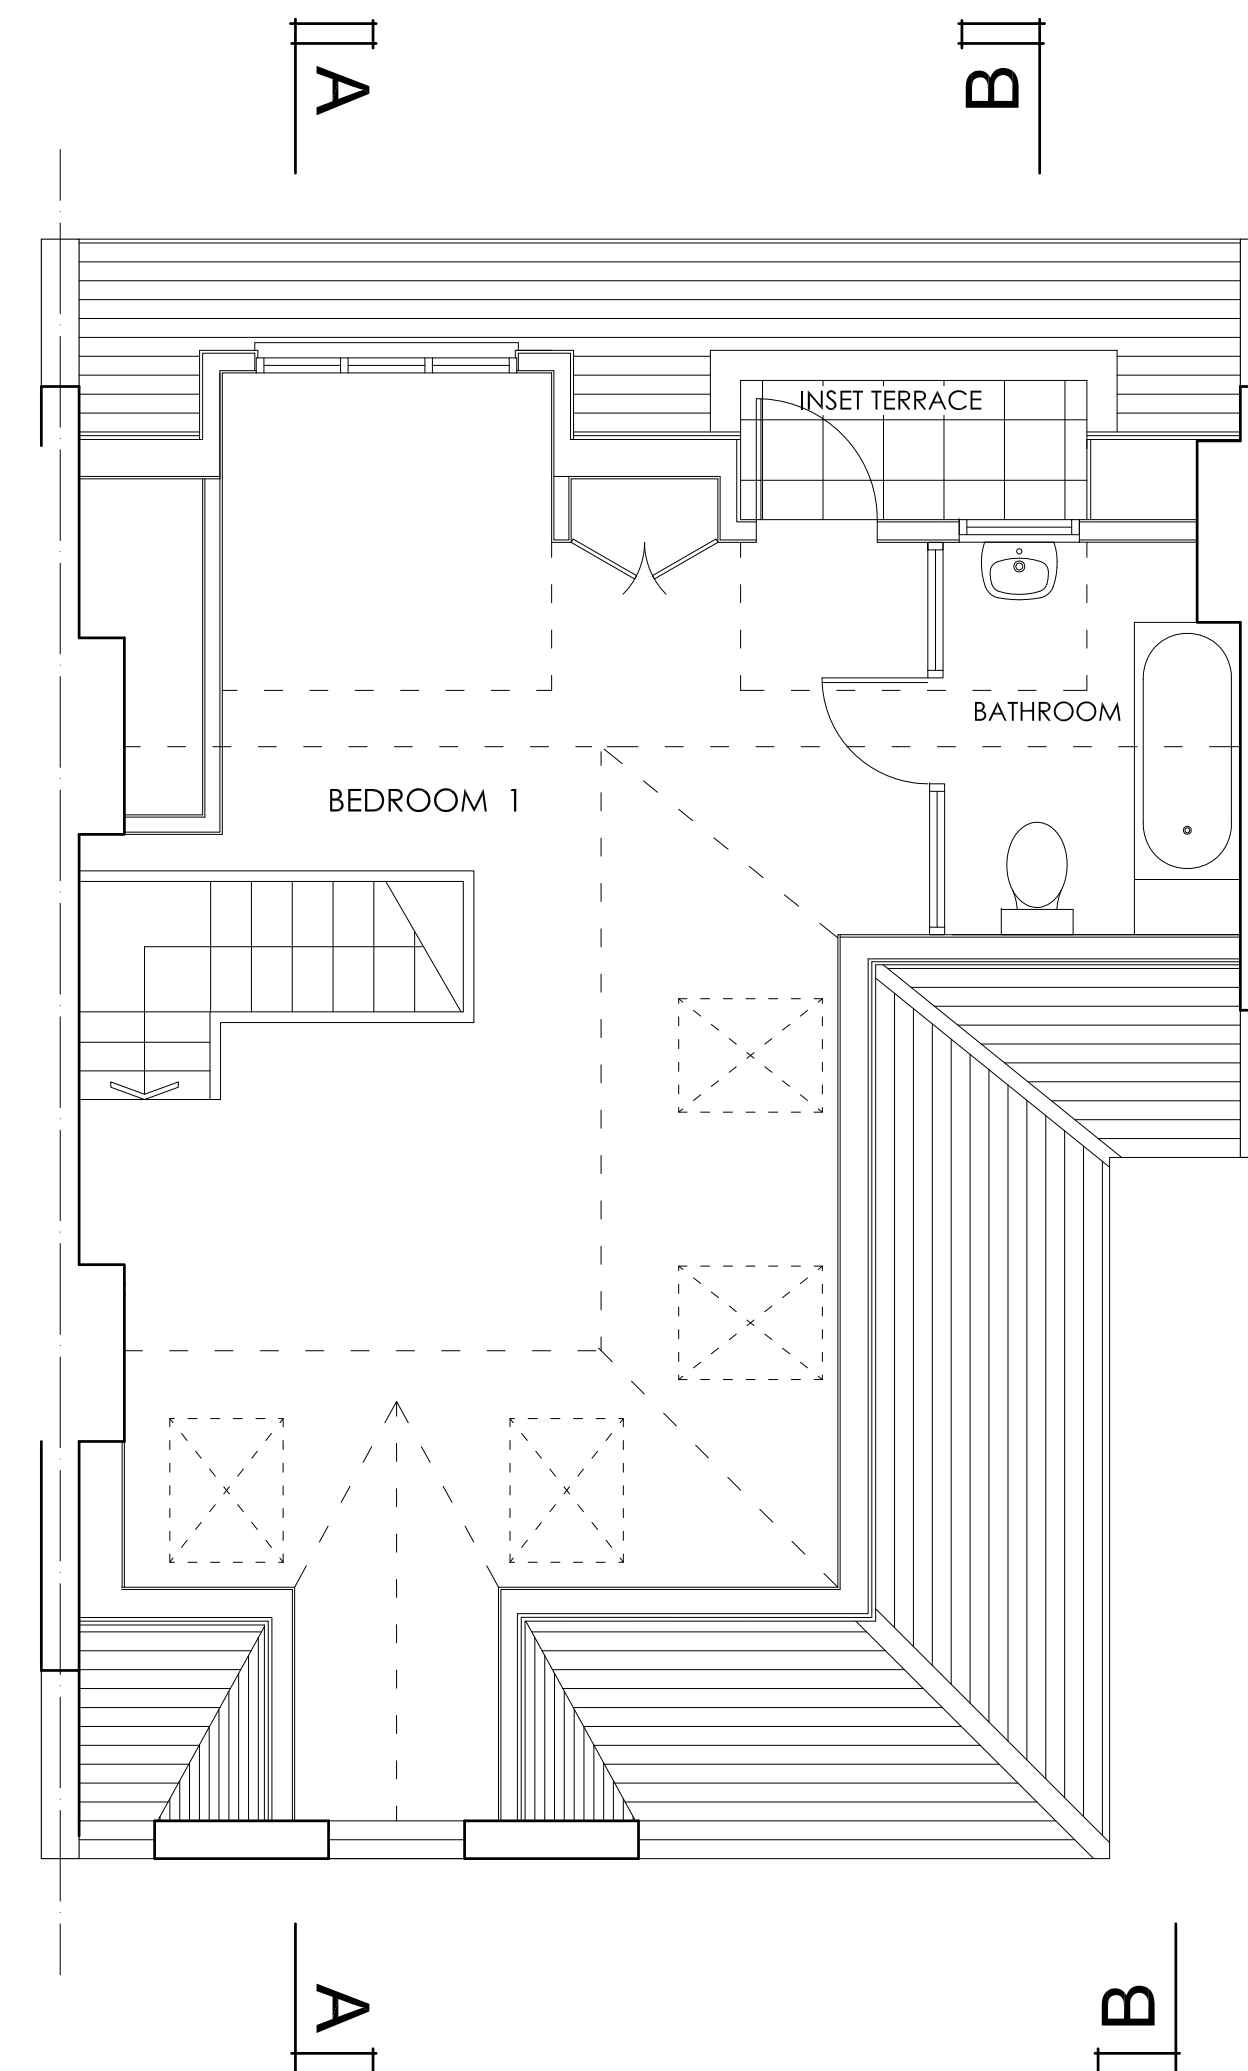
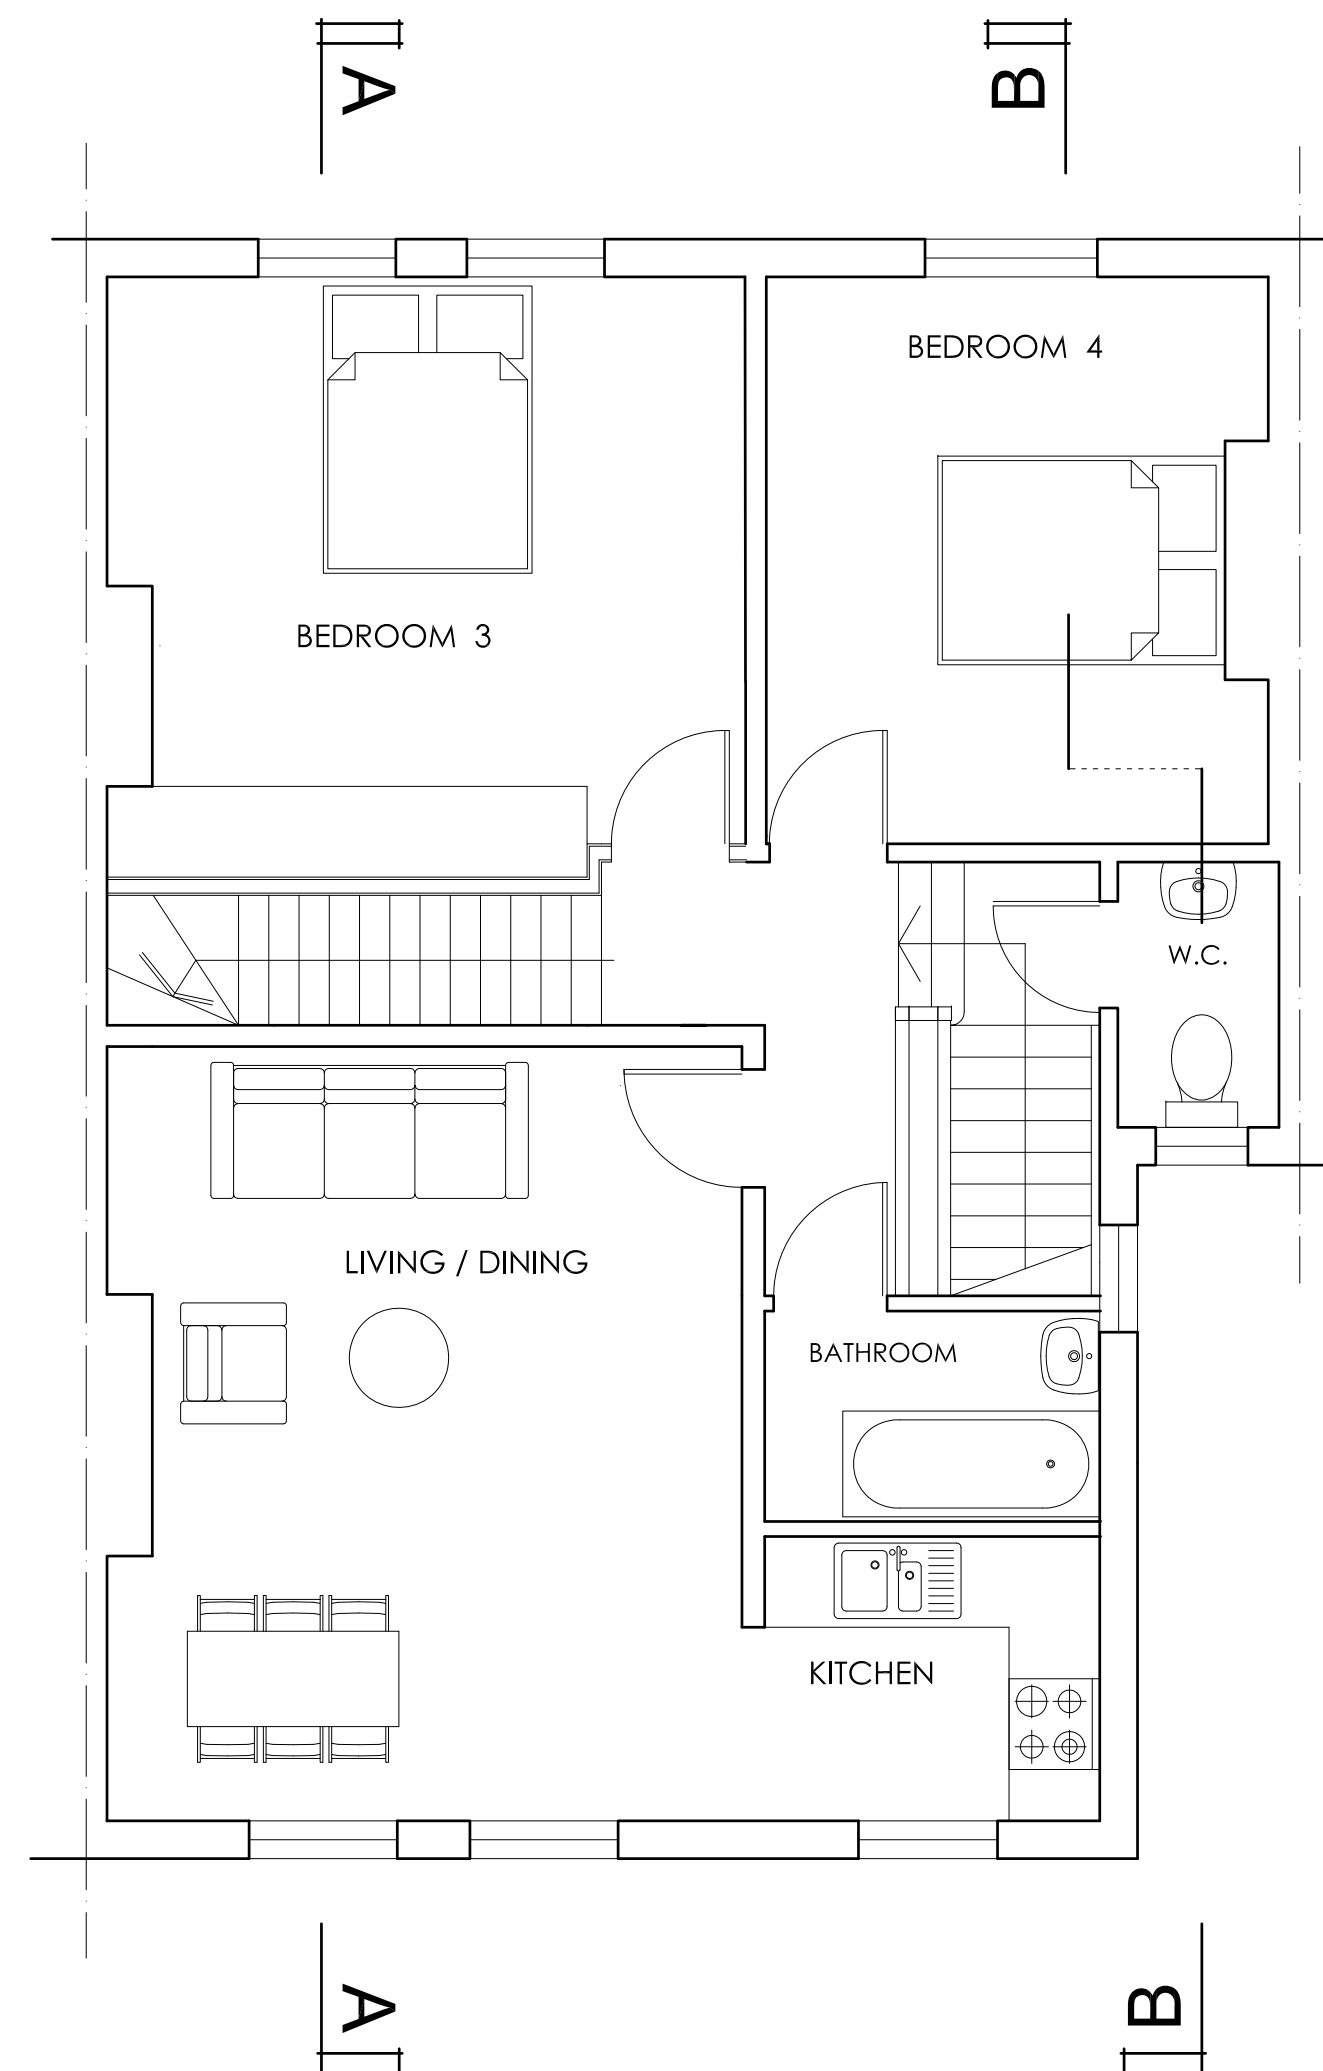


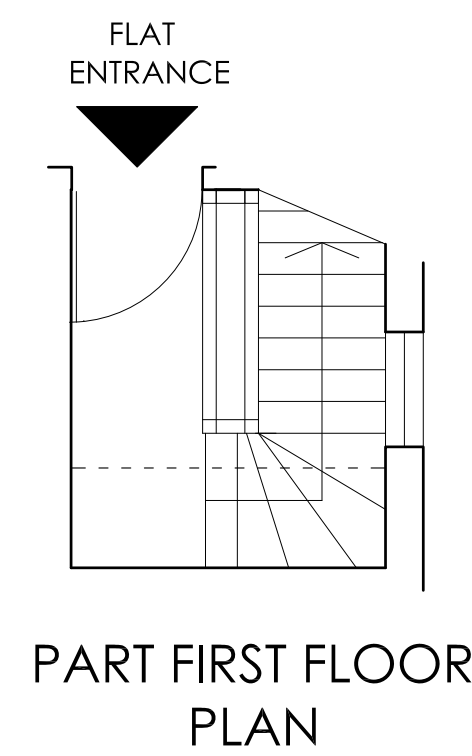

AS BUILT

REVISIONS		
Rev	Date	Detail
A	06-08-2012	DETAILS REVISED TO REFLECT WORKS AS BUILT.

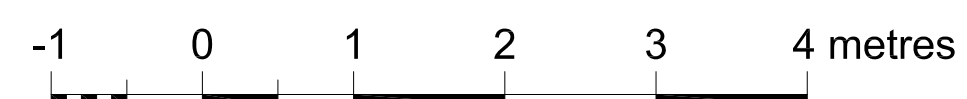

MICHAEL J LEES RIBA
20 KINGS AVENUE
LONDON N10 1PB
-
Tel . 020-8444-6197

Date : 27-07-2006

Drawn By : mjl

TITLE : PROPOSED LOFT CONVERSION
126 GOLDHURST TERRACE
WEST HAMPSTEAD NW6 3HR

Scale : 1:50 (A1)
1:100 (A3)

Revision : A

DRAWING : PLANS - AS BUILT

Drwg No. : 0617-11