


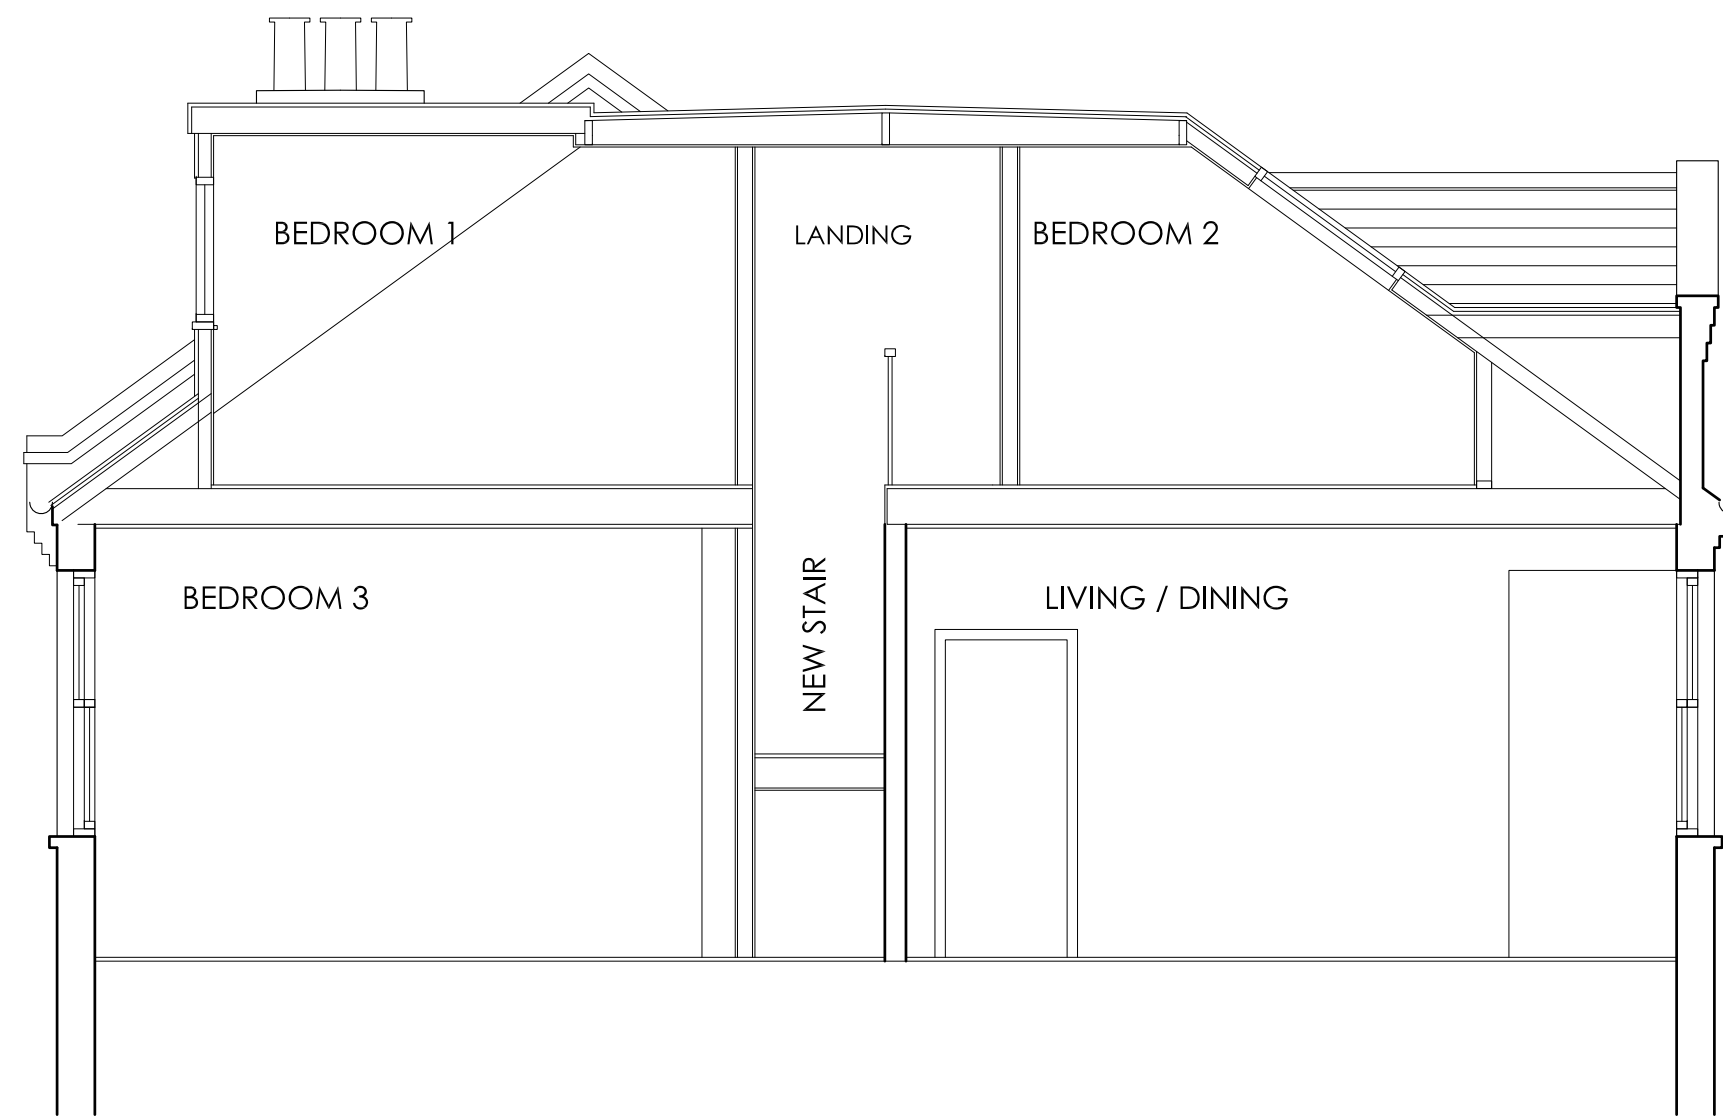

SECTION A-A


CONSERVATION TYPE ROOF
WINDOW FITTED IN REFURBISHED
SLATE ROOF



FRONT ELEVATION

AS BUILT


CONSERVATION TYPE ROOF
WINDOWS FITTED IN
REFURBISHED SLATE ROOF

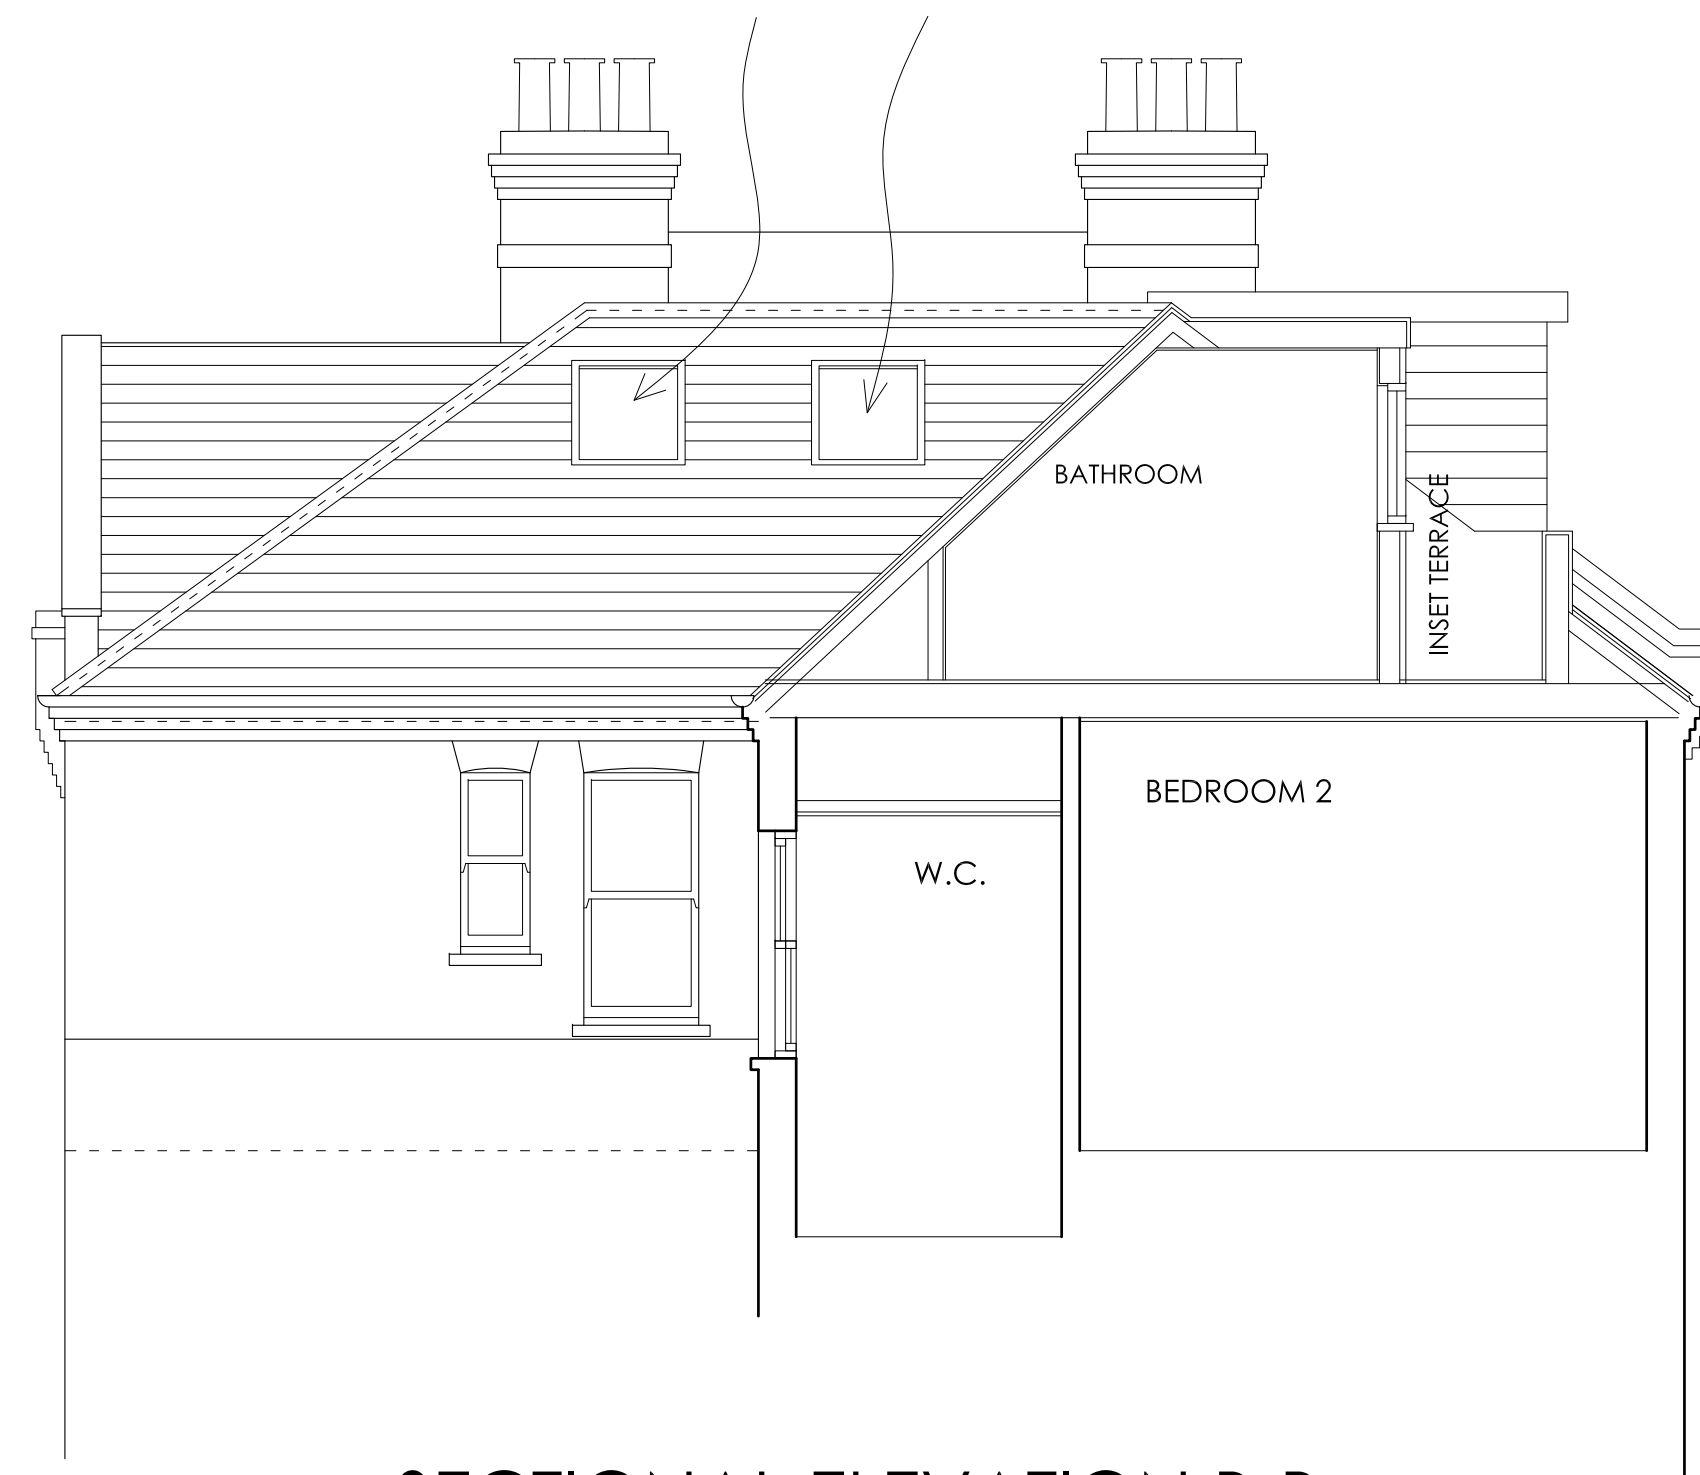

SECTIONAL ELEVATION B-B

DORMER WINDOW WITH
CASEMENT WINDOW, ACCESS
DOOR AND IMITATION SLATE
CLADDING

UPSTAND TO PERIMETER OF
INSET TERRACE.

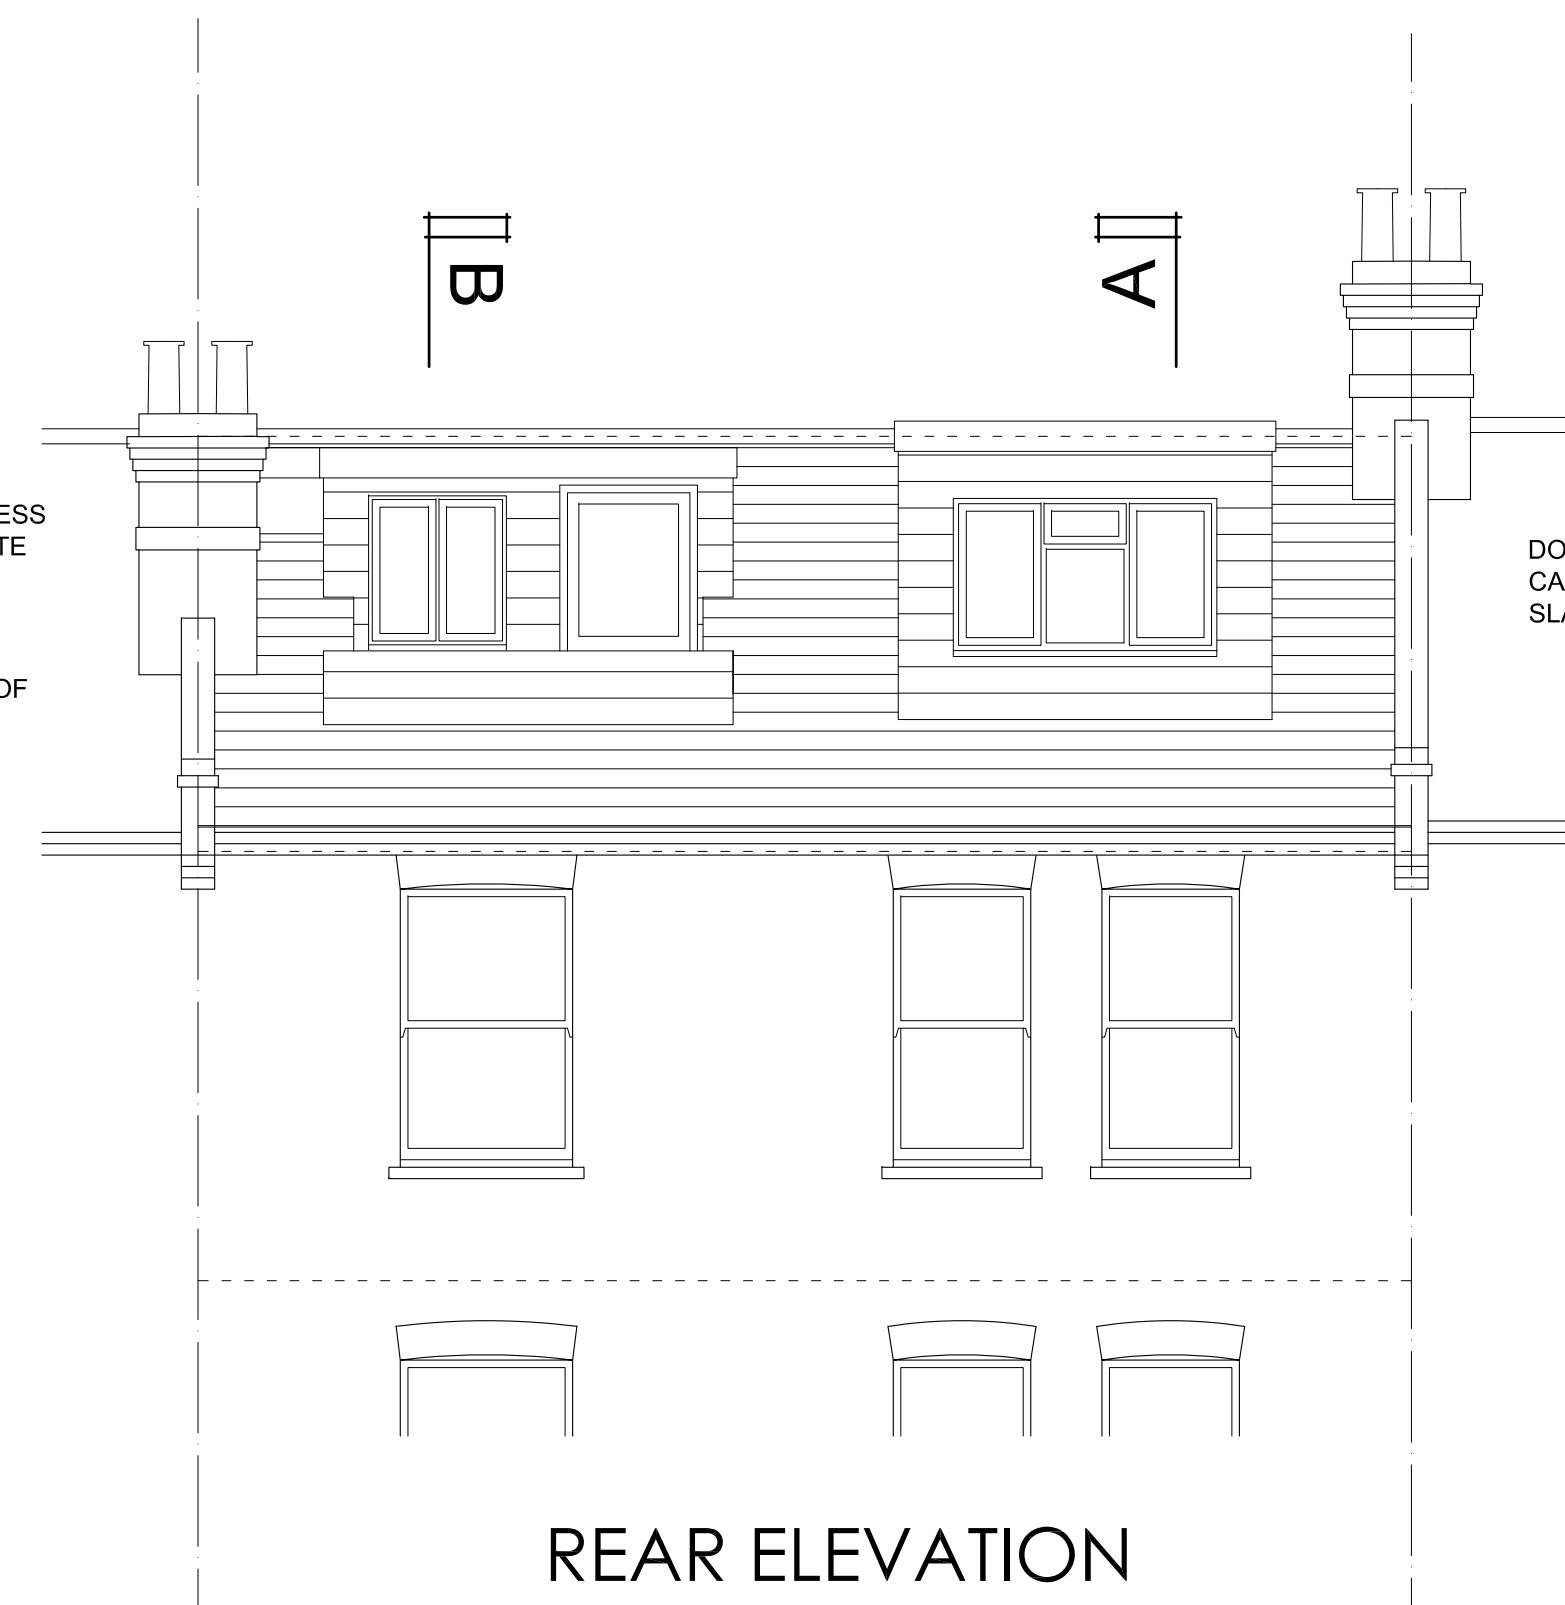

REAR ELEVATION

DORMER WINDOW WITH TIMBER
CASEMENT WINDOW AND IMITATION
SLATE CLADDING

REVISIONS		
Rev	Date	Detail
A	06-08-2012	DETAILS REVISED TO REFLECT WORKS AS BUILT.

-1 0 1 2 3 4 metres

MICHAEL J LEES RIBA
20 KINGS AVENUE
LONDON N10 1PB
Tel . 020-8444-6197

Date :
27-07-2006

Drawn By :
mjl

TITLE :
PROPOSED LOFT CONVERSION
126 GOLDHURST TERRACE
WEST HAMPSTEAD NW6 3HR

Scale :
1:50 (A1)
1:100 (A3)

Revision :
A

DRAWING :
ELEVATIONS AND SECTIONS
AS BUILT

Drwg No. :
0617-12