


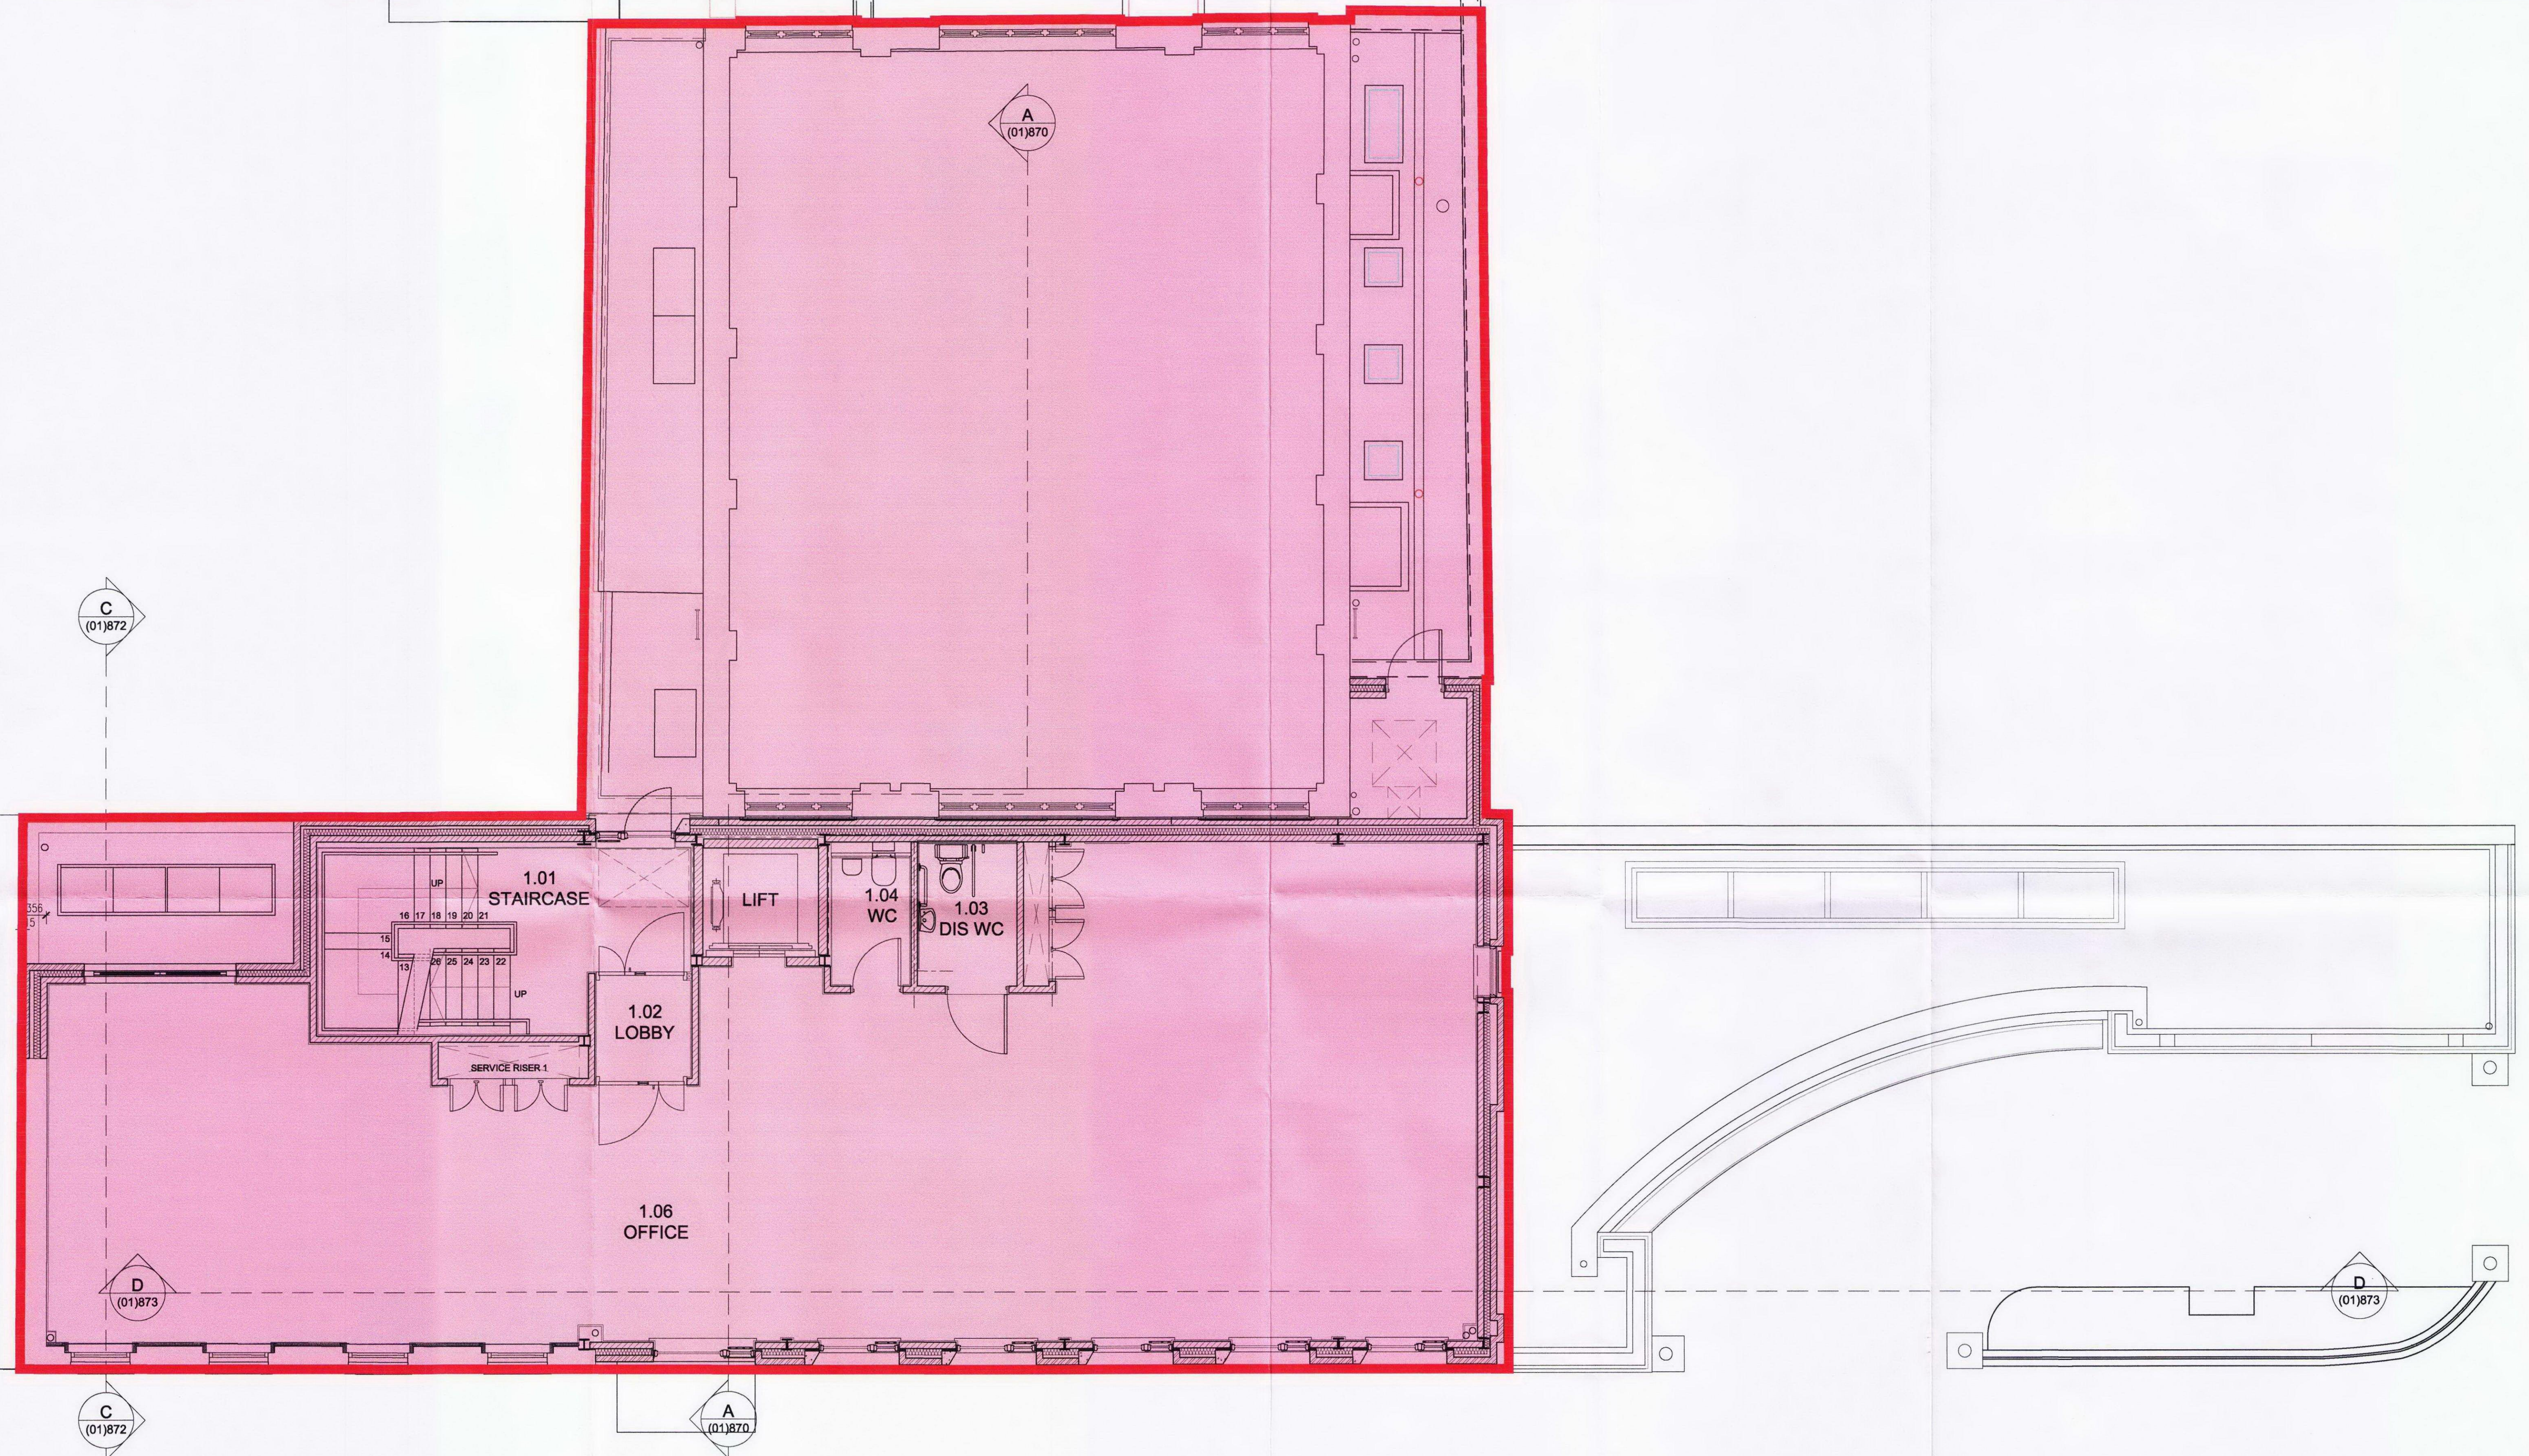

indicates the subject of this application

REV	ISSUE DATE	REVISION NOTES
	23.12.11	Issued for information. (Based on (01)851 rev A)
GENERAL NOTES Do not scale. All written dimensions must be checked on site before work commences on site or in shop. Figured dimensions take preference over those scaled. Discrepancies, where identified, must be reported to the Architect immediately. Any areas indicated on this drawing are for guidance purposes only. No responsibility is taken for their accuracy. All work must be carried out in accordance with the Building Regulations and to the satisfaction of the Local Authority.		
REV	ISSUE DATE	REVISION NOTES

STATUS

CONSTRUCTION

Garnett+Partners LLP
Holborn Hall
195 High Holborn
London WC1V 7BD
Tel. +44 (0)20 7404 7677
Fax. +44 (0)20 7404 6648
mail@garnettpartners.com
www.garnettpartners.com

architects / planners / designers

**GARNETT
+PARTNERS**

CLIENT
The Bedford Estates

PROJECT
**2-8 Ridgmount Street &
6 Store Street**

DRAWING TITLE
**First Floor Plan
as built**

SCALE
1:50@A1 1:100@A3

DATE
December 2011

JOB NO.
677

DWG NO.
(01)661

REV.
-