


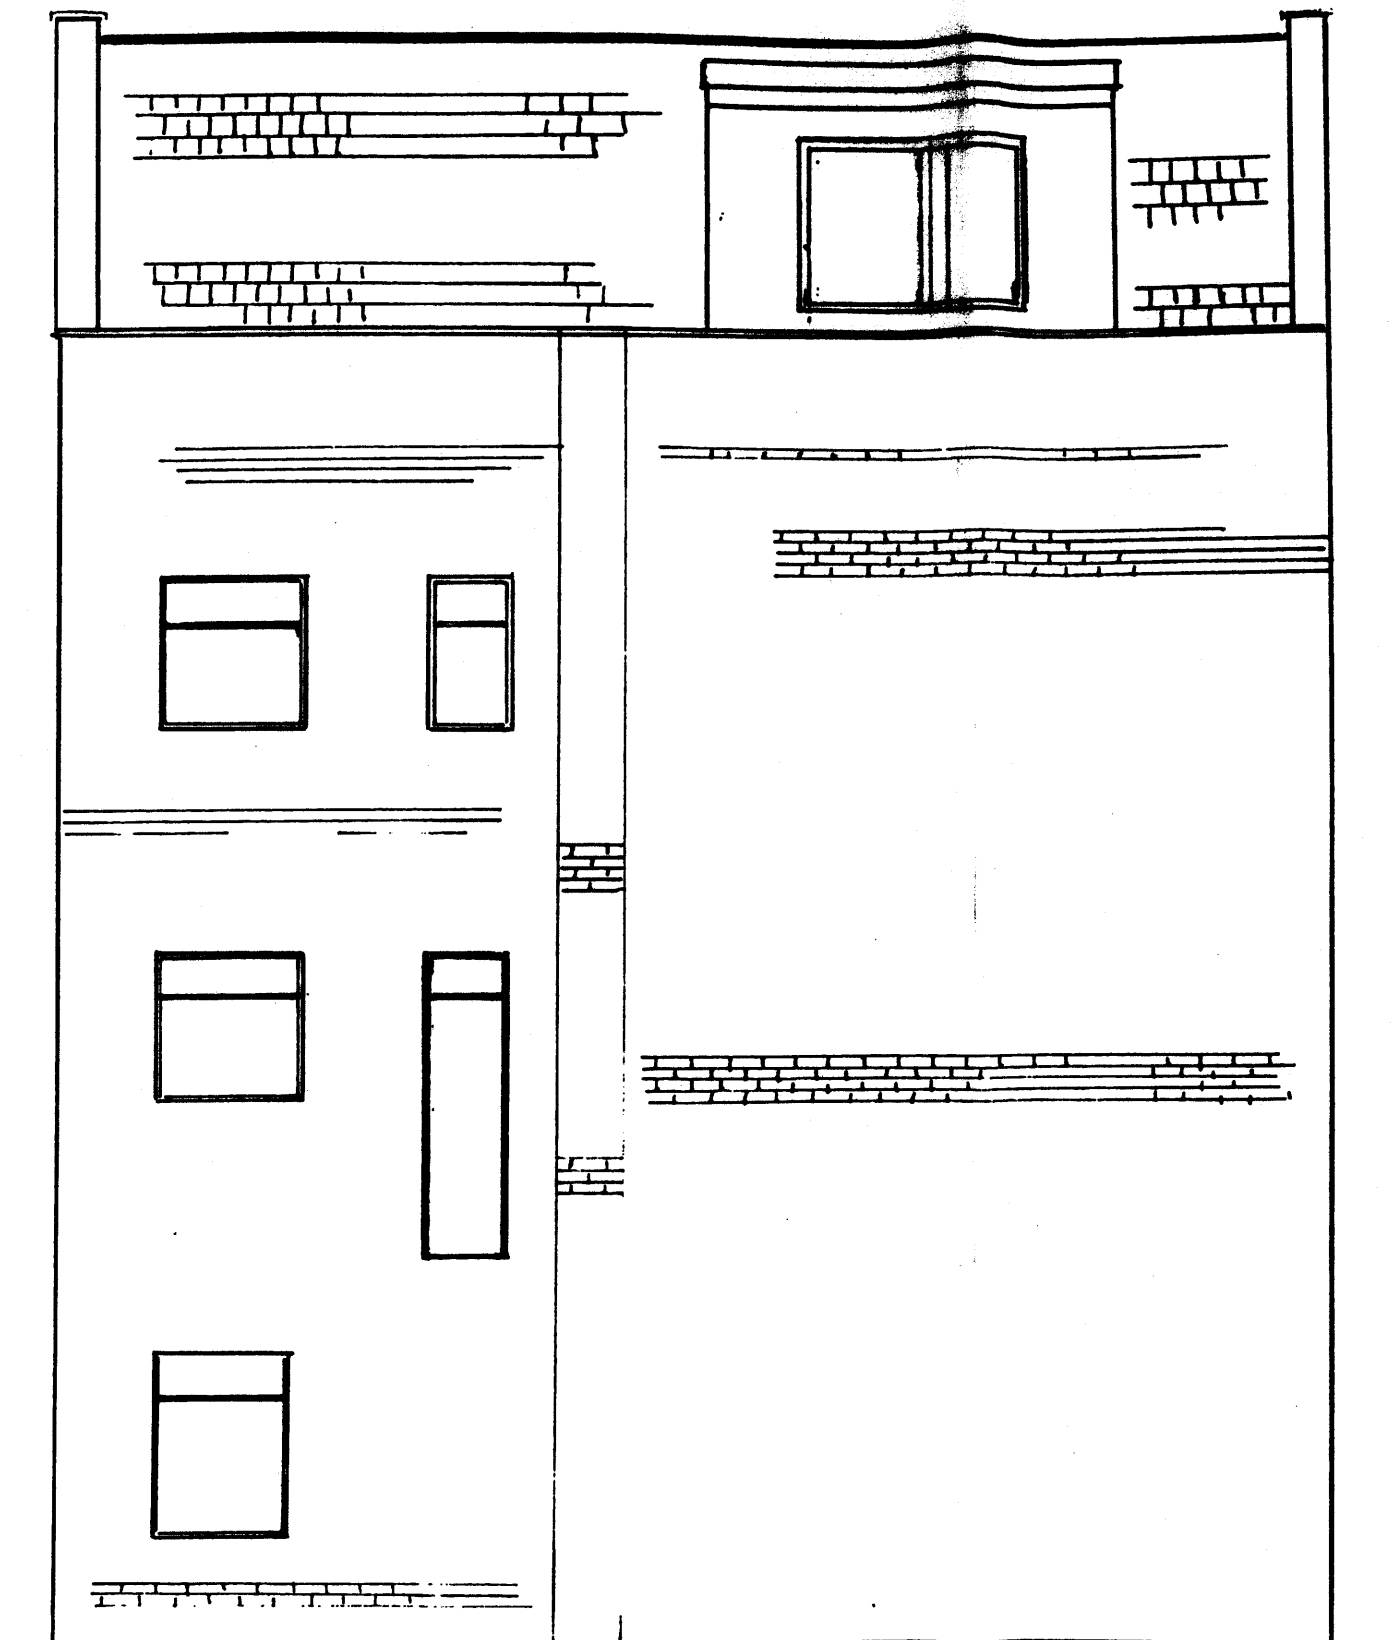

SOUTH WEST ELEVATION /REAR/

SCALE 1:50

1 THE VILLAGE NORTH END WAY
HAMPSTEAD
LONDON NW3 7HA
ELEVATION AS CONSTRUCTED

DRWG. No 24