


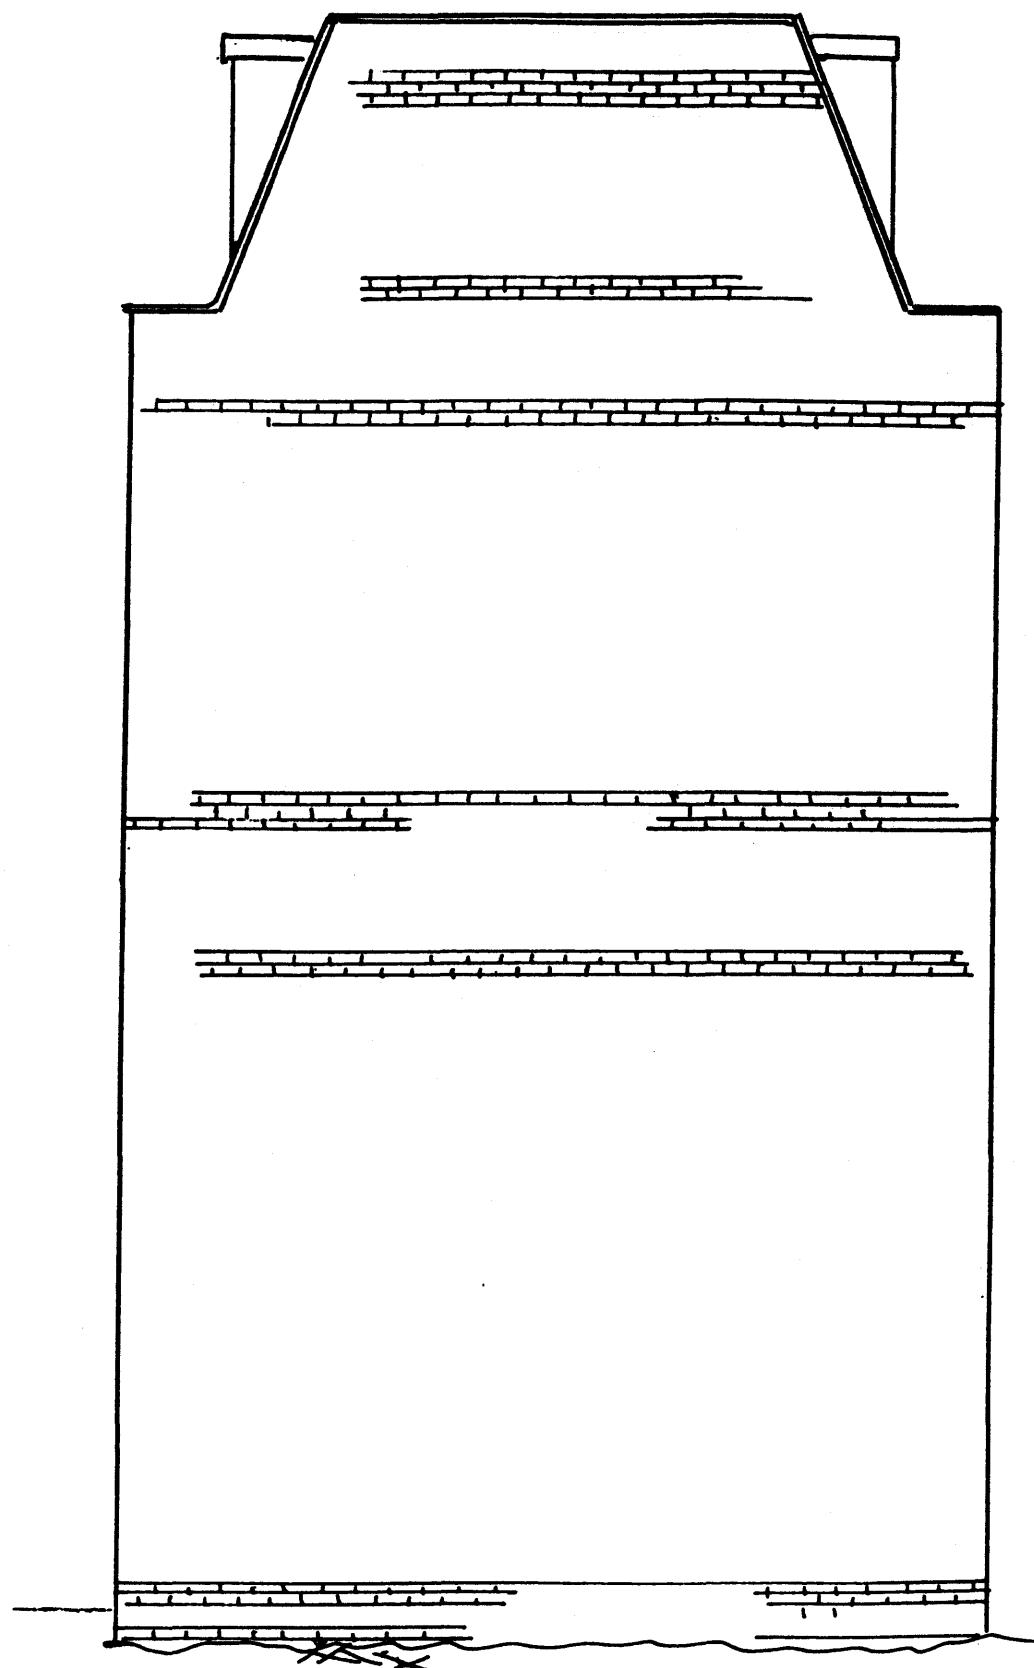

PAVEMENT

NORTH WEST ELEVATION /SIDE/ SCALE 1:50

THE VILLAGE WAY
HAMPSTEAD
LONDON NW3 7HA
ELEVATION AS CONSTRUCTED

DRWG. No. 25