



Please Note:
 Dimensions are not to be scaled from this drawing.
 Contractors must verify all dimensions before starting work and any discrepancies are to be reported to BDGworkfutures.
 Construction Coordination is to be the responsibility of the acting principle / manufacturing contractor. Any variations or discrepancies to be reported to BDGworkfutures.
 Manufacturing drawings / rods are to be provided for approval by BDGworkfutures for all bespoke items. This drawing is the property of BDGworkfutures as detailed in the Terms & Conditions available on termsandconditions.com. Full Terms & Conditions are available on termsandconditions.com.
 *Except for Planning Application purposes only.

| | |
|----------------|--|
| Information | |
| Approval | |
| Tender | |
| Construction | |
| Record Drawing | |

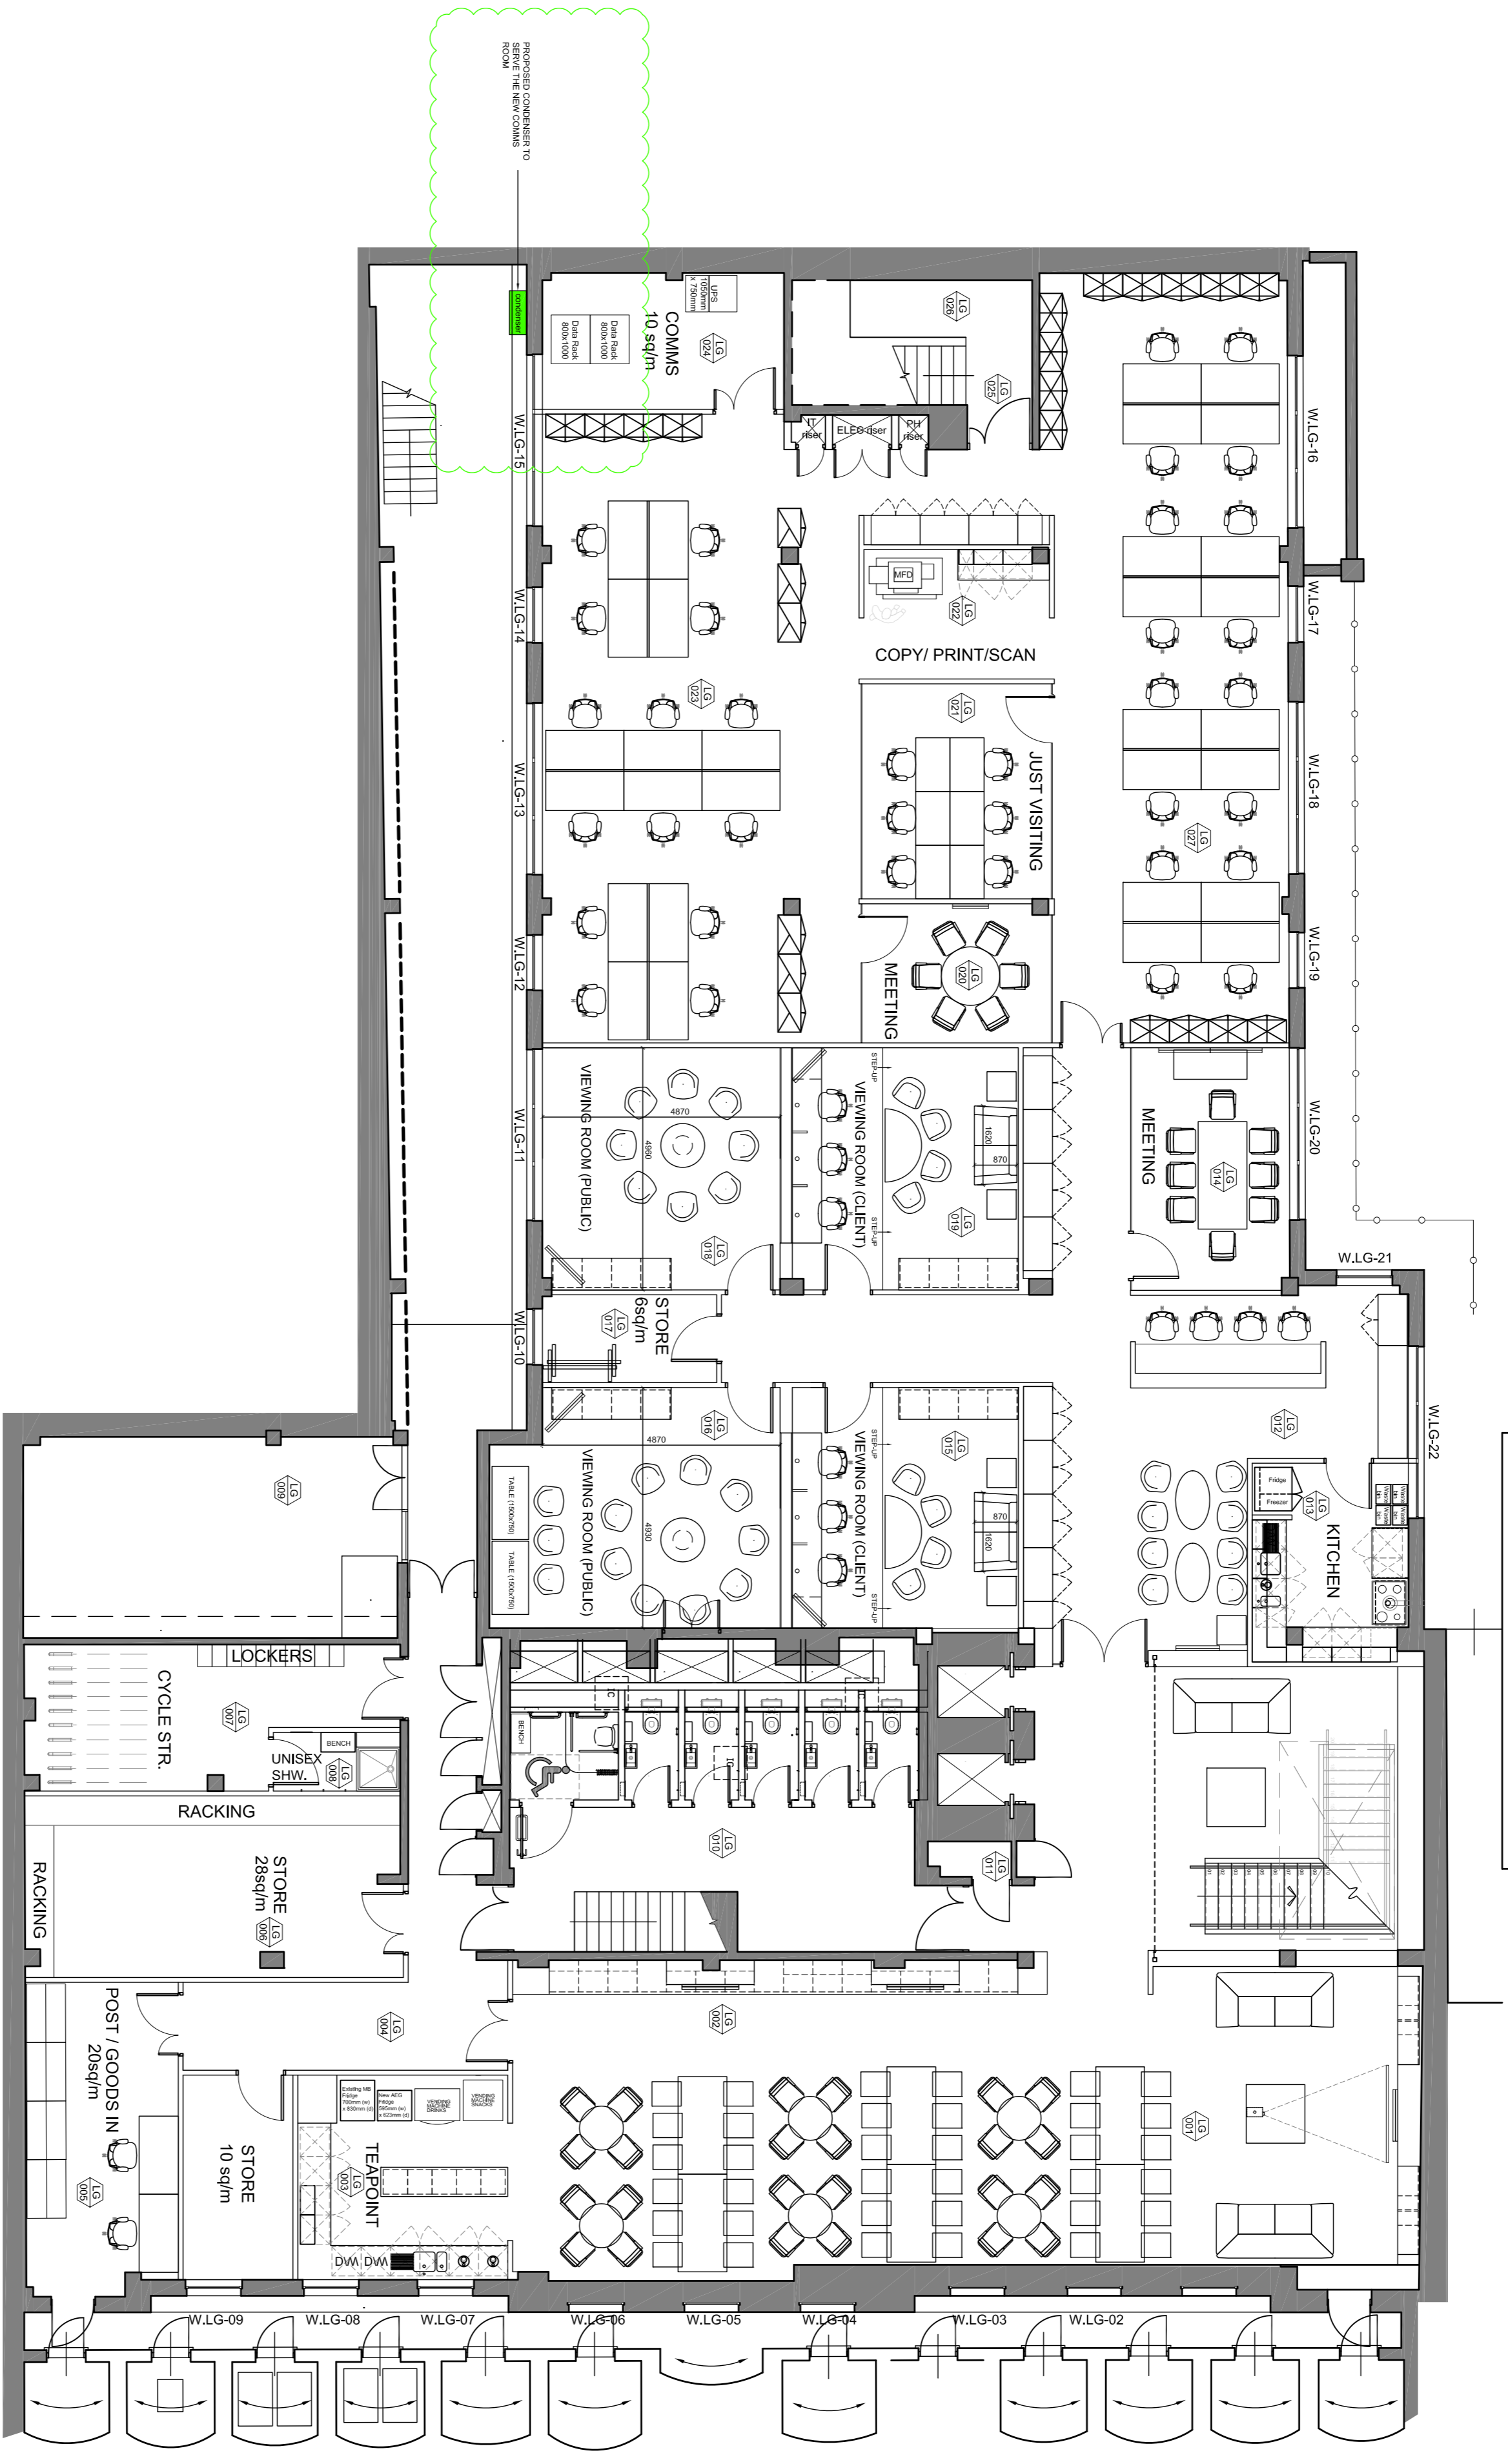

01 LOWER GROUND FLOOR
 PROPOSED PLAN

1:100

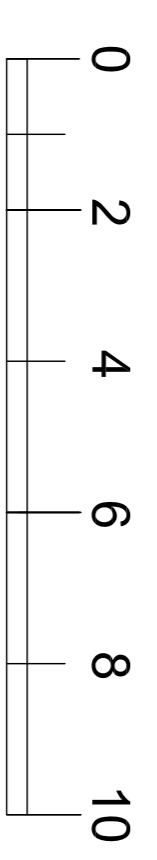

| Rev | Date | Description | By | Chk |
|-----|----------|-----------------------------|----|-----|
| G | 17.01.12 | Comms Condenser added | TK | CH |
| F | 09.09.10 | Reception furniture revised | TK | CH |
| E | 10.08.11 | Seitcase moved as discussed | TK | CH |
| D | 13.05.11 | CONSTRUCTION ISSUE | TK | CH |
| C | 28.04.11 | ISSUED FOR TENDER | TK | CH |
| B | 11.04.11 | WC core amended to fit slwr | TK | CH |
| A | 05.04.11 | Revised to client comments | TK | CH |
| - | 01.04.11 | FIRST ISSUE | TK | CH |

BDGworkfutures
 33 St John Street, London EC1M 4AA
 Tel: 020 7539 7400 Fax: 020 7539 7401
 www.bdgworkfutures.com

Client:
 -
 -
 Project:
 24 BLOOMSBURY WAY
 LONDON
 WC1A 2PX

Title:
 PROPOSED
 LOWER GROUND
 FLOOR PLAN

| | | | | | |
|-------------|-------------------|--------------|----------|-------------|----|
| Scale: | 1:100 @ A1 | Date: | 31.03.11 | Revision: | G |
| Drawing No: | 24BW LG GA 135 01 | Drawn By: | TK | Checked By: | CH |
| Project No: | 2000000 | Approved By: | PH | | |