



DO NOT SCALE.
IF IN DOUBT ASK.

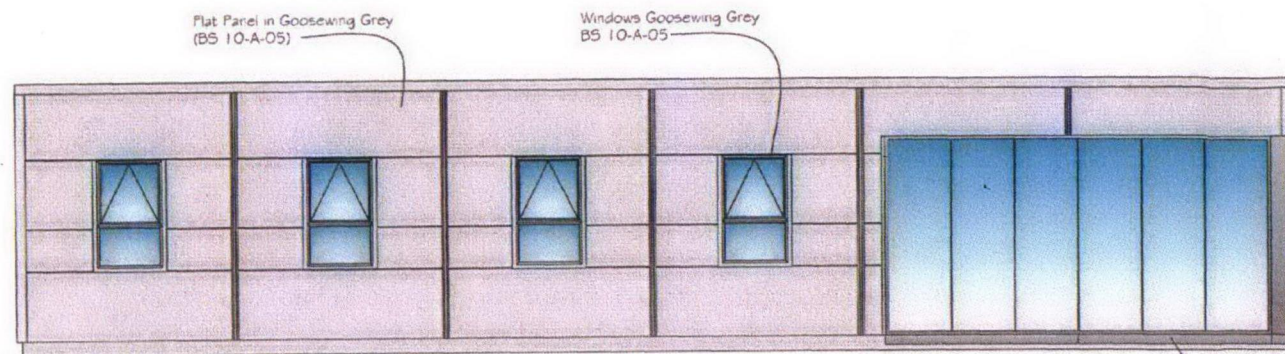


ELEVATION A


Polished Stainless Steel (PSS)

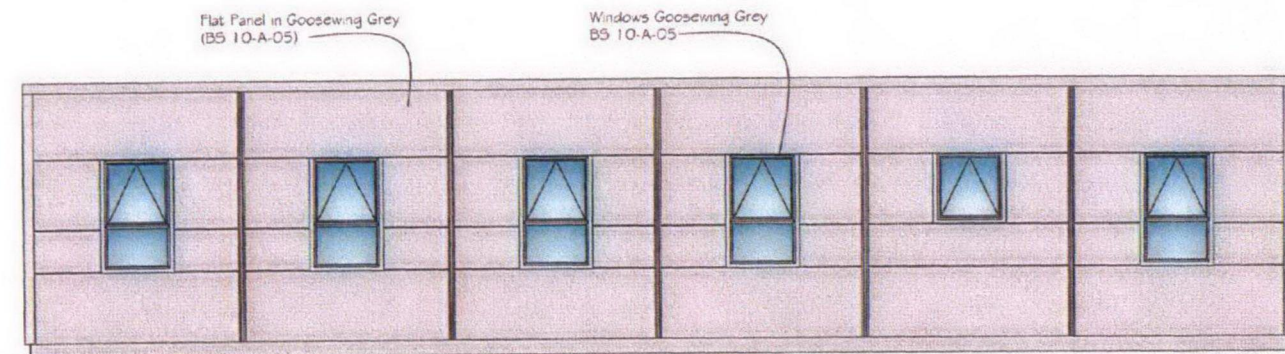

ELEVATION C

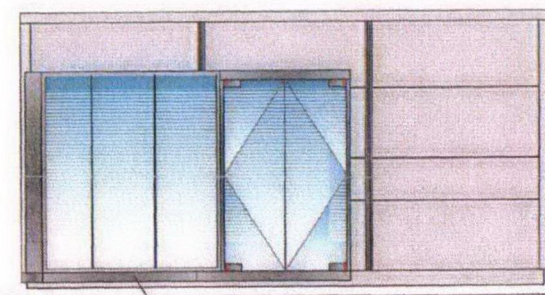

ELEVATION D

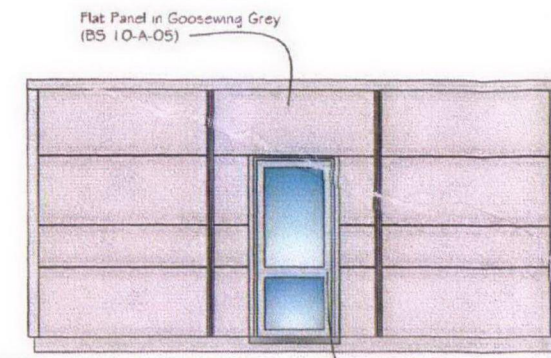

ELEVATION B

Door Goosewing Grey
BS 10-A-05

Manufacturing Details

Building Span: 7.2m x 12m
Design: Premier Plus - Single Storey
Floor Loading: 5.0kN/m²
Ceiling Height: 3.100m (2750mm Suspended).
Roof Pitch: MONO PITCH

Roof Construction:
100mm TRISOSET insulated roof sheets fixed to joists forming fall.
50mm peach polyfoam to beam upstands.

Rainwater Goods:
Internal gutter system.
50mm White Solvent Weld Polypipe.

Floor Construction:
Kingspan K51000 XD Insulated Floor Panels overlaid with
Two Layers of 18mm Tongue & Grooved Flooring Grade Plywood.

External Walls & Wall Finish:
K5 1000/600 FL HF5200 80mm thick (0.7mm steel) composite
Wall Panels - Flat Finish - Colour: 'GOOSEWING GREY'.

Plinth - 3mm Plywood Banded with Plastisol - Colour: 'GOOSEWING GREY'.
Fascia trim - Colour: 'GOOSEWING GREY'.
External corners - Colour: 'GOOSEWING GREY'.
Panel joint trim - Colour: 'GOOSEWING GREY'.

Internal Wall Lining to be Supplied & Fitted on Site by Others.

Internal Partitions:
N/A.

Skirting:
N/A.

Architraves:
N/A.

External Doors:
Supplied & Fitted on Site by Waco St Neots.

Internal Doors:
N/A.

Ironmongery:
N/A.

Windows:
Full Height Glazing to Elevations A & D where shown on Layout.
Supplied & Fitted on Site by Waco St Neots.
Standard W1 Type windows as shown. See specification for details.

Ceiling Lining:
Supplied & Fitted on Site by Others.

Floor Coverings:
20mm Tiles to be Supplied & Fitted on Site by Others.

Internal Fixtures:
Supplied & Fitted on Site by Others.

Pumpings:
N/A.

Window Specification

W1 Aluminium Double glazed, 20mm sealed unit, top hung, fully opening sash, incorporating insect fly, handle, cockspur handle and trickle ventilation, with clear safety glass internal and clear float glass external.
Colour: BS 10-A-05 - Light Grey
Size: 900 x 1500mm

W2 Aluminium Double glazed, 20mm sealed unit, top hung, fully opening sash, incorporating insect fly, handle, cockspur handle and trickle ventilation, with obscure safety glass internal and clear float glass external.
Colour: BS 10-A-05 - Light Grey
Size: 900 x 1500mm

Rev	By	Description	Date
H	SRE	Fire exit door added	25/02/06
G	SRE	Additional windows shown to built units, all goosewing grey	21/02/06
F	SRE	Deviations and point-to-point, manufacturing notes added	21/02/06
E	SRE	Units as built & 2 additional bays & sld windows	11/02/06
D	SRE	Internal rooms added	09/11/05
C	SRE	2000mm wide balcony added	07/11/05
B	SRE	General Revisions	16/08/05
A	SRE	Revised as Premier Plus	16/08/05

**PREMIER
INTERLINK**
WACO UK LTD

HEAD OFFICE
CATFOSS LANE, BRANDESBURTON, DRIFFIELD
EAST YORKSHIRE YO25 8EJ
Telephone: (01964) 545000 Fax: (01964) 545001
email: sales@waco.co.uk internet: www.waco.co.uk

THIS DRAWING AND DESIGN IS THE SOLE PROPERTY OF WACO UK AND MUST NOT BE COPIED, LOANED OR COMMUNICATED, IN WHOLE OR PART, TO ANY THIRD PARTY WITHOUT CONSENT FROM THE COMPANY.

Client	Bovis Lendlease Limited		
Project	Regent's Place Development		
Title	Marketing Suite Typical Details		
Scale (of A1)	Drawn	Date:	Checked
1: 50	S.R.E.	06/08/2007	
Drawing No.			Rev
PCF01569-006b			H

PCF01569-006 Rev H