



Project:-	BT Openreach			Date:-	39540	CT Order No:-	5000768162	PCP No.:-	21 V3
Exchange:-	Hampstead	Location:-		Post Code:-	NW3 1QL			DSLAM NGR:-	526681 185633
		Hampstead High Street, S/O 80 Hampstead High Street, Hampstead, London			Carillion/Telent	01732 229 700			PCP NGR:- 526698 185655

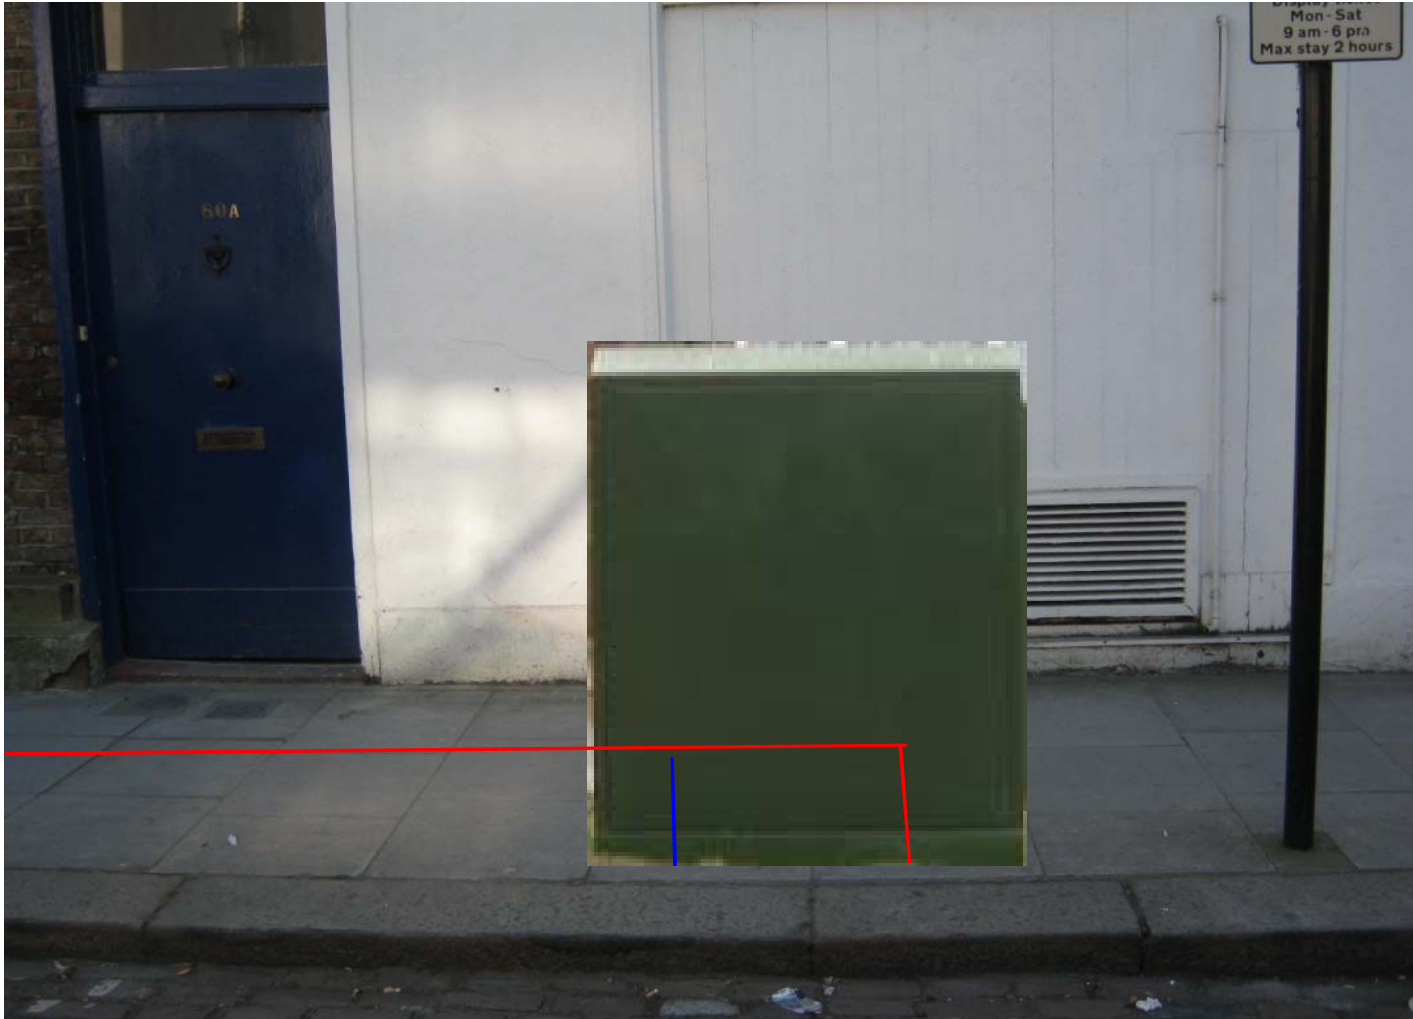

Project:-	BT Openreach			Date:-	39540	CT Order No:-	5000768162	PCP NGR:-	526698 185655
Exchange:-	Hampstead	Location:-		Post Code:-	NW3 1QL			DSLAM NGR:-	526681 185633
		Hampstead High Street, S/O 80 Hampstead High Street, Hampstead, London			Carillion/Telent			PCP No:-	21 V3

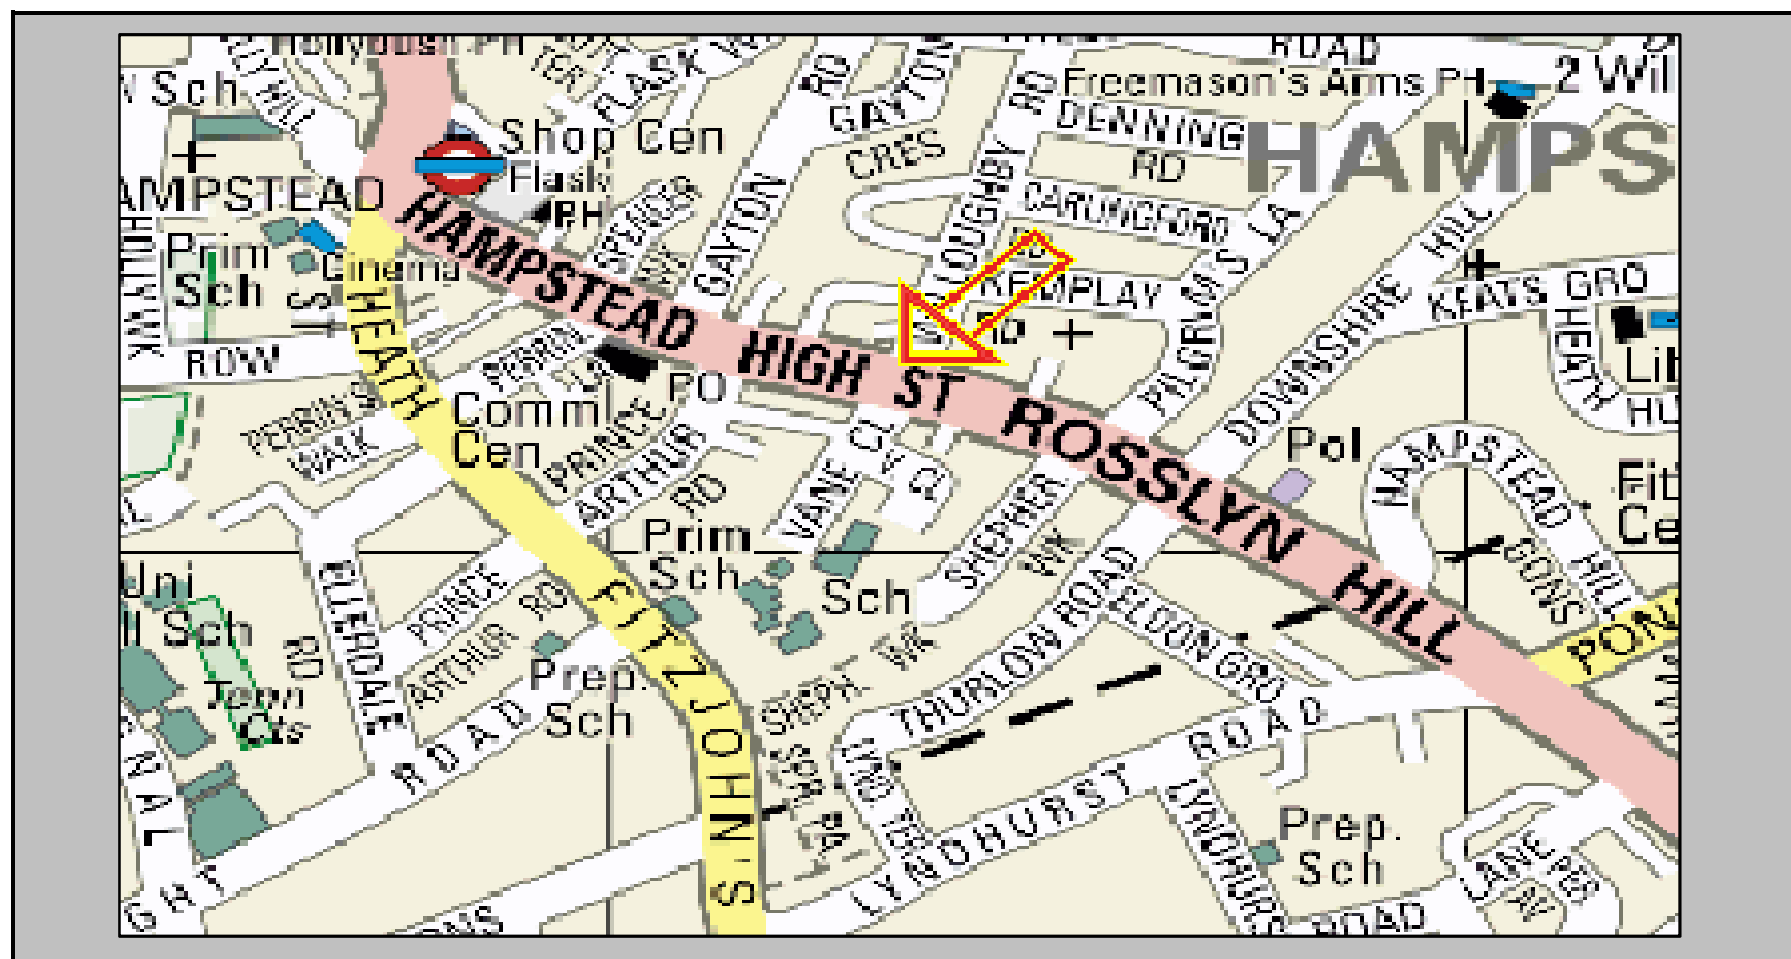

_PCP 21\ _DUCT

Project:-	BT Openreach		Date:-	39540	Ct Order No:-	5000768162	PCP NGR:-	526698 185655
Exchange:-	Hampstead	Location:-	Post Code:-	NW3 1QL			DSLAM NGR:-	526681 185633
		Hampstead High Street, S/O 80 Hampstead High Street, Hampstead, London			Carillion/Telent	01732 229 700	PCP No:-	21 V3

HAMPSTEAD PCP021

Hampstead High Street,
S/O 80 Hampstead High
Street, Hampstead
London
NW3 1SB

526679 185667

As Laid
Date:
Drawn By:

Comments:

Line Drawing

