





1. Phase 1 - Sports/Youth Centre West Elevation



2. Phase 1 - Sports/Youth Centre North Elevation

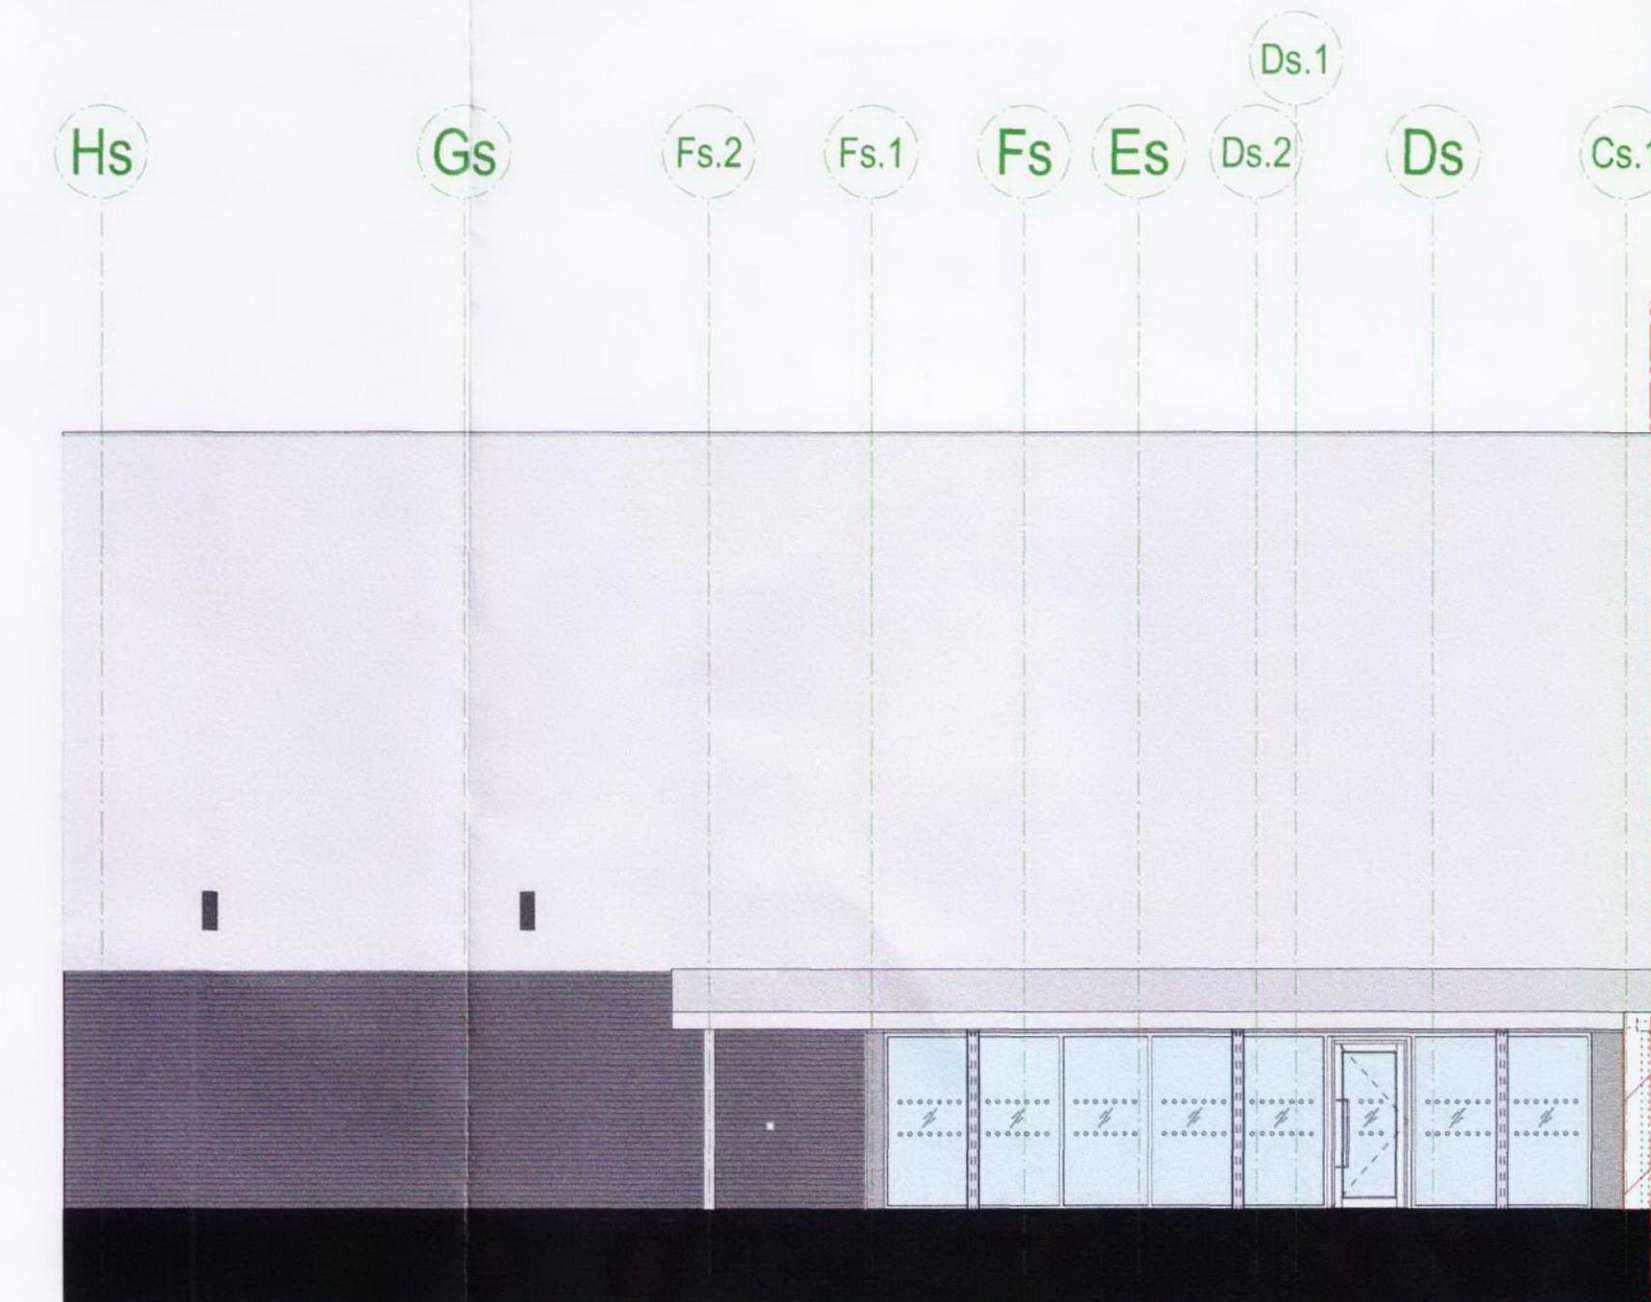


3. Phase 1 - Sports/Youth Centre East Elevation

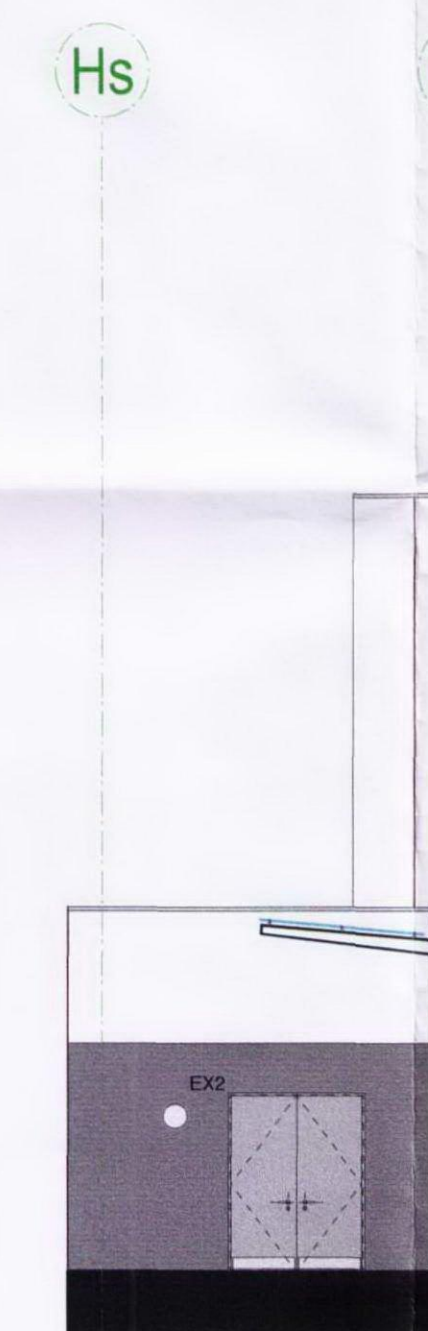

4. Phase 1 - Sports/Youth Centre North Elevation Internal courtyard



5. Phase 1 - Sports/Youth Centre South Elevation Internal courtyard

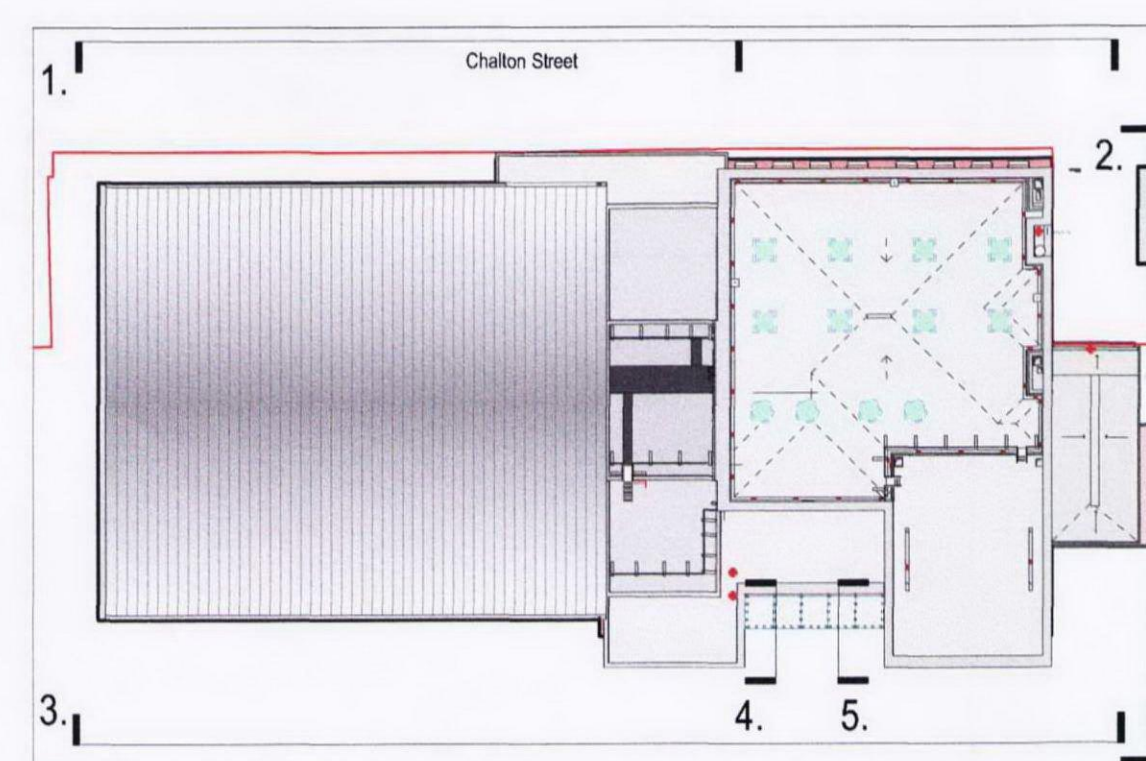

© This drawing is copyright.
Notes:
Do not scale from drawing. Use figured dimensions only. All dimensions to be checked on site.
All drawings should be read in conjunction with Structural Engineer's and Services Engineer's documentation.



rev	date	notes
01.12.11	Building Manual - As Built Drawing	
project	CAMDEN BSF_SOUTH CAMDEN COMMUNITY SCHOOL	
use	Sports and Youth Centre Elevations	
date	01.12.11	drawing no
scale	1:100 @ A1	SCCS_ARCH_1213

0 1m 2m 5m 10m