


9 Belsize Lane beyond

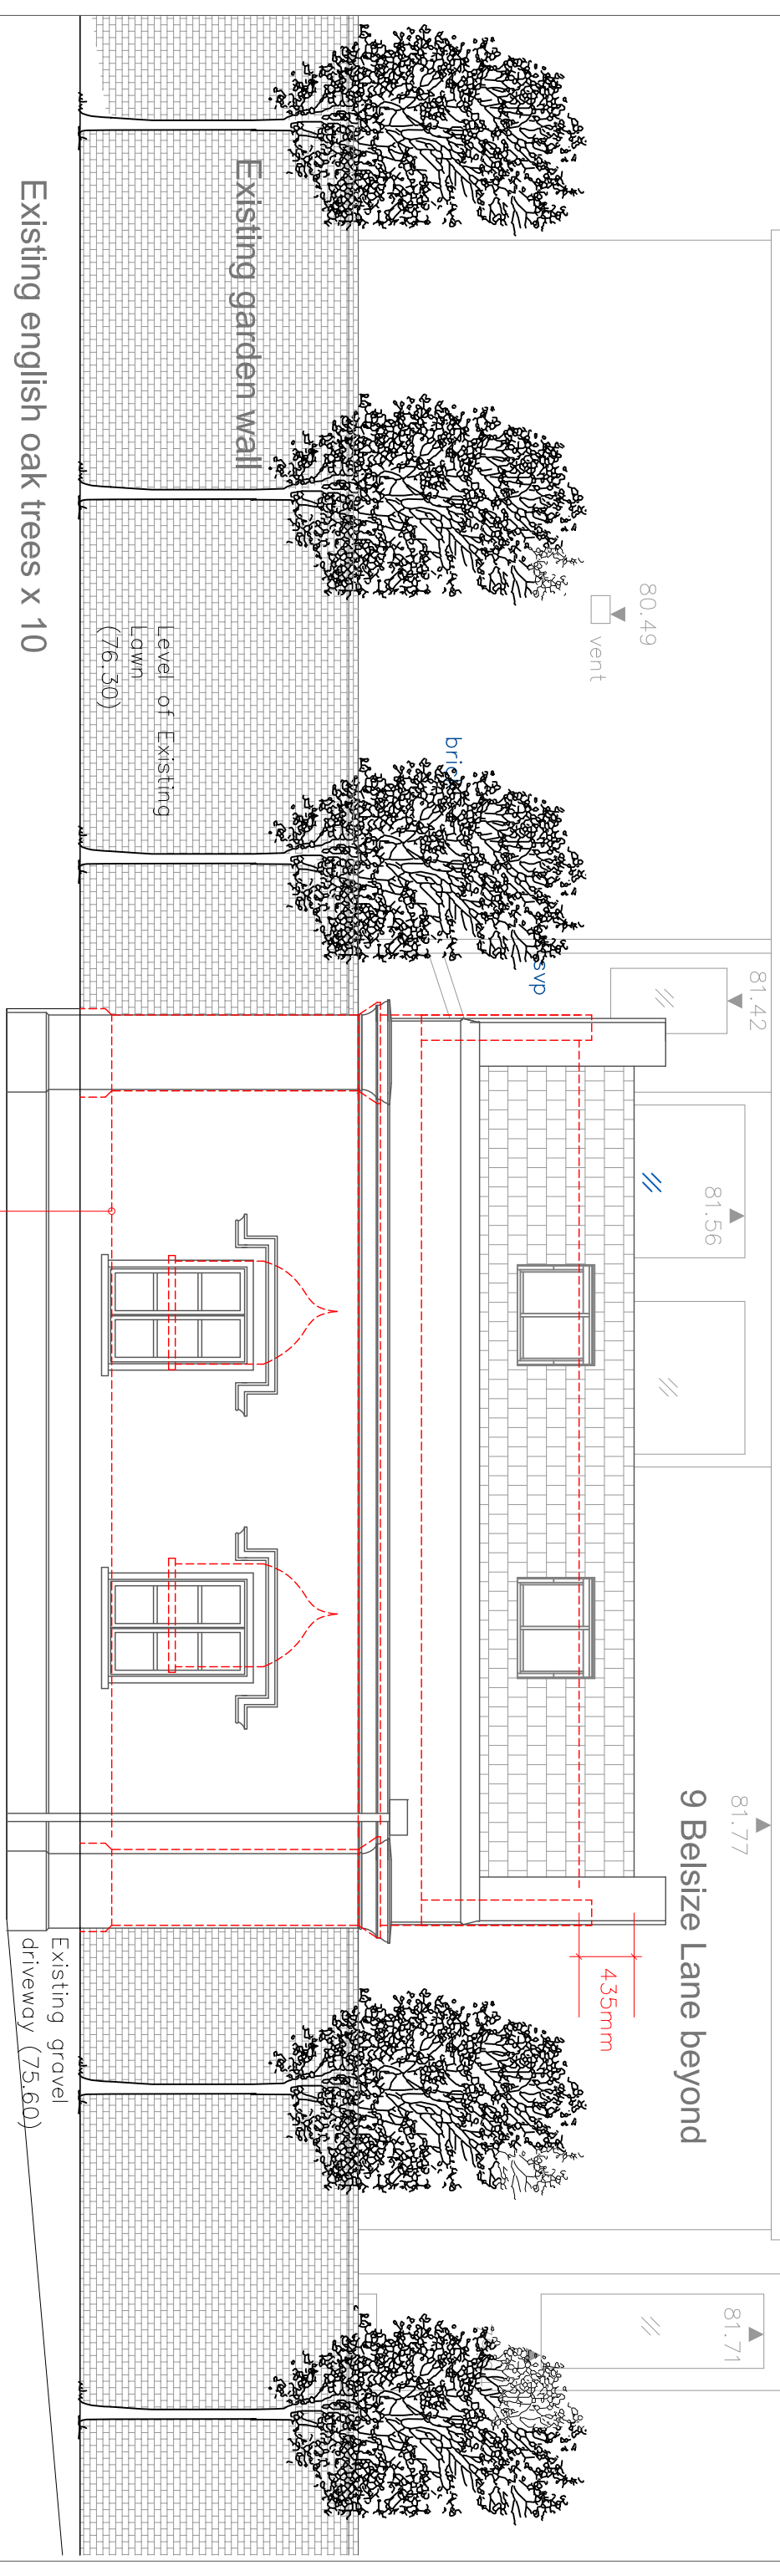

Red line indicates Existing permission

Existing Consent overlaid with the As-Built Elevation

PROJECT TITLE: HUNTERS LODGE GARAGE/OUT BUILDING- Proposed Minor amendments to the existing design	
DRAWING TITLE: SIDE ELEVATION/Proposed with amendments	SHEET NO. HL/GR/13/C
SCALE: 1:50	DATE: 05-01-2012