





**AS BUILT FLOOR PLANS**  
scale 1:100


**LOWER GROUND**

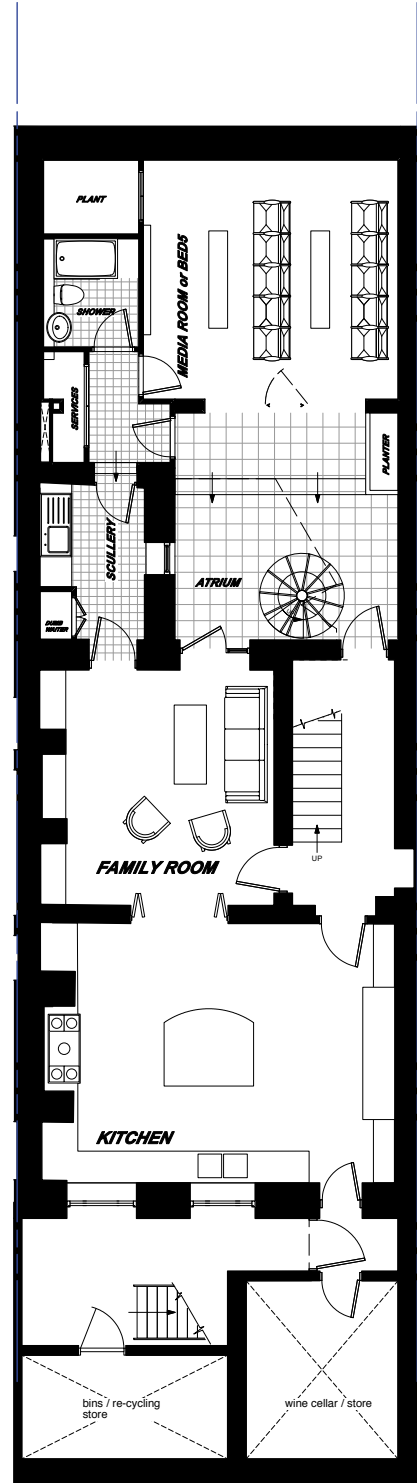


**GROUND**

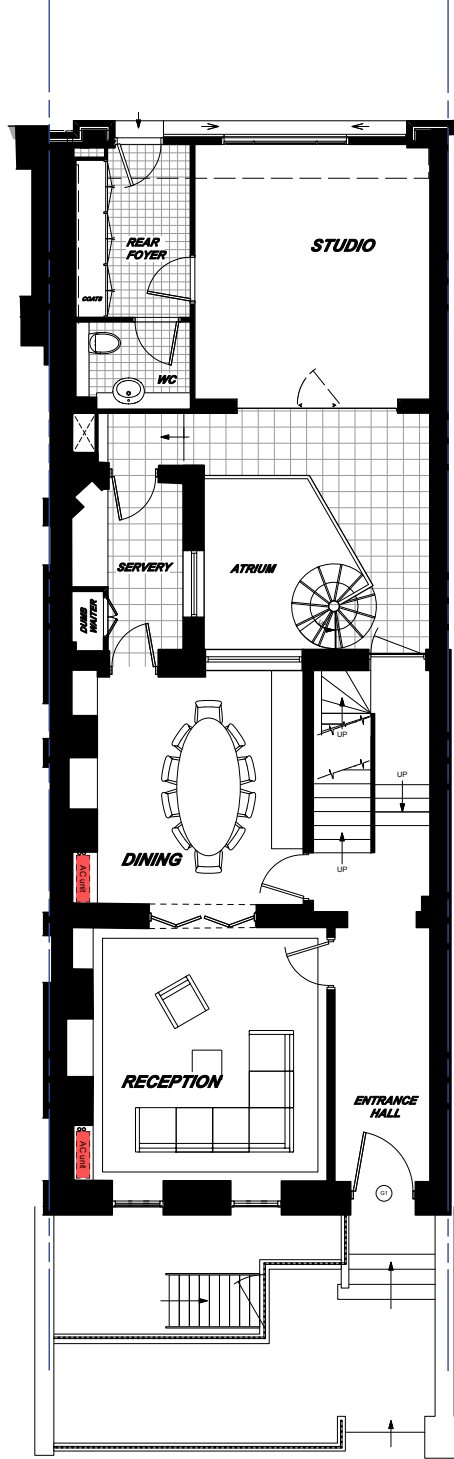


**UPPER GROUND**

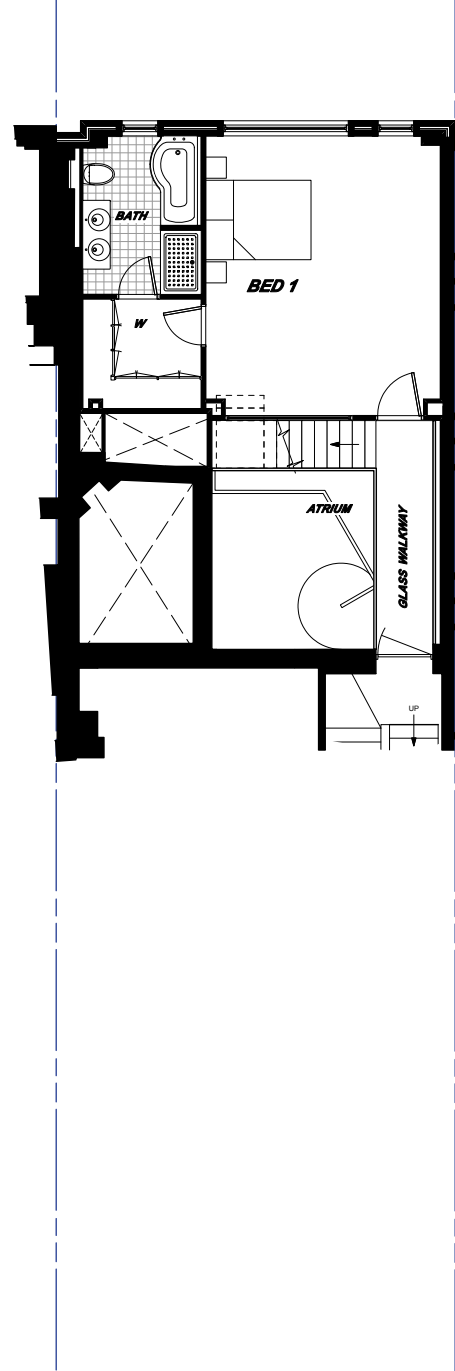




**FIRST**

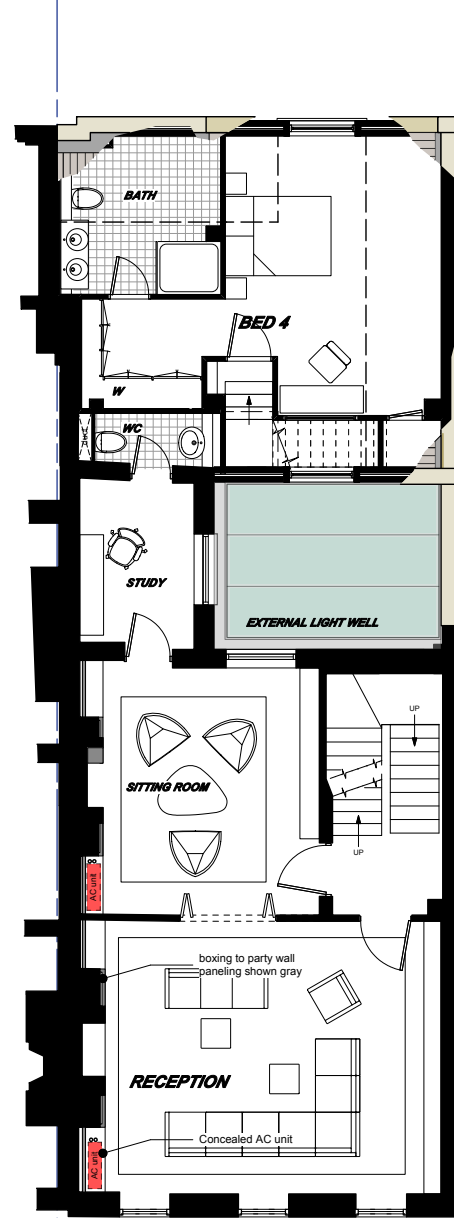

**SECOND**

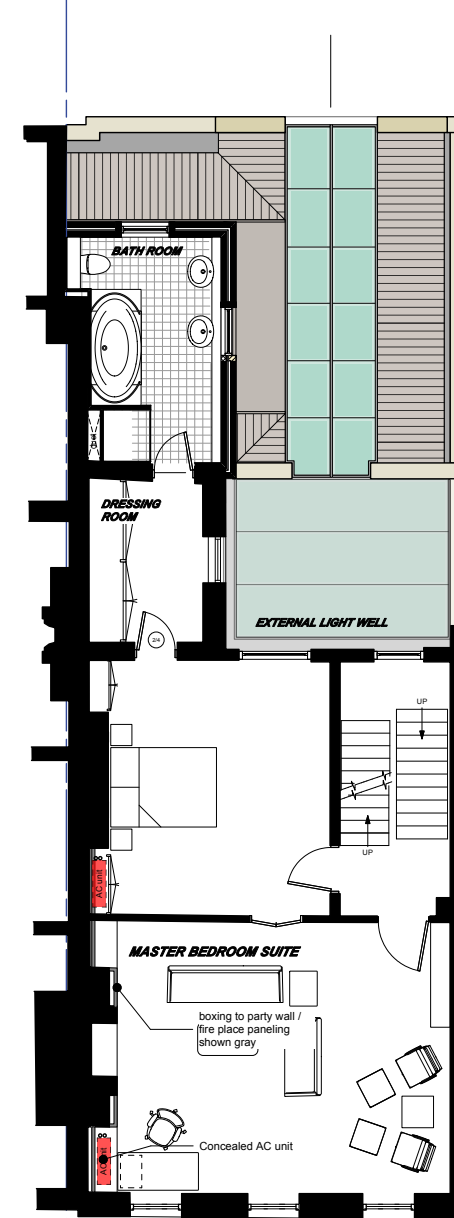

**THIRD**

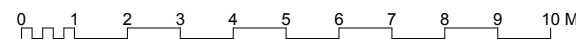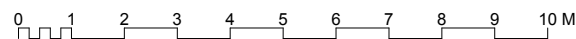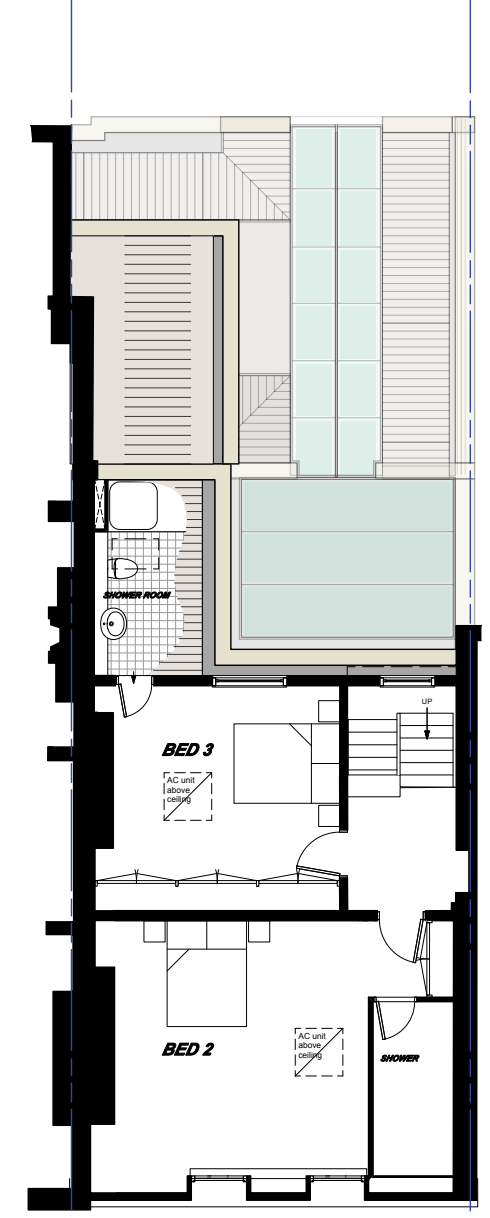

**DO NOT SCALE THIS DRAWING.**  
**CHECK ALL DIMENSIONS ON SITE**

THIS DRAWING IS ISSUED TO ESTABLISH THE FEASIBILITY OF THE PROPOSED SCHEME AND IS BASED ON UNVERIFIED BUYER'S INFORMATION PROVIDED BY OTHERS. THE DRAWINGS ARE NOT TO BE SCALED AND ALL ERRORS OR OMISSIONS ARE TO BE REPORTED TO THE ARCHITECT. FORD ARCHITECTURE DOES NOT ACCEPT ANY LIABILITY FOR THE CONSEQUENCES OF ACTION BASED ON THE INFORMATION PROVIDED. ALL PROPOSALS SHOWN ARE SUBJECT TO PLANNING AND A DETAILED STRUCTURAL SURVEY.

no.	date	revision notes

**FORD ARCHITECTURE**  
 HUDDLESTONE CLOSE  
 EYE LANE CLEEVE HILL  
 CHELTENHAM GL52 3DD  
 T/F: +44(0)1242 673103  
 E: INFO@FORDARCH.CO.UK

CLIENT: MR K V TULSIANI  
 PROJECT: 6 LINCOLN'S-INN-FIELDS GARDEN, LONDON  
 DRAWING TITLE: AS BUILT FLOOR PLANS  
 SCALE: 1:100  
 PAPER: A2  
 DATE: 5/2011  
 COPYRIGHT: ALL RIGHTS RESERVED ©  
 DRAWING NUMBER REV: P814 08/100 -