


Proposed Basement Floor Plan
as on the Planning Application
approved by London Borough of Camden

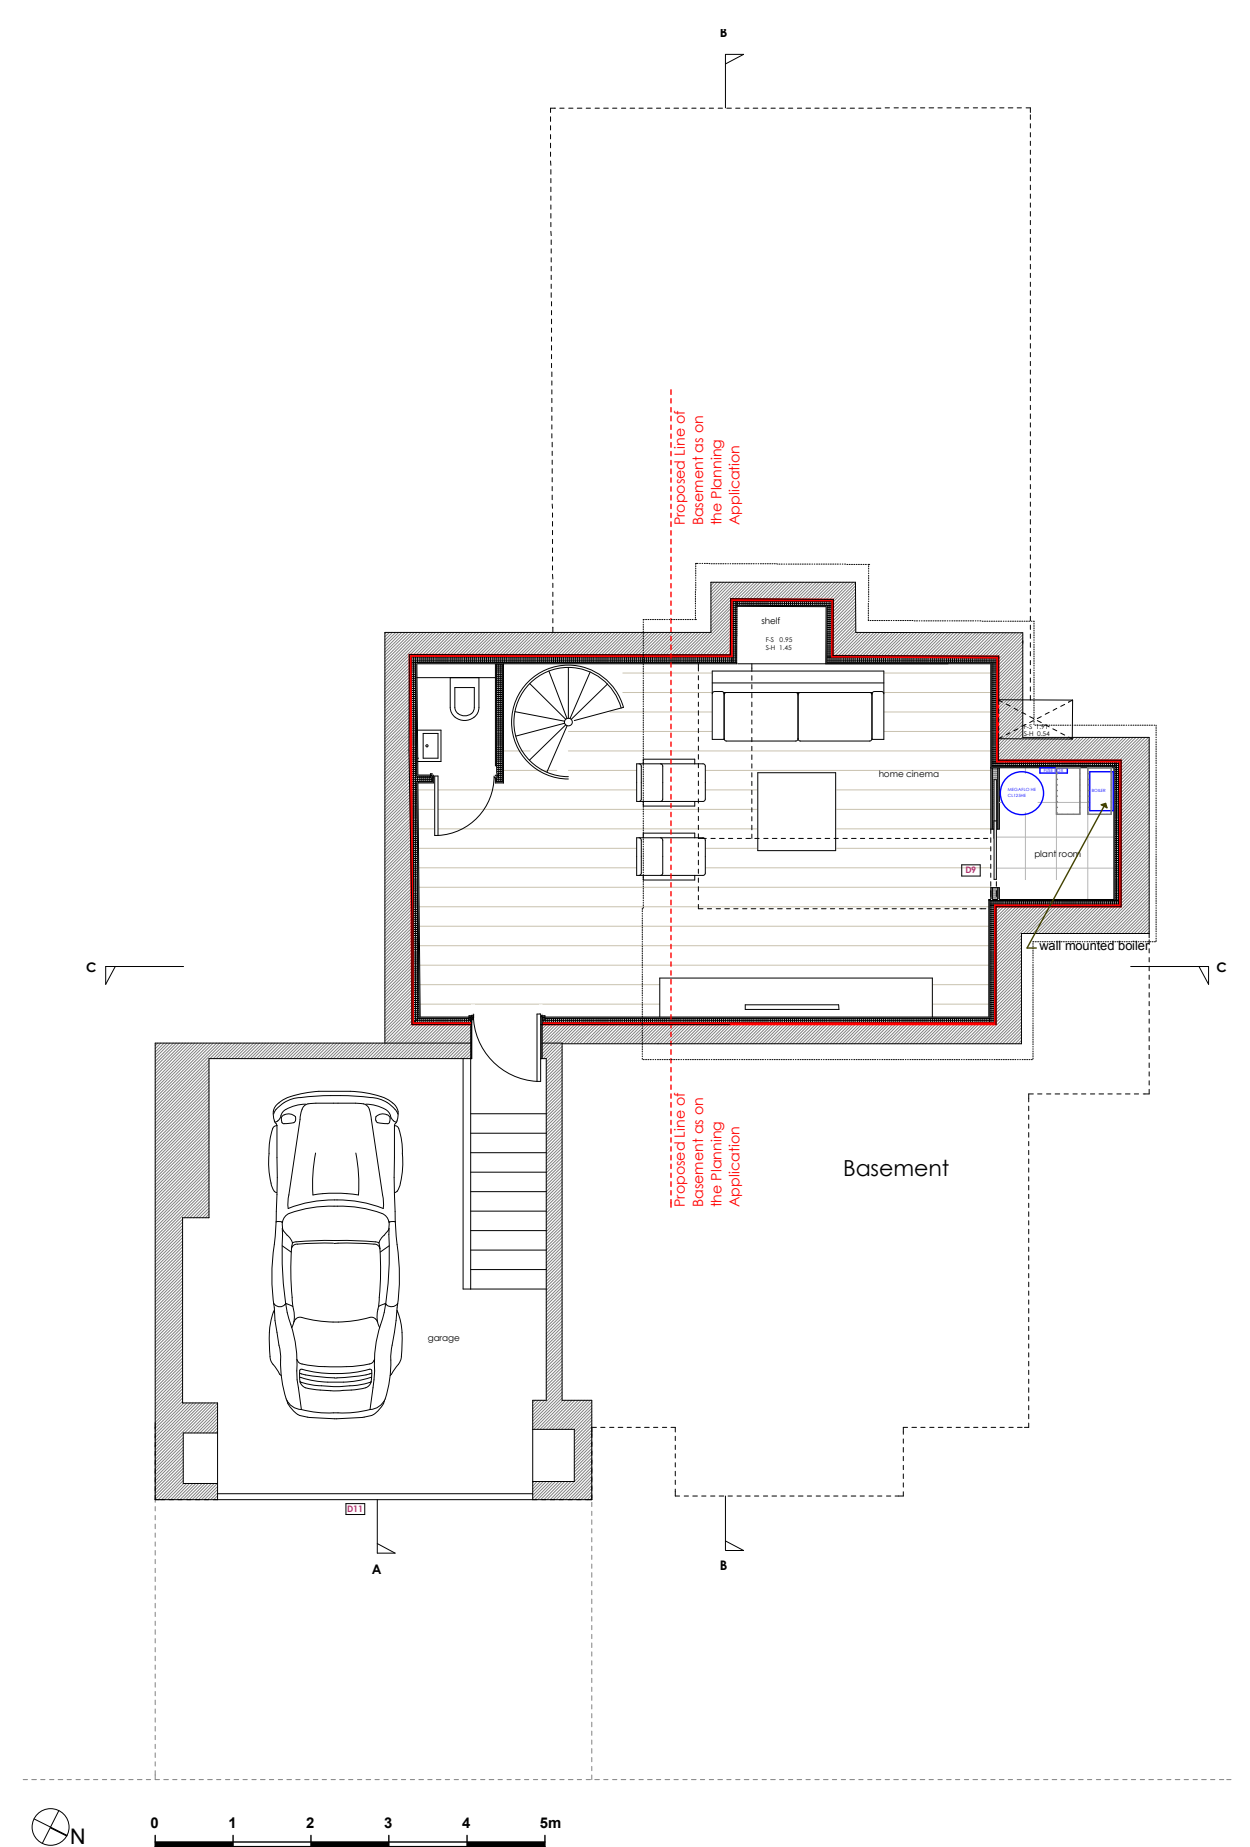

Proposed Basement Floor Plan
as built