
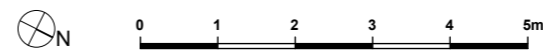


Proposed Ground Floor Plan
as on the Planning Application
approved by London Borough of Camden

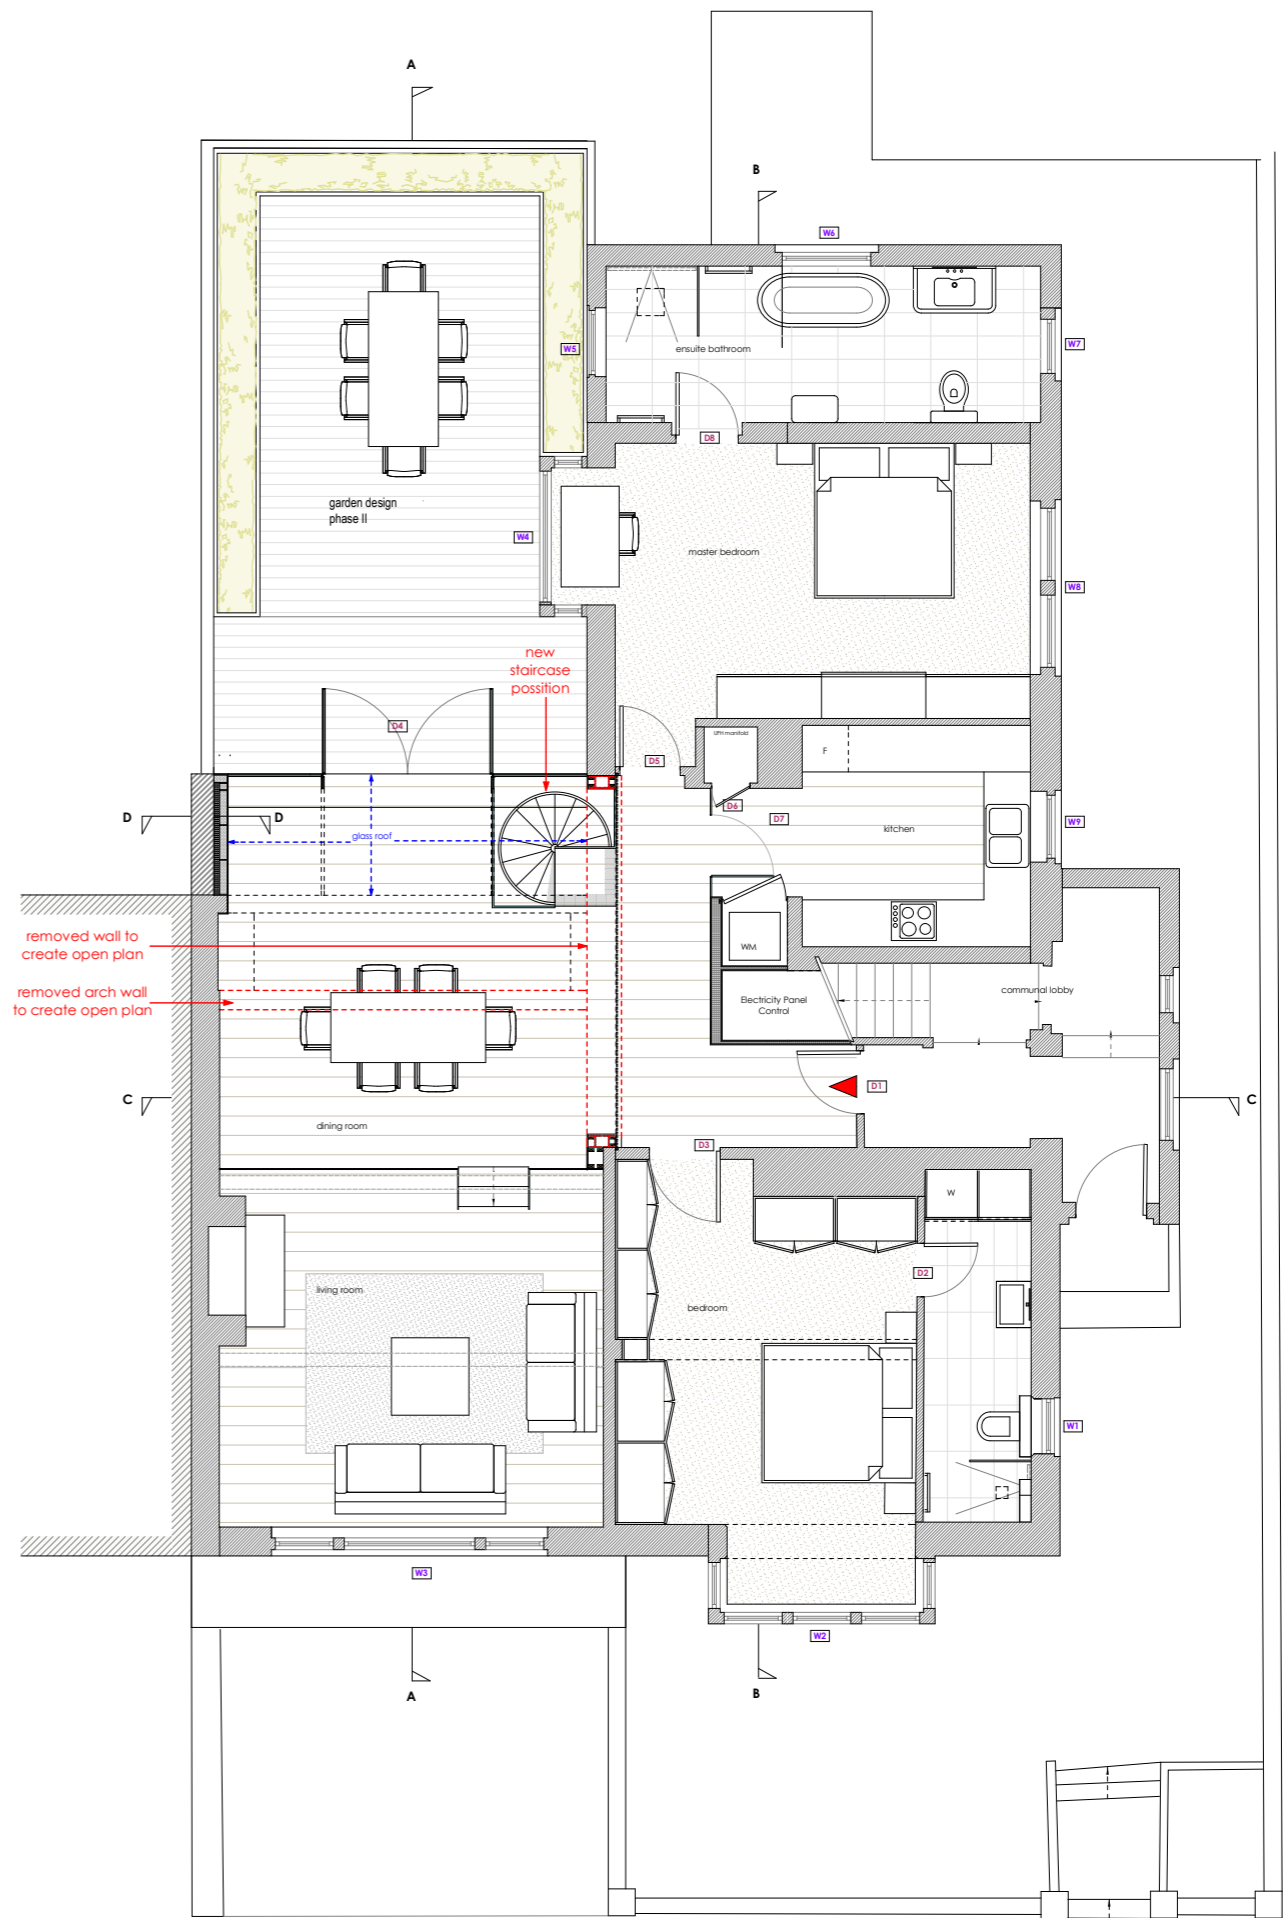

Proposed Ground Floor Plan
as built