


Proposed Section A-A
as on the Planning Application
approved by London Borough of Camden

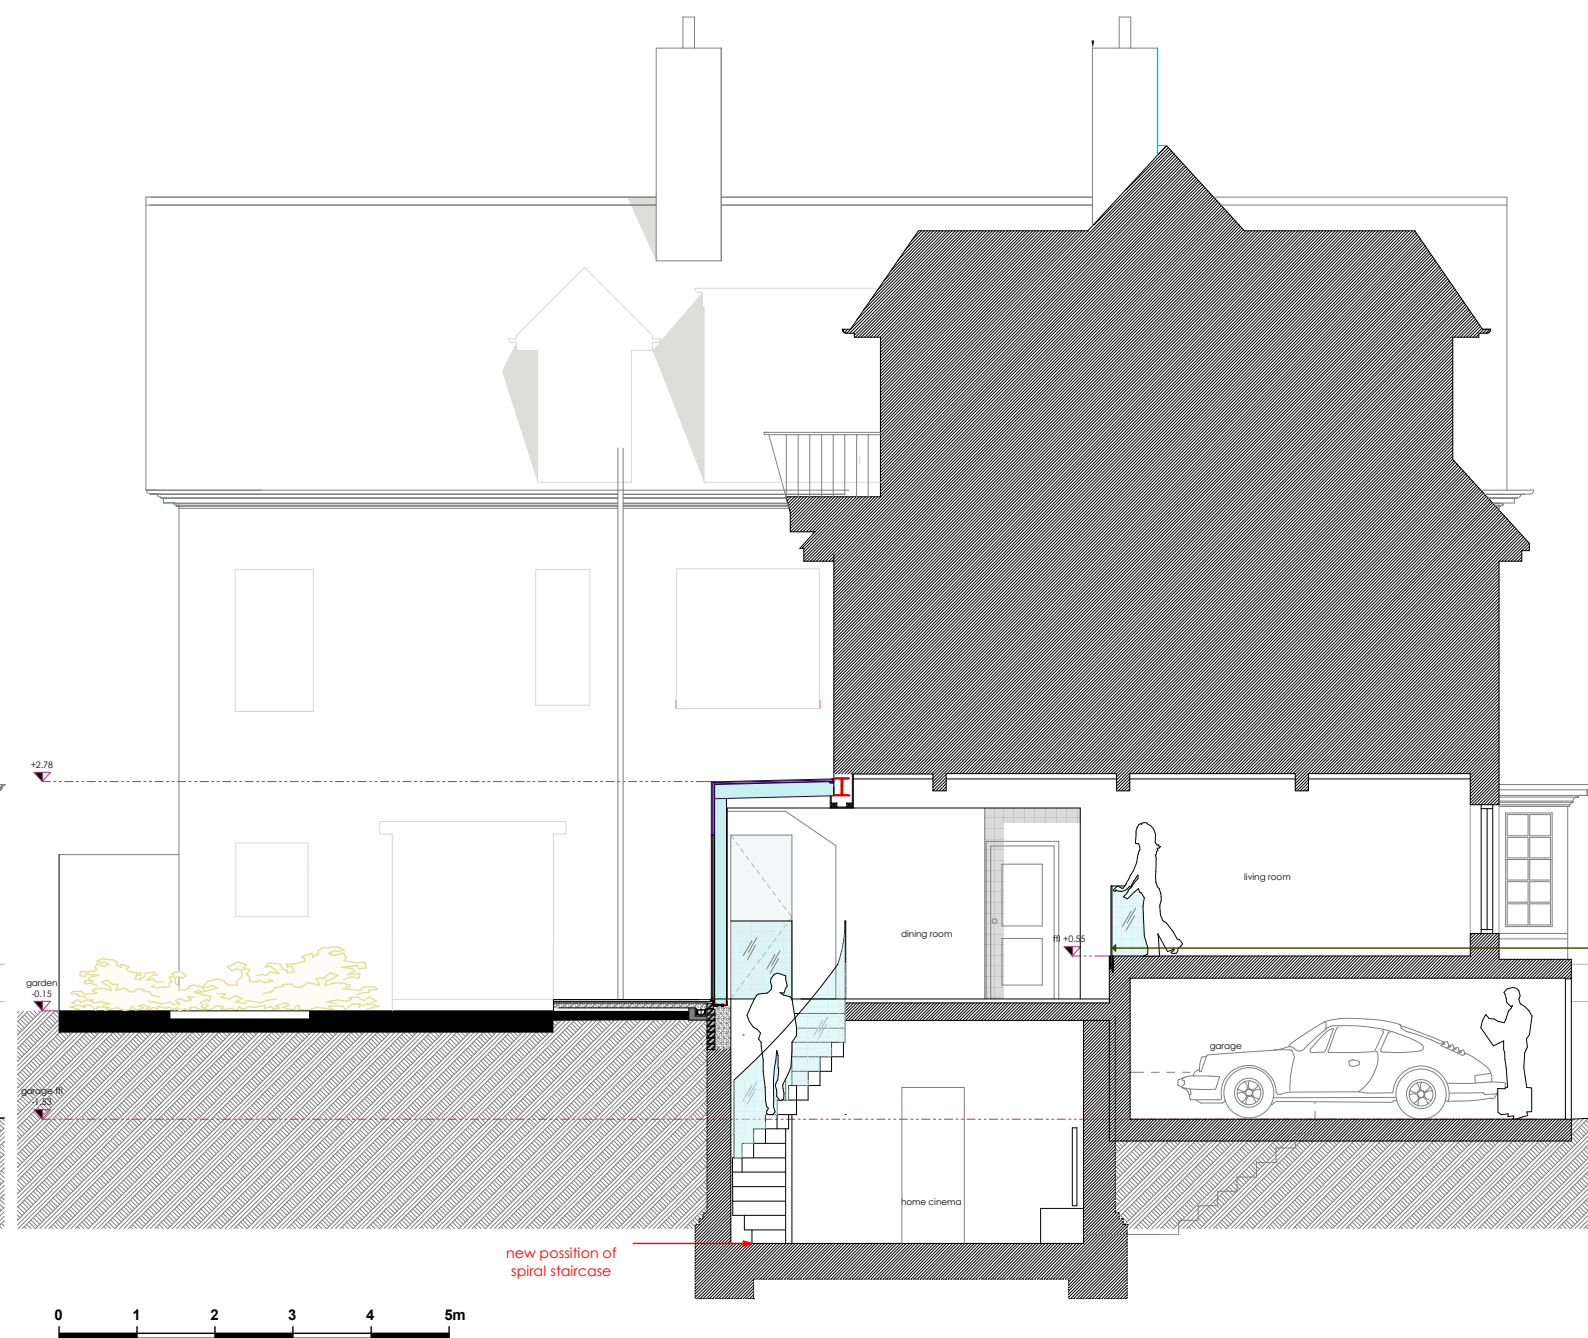

Proposed Section A-A
as built