



Second Floor - As Constructed

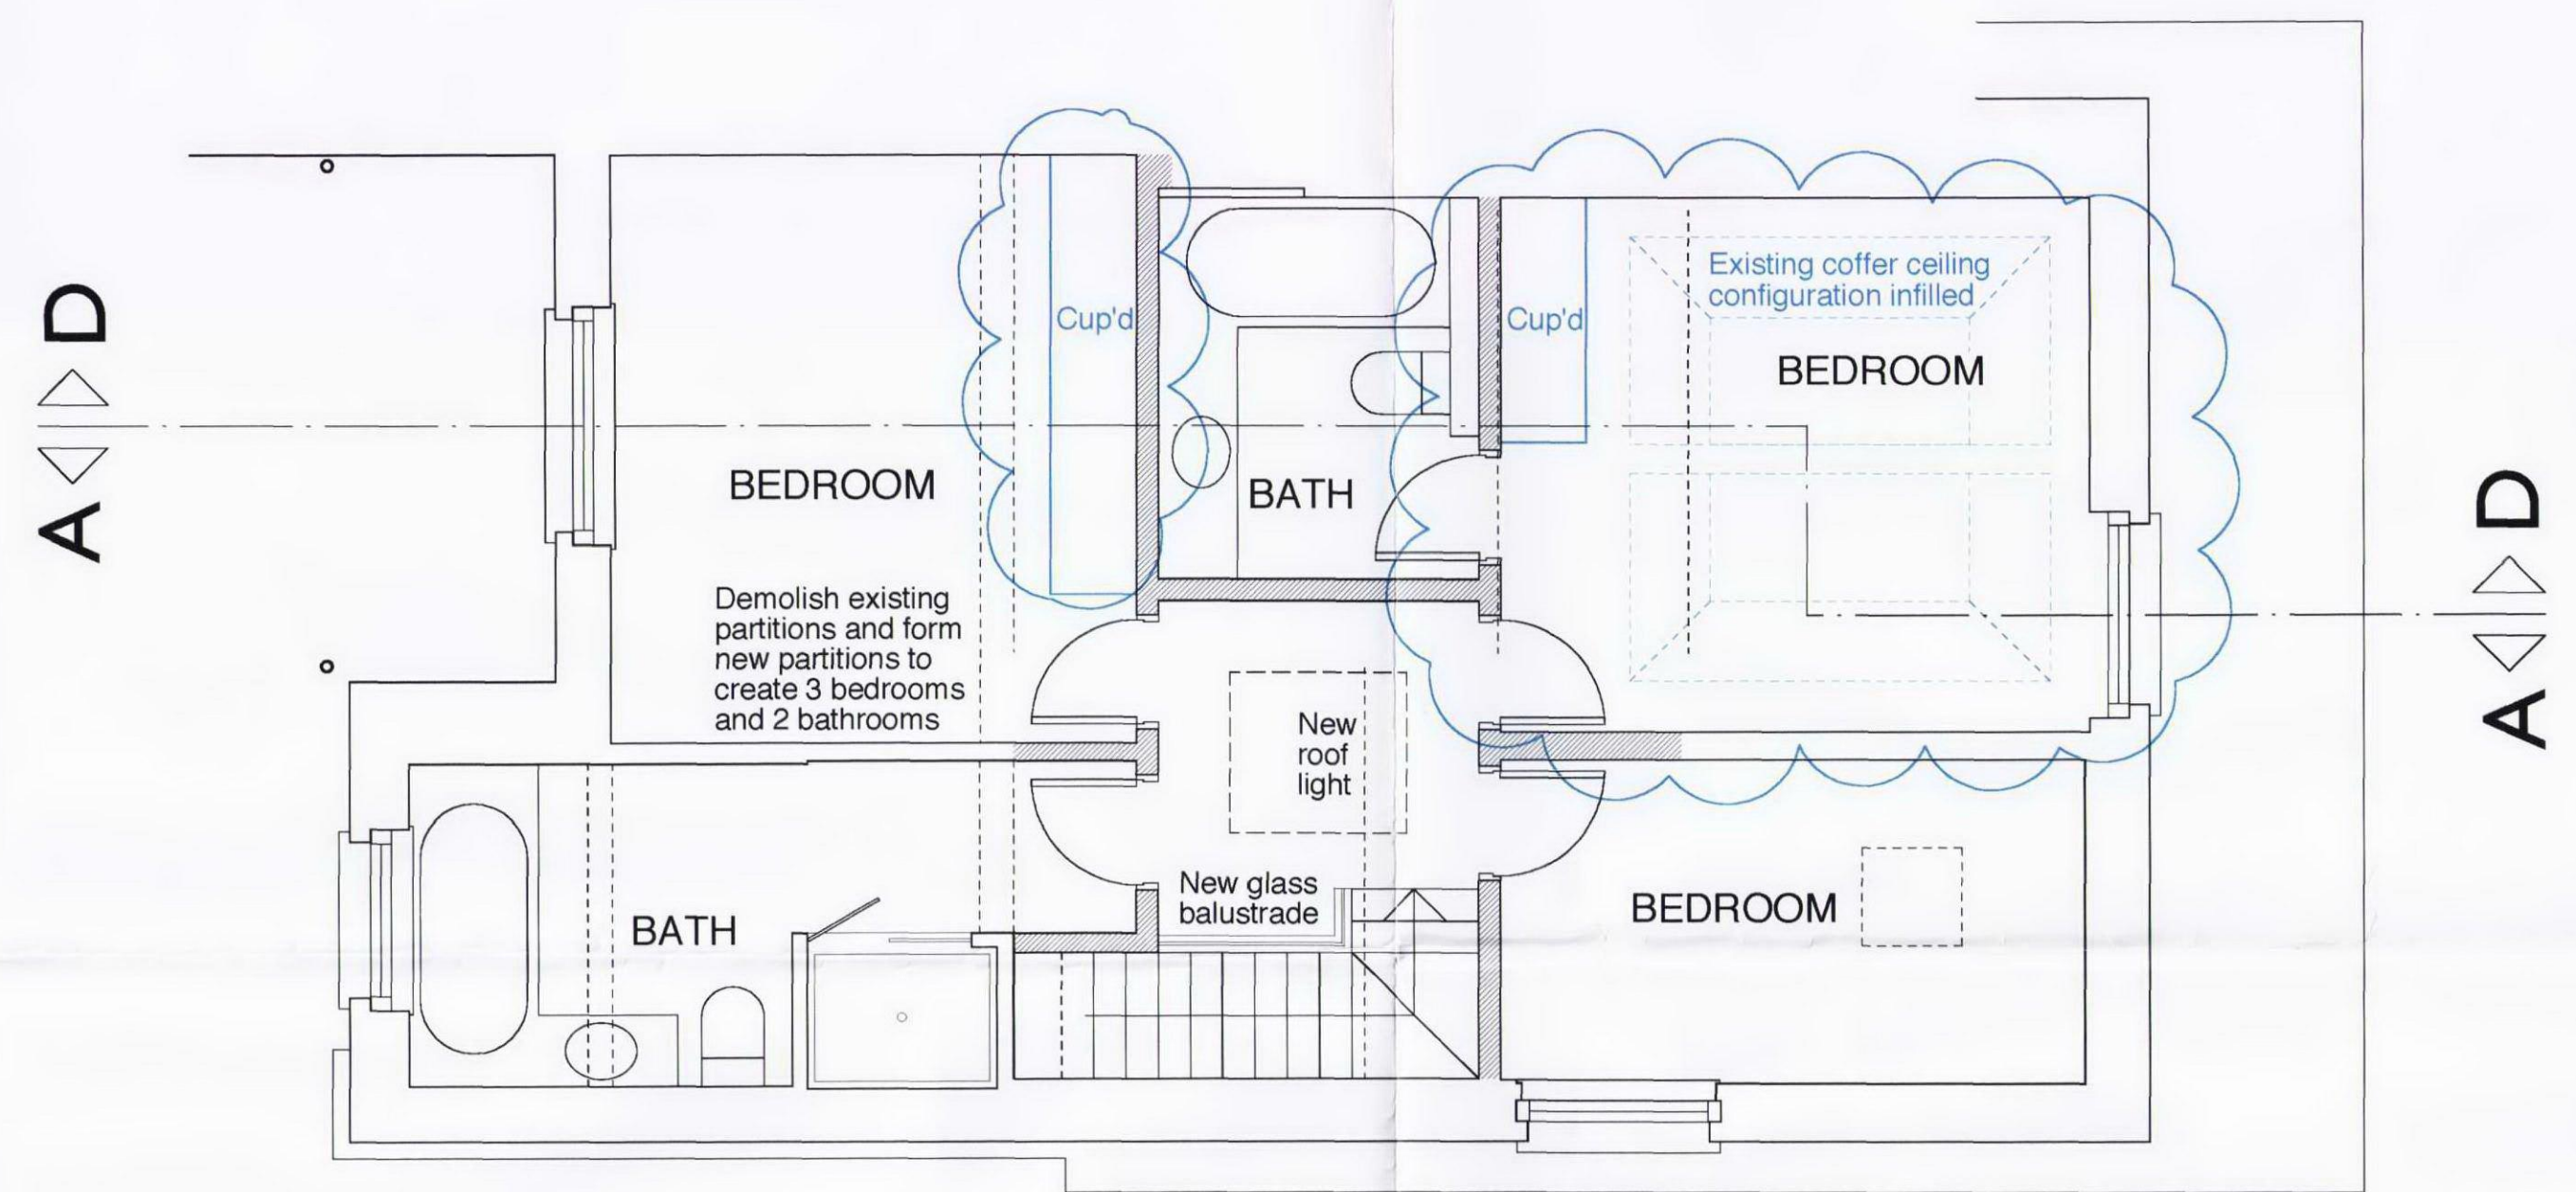

Third Floor - As Constructed

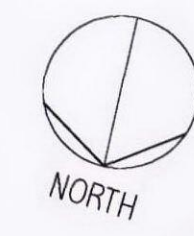

Revisions:	Date:	January 2011	Drawing No:	5071/11	Project:	57 CUMBERLAND TERRACE LONDON NW1 4HJ	studio <b>DAR</b> architects	4C CODA Centre 189 Munster Road London SW6 6AW t: +442073864590 f: +442073869454 www.studiodar.co.uk e: office@studiodar.co.uk
	Scale:	1:50	Drawing Title:	SECOND & THIRD FLOOR PLANS As Constructed				
	Drawn by:	AB						

RECEIVED  
23 JAN 2011