
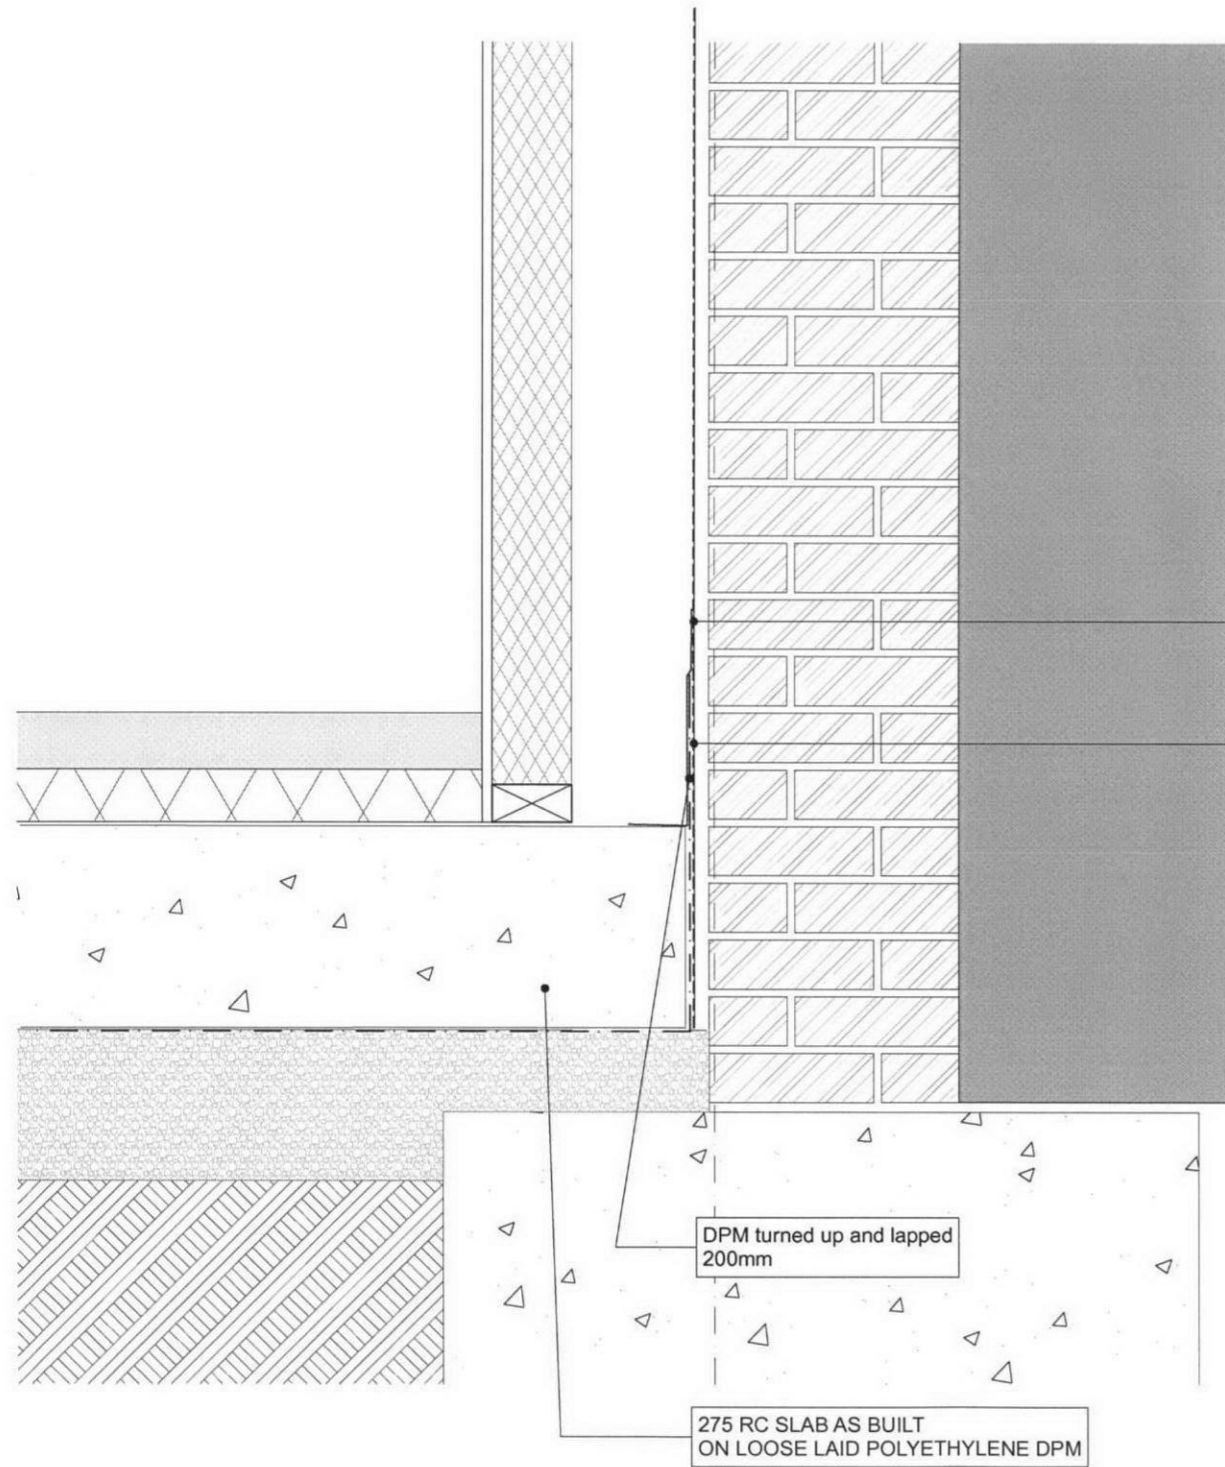


This drawing is to be read in conjunction with all other related drawings. Do not scale from this drawing. All dimensions must be checked and verified on site before commencing any work or producing shop drawings. The originator must be notified of any discrepancies. This drawing is copyright and remains the property of SPURWIEN

Key Plan Phase 2

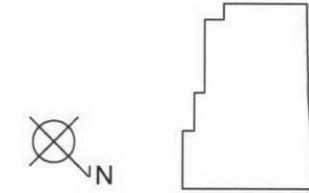

340mm PARTY WALL
2 COAT DAMP PROOF MEMBRANE (RIW Liquid Asphaltic Composition)
160mm CAVITY

150 Wide band of RIW Sheetseal 226
to link DPM to Membrane

DPM turned up and lapped
200mm

275 RC SLAB AS BUILT
ON LOOSE LAID POLYETHYLENE DPM

Rev	Date	Notes

Job Title
York Way
Residential Development
141-143 York Way, London N7 9LG

Drawing Status
Application for Removal of Condition No. 6
Reference 2007/1392/P

Client
Chelland Properties
Alleyn Park
West Dulwich
London SE21 85SF

Drawing Name
Party Wall/Rear Extension Tanking Detail

Drawn by: ES
Checked by: FE
Date drawn: December 2010
Date issued: December 2010

Drawing Scale
1:10 @ A3
/SM

Project No / Dwg No Revision
0604/ 1456

SPUR Architects
102 Belsize Lane, London NW3 5BB
Tel.: 203 384 55 87
office@spur.co.at



DETAIL 56 Party Wall/Rear Extension Tanking Detail