


NOTES:

1. This drawing is copyright of Scancon Architects Ltd.
2. Use figured dimensions only. Do not scale.
3. Contractors to notify architect immediately of any dimensional discrepancy.

Revisions:

/ - 17.12.2010 - Issued as part of an Application for listed building consent for alterations, extension or demolition of a listed building

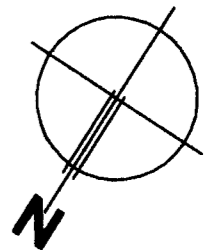

KEY:

- 200 Dimensions to finishes
- Approved or existing walls
- New walls to be approved
- Walls to be removed
- Walls as approved in 2004 permission
- Walls as built after 2004 permission

drawing status:

PLANNING

job title:

**56 ALBERT STREET
Top Floor Flat
London NW1 7NR**

client:

James Williams

des. title:

**AS BUILT
Second Floor Plan**


drawn: MK | audited: - | date: 12/10 | scale: 1:50@A3

job No: **0099** | des. No: **PL 03** | rev: /

Wall to former dressing room has been removed

Bathroom and surrounding walls, as built after gaining planning permission in 2004

Bathroom and surrounding walls as approved in the 2004 planning permission

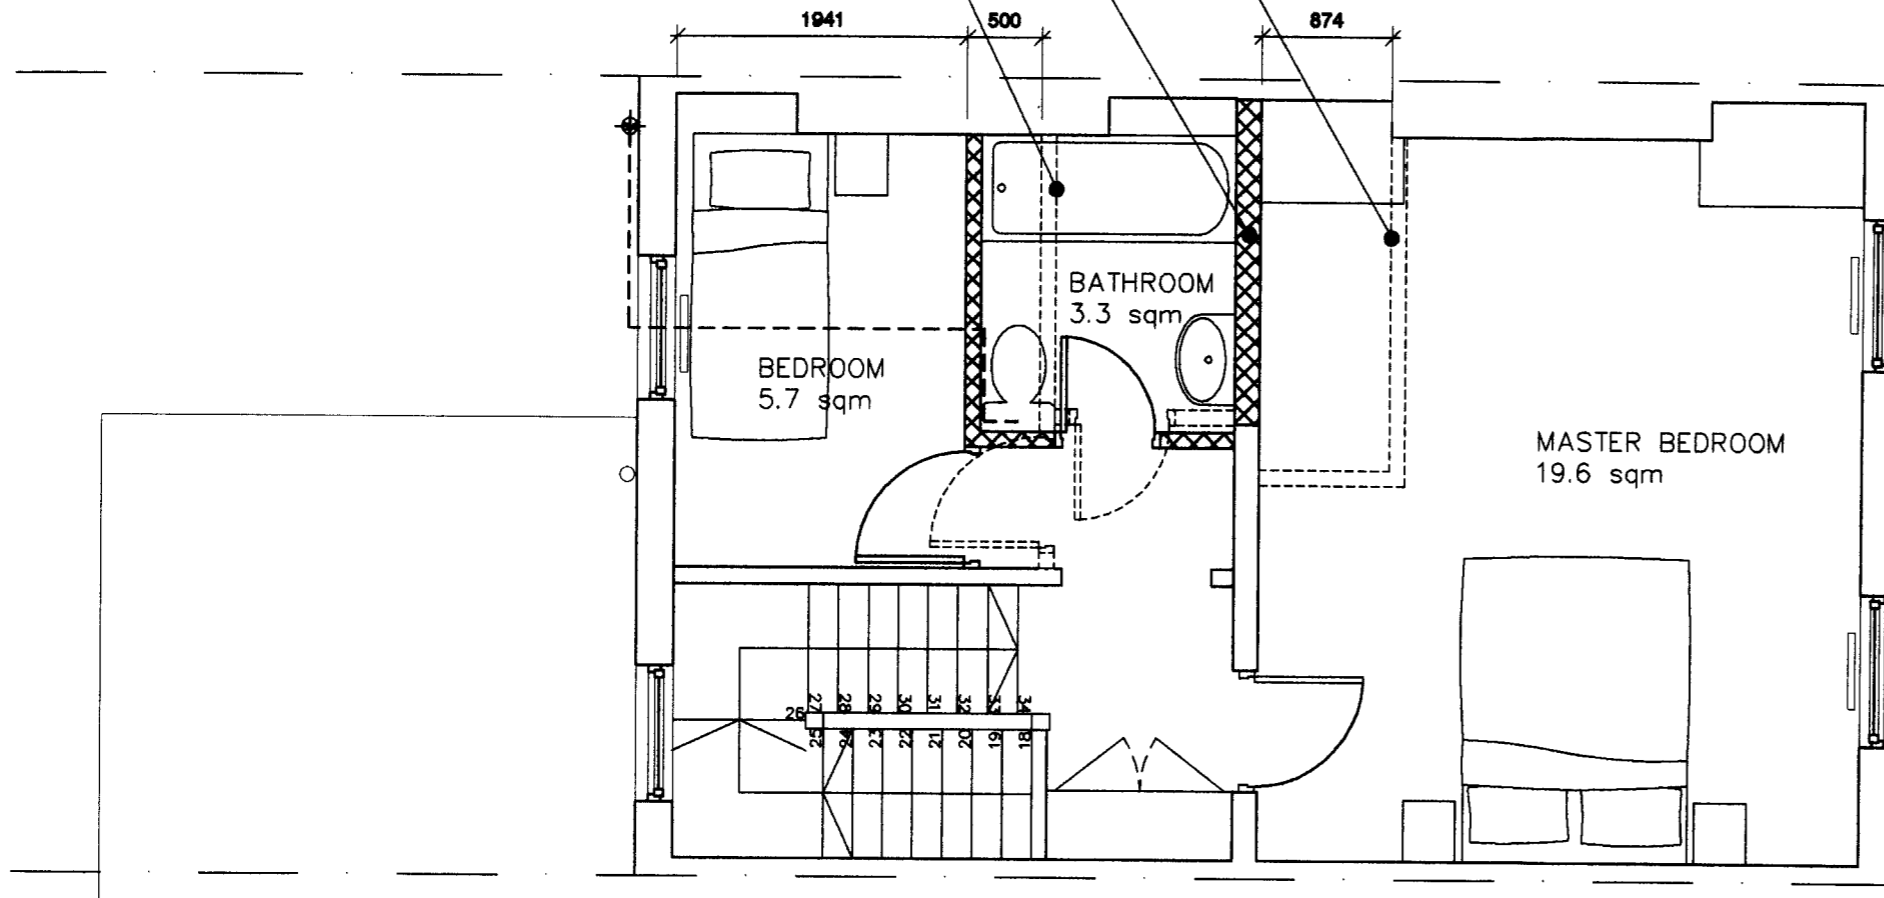

54 ALBERT STREET

56 ALBERT STREET
APPLICATION SITE

58 ALBERT STREET