


All Souls Church

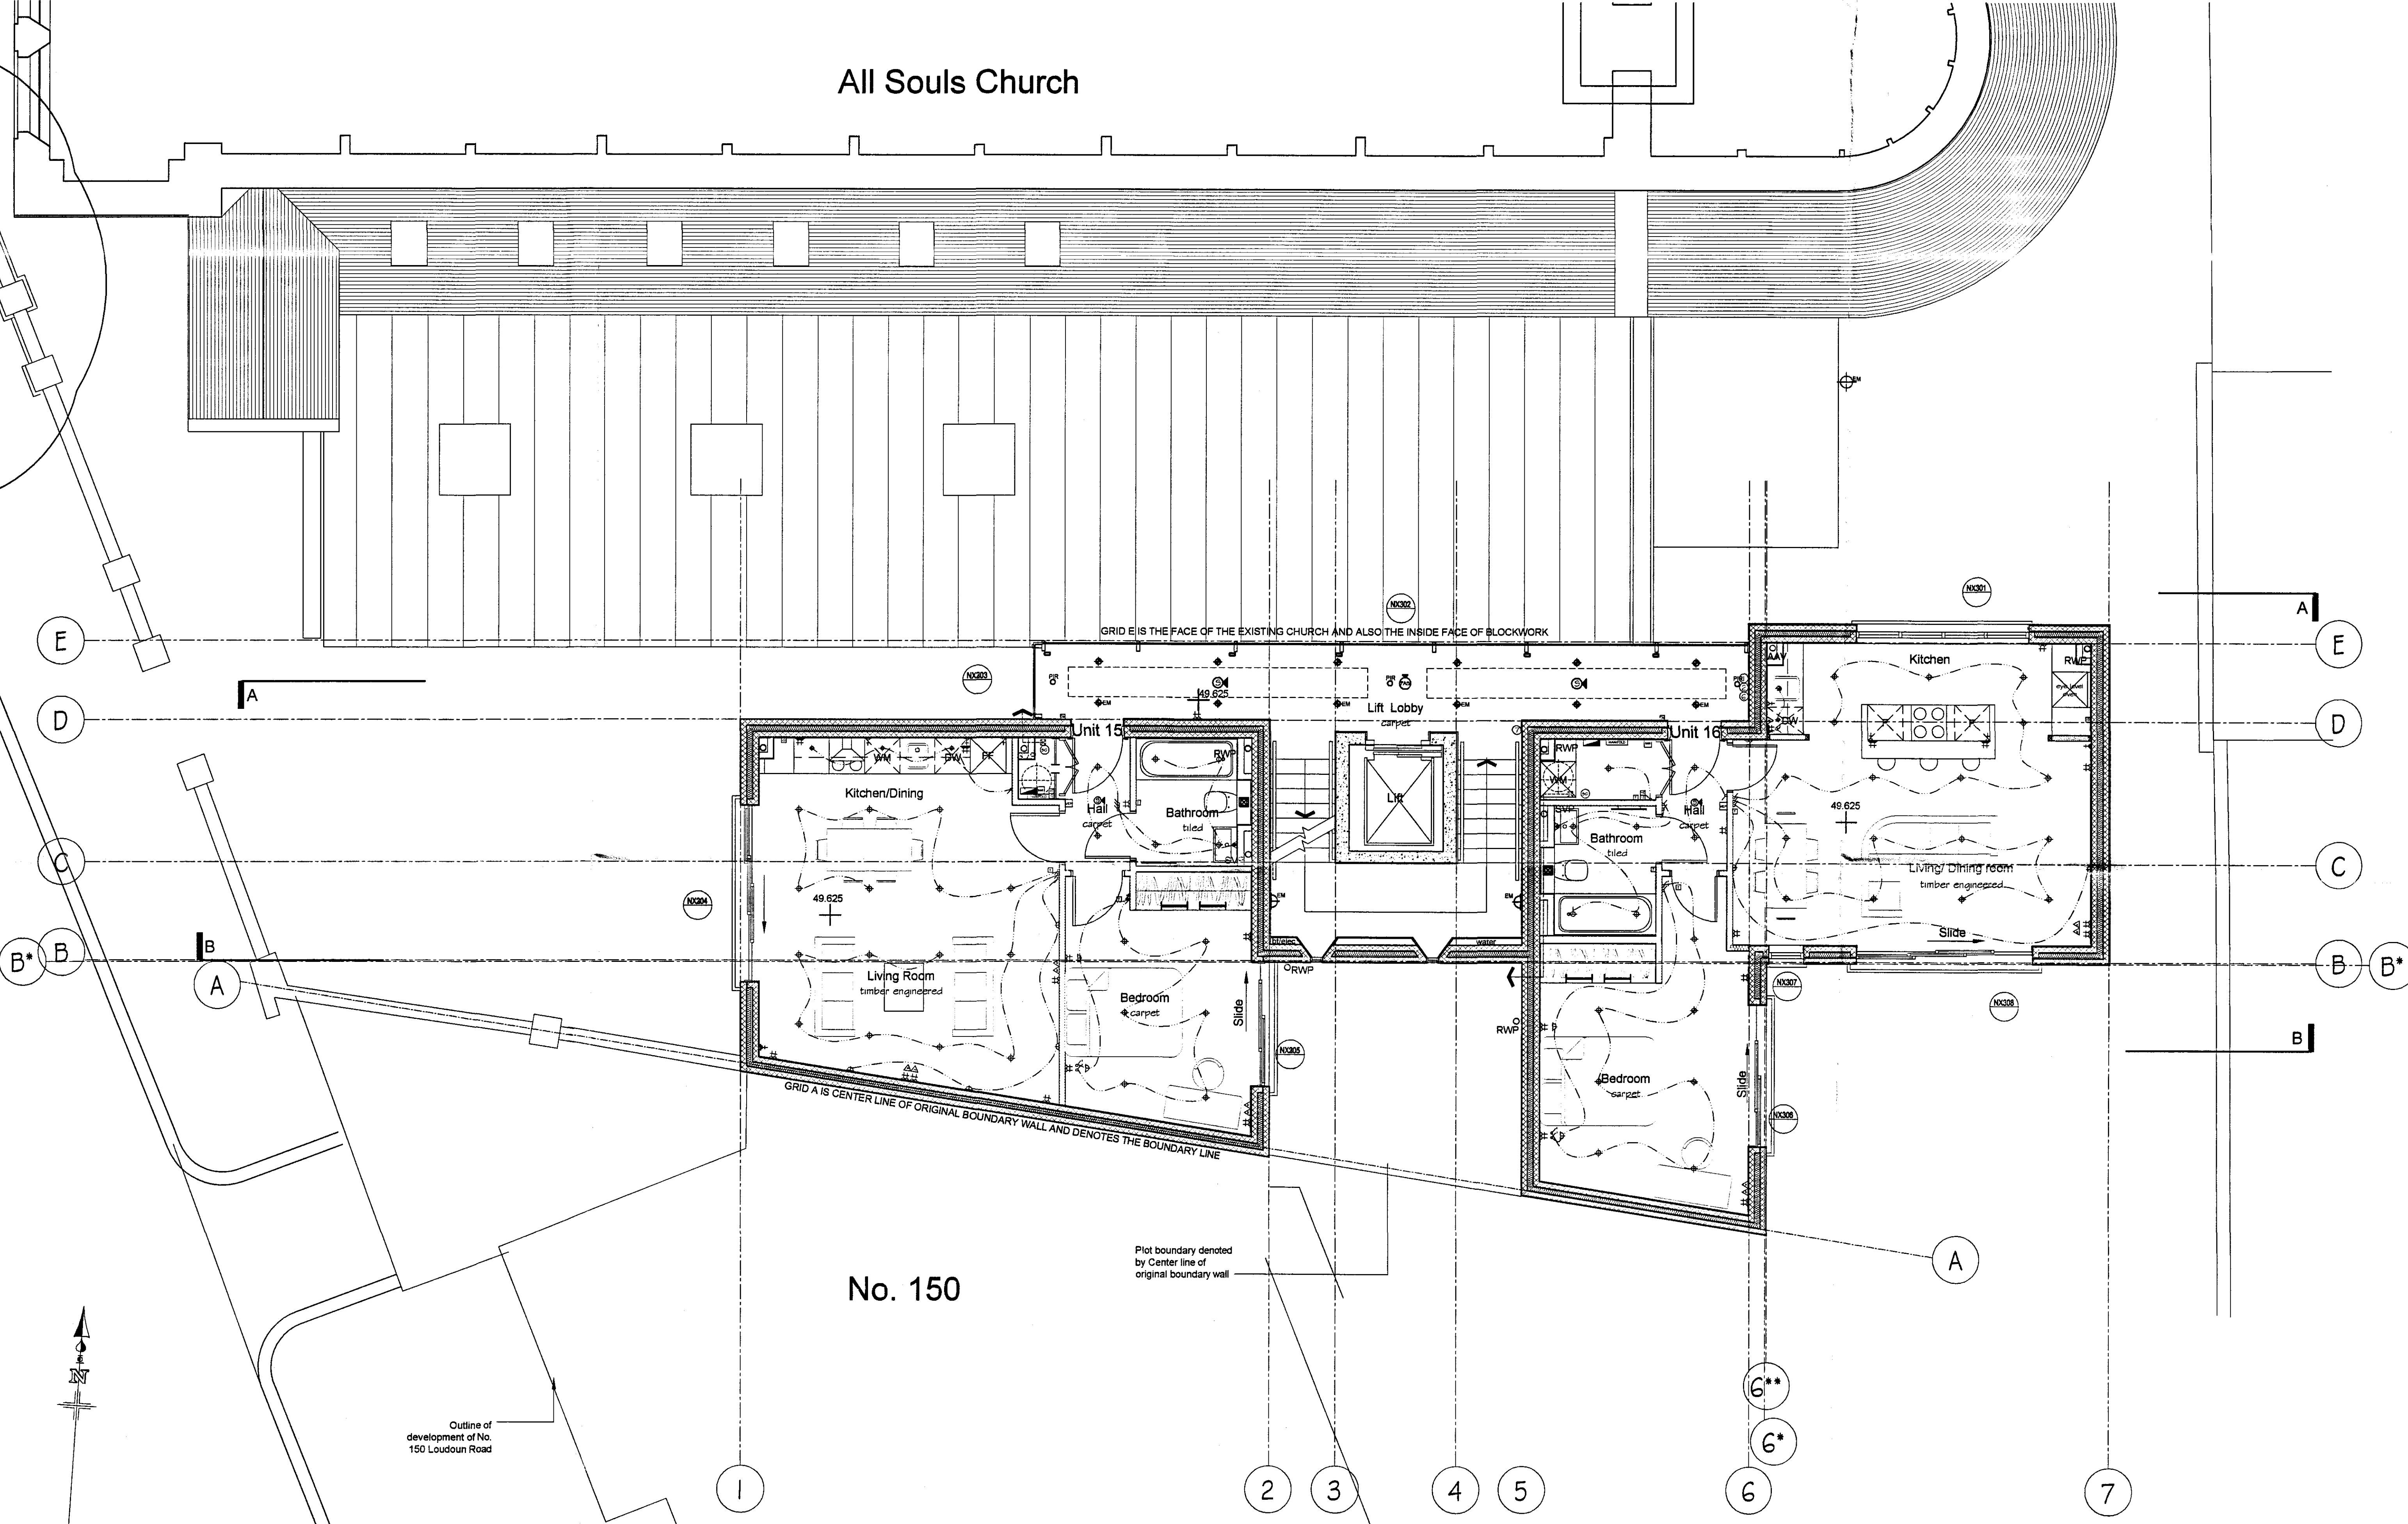

Notes No scaled dimensions to be taken from this drawing. All dimensions to be site checked.

<p>Downlighter</p> <p>Wall mounted directional movement sensor</p> <p>Ceiling mounted 360° movement sensor</p> <p>Grille (indicated on floor plan)</p> <p>Emergency wall light</p> <p>Wall light</p> <p>Sensor</p> <p>Sensor Fan</p> <p>Extractor Fan</p> <p>Downlighter</p>	<p>Emergency downlighter</p> <p>Light Switch</p> <p>Break Glass Contact</p> <p>Dispersible alarm</p> <p>Video Entry Phone</p> <p>Fire alarm panel</p> <p>Fire alarm control panel</p> <p>Fire alarm pull station</p> <p>Flex Outlet</p> <p>Flex Indicator</p> <p>Fused Spur</p> <p>Boiler with emergency light</p> <p>Pendant Light</p> <p>Transformer with emergency</p> <p>High level double socket</p> <p>Low level double socket</p> <p>Low level 3-way 100VAC</p> <p>Shelvet Valve</p> <p>Service Valves</p>	<p>Shelvet socket</p> <p>Indicator Switch</p> <p>Surface mounted valve</p> <p>Fluorescent light</p> <p>Boiler</p> <p>Transformer</p> <p>Salvage Junction box</p> <p>Consumer Unit</p> <p>Two way light switch</p> <p>3 line water fire extinguisher</p> <p>Indicator Switch</p> <p>3 line (AP7) fire extinguisher</p> <p>Fire exit light directional sign 150mm depth with 100mm Ø</p> <p>Fire exit light directional sign 150mm depth with 100mm Ø</p> <p>Fire exit sign (300mm x 100mm) with 100mm Ø</p> <p>Fire exit sign (300mm x 100mm) with 100mm Ø</p> <p>Fire exit sign (300mm x 100mm) with 100mm Ø</p> <p>Fire exit sign (300mm x 100mm) with 100mm Ø</p> <p>Fire exit sign (300mm x 100mm) with 100mm Ø</p> <p>Fire exit sign (300mm x 100mm) with 100mm Ø</p> <p>Fire exit sign (300mm x 100mm) with 100mm Ø</p> <p>Fire exit sign (300mm x 100mm) with 100mm Ø</p>
------------------------------------------------------------------------------------------------------------------------------------------------------------------------------------------------------------------------------------------------------------------------------	-------------------------------------------------------------------------------------------------------------------------------------------------------------------------------------------------------------------------------------------------------------------------------------------------------------------------------------------------------------------------------------------------------------------------------------------------------------------------------------------------------------------	---------------------------------------------------------------------------------------------------------------------------------------------------------------------------------------------------------------------------------------------------------------------------------------------------------------------------------------------------------------------------------------------------------------------------------------------------------------------------------------------------------------------------------------------------------------------------------------------------------------------------------------------------------------------------------------------------------------------------------------------------------------------------------------------------------------------------------------------------------------------------------

<table border="1"> <thead> <tr> <th>Rev</th> <th>Date</th> <th>Revision</th> <th>Initials</th> <th>Rev</th> <th>Date</th> <th>Revision</th> <th>Initials</th> </tr> </thead> <tbody> <tr><td> </td><td> </td><td> </td><td> </td><td> </td><td> </td><td> </td><td> </td></tr> <tr><td> </td><td> </td><td> </td><td> </td><td> </td><td> </td><td> </td><td> </td></tr> <tr><td> </td><td> </td><td> </td><td> </td><td> </td><td> </td><td> </td><td> </td></tr> <tr><td> </td><td> </td><td> </td><td> </td><td> </td><td> </td><td> </td><td> </td></tr> <tr><td> </td><td> </td><td> </td><td> </td><td> </td><td> </td><td> </td><td> </td></tr> <tr><td> </td><td> </td><td> </td><td> </td><td> </td><td> </td><td> </td><td> </td></tr> <tr><td> </td><td> </td><td> </td><td> </td><td> </td><td> </td><td> </td><td> </td></tr> <tr><td> </td><td> </td><td> </td><td> </td><td> </td><td> </td><td> </td><td> </td></tr> </tbody> </table>	Rev	Date	Revision	Initials	Rev	Date	Revision	Initials																																																																	<p>project</p> <p>ALL SOULS CHURCH Loudoun Road London NW8</p> <p>client</p>	<p>drawing</p> <p>AS BUILT THIRD FLOOR PLAN</p> <table border="1"> <tr> <td>date</td> <td>scale</td> <td>drawn</td> <td>checked</td> </tr> <tr> <td>10/09</td> <td>1:50</td> <td>HK</td> <td>JE</td> </tr> <tr> <td>job no</td> <td>drawing no</td> <td>rev</td> <td></td> </tr> <tr> <td>6761</td> <td>234</td> <td></td> <td></td> </tr> </table>	date	scale	drawn	checked	10/09	1:50	HK	JE	job no	drawing no	rev		6761	234			<p>METROPOLITAN DEVELOPMENT CONSULTANCY</p> <p>66 Bickenhall Mansions, Bickenhall Street, London, W1U 6BX Telephone: 020 7486 6675 Fax: 020 7486 7206 Email: surveyors@mdlondon.com</p>
Rev	Date	Revision	Initials	Rev	Date	Revision	Initials																																																																																				
date	scale	drawn	checked																																																																																								
10/09	1:50	HK	JE																																																																																								
job no	drawing no	rev																																																																																									
6761	234																																																																																										