


NORTH ELEVATION

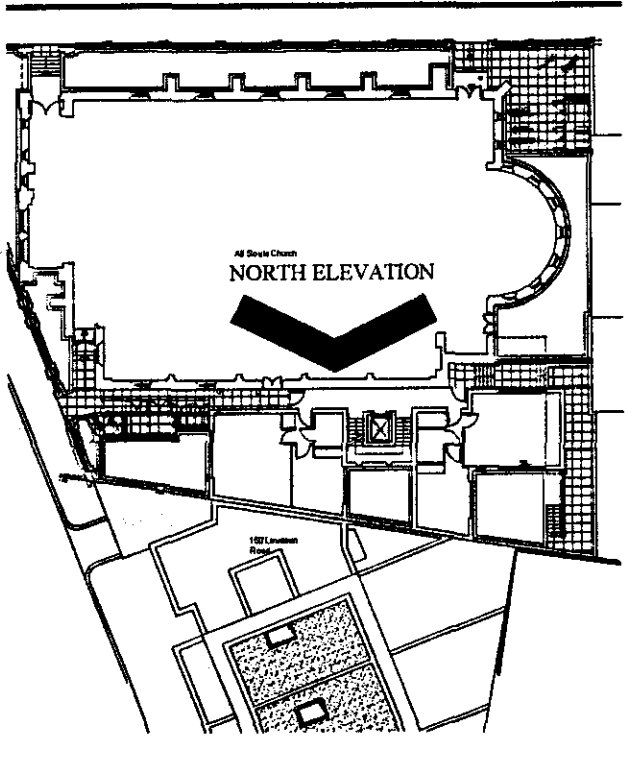

Notes No scaled dimensions to be taken from this drawing. All dimensions to be site checked.

Rev	Date	Revision	Initials	Rev	Date	Revision	Initials

project ALL SOULS CHURCH Loudoun Road, London, NW6		drawing AS BUILT NORTH ELEVATION NEW BUILD	
date	scale	drawn	checked
10/09	1:50@A1	LB	JE
job no	drawing no	rev	
8761	236		


METROPOLITAN DEVELOPMENT CONSULTANCY
 66 Bickenhall Mansions,
 Bickenhall Street, London, W1U 6BX
 Telephone: 020 7486 6675
 Fax: 020 7486 7206
 Email: surveyors@mdclondon.com