


S.O.P.

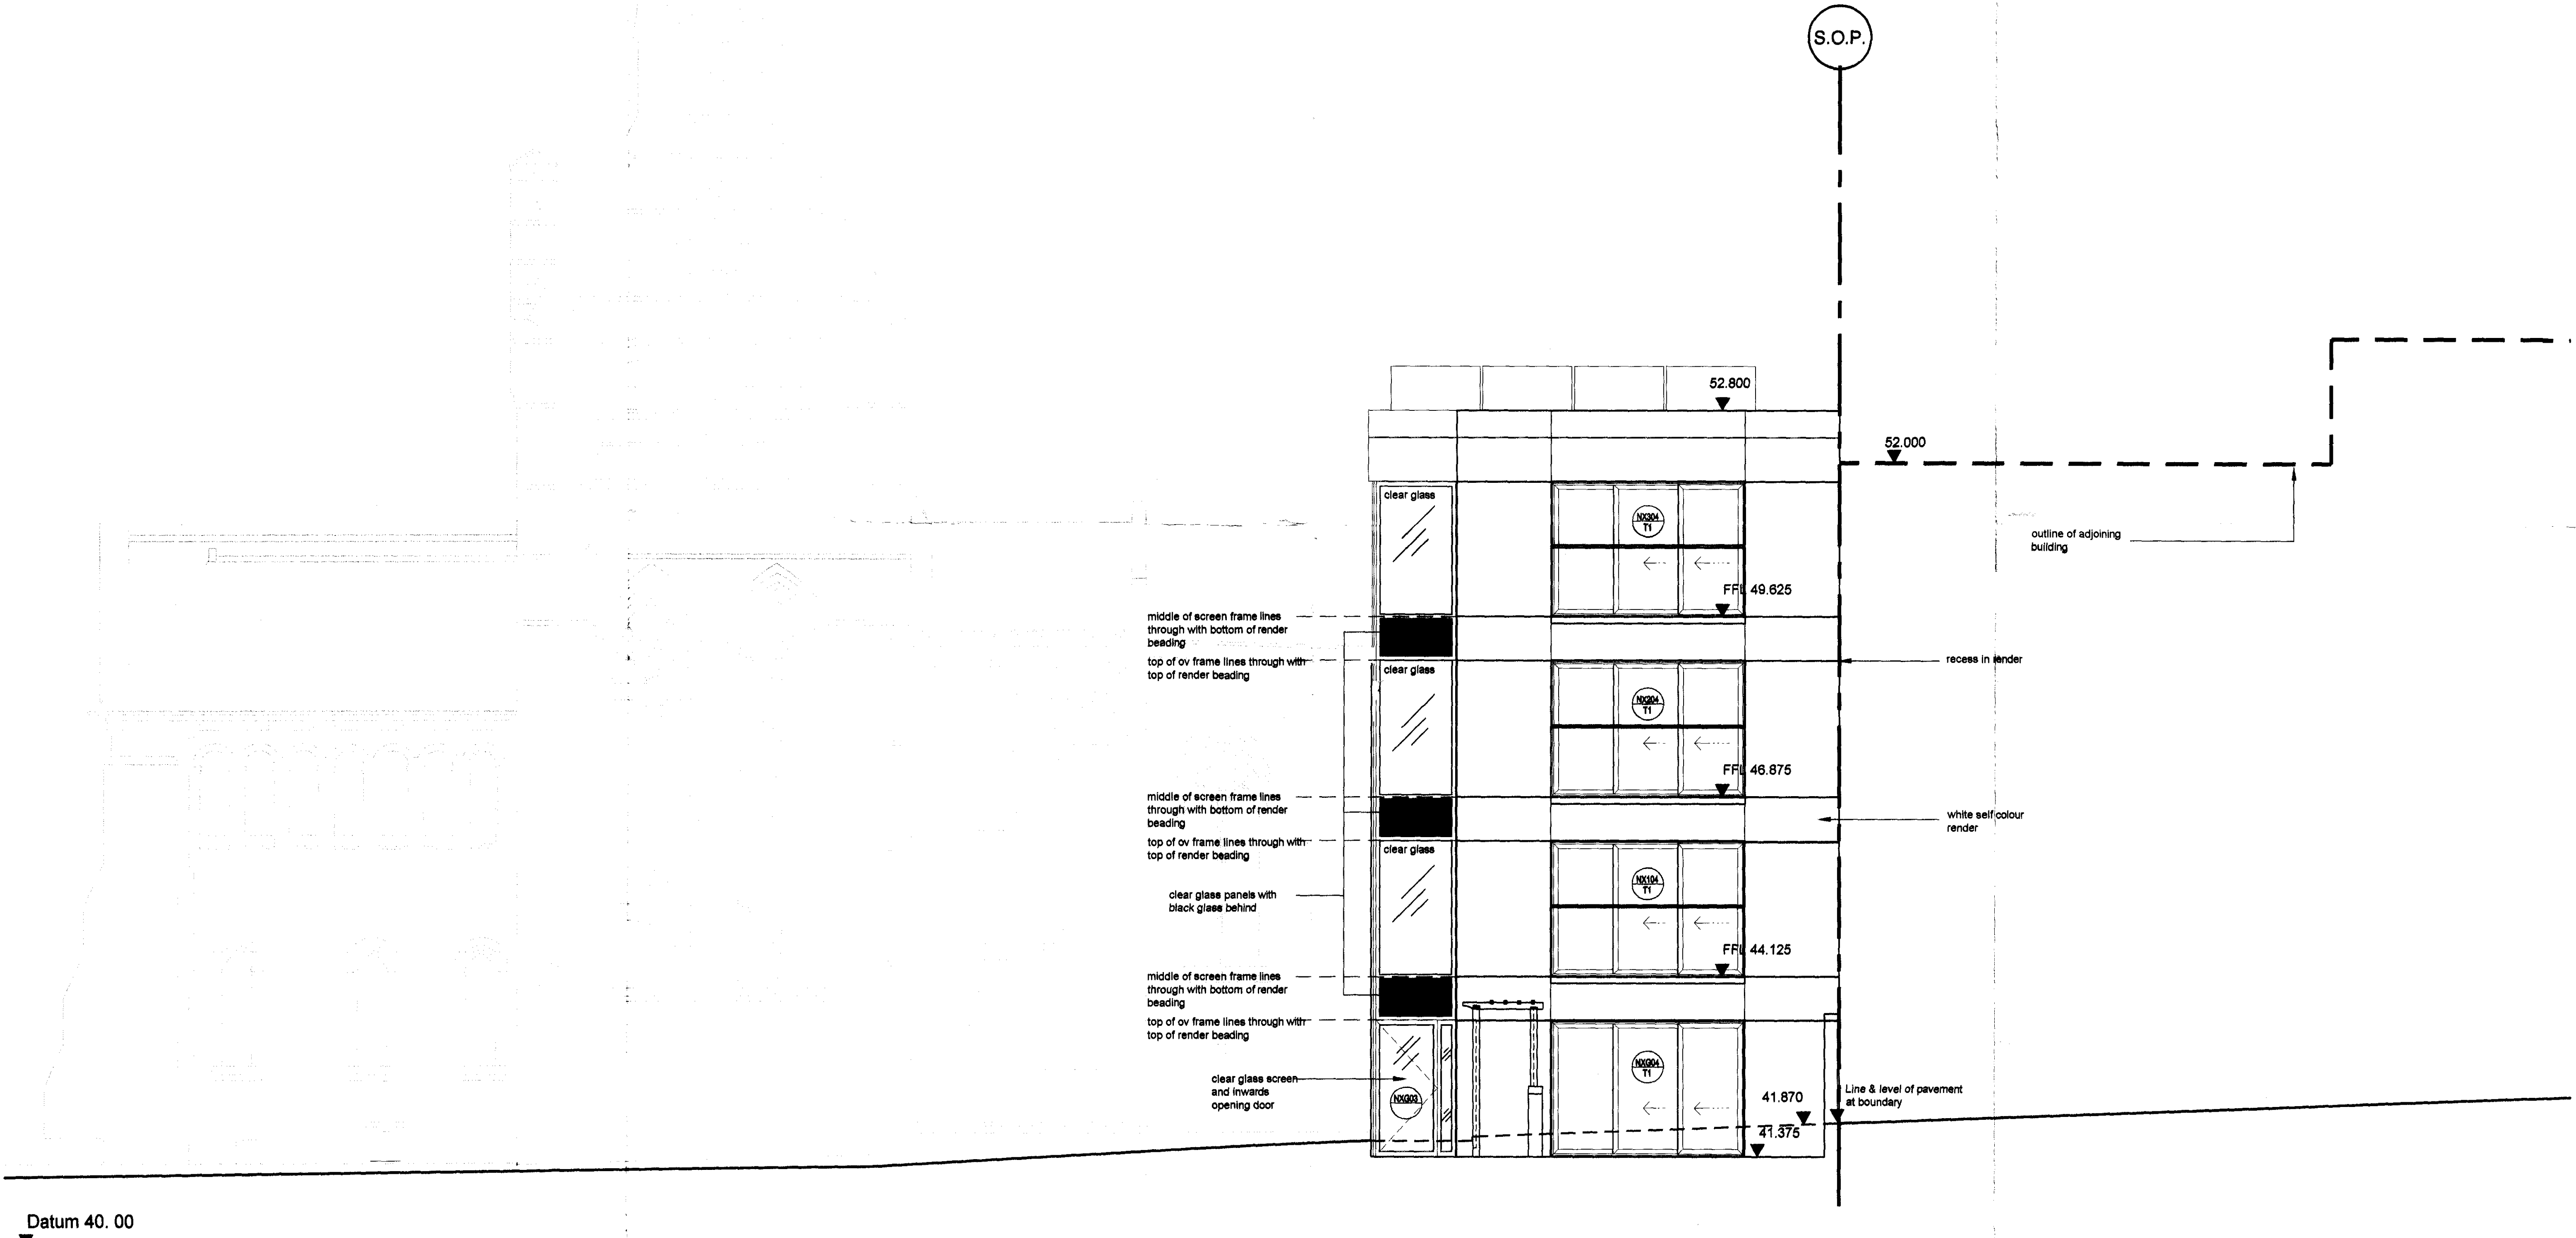

Datum 40.00


WEST ELEVATION

Notes No scaled dimensions to be taken from this drawing. All dimensions to be site checked.

Rev	Date	Revision	Initials	Rev	Date	Revision	Initials

project
 ALL SOULS CHURCH
 Loudoun Road,
 London,
 NW8
 client

drawing
 AS BUILT
 WEST ELEVATION
 NEW BUILD
 date 10/09 scale 1:50@A1 draw LB checked JE

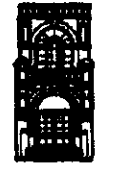 METROPOLITAN
 DEVELOPMENT
 CONSULTANCY
 66 Bickenhall Mansions,
 Bickenhall Street, London, W1U 6BX
 Telephone: 020 7486 6675