
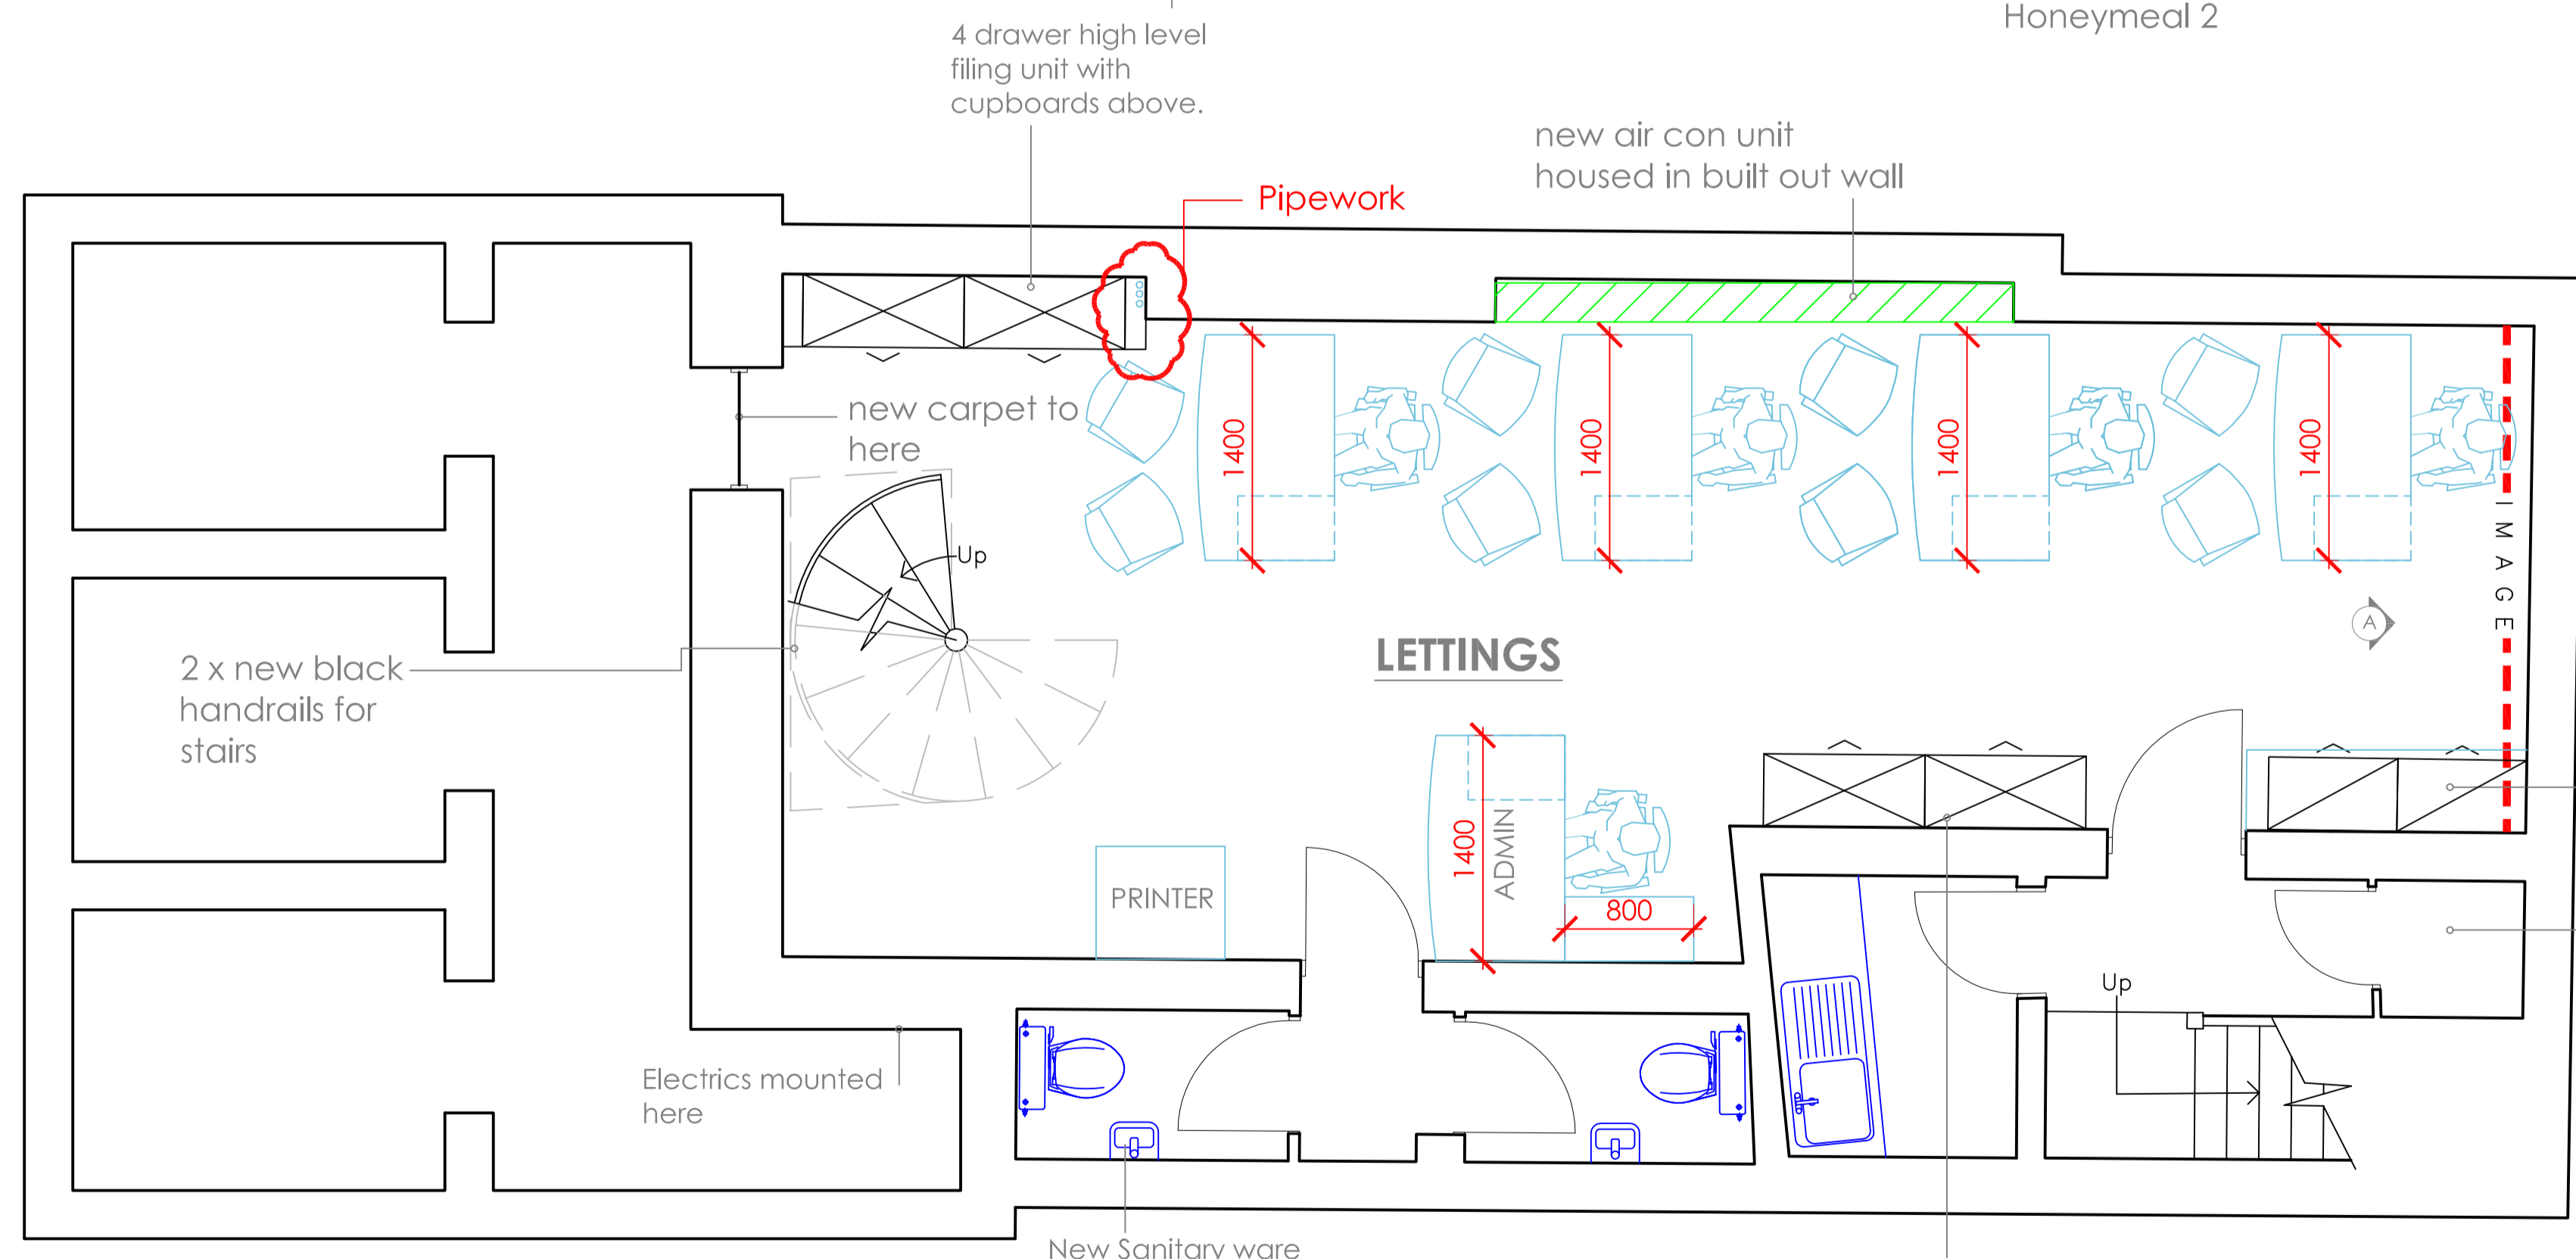


Legend:

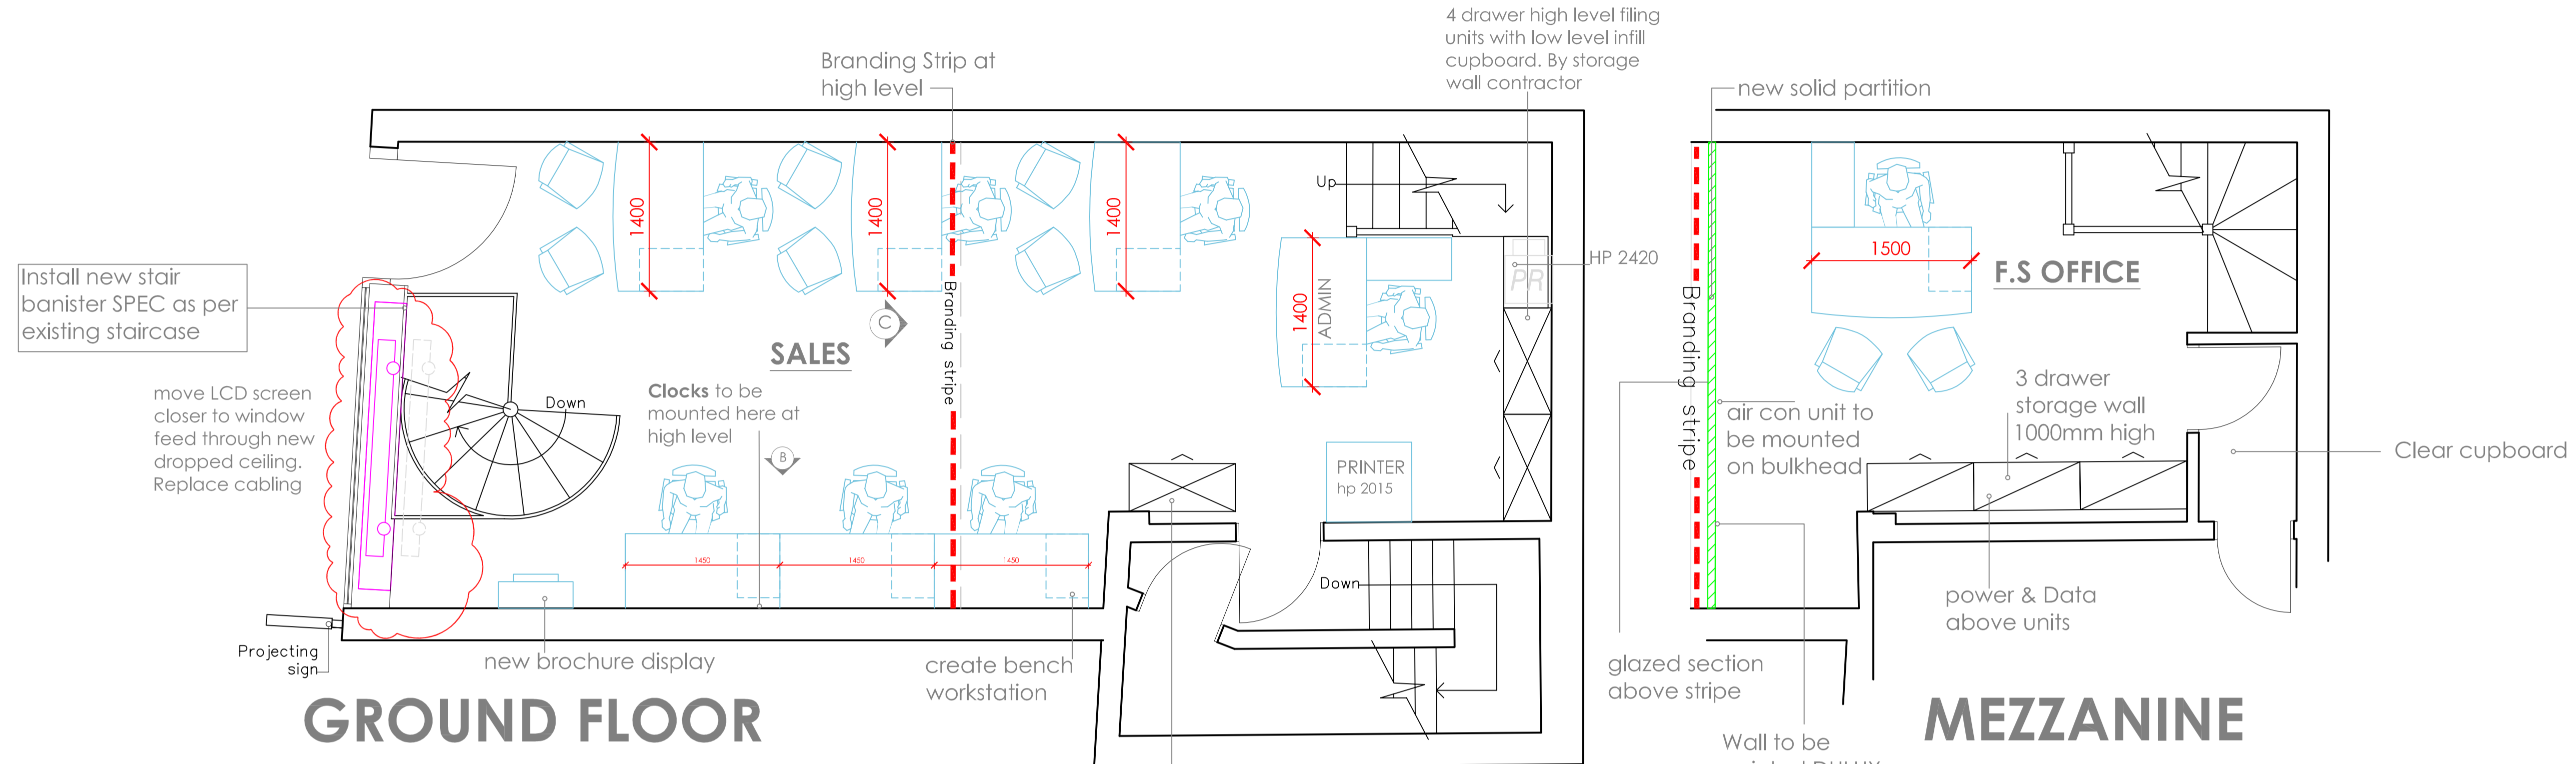

2 x 800mm wide **low level** 3 drawer unit. power & data above. Franking machine here

Retain existing comms rack & position LCD for Window display to go here

**FOR CONSTRUCTION**

Rev.	Alterations.	Date.
A	Amended following meeting	12.01.09
B	Amended to notes	15.02.09
C	Amended following site visit	19.2.09
D	Amended following site visit	01.09.09
E	Amended following TLC meeting	10.09.09
F	LCD-PC moved	30.9.09

**TLG**

TURNER LEGG CONSULTING LTD  
 3 PANNELLS COURT  
 GUILDFORD SURREY  
 GU1 4EU  
 TEL : 01483 306667  
 FAX : 01483 306668  
 WEB : www.turnerlegg.co.uk

Client KFH - Belsize park

Title General arrangement  
 Site 38 Englands lane  
 Belsize Park  
 London  
 NW3 4UE

Drawn by EM Date 28/12/08 Consultant TLC Scale 1:50@A2

Drawing number: 2081\_GAP\_001  
 Revision: F

Drawing status:  
 Concept options  
 Development / Tender  
 Construction approved  
 Completed / As built