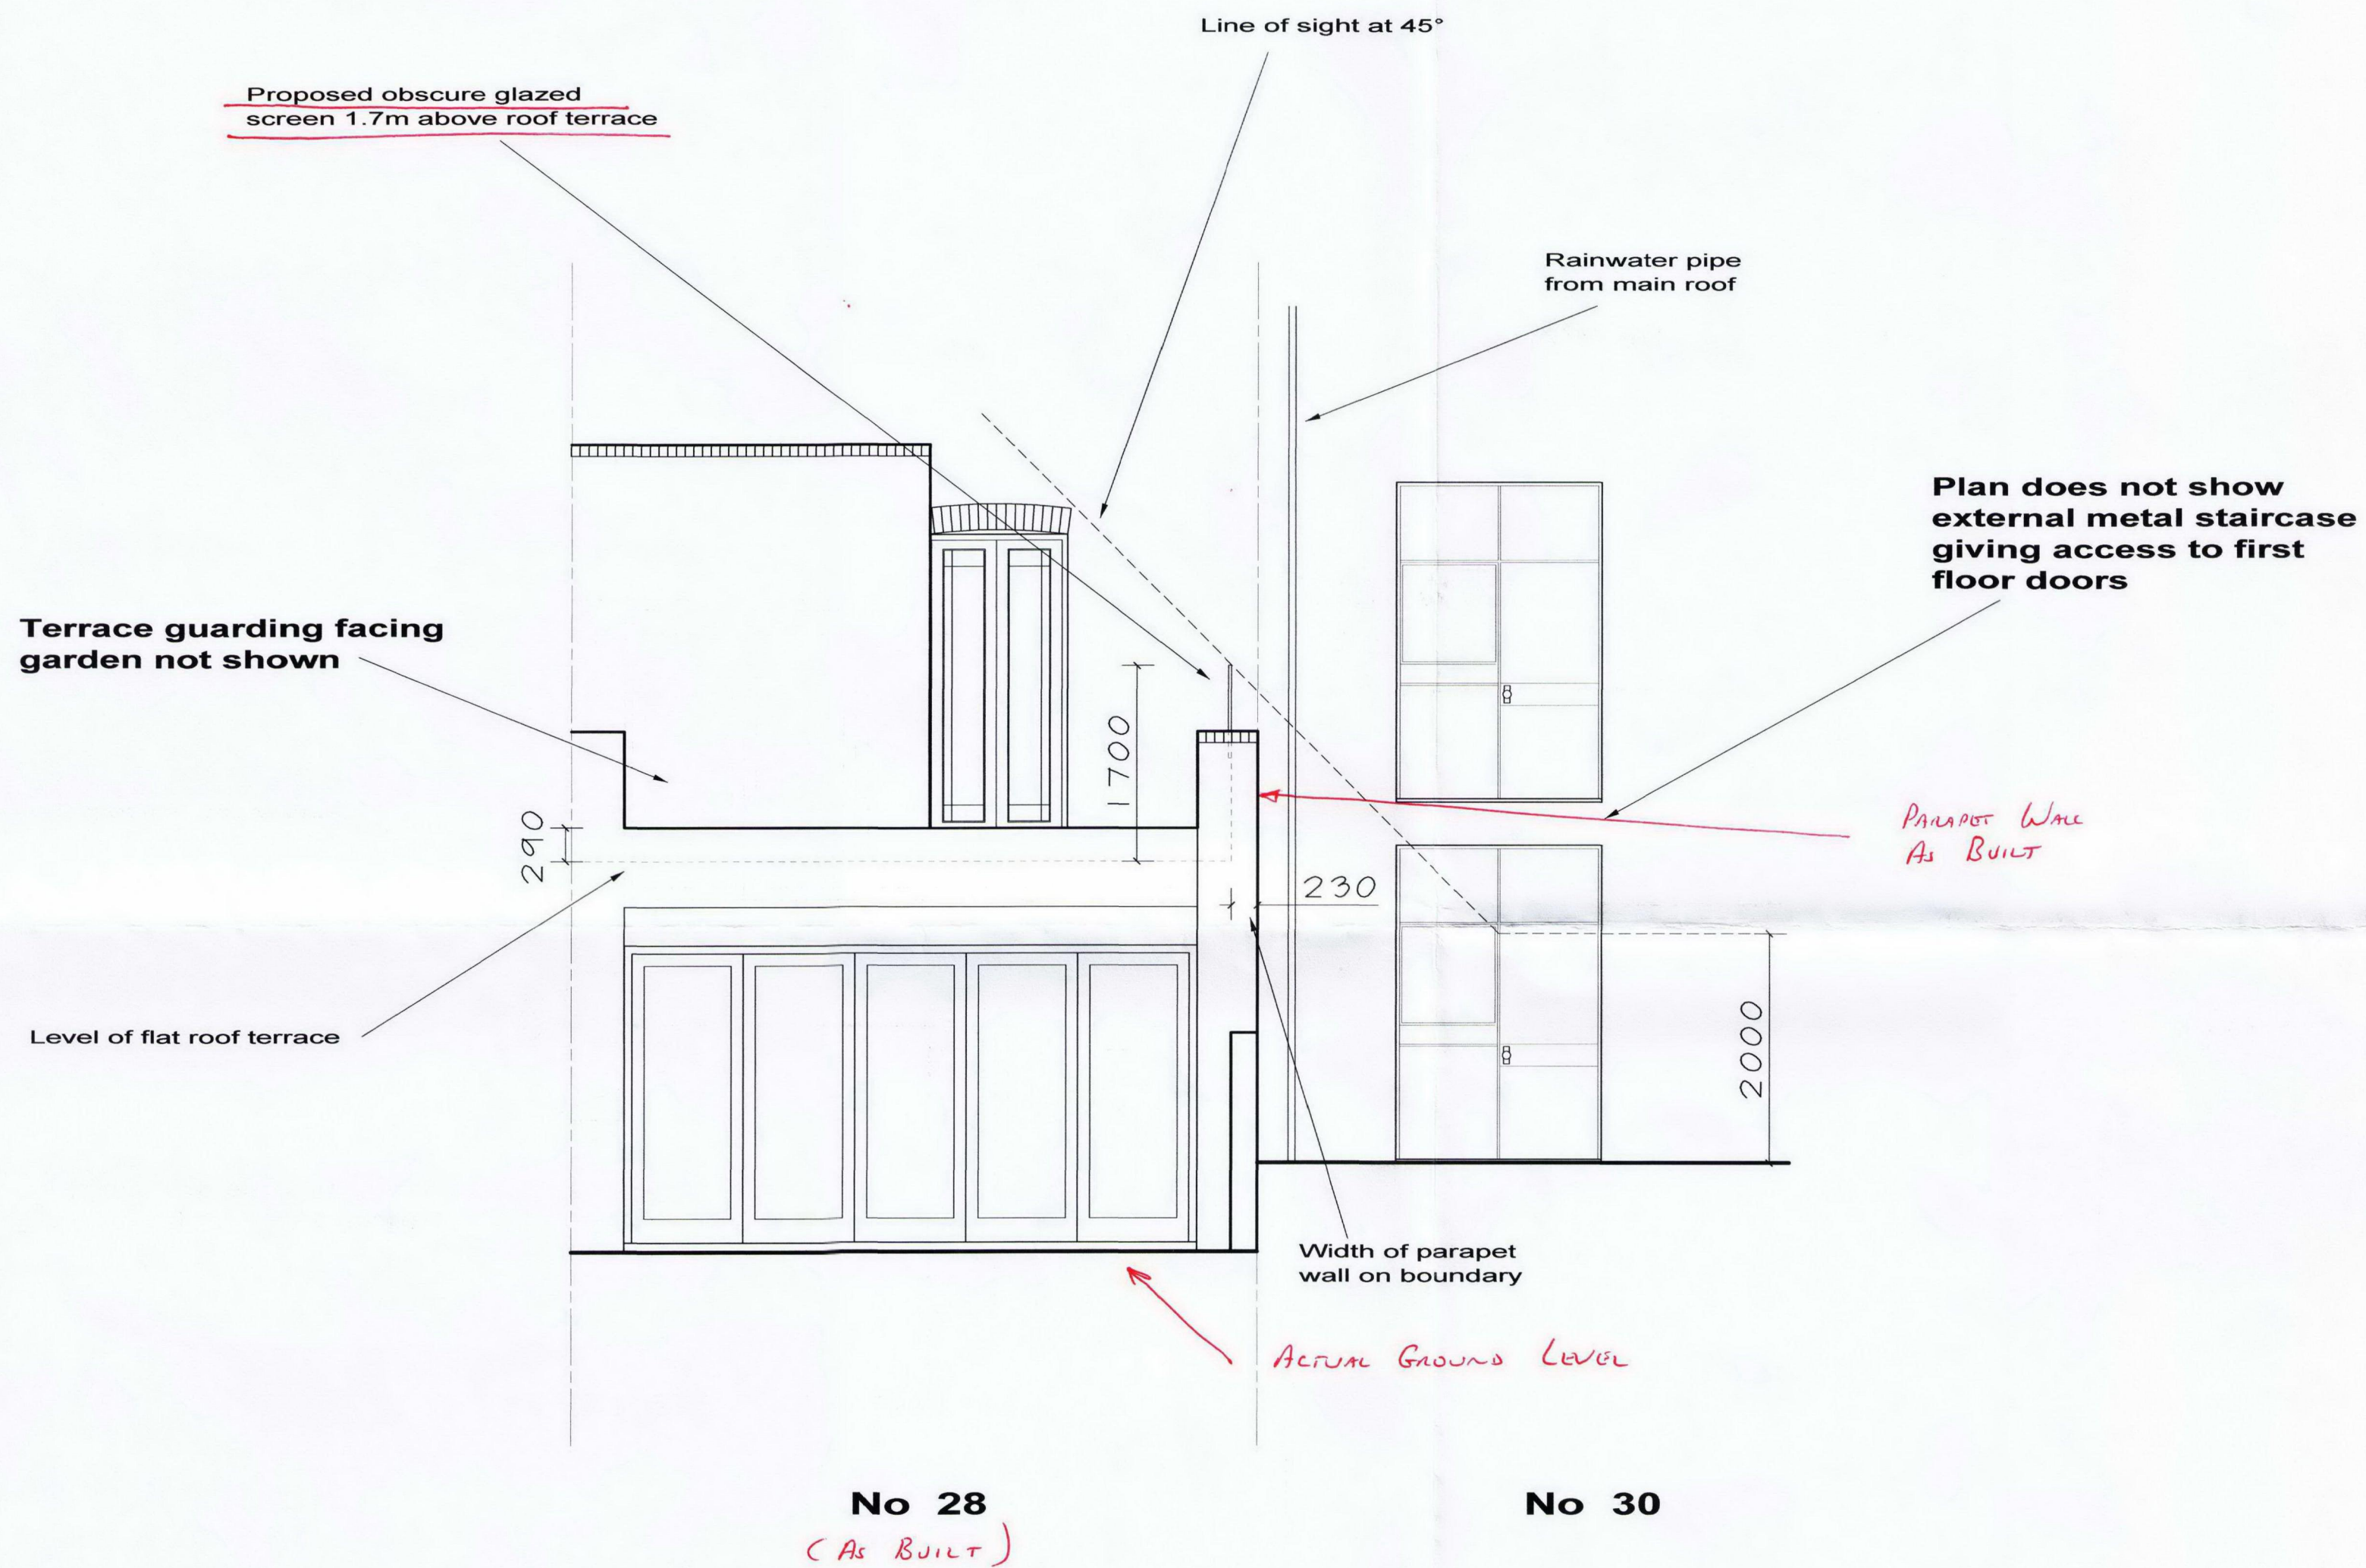


1/50 Bar Scale

Revision: A, Assititional info added Feb 10

Site
28 Lady Margaret Road,
London,
NW5 2XL.

Client
Mr & Mrs D Hall

Detail
Rear Elevation (As Built)

Scale	1/50	Drawing Number 3081/ 7A
Date	01/02/10	
Drawn by	JAS	

F.J. Thompson & Co

 Tel 01923 720277
Fax 01923 772910
email: surveys@fjthompson.co.uk

Old Kings Arms
30 Church Street
Rickmansworth
Hertfordshire
WD3 1DJ