
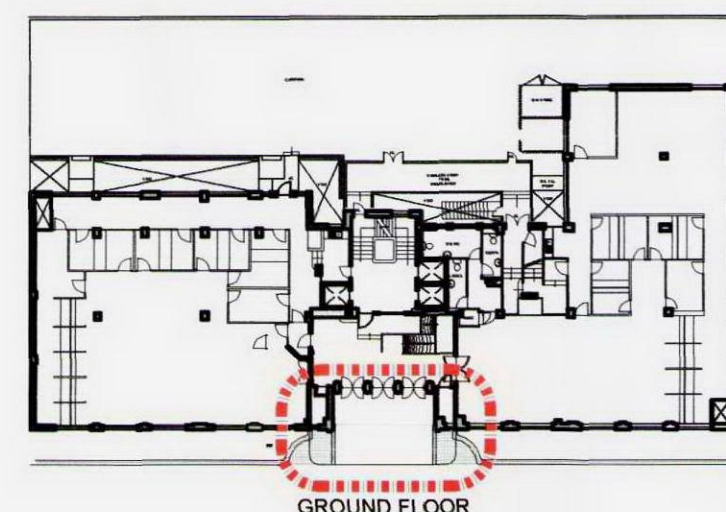


All dimensions must be checked on site and not scaled from this drawing.

0m 1m 2m 3m 4m 5m 6m 7m 8m 9m

NOTES:  
THIS DRAWING MUST BE SIGNED OTHERWISE IT WILL BE INVALID.  
BUILDING PARAMETERS TAKEN FROM AS BUILT DRAWINGS PROVIDED.  
CHECK SURVEY UNDERTAKEN ONLY.  
SUBJECT TO STATUTORY APPROVAL.  
ALL DIMENSIONS SHOWN ARE IN MILLIMETERS UNLESS OTHERWISE SHOWN.

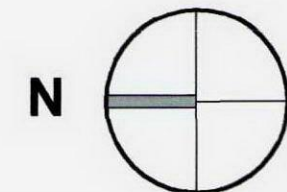

KEY PLAN

DRAWING CHECK LIST

- 1 Project number ? ☐
- 2 Surveyed building ? ☐
- 3 Partitions designed with HL grid, M&E services on ? ☐
- 4 Symbols on drawings match the key ? ☐
- 5 Partitioning types identified ? ☐
- 6 Acoustic barrier & ply identified ? ☐
- 7 New (N), Relocated (R) and Emergency (E) services identified ? ☐
- 8 Light switches and PIR's in all rooms ? ☐
- 9 Teapoints - does the detail match the plan ? ☐
- 10 Are the correct layers on/off ? ☐
- 11 Drawing issued to GSA ? ☐

DRAWING CHECKED BY:


DESIGNER \_\_\_\_\_ DATE \_\_\_\_\_  
INTERIOR ARCHITECT \_\_\_\_\_ DATE \_\_\_\_\_  
TECHNICAL DIRECTOR \_\_\_\_\_ DATE \_\_\_\_\_  
HEAD OF BUILDING SERVICES \_\_\_\_\_ DATE \_\_\_\_\_

DRAWING APPROVED BY:


SIGNED \_\_\_\_\_  
PRINT NAME \_\_\_\_\_  
ON BEHALF OF \_\_\_\_\_  
DATE \_\_\_\_\_

DRAWING APPROVED BY:


SIGNED \_\_\_\_\_  
PRINT NAME \_\_\_\_\_  
ON BEHALF OF **MARIS INTERIORS LLP**  
DATE \_\_\_\_\_

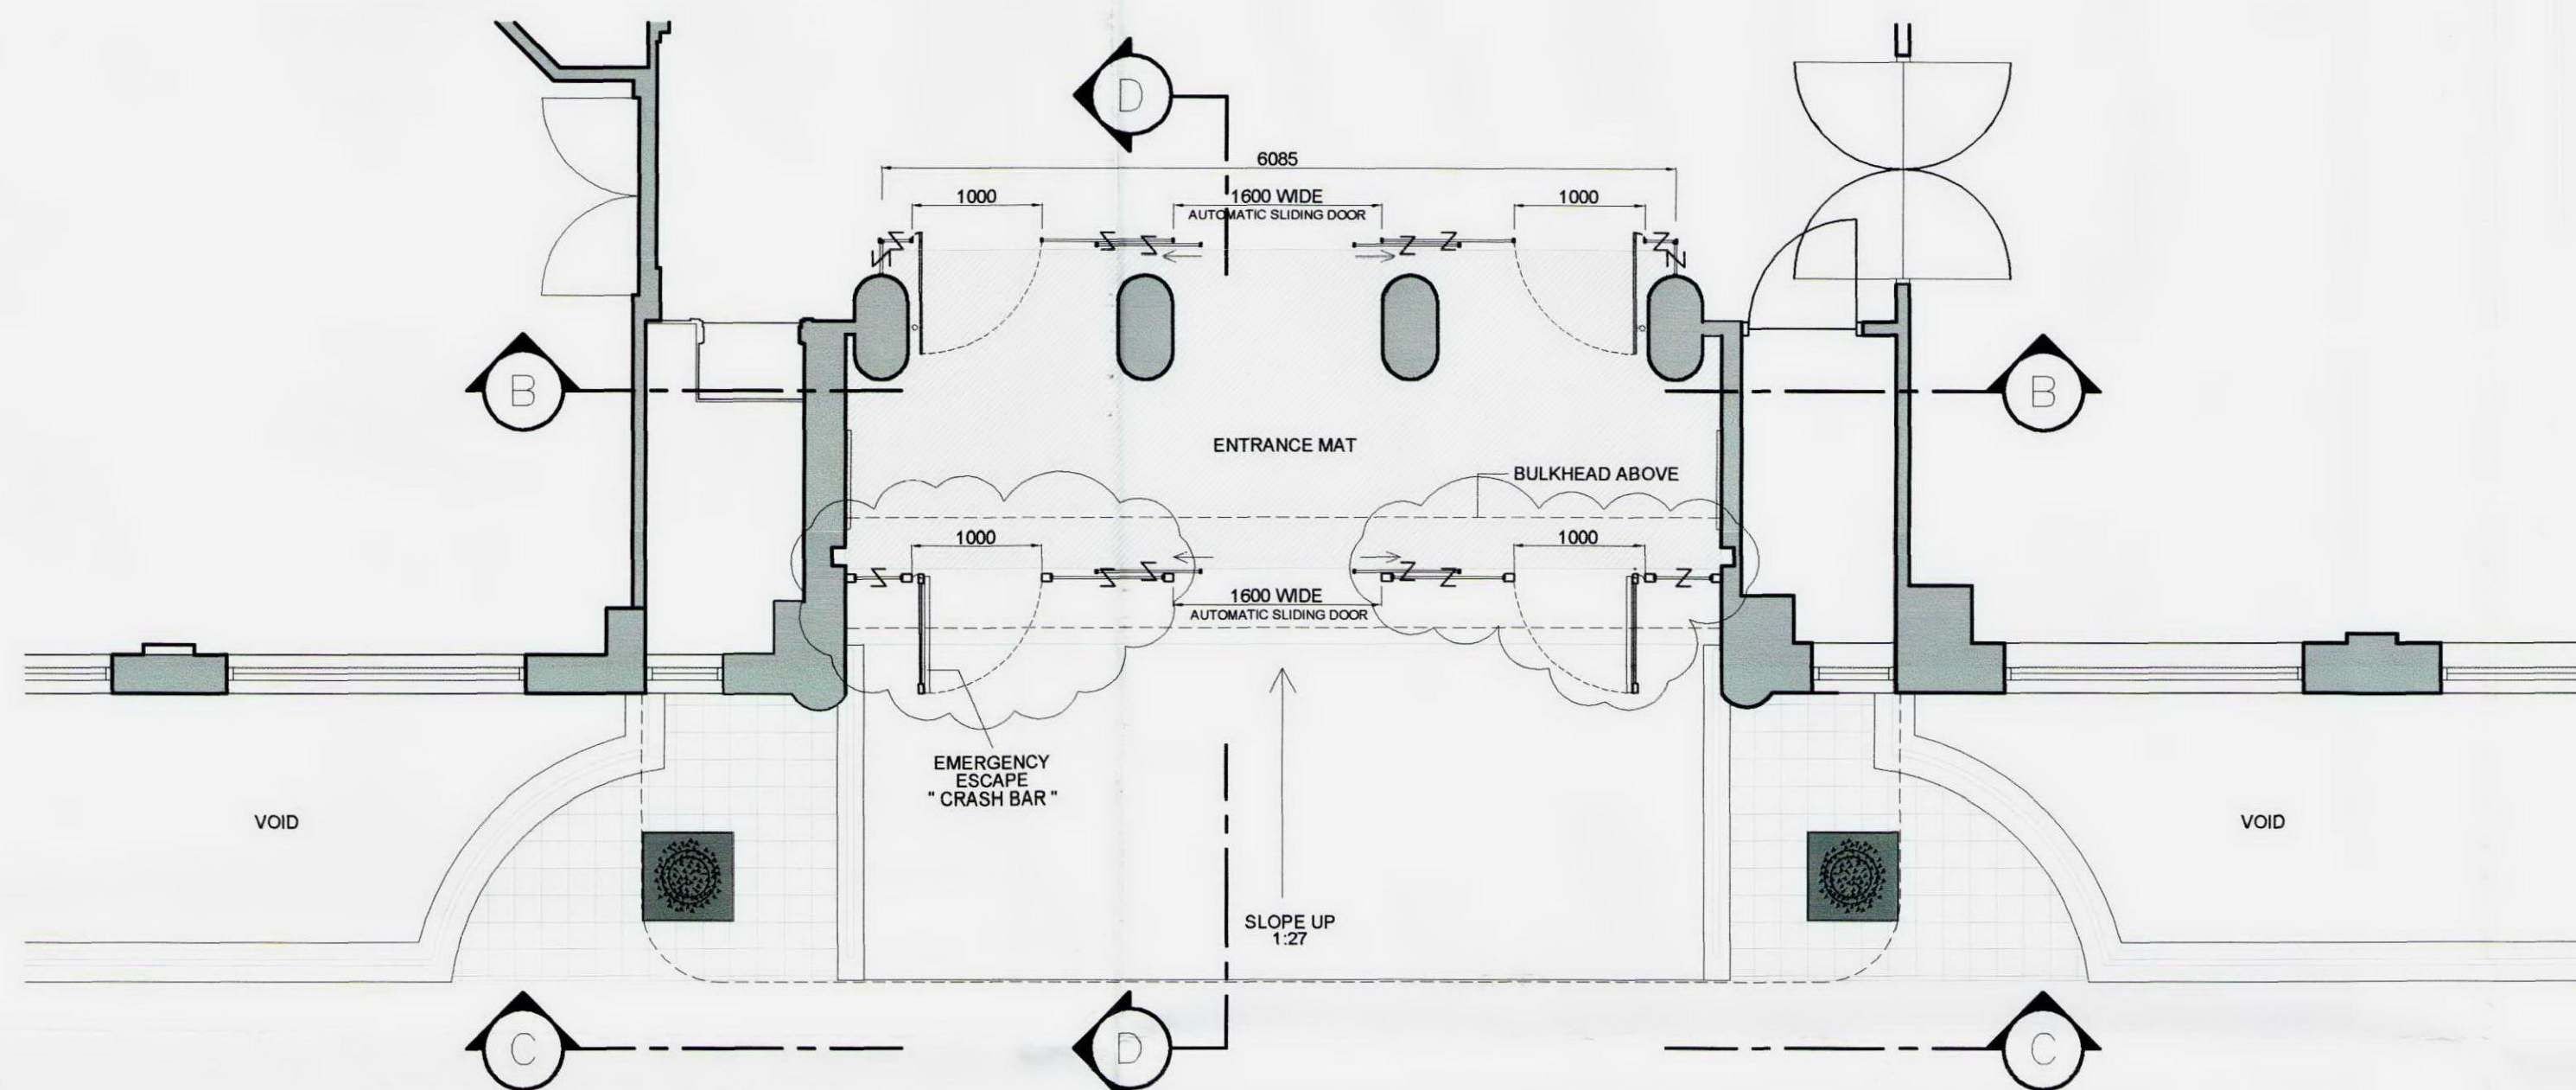


PROPOSED FRONT ENTRANCE PLAN  
SCALE : 1/50

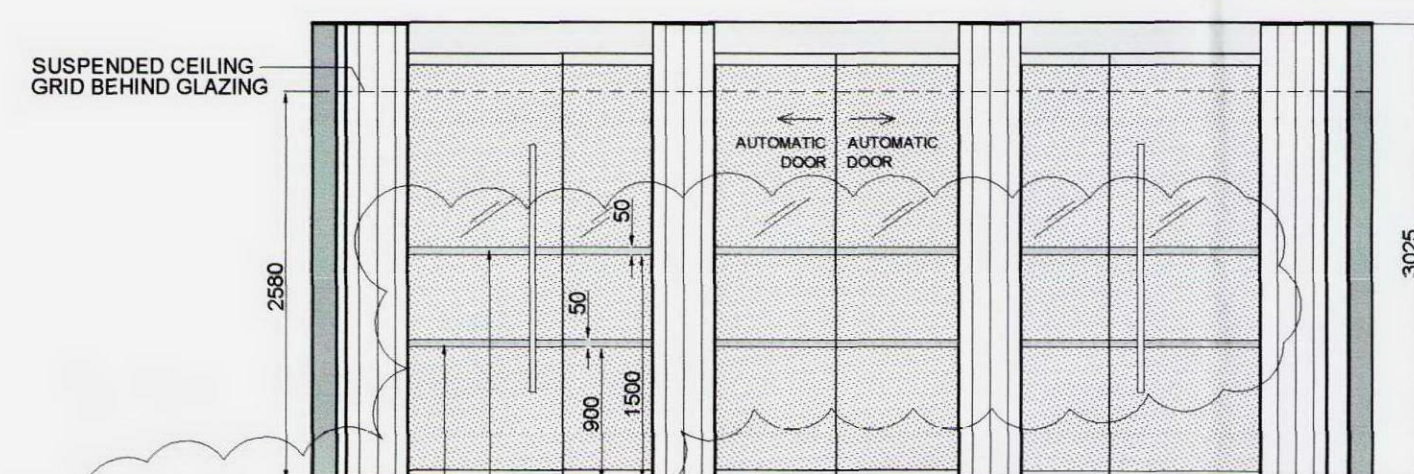

SECTION BB  
SCALE : 1/50

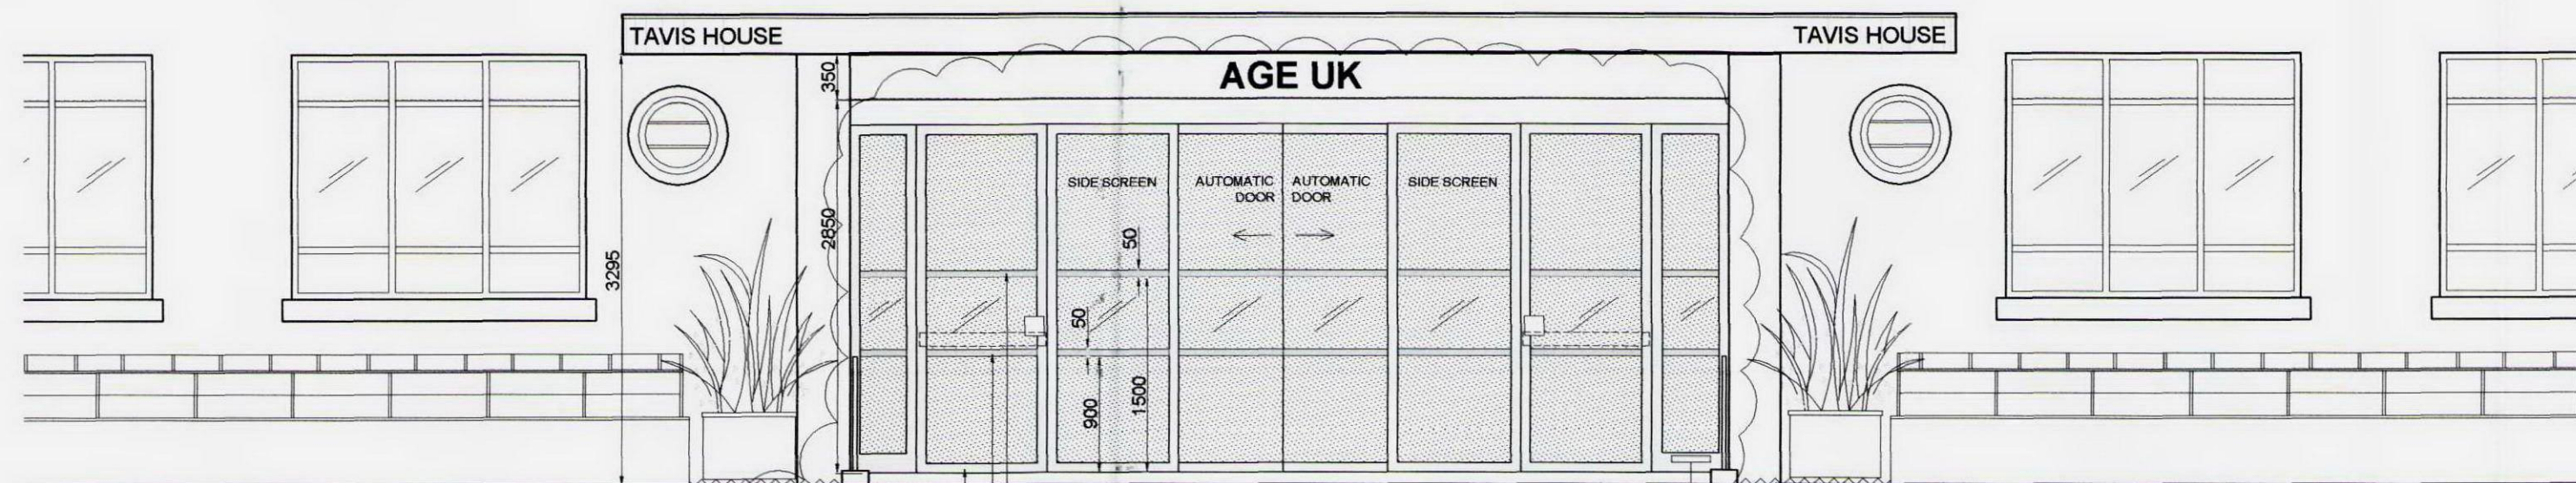

SECTION CC  
SCALE : 1/50

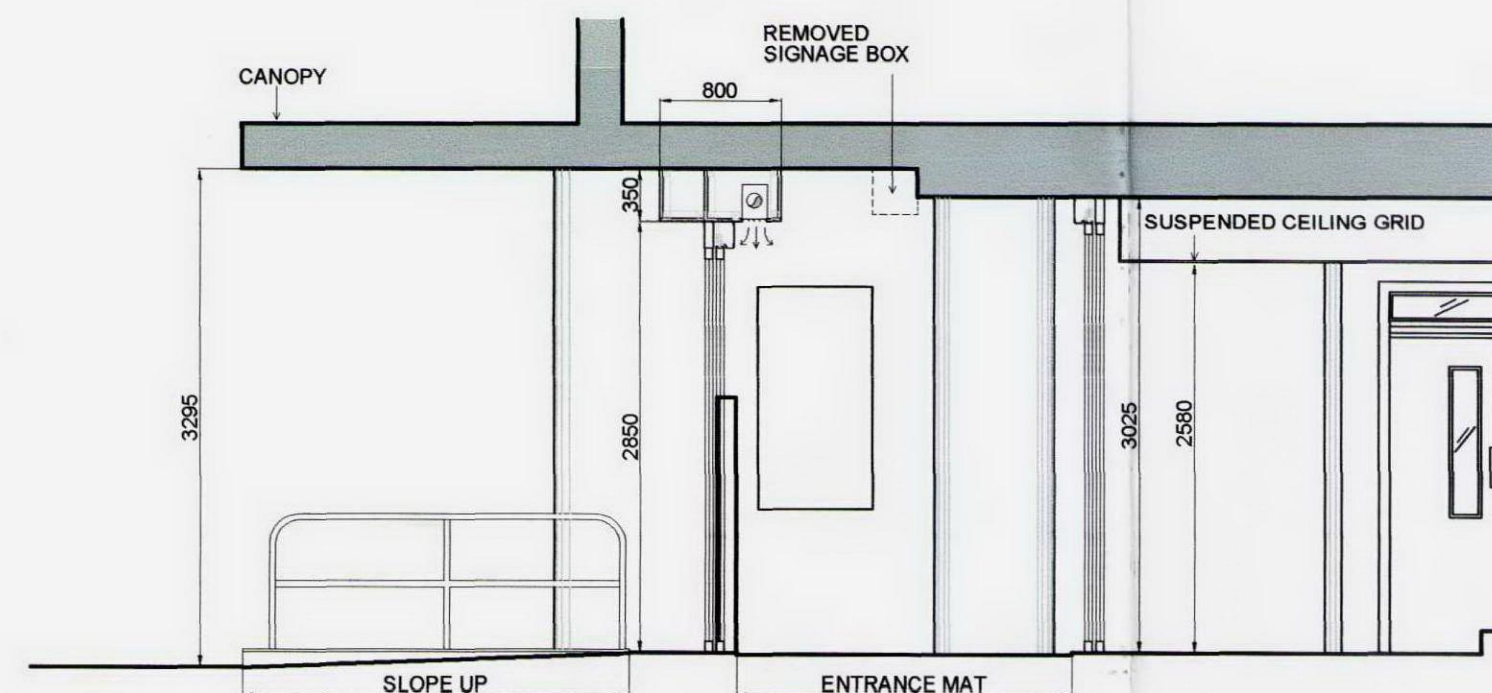

SECTION DD  
SCALE : 1/50

A	FRAMES TO DOORS & FROSTED FILM ADDED	PS	25-06-10
-	DRAWING PRODUCED FIRST ISSUE	PS	24-05-10

REV	DESRIPTIVE AMENDMENTS	BY	DATE
-----	-----------------------	----	------

PRE CONSTRUCTION  
DRAWING

PRE CONSTRUCTION DRAWING / APPROVAL DRAWING  
CONSTRUCTION DRAWING / AS BUILT DRAWING



Maris Interiors LLP  
13th Floor | The Tower Building  
11 York Road | London | SE1 7NX  
T: 020 7902 1750 | F: 020 7902 1799  
E: maris@maris-interiors.co.uk | W: www.maris-interiors.co.uk

CLIENT

AGE UK  
TAVIS HOUSE

PROJECT ADDRESS

TAVISTOCK SQUARE  
LONDON  
WC1H

DRAWING TITLE

PROPOSED ENTRANCE LOBBY  
PLAN, SECTION & ELEVATION

DESIGNER: SIGNED OFF BY \_\_\_\_\_ DATE \_\_\_\_\_ PRE CONTRACTS / CONTRACT: SIGNED OFF BY \_\_\_\_\_ DATE \_\_\_\_\_

DESIGNER / DRAWN BY **SB/PS** SCALE **1/50** AMENDED DATE **25-06-10**

Project No. **16146** Building **1** Floor **G** Detail **P6** Revision **A**



MARIS