


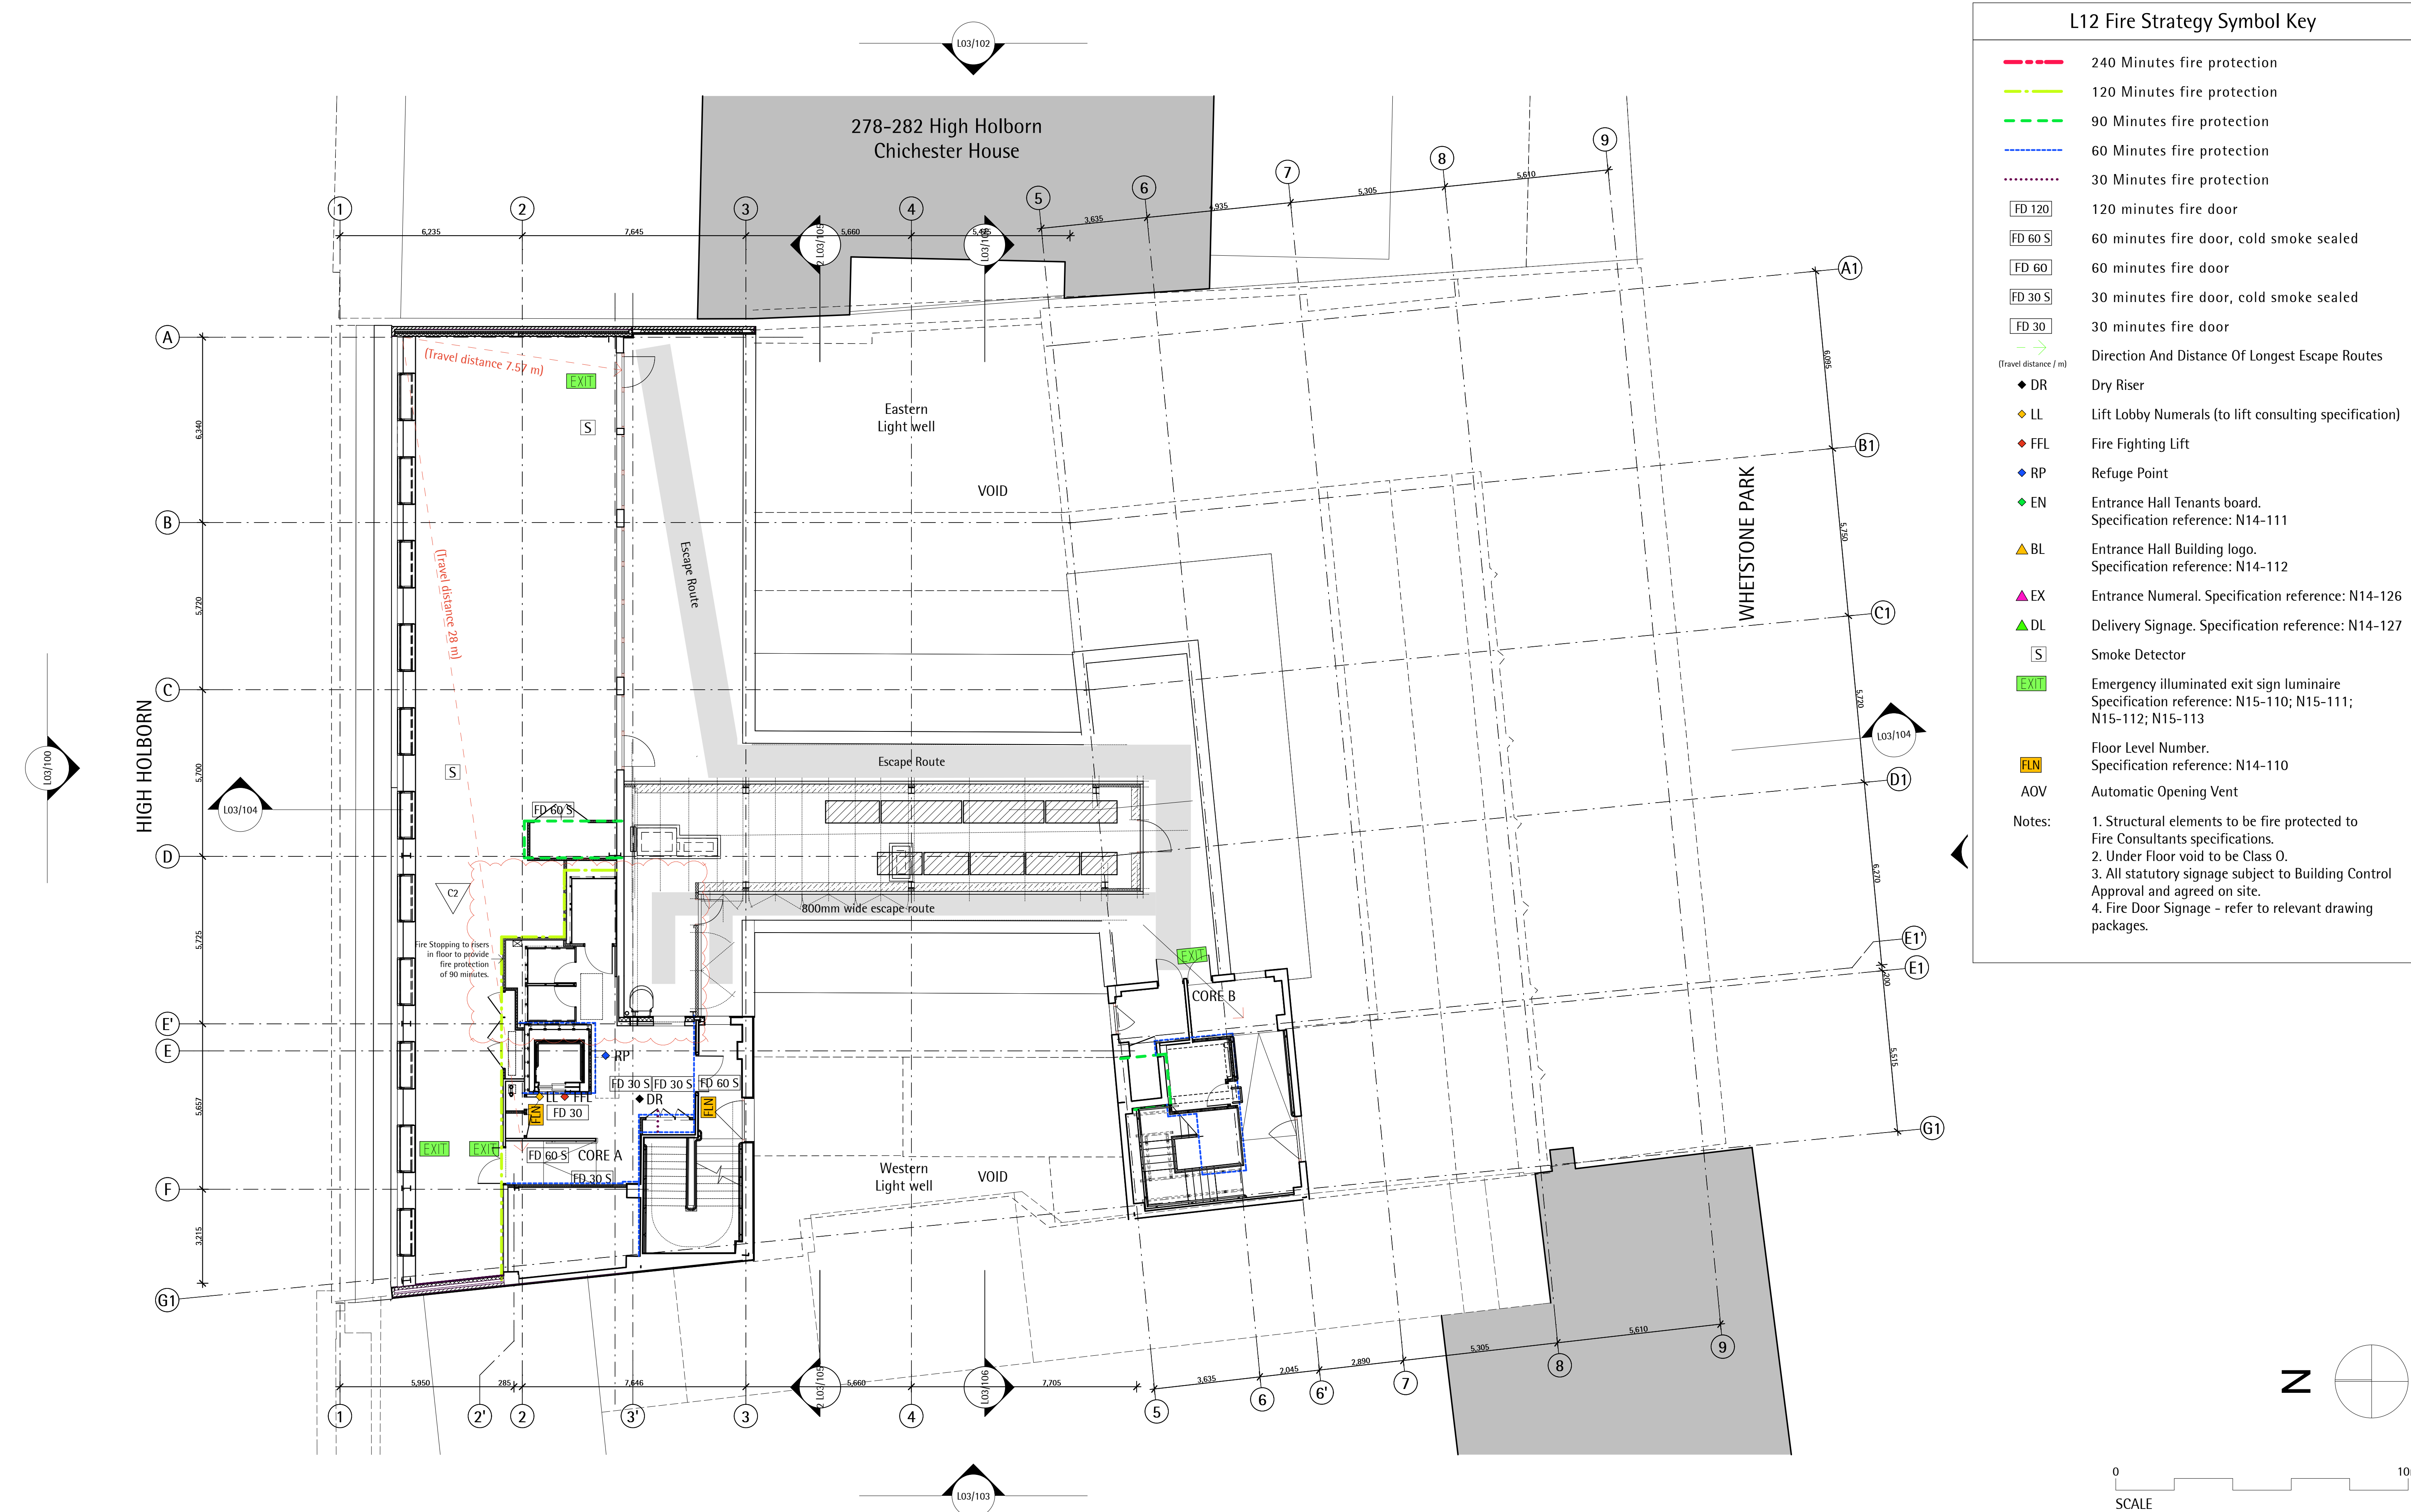

L12 Fire Strategy Symbol Key

240 Minutes fire protection

120 Minutes fire protection

90 Minutes fire protection

60 Minutes fire protection

30 Minutes fire protection

FD 120

120 minutes fire door

FD 60 S

60 minutes fire door, cold smoke sealed

FD 60

60 minutes fire door

FD 30 S

30 minutes fire door, cold smoke sealed

FD 30

30 minutes fire door

(Travel distance / m)

Direction And Distance Of Longest Escape Routes

DR

Dry Riser

LL

Lift Lobby Numerals (to lift consulting specification)

FFL

Fire Fighting Lift

RP

Refuge Point

EN

Entrance Hall Tenants board.
Specification reference: N14-111

BL

Entrance Hall Building logo.
Specification reference: N14-112

EX

Entrance Numeral. Specification reference: N14-126

DL

Delivery Signage. Specification reference: N14-127

S

Smoke Detector

EXIT

Emergency illuminated exit sign luminaire
Specification reference: N15-110; N15-111;
N15-112; N15-113

FLN

Floor Level Number.
Specification reference: N14-110

AOV

Automatic Opening Vent

Notes:

1. Structural elements to be fire protected to Fire Consultants specifications.

2. Under Floor void to be Class O.

3. All statutory signage subject to Building Control Approval and agreed on site.

4. Fire Door Signage - refer to relevant drawing packages.

Notes:
Do not Scale from this drawing

Use figured dimensions only

Rev.	Date	Dwn	Description
P1	24/06/08	aj	Issued for Fire Strategy comments.
P2	01/07/08	aj	Updated to JGA Fire Strategy comments.
P3	06/08/08	rn	Updated to Joinery Tender.
P4	11/08/08	AP	Updated to Signage Tender.
C1	03/09/08	dp	Issued for Construction.
C2	20/04/09	mk	Fire Protection amended
C3	24/07/09	aj	Issued for Record Drawing

Castlethorn UK
(John Fitzsimons)
C/o GVA Second London Wall
10 Stratton Street
London, W1J 8JR

ISG plc
272 High Holborn
271-273 High Holborn
London, WC1V 7NE
Tel. 020 7242 1142

272 Higholborn
London, WC1V 7NE

Ninth Floor Plan

Fire Strategy and Signage

Drawing Status: Construction

Scale(s):	Date:	Drawn:	Checked:
1:100@A1	17/06/08	aj	ah
Project No:	Drawing No:	Revision:	
1680	L12/109	C3	